


AS BUILT DRAWING APPROVED
Subject to the conditions mentioned
in this office's letter No.:
CIDCO/MAIN/PANVEL/Kon/BP-84/OC/2015/1633
Dated 11 MAY 2018
Associate Planner (NAINA)

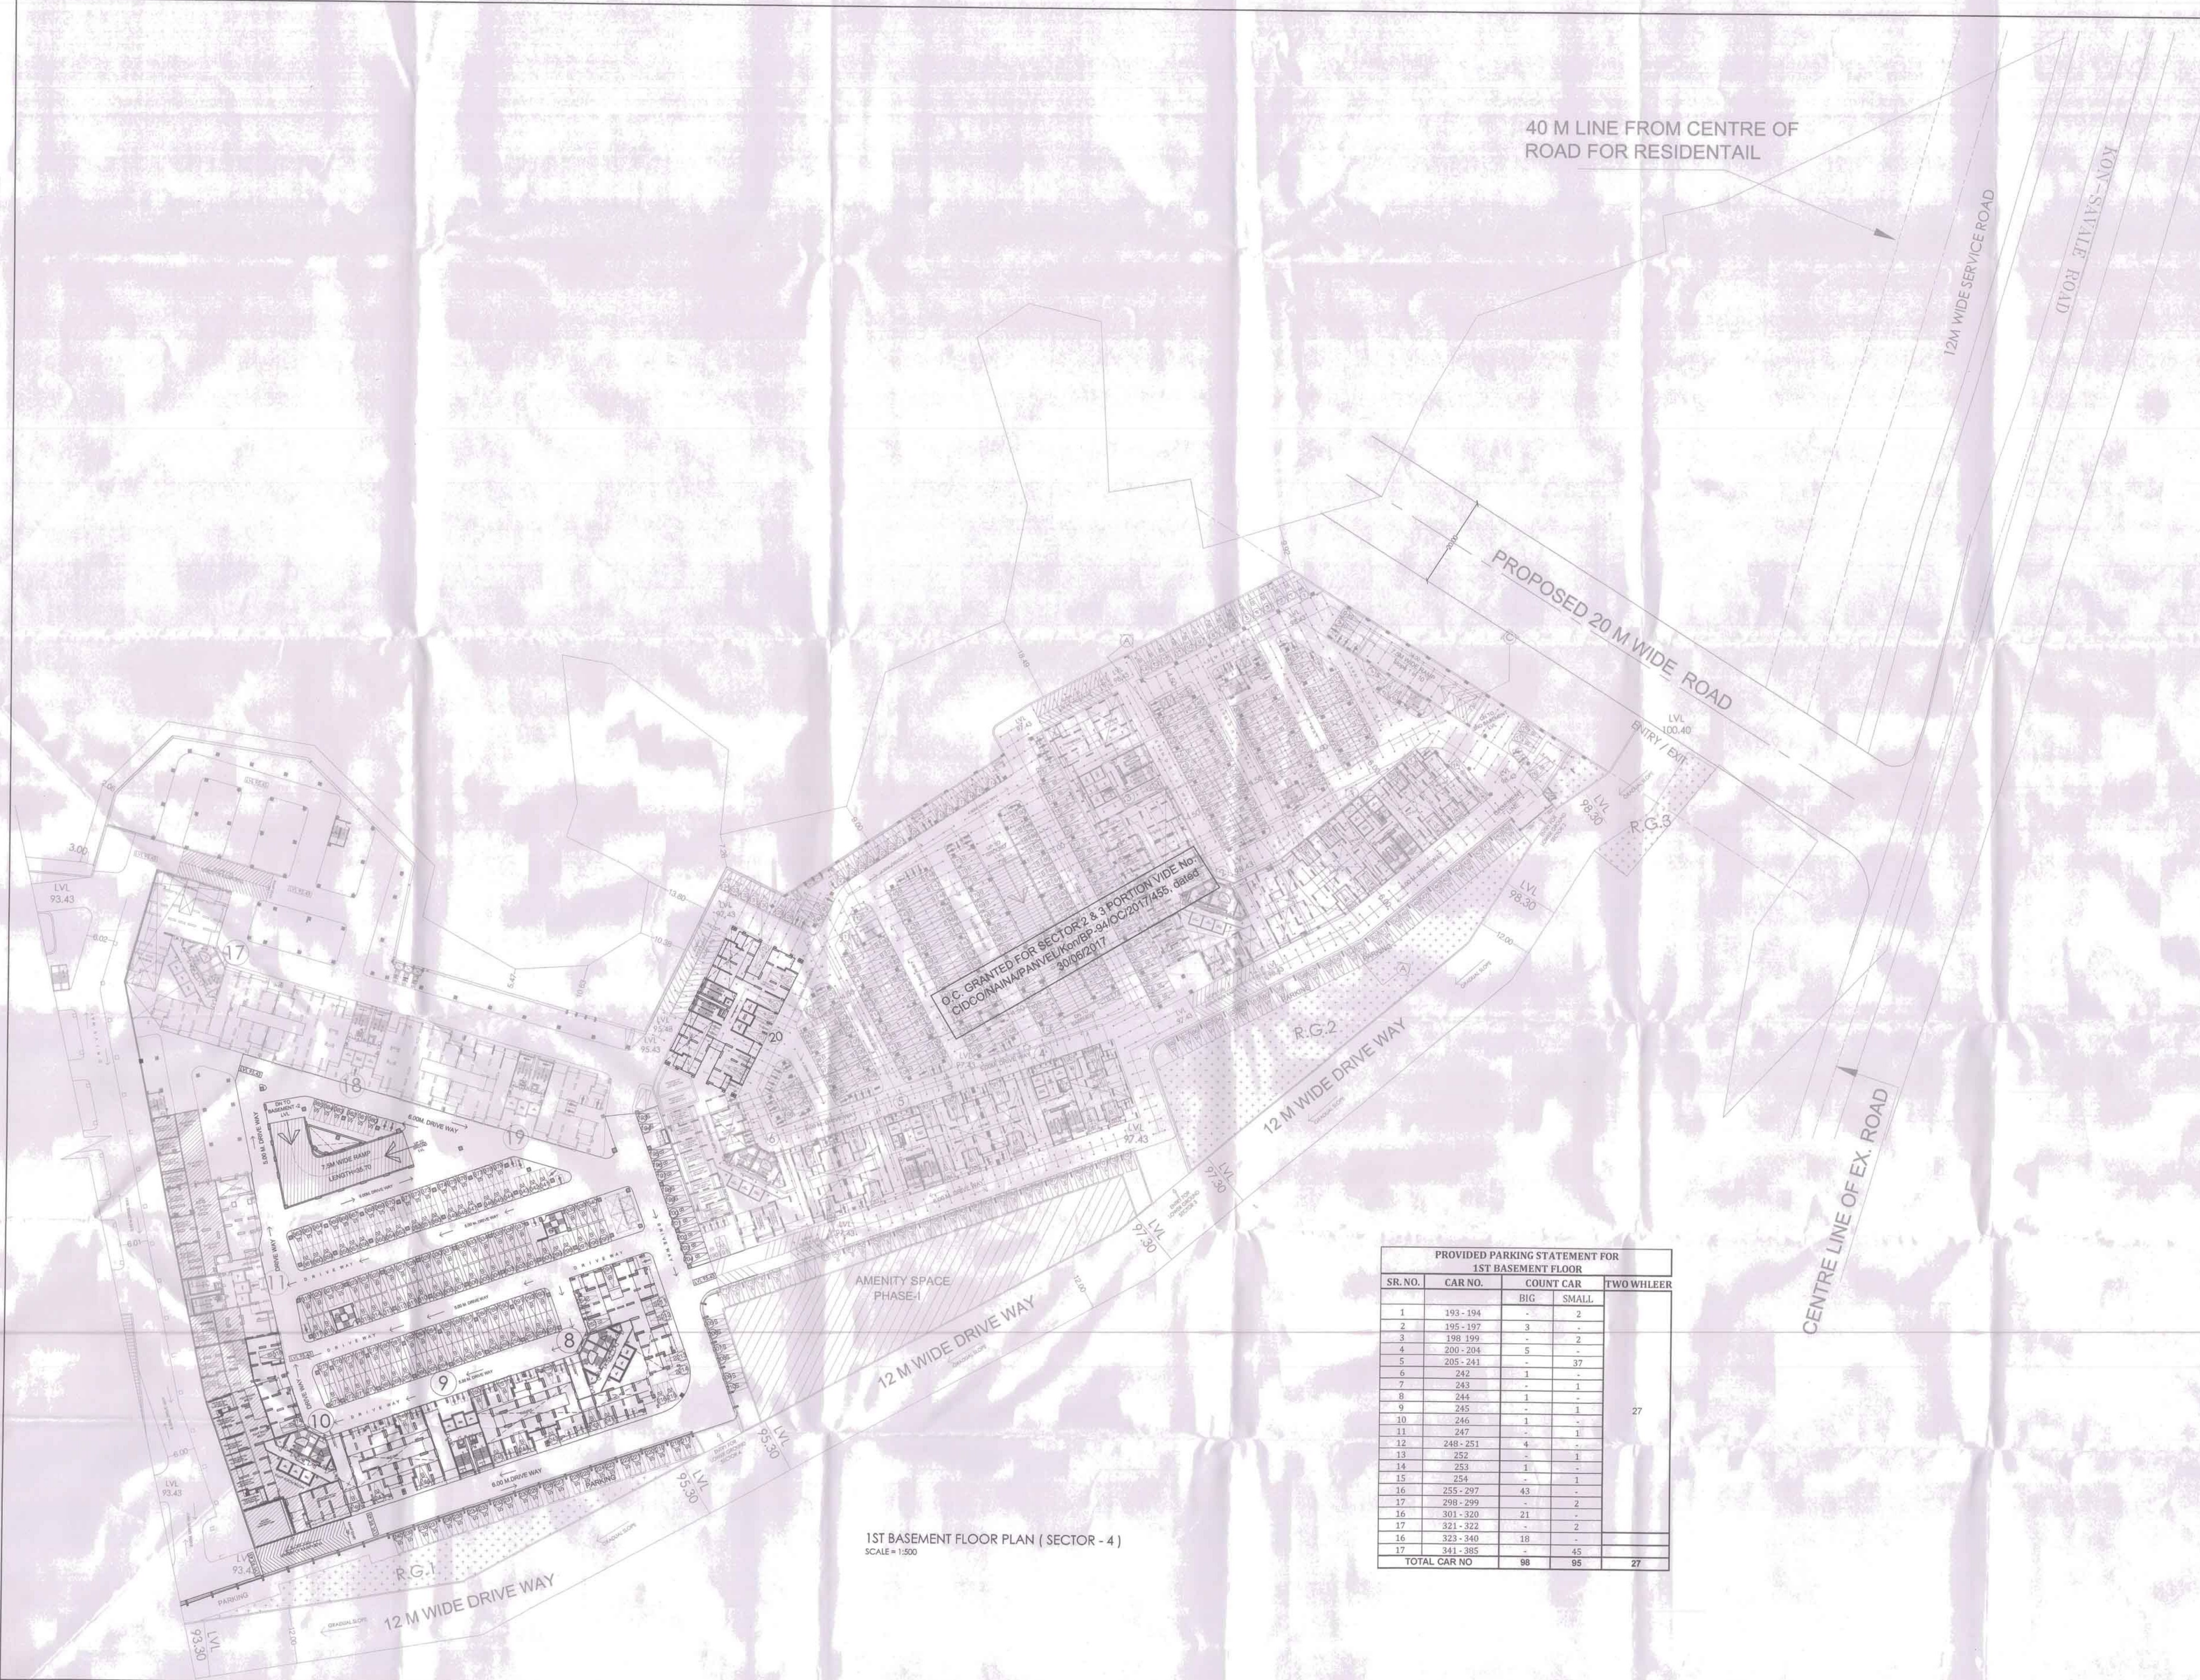

PROVIDED PARKING STATEMENT FOR 1ST BASEMENT FLOOR					TWO WHEELER
SR.NO.	CAR NO.	COUNT CAR			
		BIG	SMALL		
1	193 - 194	-	2	27	
2	195 - 197	3	-		
3	198 - 199	-	2		
4	200 - 204	5	-		
5	205 - 241	-	37		
6	242	1	-		
7	243	-	1		
8	244	1	-		
9	245	-	1		
10	246	1	-		
11	247	-	1		
12	248 - 251	4	-		
13	252	-	1		
14	253	1	-		
15	254	-	1		
16	255 - 297	43	-		
17	298 - 299	-	2		
16	301 - 320	21	-		
17	321 - 322	-	2		
16	323 - 340	18	-		
17	341 - 385	-	45		
TOTAL CAR NO		98	95	27	

DESCRIPTION OF PROPOSAL & PROPERTY
PROPOSED DEVELOPMENT OF RENTAL HOUSING SCHEME ON LAYOUT BEARING S.NO.80/A.85/0.83/7+48+58.83/2A.83/3.86/1.90/1A.90/1B.90/11.90/10.90/9.90/38.90/7.90/8.90/4.91/5 VILLAGE KON, TALUKA - PANVEL, DIST.RAIGAD.

NORTH	JOB. NO.	DRG. NO.	DRAWN BY
	322	3/12	AVOL
	SCALE	DATE	CHECKED BY
	1: 500	-	-

REVISIONS DESCRIPTION :

NAME OF THE OWNER
M/S LUCINA LAND DEVELOPMENT LIMITED.

SIGNATURE

NAME ADDRESS AND SIGNATURE OF LICENSE SURVEYOR

Octave Consultants
Architects, Interior & Landscape Designers
Indialis Finance Center, Tower -1, 15th Floor, Senapati Bapat Marg, Elphinstone Road, Mumbai 400 013.
CA/2003/30717



GROUND LVL PARKING LAYOUT (SECTOR - 4)
SCALE = 1:500

40 M LINE FROM CENTRE OF
ROAD FOR RESIDENTIAL

PROFORMA -B

4/12

CONTENTS OF SHEET

GROUND LVL PARKING LAYOUT (SECTOR - 2 & 3)

STAMP AND DATE OF RECEIPT OF PLAN

AS BUILT DRAWING APPROVED
Subject to the conditions mentioned
in this office's letter No.:
CIDCO/MAIN/ PANVEL/Kon/BP-84/OC/2018/1639
Dated 11 MAY 2018
Associate Planner (NAINA)

STAMP AND DATE OF APPROVAL OF PLAN

DESCRIPTION OF PROPOSAL & PROPERTY
PROPOSED DEVELOPMENT OF RENTAL HOUSING SCHEME ON LAYOUT
BEARING S.NO.80/A.85/0.83/7+48+58.83/2A.83/3.86/1.90/1A.90/18.90/11.
90/10.90/9.90/38.90/7.90/8.90/4.91/5 VILLAGE KON, TALUKA - PANVEL,
DIST.RAIGAD.

NORTH	JOB. NO.	DRG. NO.	DRAWN BY
	322	4/12	
	SCALE	DATE	CHECKED BY
	1:500		

REVISIONS DESCRIPTION :

NAME OF THE OWNER
M/S LUCINA LAND DEVELOPMENT LIMITED.

SIGNATURE

NAME ADDRESS AND SIGNATURE OF LICENSE SURVEYOR

Octave Consultants
Architects, Interior & Landscape Designers
Indira Park Finance Center, Tower - 1, 15th Floor, Senapati Bapat Marg,
Ephraim Road, Mumbai 400 015.



CONTENTS OF SHEET

STILT / 1ST PARKING LEVEL PLAN (SECTOR -4)

STAMP AND DATE OF RECEIPT OF PLAN

AS BUILT DRAWING APPROVED
Subject to the conditions mentioned
in this office's letter No.
CIDCO/NAINA/PANVEL/Kon/BP-34/OCC/2018/1639
Dated 11 MAY 2018
Associate Planner (NAINA)

STAMP AND DATE OF APPROVAL OF PLAN

DESCRIPTION OF PROPOSAL & PROPERTY

PROPOSED DEVELOPMENT OF RENTAL HOUSING SCHEME ON LAYOUT
BEARING S.NO.83/A-85/O.83/7-48+58.83/2A-83/3.86/1/30/1A/30/1B/30/11/
30/10/30/9/30/38/30/7/30/8/30/4/91/5 VILLAGE KON, TALUKA - PANVEL,
DIST.RAIGAD.

NORTH	JOB. NO.	DRG. NO.	DRAWN BY
	322	3/12	AMOL
	SCALE	DATE	CHECKED BY
	1:500	-	-

REVISIONS DESCRIPTION :

NAME OF THE OWNER
M/S LUCINA LAND DEVELOPMENT LIMITED.

SIGNATURE

NAME ADDRESS AND SIGNATURE OF ARCHITECT (L.S.)

SIGNATURE

Octave Consultants
Architects, Interior & Landscape Designers
Indrabhawan Finance Center, Tower -C, 11th Floor, Jangpur Regal Marg,
Bhamburda Road, Mumbai 400 015.

Octave Consultants
CA/2003/0717

40 M LINE FROM CENTRE OF
ROAD FOR RESIDENTIAL

12M WIDE SERVICE ROAD

11.01 M WIDE ROAD

PROPOSED 20 M WIDE ROAD

CENTRE LINE OF EX. ROAD

O.C. GRANTED FOR SECTOR 2 & 3 PORTION VIDE No.
CIDCO/NAINA/PANVEL/Kon/BP-34/OCC/2017/1655 dated
30/08/2017

STILT / 1ST PARKING LEVEL PLAN (SECTOR - 2 & 3)
SCALE = 1:500

STILT / 1ST PARKING LEVEL PLAN (SECTOR - 4)
SCALE = 1:500

PROVIDED PARKING STATEMENT FOR
1ST PARKING FLOOR

SR. NO.	CAR NO.	COUNT CAR		TWO
		BIG	SMALL	
1	151	-	1	16
2	152 - 155	4	-	
3	156	-	1	
4	157 - 239	83	-	
5	240 - 278	-	39	16
6	279 - 281	3	-	
7	282 - 296	-	15	
TOTAL CAR NO		90	56	16

CONTENTS OF SHEET

1ST FLOOR/ R.G. LVL. PLAN (SECTOR -4)

STAMP AND DATE OF RECEIPT OF PLAN

AS BUILT DRAWING APPROVED
Subject to the conditions mentioned
in this office's letter No.:
CIDCO/NAINA/ PANVEL/Kon/BP-94/OC/2018/1639
Dated 11 MAY 2018
Associate Planner (NAINA)



1ST FLOOR/ R.G. LVL. PLAN (SECTOR-4)
SCALE = 1:500

STAMP AND DATE OF APPROVAL OF PLAN

DESCRIPTION OF PROPOSAL & PROPERTY
PROPOSED DEVELOPMENT OF RENTAL HOUSING SCHEME ON LAYOUT BEARING S.NO.80/A.85/0.83/7+4B+5B.83/2A.83/3.86/1.90/1A.90/1B.90/11.90/10.90/9.90/3B.90/7.90/8.90/4.91/5 VILLAGE KON, TALUKA - PANVEL, DIST.RAIGAD.

NORTH	JOB. NO.	DRG. NO.	DRAWN BY
	322	4/12	AMOL
	SCALE	DATE	CHECKED BY
	1:500		

REVISIONS: DESCRIPTION:

R-0

NAME OF THE OWNER

M/S LUCINA LAND DEVELOPMENT LIMITED.




SIGNATURE

NAME ADDRESS AND SIGNATURE OF ARCHITECT (L.S.)

SIGNATURE

Octave Consultants
Architects, Interior & Landscape Designers
Indrabhute Finance Center, Tower -A, 11th Floor-Satyam Rajput Marg,
Elphinstone Road, Mumbai 400 013



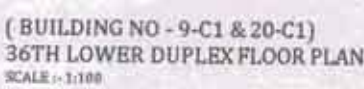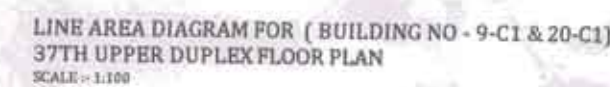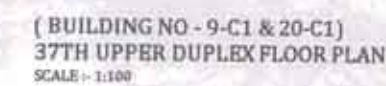

SCHEDULE OF DOOR & WINDOW			
SR.NO.	NUMERATIVE	SIZE IN MTR	LOCATION
1	W1	1.83 X 2.10	LIVING ROOM M.BED ROOM
2	W2	0.69 X 2.00	TOILET
3	W3	0.21 X 0.91	TOILET
4	W4	3.22 X 1.31	M.BED ROOM
5	W5	0.60 X 1.31	SERVICE AREA
6	W6	1.00 X 1.40	STAIRCASE WINDOW
7	W7	0.90 X 2.10	M.BED ROOM
8	D1	0.90 X 2.10	TOILET / SERVICE AREA
9	D2	1.06 X 2.10	MAIN ENTRANCE DOOR
10	D3	1.06 X 2.10	STAIRCASE DOOR
11	D4	0.69 X 2.10	KITCHEN DOOR
12	D5A	1.83 X 2.10	

DAILY & WEEKLY AVERAGE DATA (9-AM - 3-PM)										
PLAY NO. 1, 2, 3, 99, 100										
NO.	WEEK	DATE	START	END	START	END	TOTAL	WEEKLY	WEEKLY	WEEKLY
1	1	1	1	1	1	1	1	1	1	1
2	2	2	2	2	2	2	2	2	2	2
3	3	3	3	3	3	3	3	3	3	3
100	100	100	100	100	100	100	100	100	100	100

[illegible]

BUILT UP AREA (DUPLICATION BUILDING) - 9-C & 20-C									
37TH FLOOR DUPLICATION FLOOR PLAN									
ADDITION (X)									
A	3.554	X	16.97	X	1	X	1	X	532.81
TOTAL									532.81
1	2.607	X	2.65	X	1	X	2		10.897
2	4.119	X	0.13	X	1	X	2		0.04
2a	2.48	X	0.43	X	1	X	2		2.13
3	2.45	X	4.04	X	1	X	2		19.41
3a	2.81	X	1.23	X	1	X	2		7.64
4	2.60	X	1.44	X	1	X	1		0.75
5	7.73	X	2.90	X	1	X	2		41.75
6	2.61	X	2.46	X	1	X	2		12.52
7	4.17	X	0.51	X	1	X	2		4.86
7a	2.48	X	0.84	X	1	X	2		4.10
8	1.03	X	1.63	X	1	X	2		9.96
9	2.43	X	1.05	X	1	X	4		11.61
9a	2.43	X	0.20	X	1	X	4		2.16
TOTAL			0.20	X	1	X	1		139.17

SECTION (T2)						
D1	1.60	1.80	X	1	X	3 = 5.76
D2	0.80	2.25	X	1	X	1 = 5.00
TOTAL						11.56
STAIRCASE LIFT & LIFT LOBBY DEDUCTION (T2)						
S1	1.30	1.82	X	1	X	2 = 23.56
S2	1.50	2.00	X	1	X	2 = 14.48
S3	1.70	2.30	X	1	X	2 = 6.12
S4	2.30	2.71	X	1	X	2 = 3.97
S5	0.68	2.08	X	1	X	2 = 3.85
S6	2.40	0.16	X	1	X	2 = 0.79
S7	2.30	2.77	X	1	X	2 = 12.90
S8	2.30	0.63	X	1	X	2 = 5.24
S9	2.40	0.16	X	1	X	2 = 0.79
S10	1.60	1.80	X	1	X	1 = 0.84
S11	2.40	2.87	X	1	X	2 = 13.44
S12	1.00	2.40	X	1	X	2 = 16.67

TOTAL T4 (Y1 - Y2 + Y3)		=	115.93	50
NET BUILT-UP AREA (E-Y4)		=	266.66	50
BALCONY STATEMENT			=	266.15
BI	8.25 X	1.05	X 1 X 4	=
=	2.65 X	0.20	X 1 X 4	=
TOTAL			=	15.77
10% BALCONY AREA			=	26.62
PROPOSED BALCONY			=	15.77
EXCESS BALCONY			=	0.00
TOTAL			=	266.15

BIRLY UP AREA CALIBRATION BUILDING NO - 9-C & 20-C									
36TH LOWER DUPLEX FLOOR PLAN									
ADDITION (X)									
A	22.54	X	16.37	X	1	X	1	=	\$32.91
TOTAL									

REDUCTION (1)						= 532.81	
1	2.65	X	2.05	X	1	2	10.87
2	6.67	X	0.10	X	1	2	1.21
3	2.40	X	0.04	X	1	3	0.41
4	3.60	X	3.44	X	1	1	8.95
5	2.20	X	2.90	X	1	2	41.75
6	2.65	X	2.40	X	1	2	13.05
7	6.67	X	1.54	X	1	2	5.96
8	3.05	X	0.67	X	1	2	3.96
C1	0.35	X	0.33	X	1	4	0.66
B1	3.25	X	1.05	X	1	4	13.65
	3.25	X	0.20	X	1	4	2.12
B2	3.25	X	3.23	X	1	2	7.94
TOTAL							176.36

DIST. IRRADIATION (T ₂)		DIST. IRRADIATION (T ₂)		DIST. IRRADIATION (T ₂)		DIST. IRRADIATION (T ₂)	
D1	1.800	X	1	X	2	*	5.76
D2	2.100	X	1	X	1	*	5.88
TOTAL						11.54	
STAIRCASES & LIFT/LIGHT IRRADIATION (T ₃)							
S1	3.30	X	1	X	2	*	23.18
S2	3.50	X	1	X	1	*	11.49
S3	1.70	X	1	X	1	*	5.61
S4	1.60	X	1	X	1	*	5.28
S5	2.40	X	2	X	2	*	18.44
S6	1.40	X	1	X	1	*	4.67
TOTAL						69.67	
TOTAL (T ₁ + T ₂ + T ₃)							
NET BUILDING AREA (S _{TA})						279.80	
BALCONY STAIRWAYS						301.01	
BALCONY STAIRWAYS							
B1	2.25	X	1	X	1	*	12.60
B2	2.65	X	1	X	1	*	14.12
B3	2.45	X	1	X	1	*	7.96
B4	1.85	X	1	X	1	*	7.44
TOTAL						42.12	
TOTAL BALCONY AREA							
INDOOR BALCONY						30.30	
OUTDOOR BALCONY						31.77	
TOTAL BALCONY						62.07	
TOTAL BALCONY AREA						293.89	

CONTENTS OF SHEET
36TH LOWER DUPLEX FLOOR PLAN (BUILDING NO - 9-C1 & 20-C1)
37TH UPPER DUPLEX FLOOR PLAN (BUILDING NO - 9-C1 & 20-C1)
LINE AREA DIAGRAM CALCULATION & CARPET AREA STATMENT
SCHEDULE OF DOOR & WINDOW

STAMP AND DATE OF RECEIPT OF PLAN

AS BUILT DRAWING APPROVED
Subject to the conditions mentioned
in this office's letter No.:

GIDCO/NAINA/PANVEL/Kon/BP-94/OC/2018/1639

Dated 11 MAY 2018

Associate Planner (NAINA)

STAMP AND DATE OF APPROVAL OF PLAN

DESCRIPTION OF PROPOSAL & PROPERTY

PROPOSED DEVELOPMENT OF RENTAL HOUSING SCHEME ON LAYOUT
BEARING S.NO.80/A.85/0.83/7+4B+5B.83/2A.83/3.86/1.90/1A.90/1B.90/11.
90/10.90/9.90/3B.90/7.90/8.90/4.91/5 VILLAGE KON, TALUKA - PANVEL,
DIST.RAIGAD.

	NORTH	JOB. NO.	DRG. NO.	DRAWN BY
		322	8/12	AMOL
	SCALE	DATE	CHECKED BY	
	1:150	-	-	
REVISIONS	DESCRIPTION :			
R-0				
NAME OF THE OWNER			SIGNATURE	
M/S LUCINA LAND DEVELOPMENT LIMITED.				

NAME ADDRESS AND SIGNATURE OF ARCHITECT (R.S.)

Octave Consultants
Architects, Interior & Landscape Designers
Bell's Finance Centre, Tower -1, 15th Floor, Jangpuri Road
Elphinstone Road, Mumbai 400 013.

Octave Consultants
CA/2003/30717

STILT / 1ST PARKING FLOOR PLAN (BUILDING NO - 8-G1 & 10-G1)
1ST TO 6TH, 8TH TO 11TH, 13TH TO 16TH, 18TH TO 21ST, 23RD
TO 26TH, 28TH TO 31ST, 33RD TO 35TH TYPICAL FLOOR PLAN
STILT FLOOR PLAN
LINE AREA DIAGRAM CALCULATION OF STILT FLOOR & CARPET AREA
TENANT AREA STATEMENT
SCHEDULE OF DOOR & WINDOW

STAMP AND DATE OF RECEIPT OF PLAN

AS BUILT DRAWING APPROVED
Subject to the conditions mentioned
in this office's letter No.:

CIDCO/NAINA/ **PANVEL**/Kon/BP-94/OC/2018/1639

Dated 11 MAY 2018

Associate Planner (NAINA)

22

SCHEDULE OF DOOR & WINDOW			
SL.NO.	NOMENCLATURE	SIZE IN METER	LOCATION
1	W1	1.83 X 2.10	LIVING ROOM, BED ROOM - 1
3	W2	0.60 X 0.90	TOILET
4	W2A	0.33 X 0.90	TOILET
5	W4	1.21 X 1.85	BED ROOM - 2
6	W5	0.90 X 1.35	SERVICE AREA
7	D1	0.90 X 2.10	BED ROOM - 1
8	D2	0.75 X 2.10	TOILET / SERVICE FLOOR
9	D3	1.00 X 2.10	MAIN ENTRANCE DOOR
10	D4	1.50 X 2.10	STAIRCASE DOOR
11	D6	3.00 X 2.10	KITCHEN DOOR

LEGEND :		
SYMBOL	DESCRIPTION	QTY
	BUTTERFLY VALVE WITH TAMPER SWITCH	1 No.
	FLOW SWITCH	1 No.
	RECESSED PENDENT SPRINKLER - 68°C	5 No.
	RECESSED WALL MOUNTED SPRINKLER - 68°C	24 No.
	RECESSED WALL MOUNTED SPRINKLER - 79°C	6 No.
	Ø100 SLEEVE	35 No.
	Ø75 SLEEVE	02 No.

BUILT UP AREA CALCULATION BUILDING NO - B-G1 & 10-G1
1ST TO 6TH, 8TH TO 11TH, 13TH TO 16TH, 18TH TO 21ST, 23RD TO 26TH, 28TH TO 31ST, 33RD TO 35TH TYPICAL FLOOR PLAN

[illegible]

DAILY DEDUCTION (Y2)										
D1	3.40	X	1.31	X	0.5	X	1	=	2.22	90.8
D2	3.33	X	1.48	X	0.5	X	1	=	2.44	90.8
D3	6.88	X	0.59	X	1	X	1	=	3.40	90.8
D3	2.62	X	0.77	X	0.5	X	1	=	1.01	90.8
*	2.40	X	1.31	X	0.5	X	1	=	1.57	90.8
TOTAL								=	10.66	90.8

STAIRCASE LIFT & LIFT LOBBY DISINTEGRATION (V2)										
S1	5.29	3	3.49	1	3	1	1	1	18.65	50.24
S2	1.90	3	0.69	1	3	1	1	1	1.14	3.03
S3	2.46	3	2.46	1	3	1	1	1	8.57	23.87
S4	2.46	3	0.69	1	3	0.5	1	1	1.04	2.89
S5	4.65	5	3.17	1	3	1	1	1	9.86	26.99
S6	2.69	3	[2.55 1.48]	1	3	1	1	1	6.17	17.07
S7	2.69	3	0.69	1	3	0.5	1	1	2.20	6.09
S8	2.55	3	2.19	1	3	1	1	1	5.93	16.30
S9	1.90	3	0.69	1	3	1	1	1	2.14	5.89
S10	2.69	3	2.69	1	3	1	1	1	9.86	26.99
S11	2.38	3	[1.88 1.31]	1	3	0.5	1	2	7.66	21.19
S12	2.09	3	[0.77 1.05]	1	3	0.5	1	2	2.95	8.13
S13	1.99	3	1.65	1	3	1	1	1	3.29	9.13
S14	2.69	3	0.69	1	3	1	1	1	2.20	6.09
S15	0.80	3	1.73	1	3	1	1	1	13.12	36.30
S16	1.83	3	0.95	1	3	1	1	1	1.25	3.49
S17	2.69	3	2.69	1	3	1	1	1	9.86	26.99
S18	2.09	3	[1.76 1.48]	1	3	0.5	1	1	4.47	12.40

TOTAL					=	108.19	SQ.FT.
TOTAL Y4 (Y1 + Y2 + Y3)					=	590.89	SQ.FT.
NET BUILT-UP AREA (X+Y4)					=	439.52	SQ.FT.
BALCONY STATEMENT							
B1	3.25	X	1.60	X	1	X	8 = 19.50 SQ.FT.
A	* 2.85	X	2.85	X	1	X	6 = 3.18 SQ.FT.
H3	1.19	X	3.15	X	1	X	4 = 14.99 SQ.FT.
B4	1.19	X	3.25	X	1	X	2 = 7.74 SQ.FT.
TOTAL					=	45.41	SQ.FT.
PROPOSED BALCONY AREA					=	45.41	SQ.FT.
10% BALCONY AREA					=	43.95	SQ.FT.
PROPOSED BALCONY					=	45.41	SQ.FT.
EXCESS BALCONY					=	1.46	SQ.FT.
TOTAL					=	440.98	SQ.FT.

BUILT UP AREA CALCULATION BUILDING NO - 8-G1	
STILT / 1ST PARKING FLOOR PLAN	
AREA/NO. OF CUR	

	31.10	31.9	X	Y	Z	1	-	1035.61	50.1	
TOTAL	31.10							1035.61	50.1	
INTERSECTION										
2	2.40	X	1	1	X	4	-	3.27	50.1	
3	6.30	X	6.30	X	1	1	X	-	13.75	50.1
4	2.10	X	2.10	X	1	1	X	-	2.81	50.1
4	23.67	X	7.50	X	1	1	X	-	104.77	50.1
5	1.80	X	1.80	X	1	1	X	-	2.52	50.1
6	1.18	X	3.55	X	1	2	X	-	4.12	50.1
7	22.97	X	3.50	X	1	1	X	-	76.94	50.1
8	1.80	X	1.80	X	1	1	X	-	2.52	50.1
9	12.57	X	10.60	X	1	1	X	-	131.07	50.1
10	1.80	X	1.80	X	1	1	X	-	2.52	50.1
11	18.2	X	5.00	X	1	1	X	-	43.5	50.1
12	7.20	X	5.70	X	1	1	X	-	18.45	50.1
13	1.80	X	1.80	X	1	1	X	-	2.52	50.1
14	0.67	X	[1.71 + 1.71]	X	0.50	2	X	-	1.00	50.1
15	1.80	X	[1.52 + 1.71]	X	0.50	2	X	-	1.00	50.1
16	1.80	X	1.80	X	1	1	X	-	2.52	50.1
17	0.75	X	[1.52 + 1.71]	X	0.50	2	X	-	1.00	50.1
17	6.75	X	6.50	X	0.50	2	X	-	72.61	50.1
18	1.80	X	1.80	X	1	1	X	-	2.52	50.1
19	0.67	X	[1.00 + 1.71]	X	0.50	2	X	-	0.97	50.1

DOCT DEDUCTION (Y2)										
D1	3.60	X	1.53	X	0.5	X	1	=	2.71	50
*	3.61	X	1.40	X	0.5	X	1	=	2.67	50
D2	6.00	X	0.50	X	1	X	1	=	3.48	50
D3	2.62	X	0.77	X	0.5	X	1	=	1.01	50
*	2.40	X	1.31	X	0.5	X	1	=	1.57	50
*	2.48	X	0.20	X	1	X	1	=	0.48	50
TOTAL									11.84	50

[illegible]

TOTAL Y4 {Y1 + ... + Y3}		=	767.54	SQ.	
NET BUILT-UP AREA (X+Y4)		=	322.87	SQ.	
BALCONY STATEMENT					
Rd 315' X	1.09	X 1 X 4	=	157.5	SQ.
TOTAL			=	13.72	SQ.
PROPOSED BALCONY AREA			=	13.73	SQ.
10% BALCONY AREA			=	32.29	SQ.
PROPOSED BALCONY			=	13.73	SQ.
GROSS BALCONY			=	8.66	SQ.
TOTAL			=	322.87	SQ.

TENAMENT AREA STATEMENT					
BUILDING - G-01					
FLOORS	FLAT NOS	CARPET AREA	BALCONY AREA	ENCL. PROJECTED	R/U AREA
STILL FLOOR	1	0.00	0.00	1.43	0.00
	2	64.88	9.00	3.43	77.68
	3	64.88	9.00	3.43	77.68
	4	76.94	0.00	3.43	83.95
	5	64.17	3.78	3.87	75.33
1ST TO 6TH, 8TH TO 11TH, 13TH TO 16TH, 18TH TO 21ST, 23RD TO 26TH, 28TH TO 31ST, 33RD TO 35TH TYPICAL FLOOR	1	64.17	3.78	3.87	75.33
	2	64.17	3.78	3.87	75.33
	3	82.75	3.78	3.75	69.43
	4	82.75	3.78	3.75	69.43
	5	64.17	3.78	3.87	75.33
7TH, 12TH, 14TH, 22ND, 27TH & 36TH TYPICAL FLOOR	1	64.17	3.78	3.87	75.33
	2	64.17	3.78	3.87	75.33
	3	82.75	3.78	3.75	69.43
	4	0.00	0.00	0.00	0.00
	5	64.17	3.78	3.87	75.33
DUPLEX FLOOR (36TH LOWER & 37TH UPPER)	1	120.23	7.56	3.87	141.87
	2	121.44	7.56	3.75	142.07
	3	109.38	7.56	3.75	129.90
	4	109.38	7.56	3.75	129.90
	5	120.23	7.56	3.87	141.87

TENEMENT AREA STATEMENT					
BUILDING - 19-61					
FLOORS	FLAT NO.	CARPET AREA	BALCONY AREA ENCL.	BALCONY AREA PROTECTED	R/O AREA
STAY FLLOOR (OWN & DOOR/GARAGE)	1	138.15	0.00	6.86	161.44
	2	137.57	0.00	6.86	161.44
	3	64.17	3.78	3.87	75.33
	4	64.77	3.78	3.75	75.33
	5	58.75	3.78	3.75	68.93
1ST TO 16TH, 18TH TO 19TH, 21ST TO 24TH, 26TH TO 27TH, 29TH TO 34TH FLOOR	1	64.17	3.78	3.87	75.33
	2	64.77	3.78	3.75	75.33
	3	58.75	3.78	3.75	68.93
	4	58.75	3.78	3.75	68.93
	5	64.17	3.78	3.87	75.33
7TH, 11TH, 14TH, 22ND, 27TH & 3RD TYPICAL FLOOR	1	64.17	3.78	3.87	75.33
	2	64.77	3.78	3.75	75.33
	3	58.75	3.78	3.75	68.93
	4	5.00	0.00	0.00	5.00
	5	64.17	3.78	3.87	75.33
DORMER FLOOR (DOWN LOWER & 17TH UPPER)	1	120.23	7.56	3.87	141.87
	2	121.44	7.56	3.75	142.07
	3	109.38	7.56	3.75	128.90
	4	109.38	7.56	3.75	128.90
	5	121.44	7.56	3.75	142.07
	6	120.23	7.56	3.87	141.87

STAMP AND DATE OF APPROVAL OF PLAN

DESCRIPTION OF PROPOSAL & PROPERTY

PROPOSED DEVELOPMENT OF RENTAL HOUSING SCHEME ON LAYOUT BEARING S.NO.80/A.85/0.83/7+48+5B.83/2A.83/3.86/1,90/1A,90/1B,90/11,90/10,90/9,90/38,90/7,90/8,90/4,91/5 VILLAGE KON, TALUKA - PANVEL, DIST.RAIGAD.

NORTH	JOB. NO.	DRG. NO.	DRAWN BY
	322	9/12	AMOL
	SCALE	DATE	CHECKED BY

	1:150
REVISIONS	DESCRIPTION -

NAME OF THE OWNER
MUE LUCINA LAND DEVELOPMENT LIMITED

NAME ADDRESS AND SIGNATURE OF ARCHITECT (L.S.)

Octave Consultants

Architects, Interior & Landscape Designers
 10000 Wilshire Blvd., Suite 1000, Beverly Hills, CA 90212
 Tel: 310.771.1000 Fax: 310.771.1001
 www.hilliergroup.com

Highstone Road, Manchester M10 0TS.

1997


Octave Consultants
CA/2003/3071

CH2000-2


CONTENTS OF SHEET
7TH, 12TH, 17TH, 22ND & 27TH TYPICAL REFUGE FLOOR PLAN
(BUILDING NO-8-G1 & 10-G1)
LINE AREA DIAGRAM, REFUGE AREA STATEMENT, CARPET AREA CALCULATION

STAMP AND DATE OF RECEIPT OF PLAN


AS BUILT DRAWING APPROVED
Subject to the conditions mentioned
in this office's letter No. PANVEL/Kon/BP-94/OC/2018/1639
Dated 11 MAY 2018
Associate Planner (NAINA)

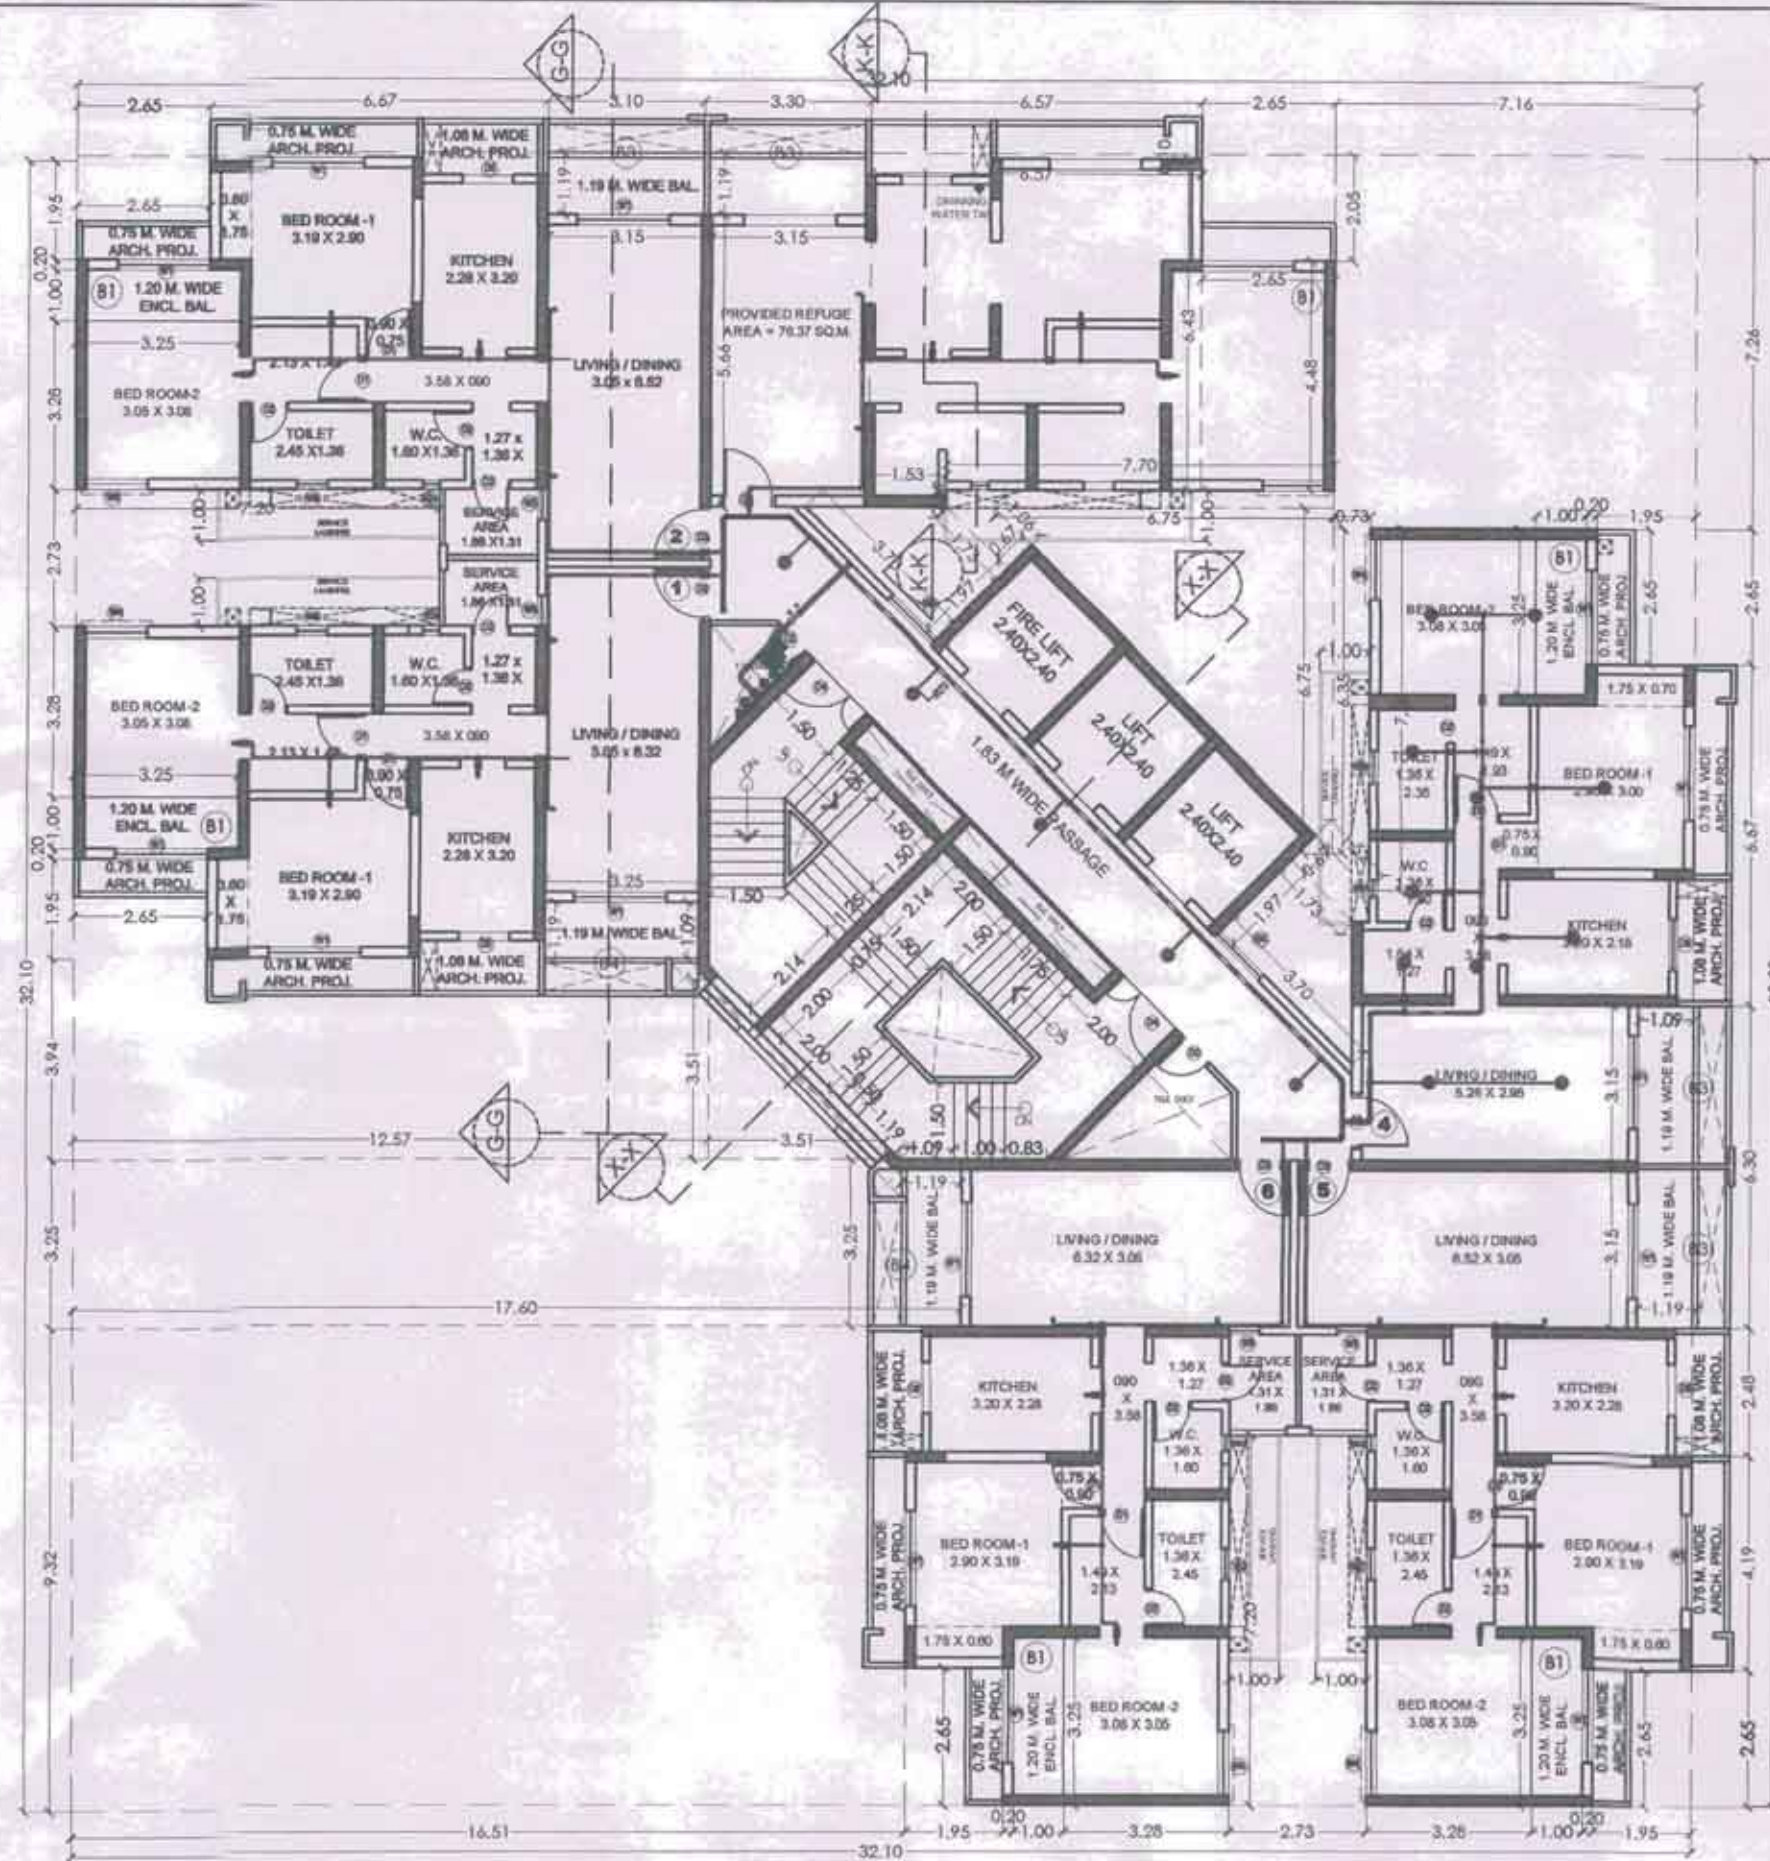


(BUILDING NO - 10-G1)
7TH, 12TH, 17TH, 22ND, 27TH & 32ND TYPICAL REFUGE FLOOR PLAN
SCALE = 1:100

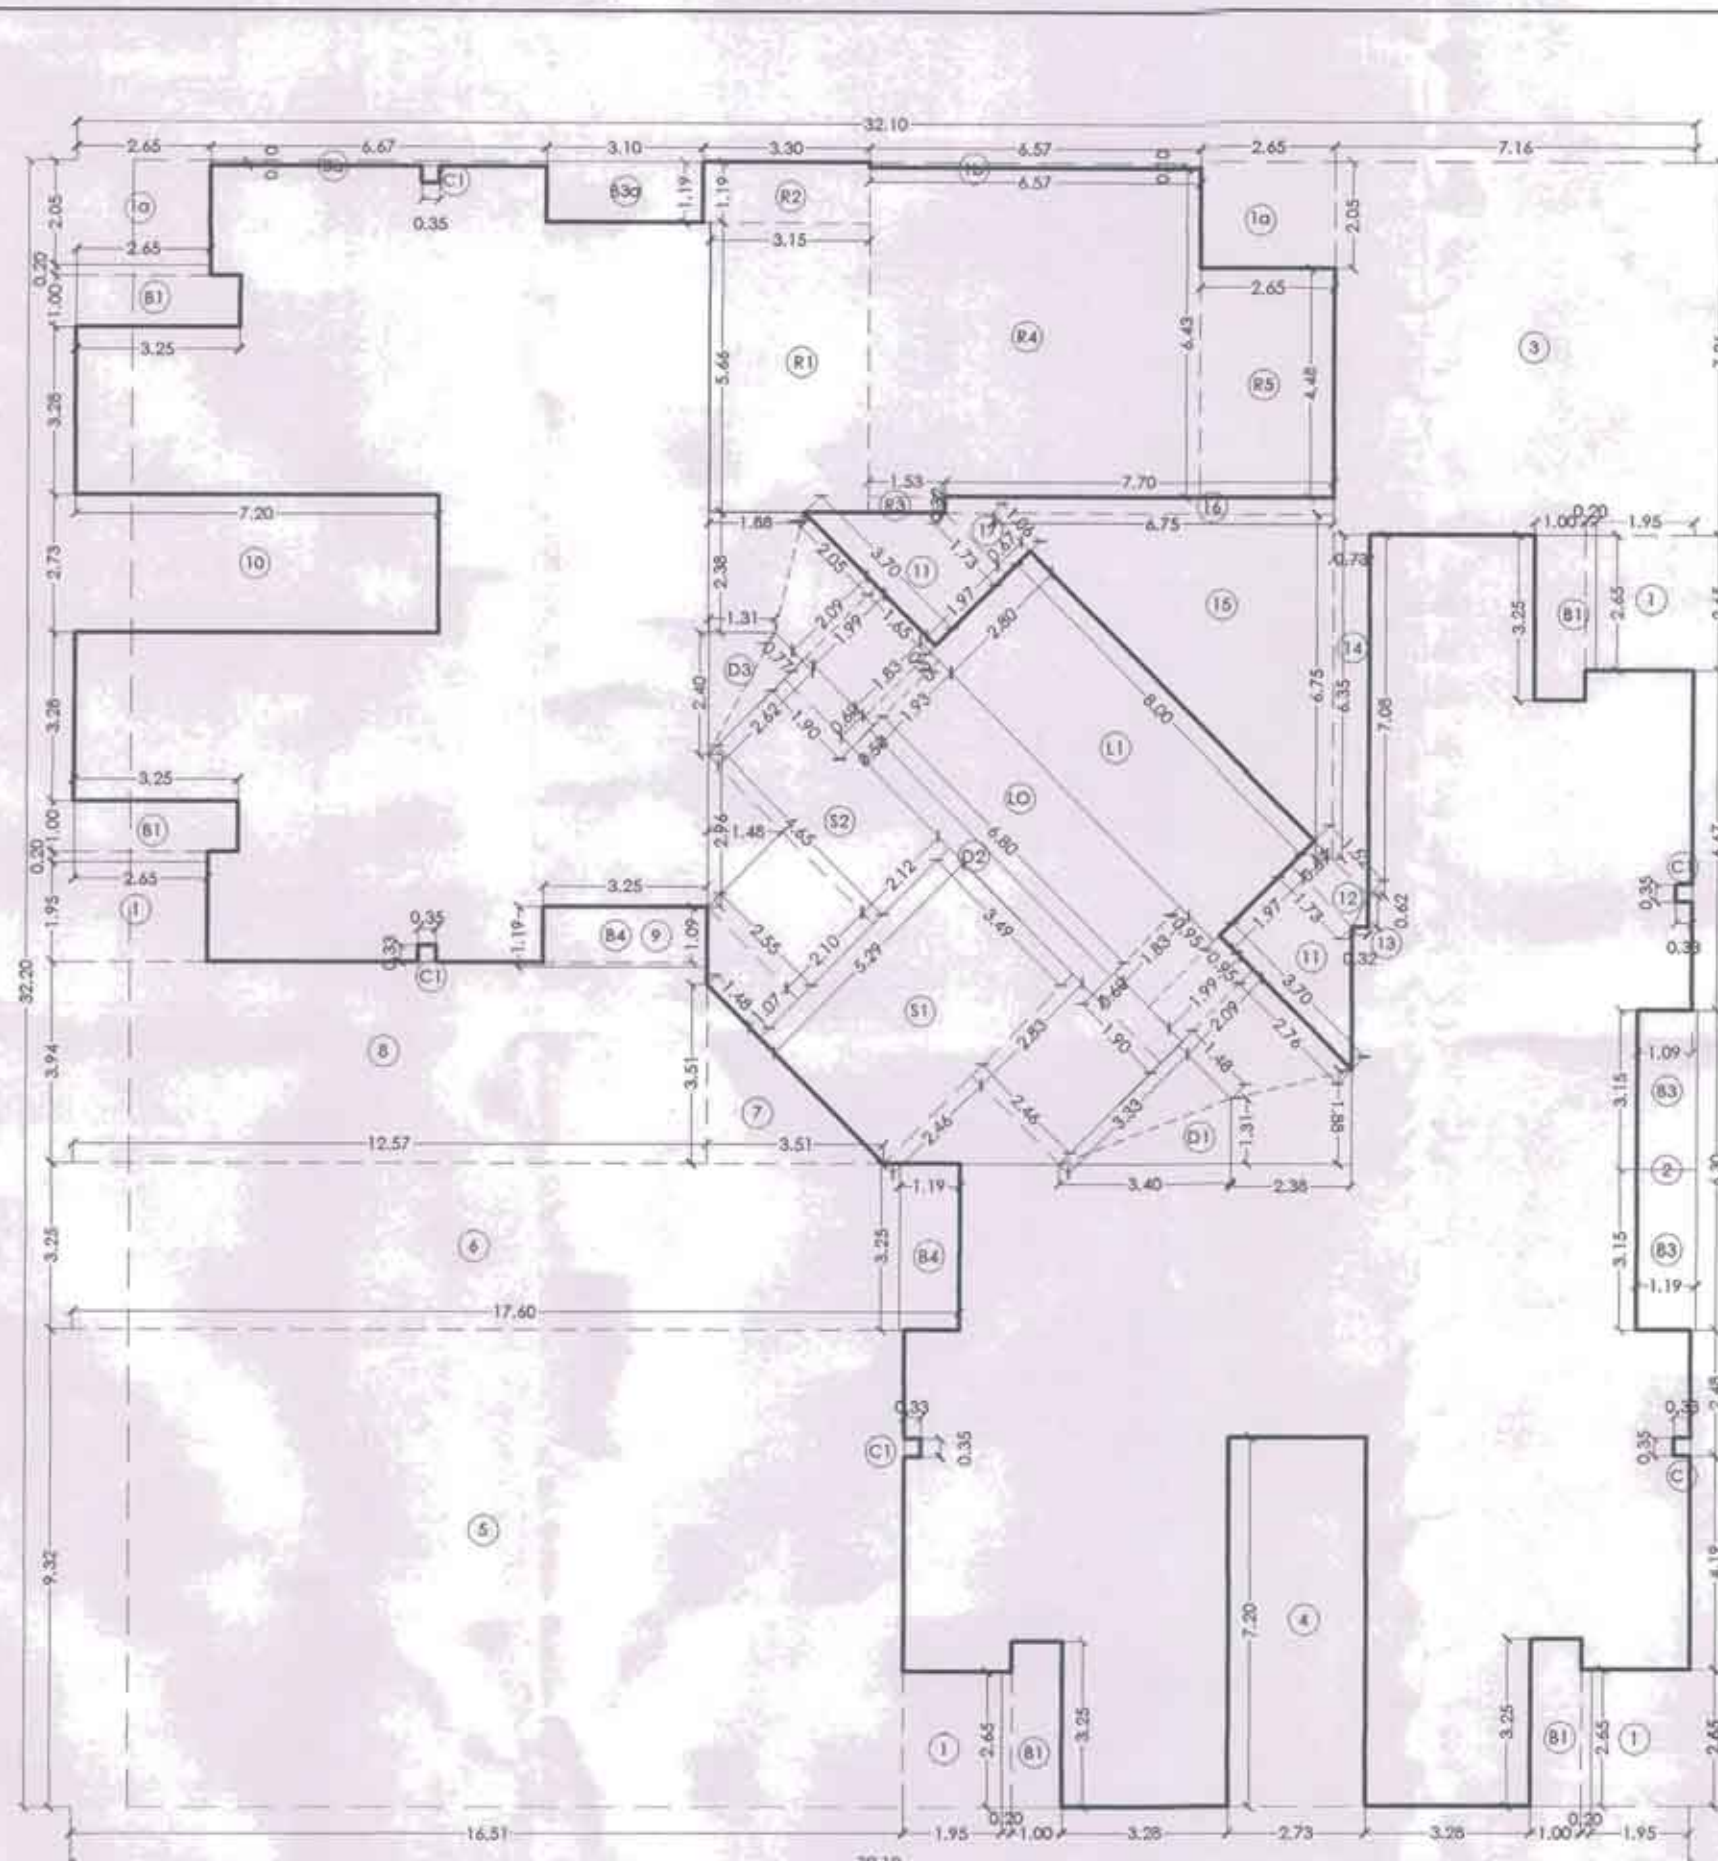

LINE AREA DIAGRAM FOR (BUILDING NO - 10-G1)
7TH, 12TH, 17TH, 22ND, 27TH & 32ND TYPICAL REFUGE FLOOR PLAN
SCALE = 1:100

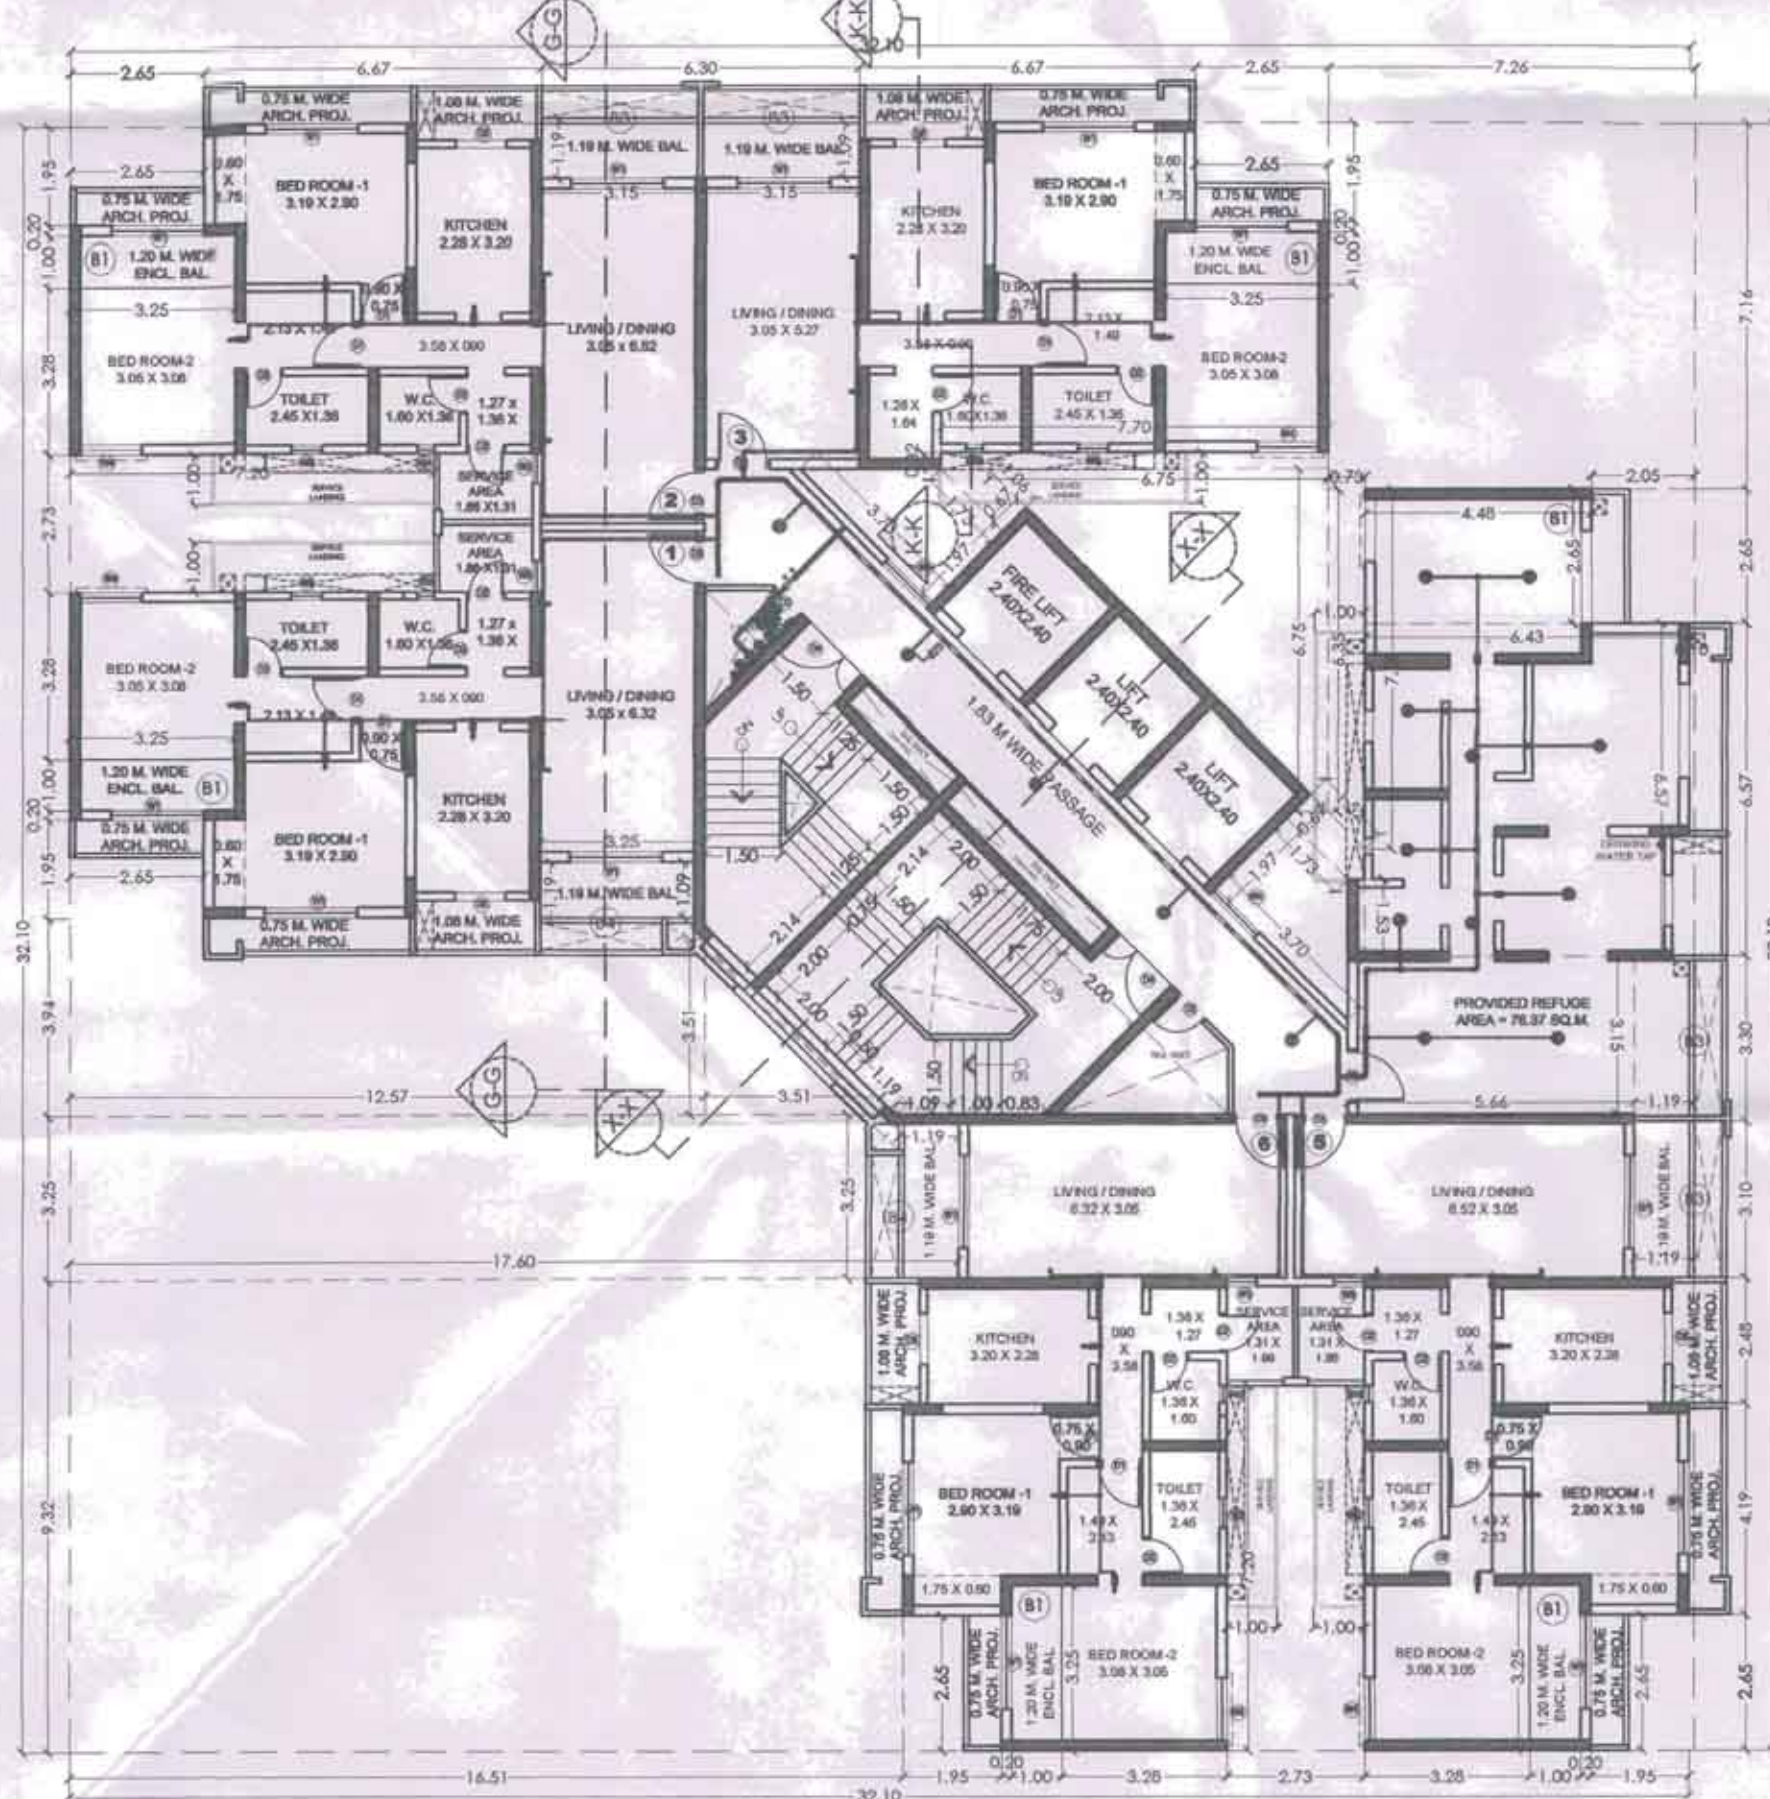

(BUILDING NO - 8-G1)
7TH, 12TH, 17TH, 22ND, 27TH & 32ND TYPICAL REFUGE FLOOR PLAN
SCALE = 1:100

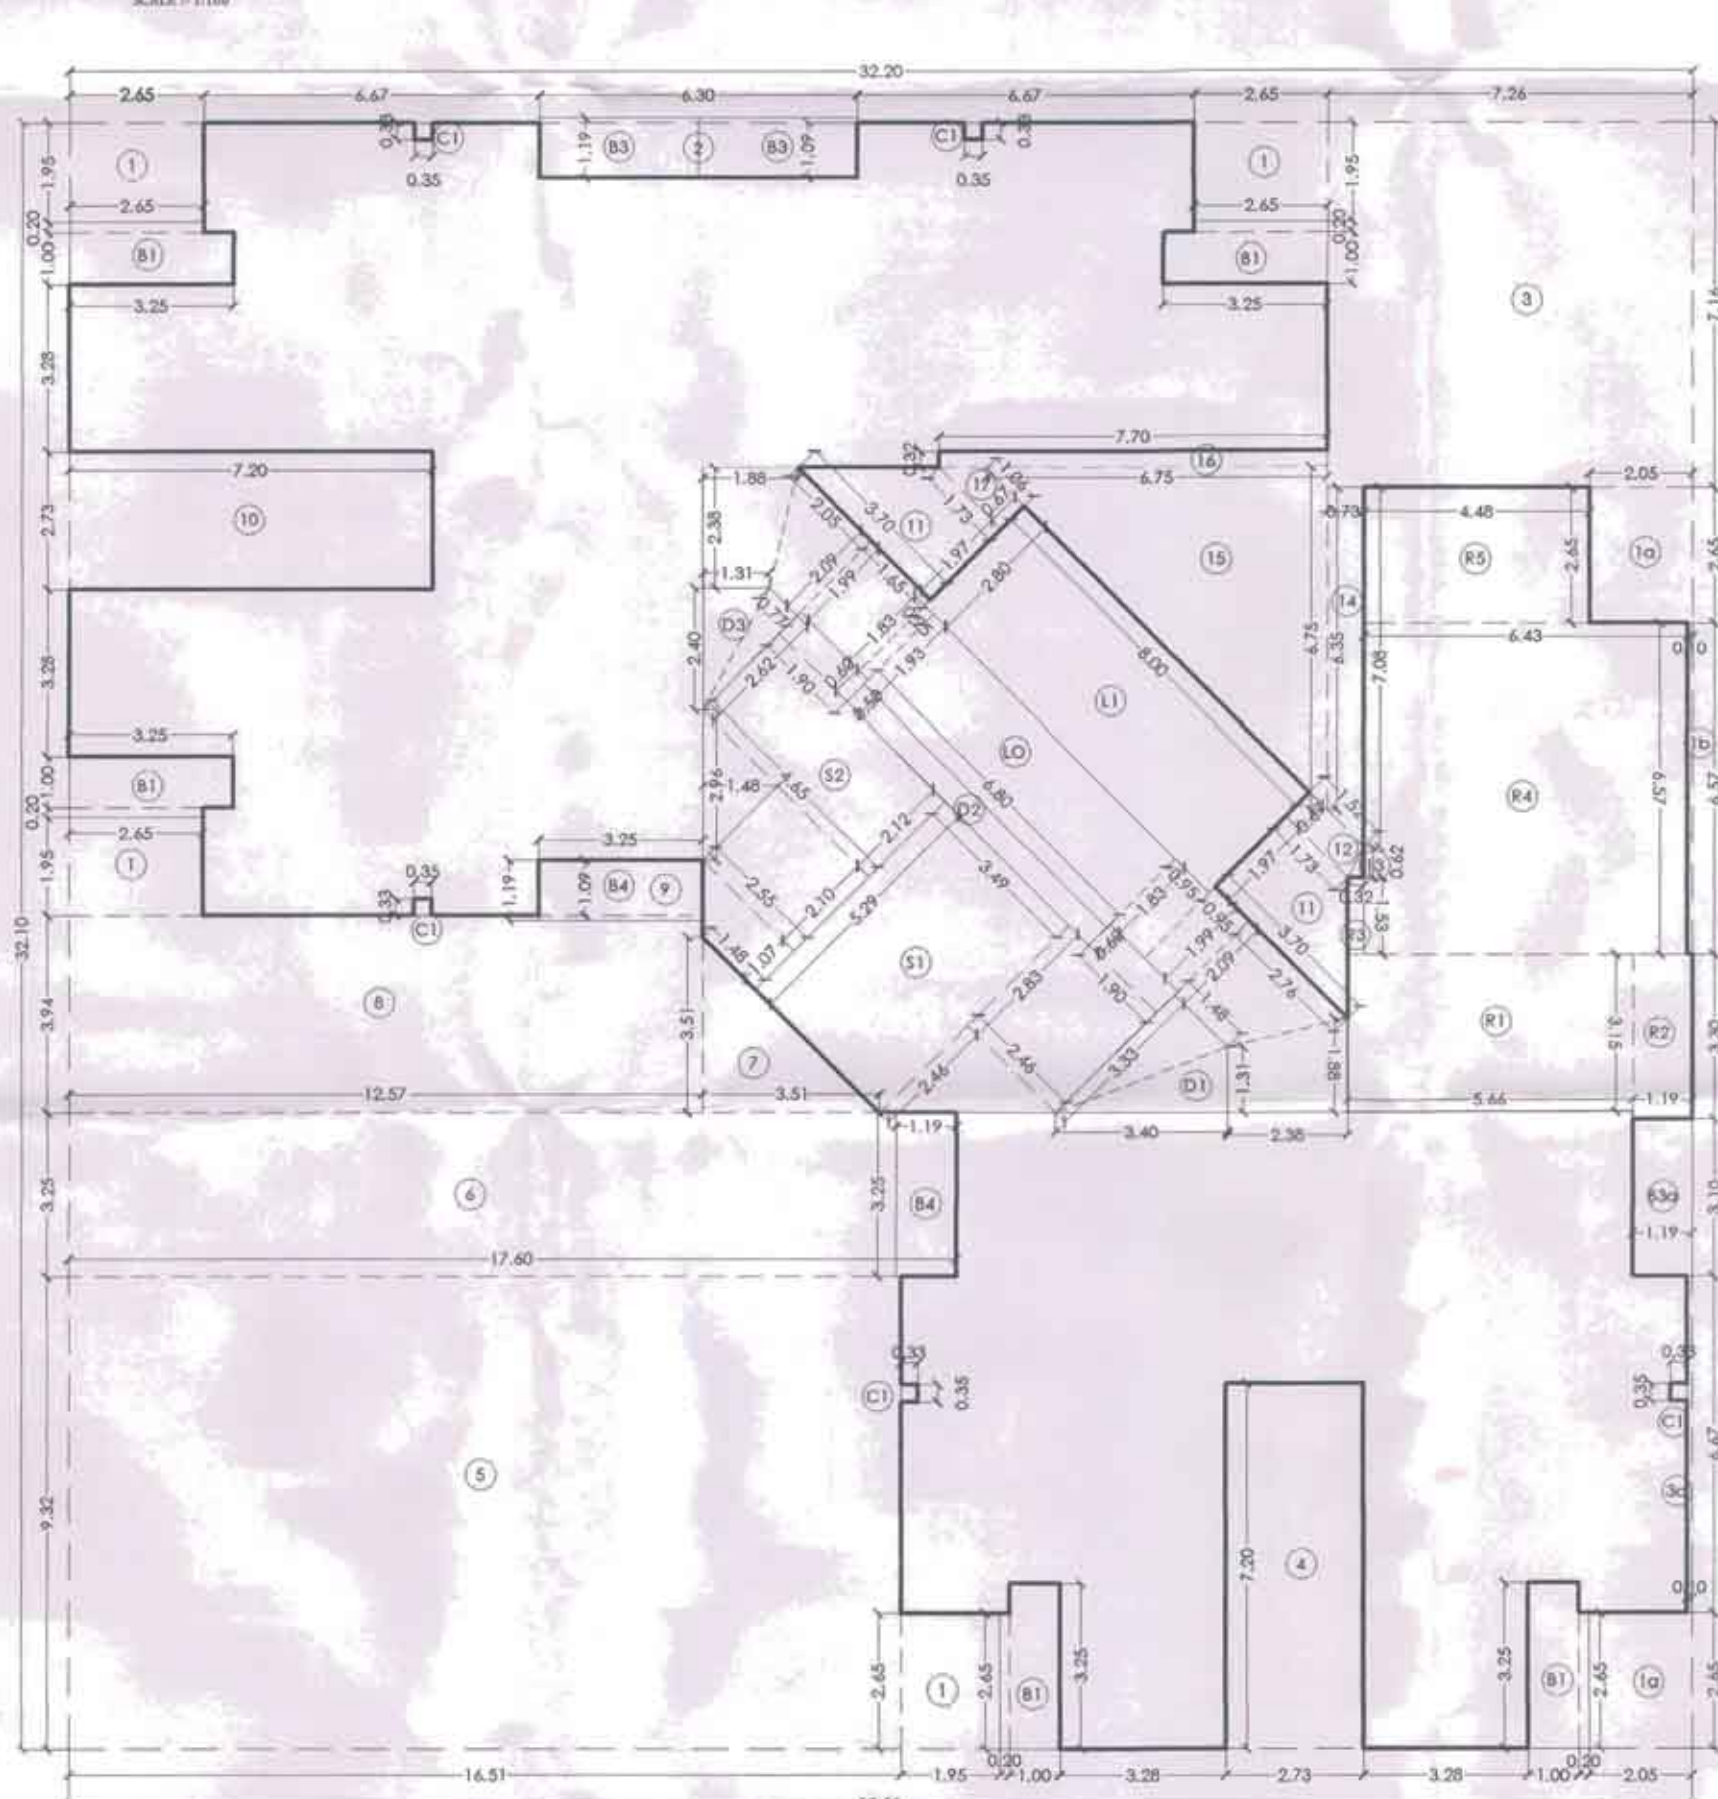

LINE AREA DIAGRAM FOR (BUILDING NO - 8-G1)
7TH, 12TH, 17TH, 22ND, 27TH & 32ND TYPICAL REFUGE FLOOR PLAN
SCALE = 1:100

BUILT UP AREA CALCULATION BUILDING NO - 10-G1									
7TH, 12TH, 17TH, 22ND, 27TH & 32ND TYPICAL REFUGE FLOOR PLAN									
ADDITION (X)	1	2	3	4	5	6	7	8	9
TOTAL	1033.62	1033.62	1033.62	1033.62	1033.62	1033.62	1033.62	1033.62	1033.62
DEDUCTION (Y)									
1	2.65	1.95	1	1	1	1	1	1	1
2	2.65	1.95	1	1	1	1	1	1	1
146	2.65	1.95							

CONTENTS OF SHEET


36TH LOWER DUPLEX FLOOR PLAN (BUILDING NO - B-G1 & 10-G1)
 37TH UPPER DUPLEX FLOOR PLAN (BUILDING NO - B-G1 & 10-G1)
 LINE AREA DIAGRAM CALCULATION & CARPET AREA STATEMENT
 SCHEDULE OF DOOR & WINDOW

STAMP AND DATE OF RECEIPT OF PLAN


AS BUILT DRAWING APPROVED
 Subject to the conditions mentioned
 in this office's letter No.:

CIDCON/NA/ PANVEL/Kon/BP-94/OC/2018/1633


Dated 11 MAY 2018
 Associate Planner (NA/NA)

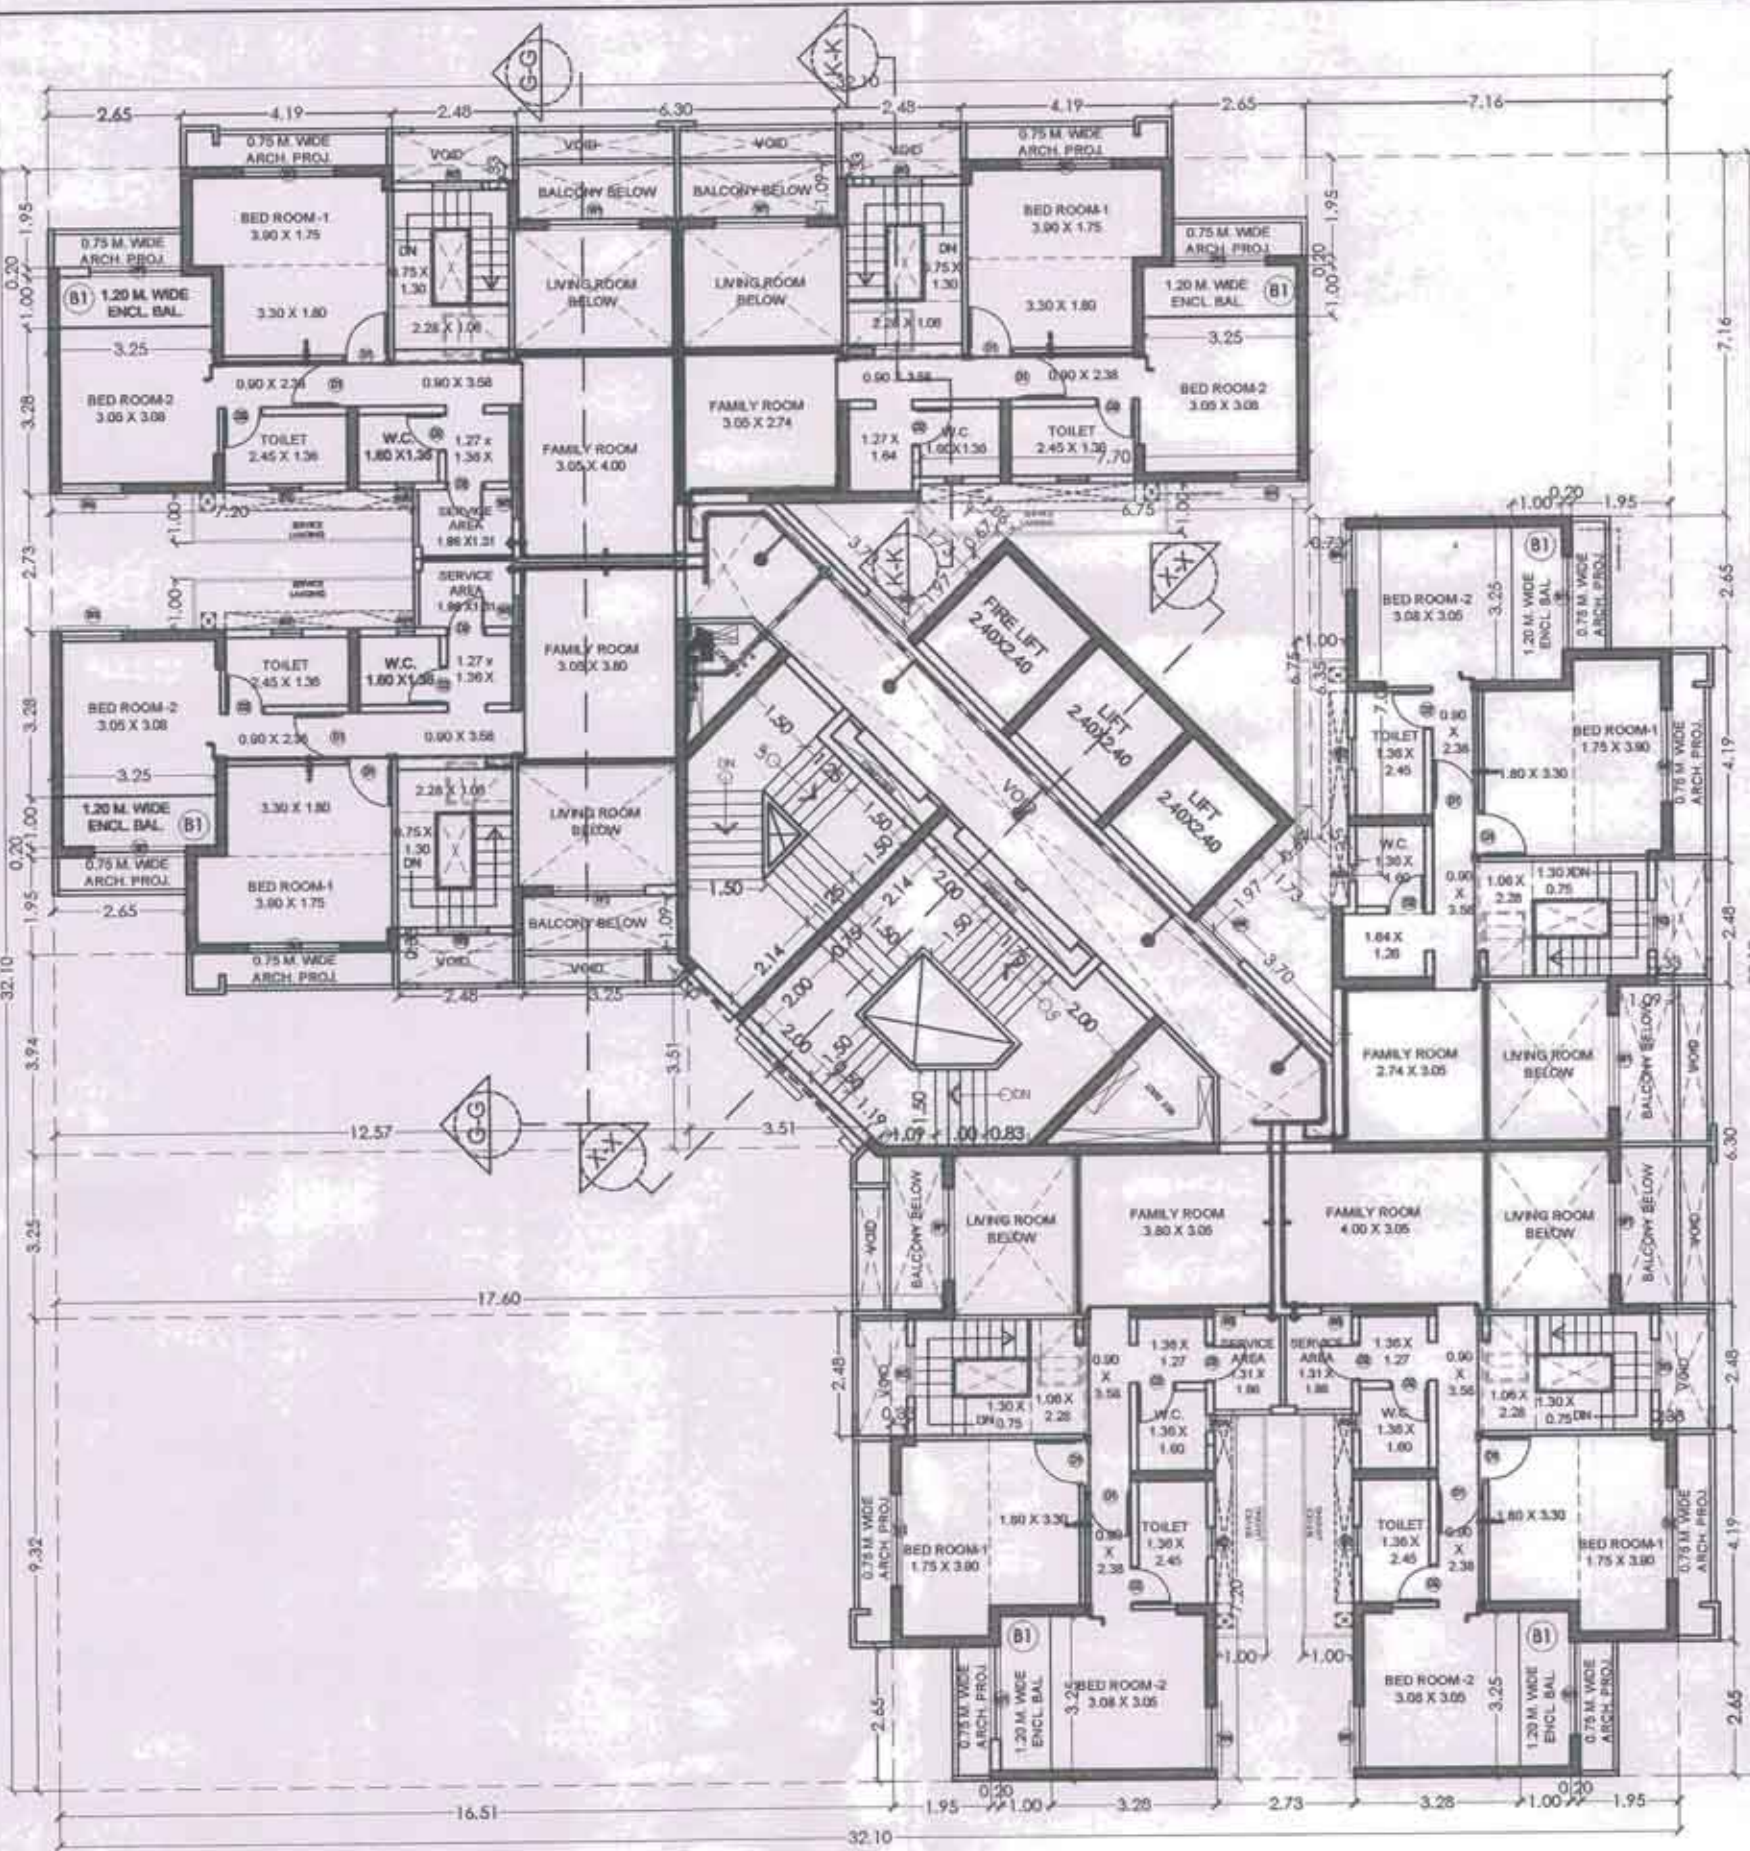


(BUILDING NO - B-G1 & 10-G1)
 37TH UPPER DUPLEX FLOOR PLAN
 SCALE: 1:500

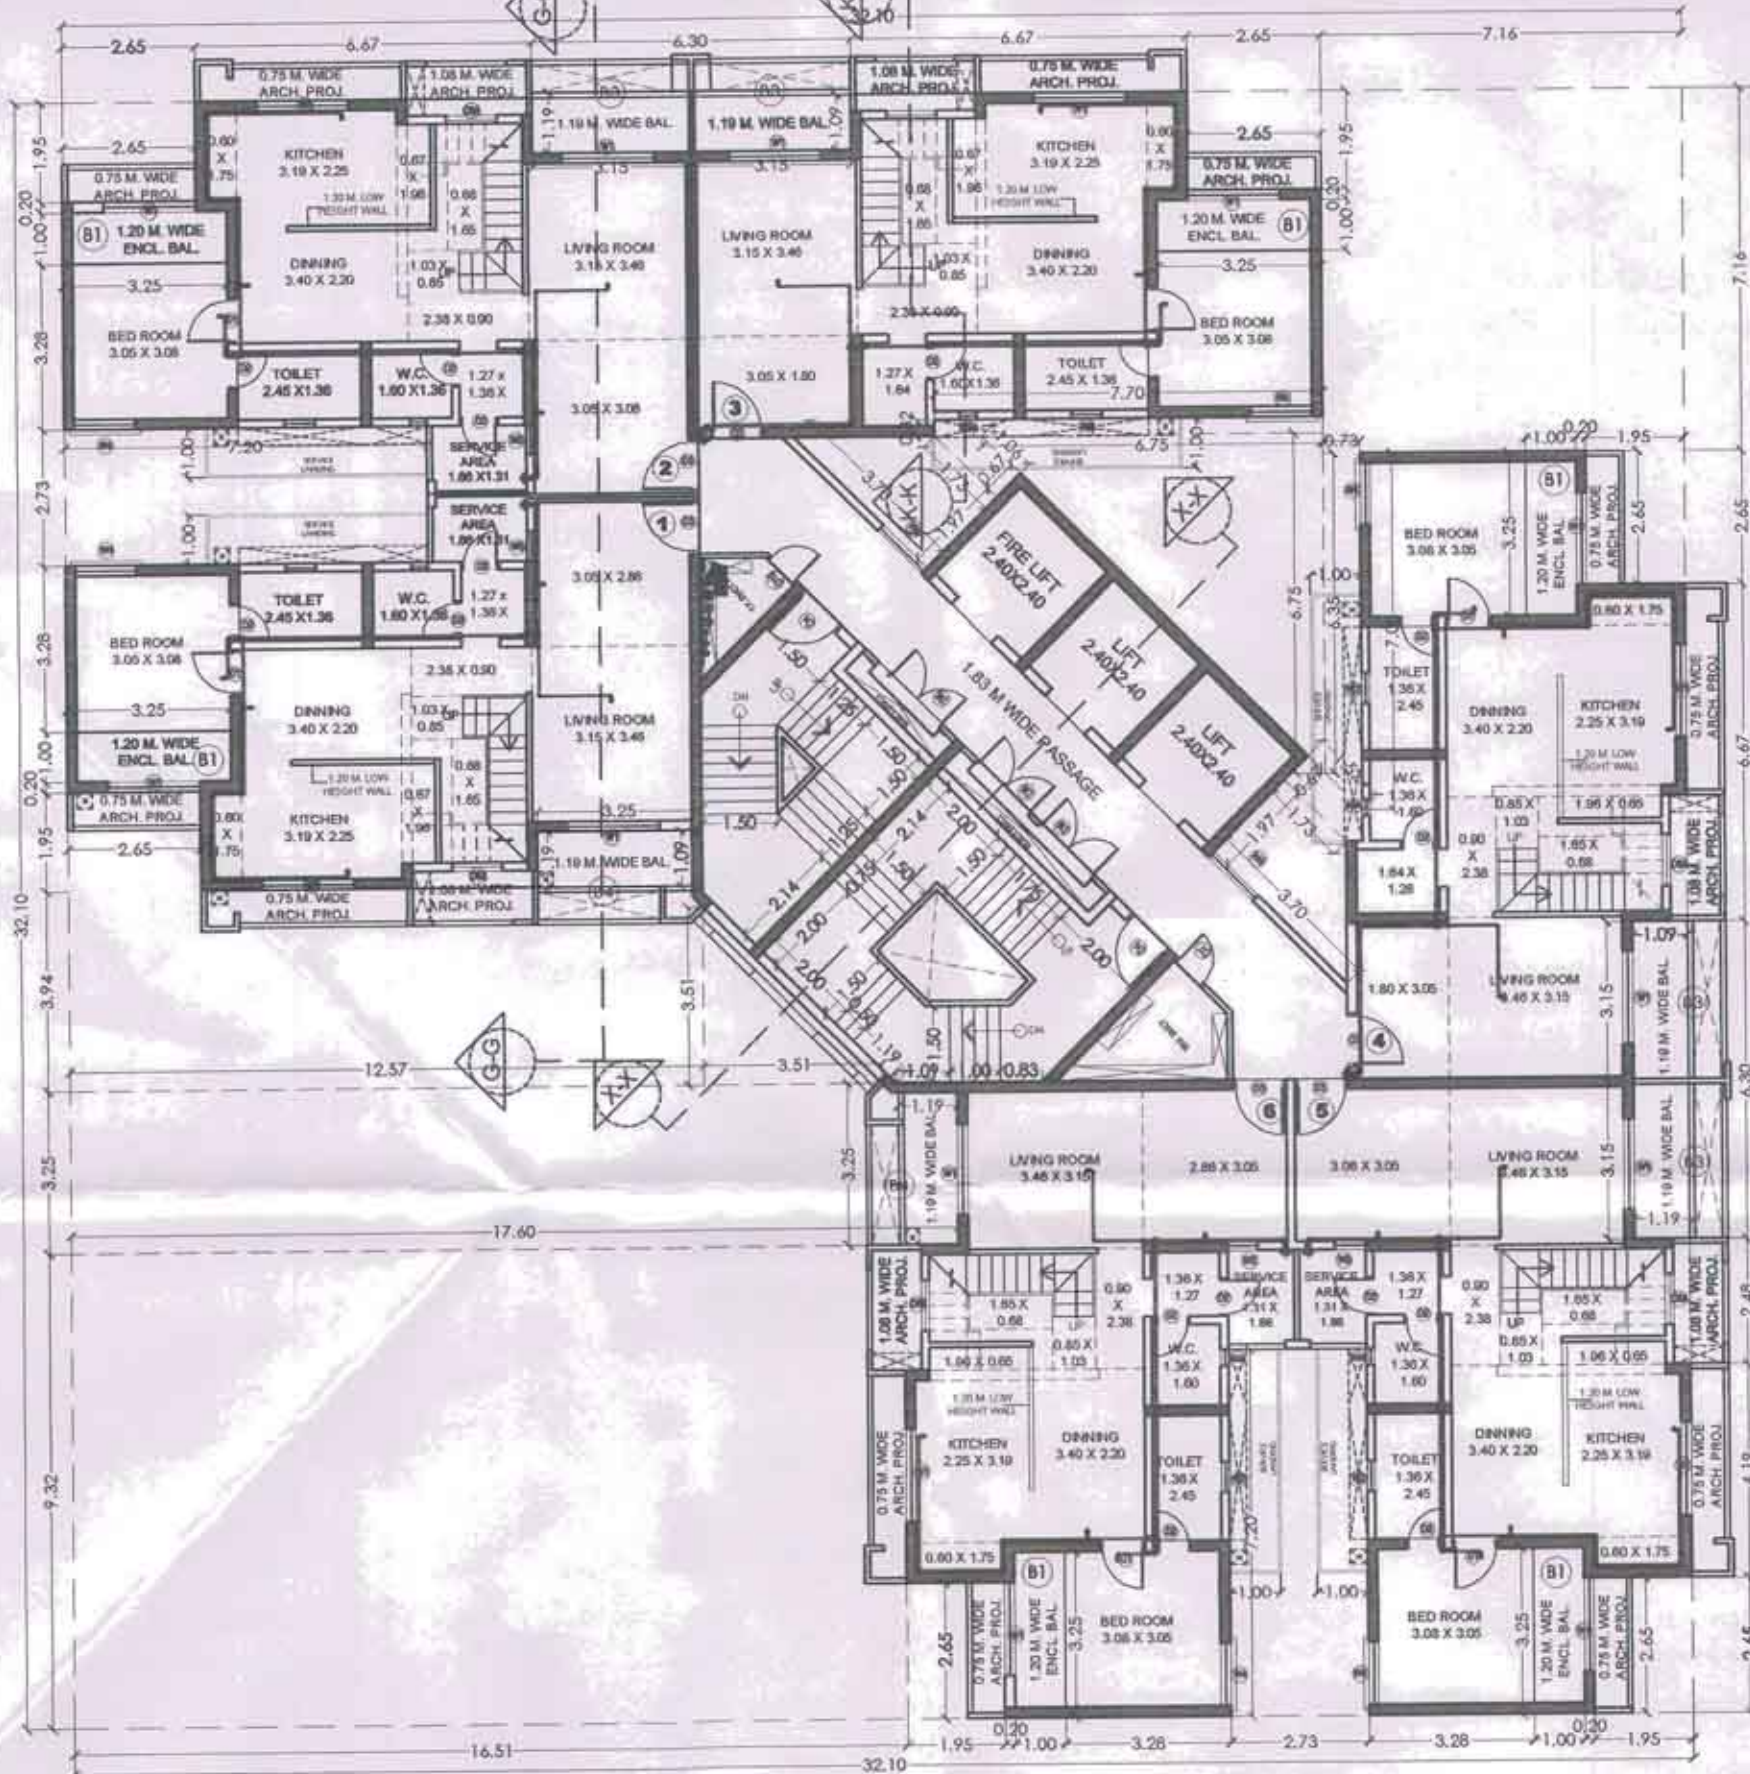


(BUILDING NO - B-G1 & 10-G1)
 36TH LOWER DUPLEX FLOOR PLAN
 SCALE: 1:500

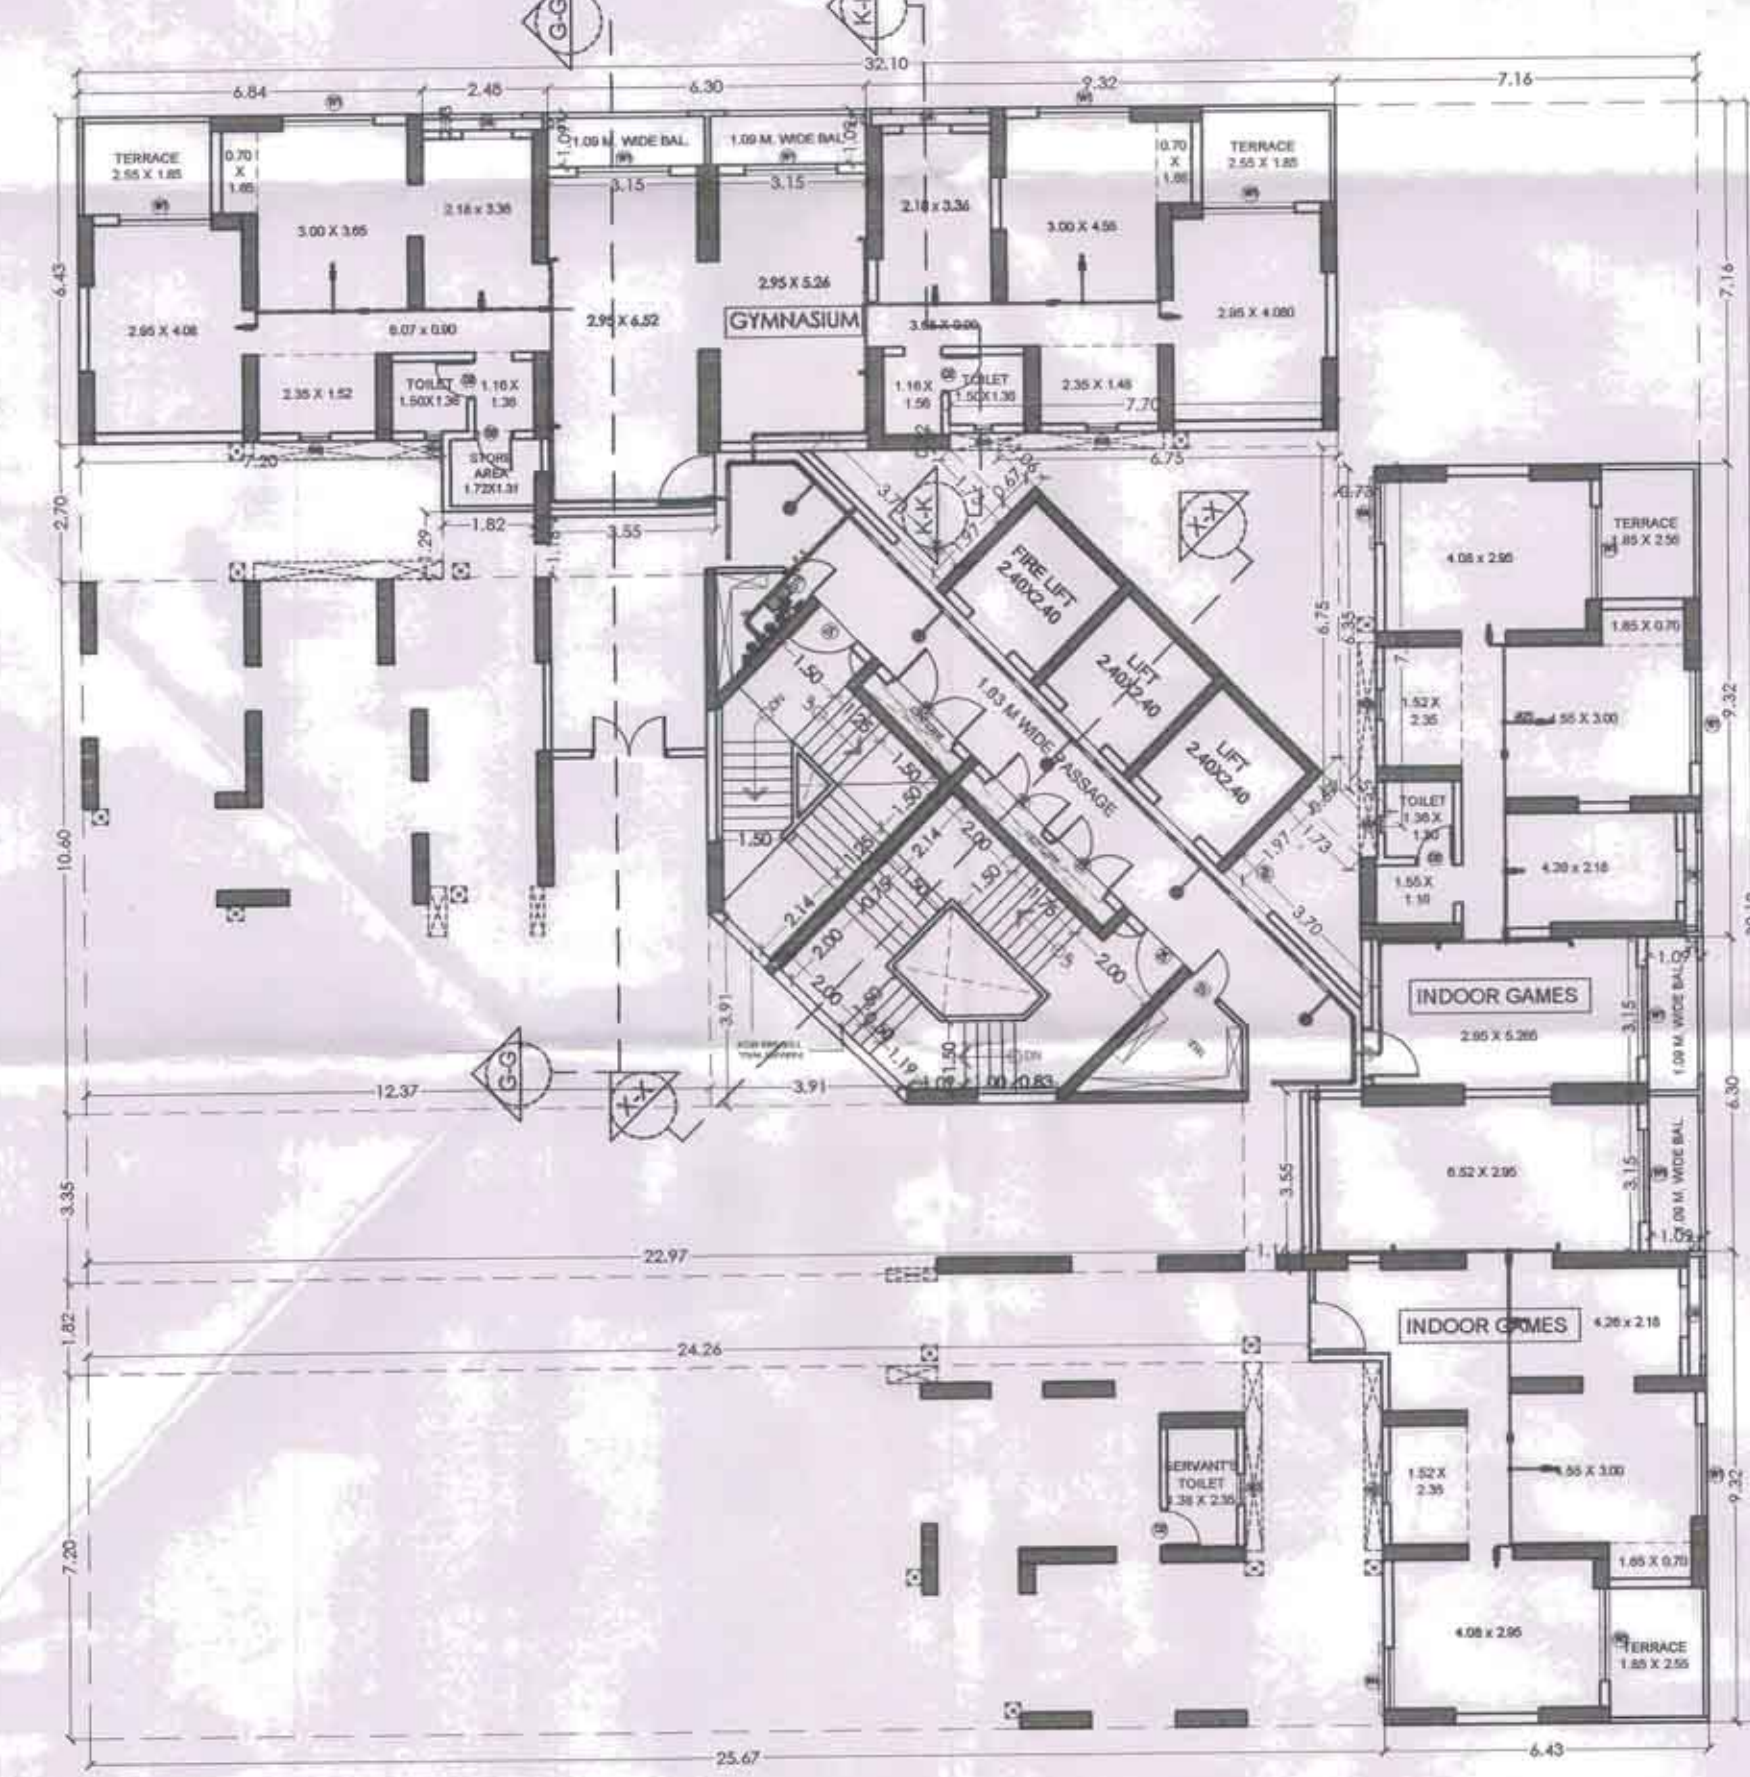


(BUILDING NO - 10-G1)
 STILT / 1ST PARKING FLOOR PLAN
 SCALE: 1:500

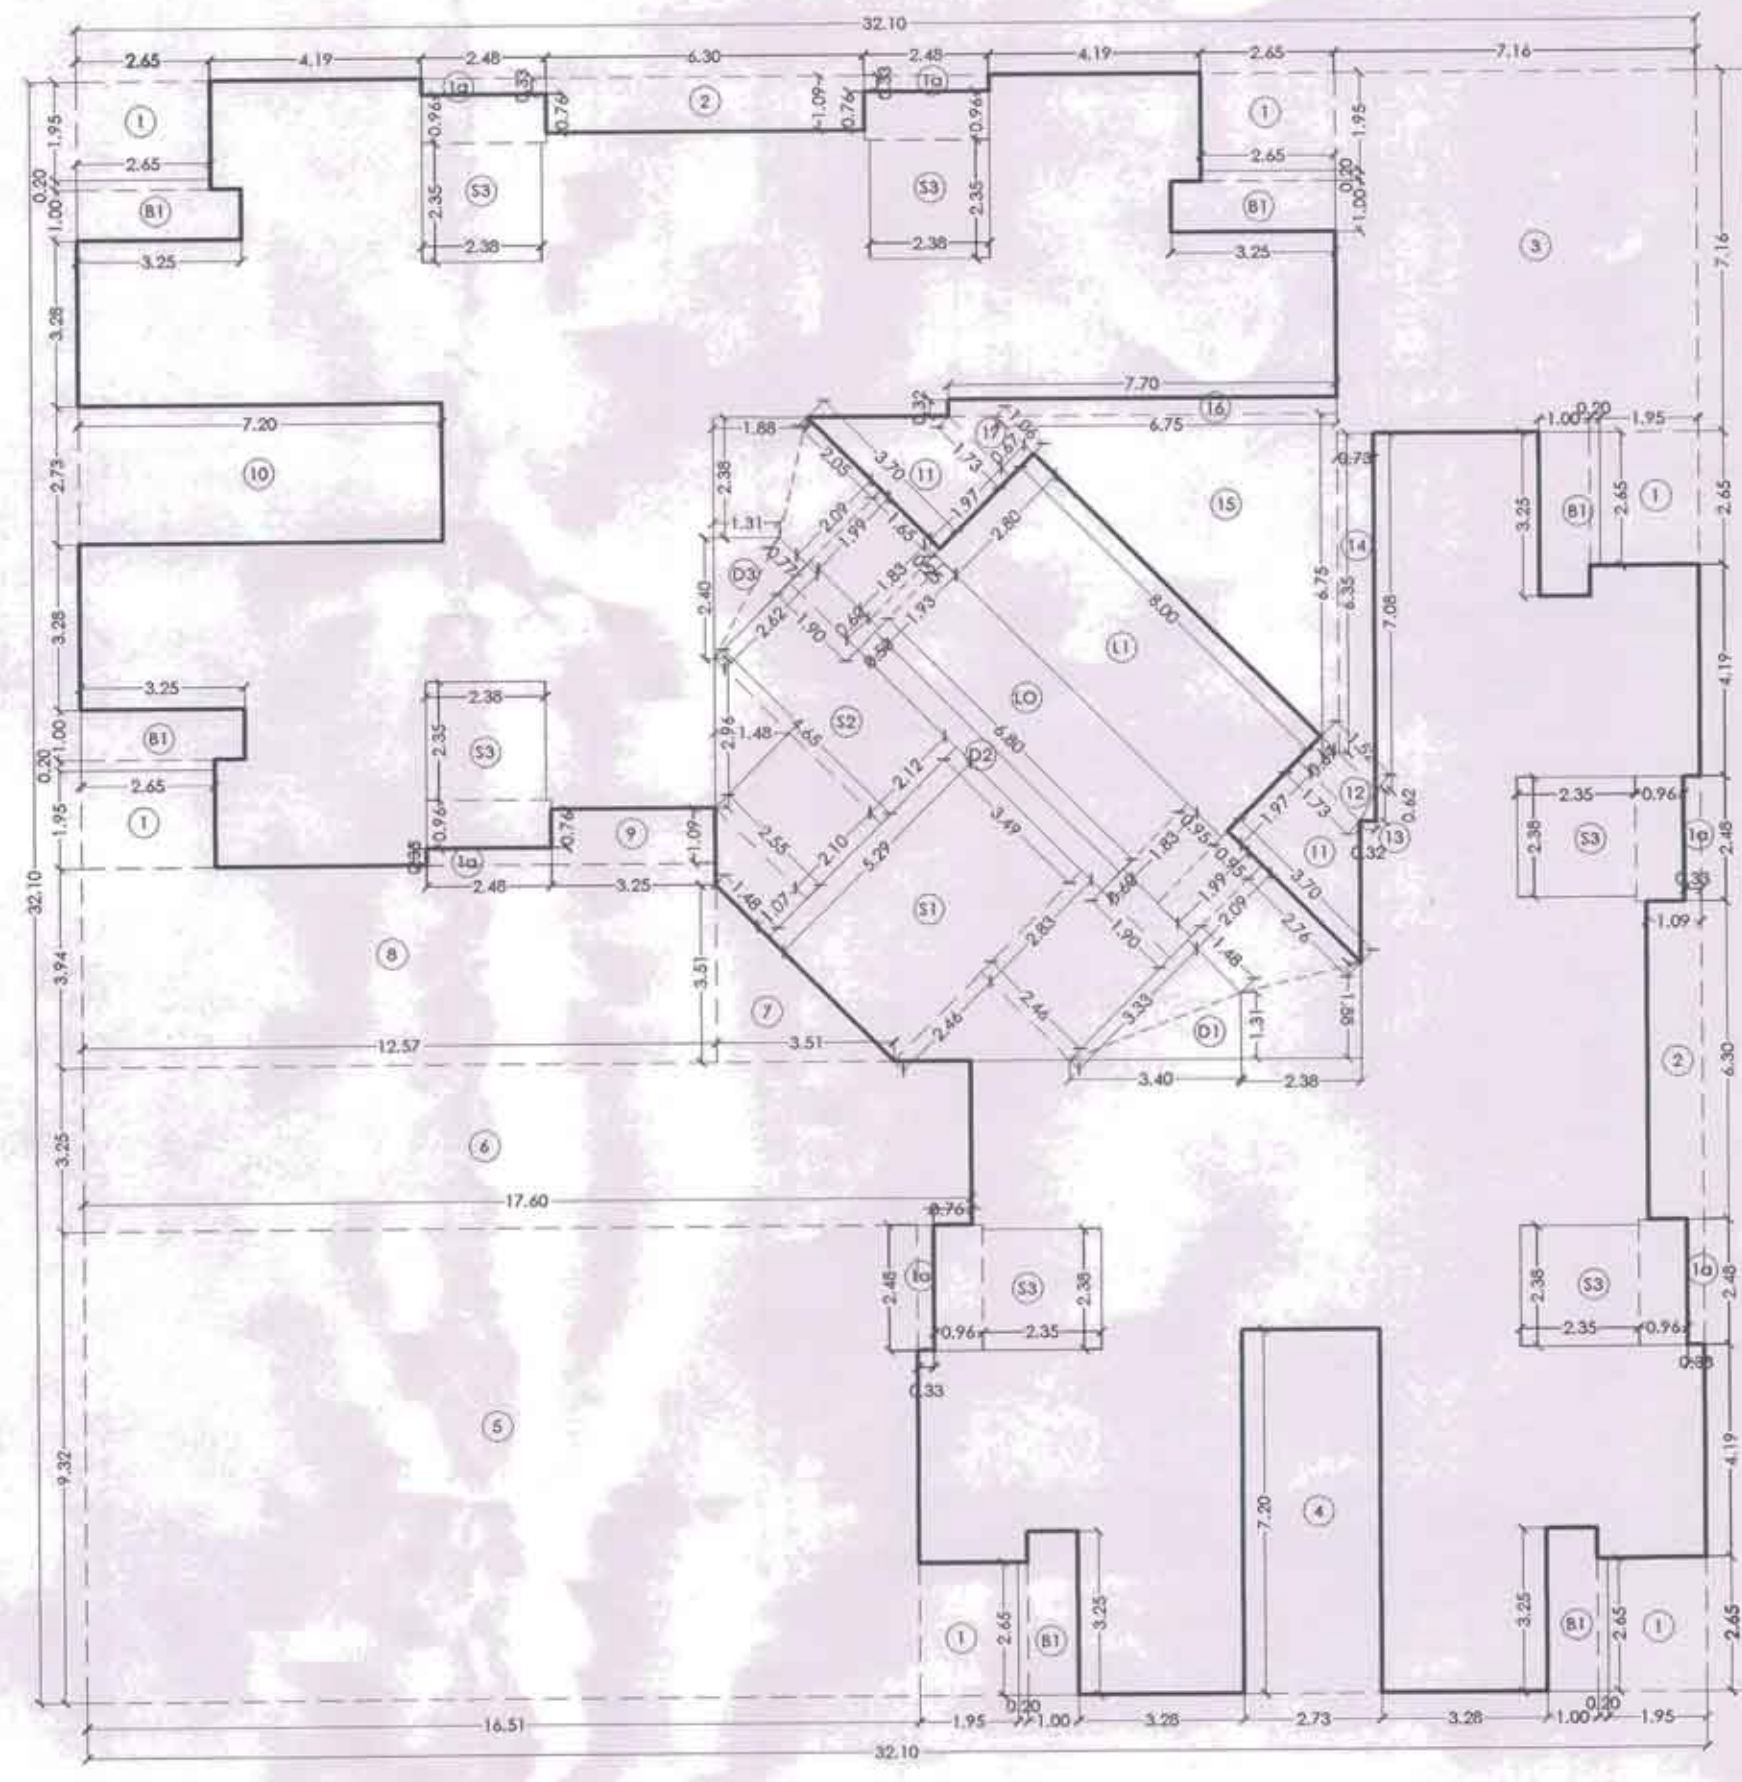

LINE AREA DIAGRAM FOR (BUILDING NO - B-G1 & 10-G1)
 37TH UPPER DUPLEX FLOOR PLAN
 SCALE: 1:500

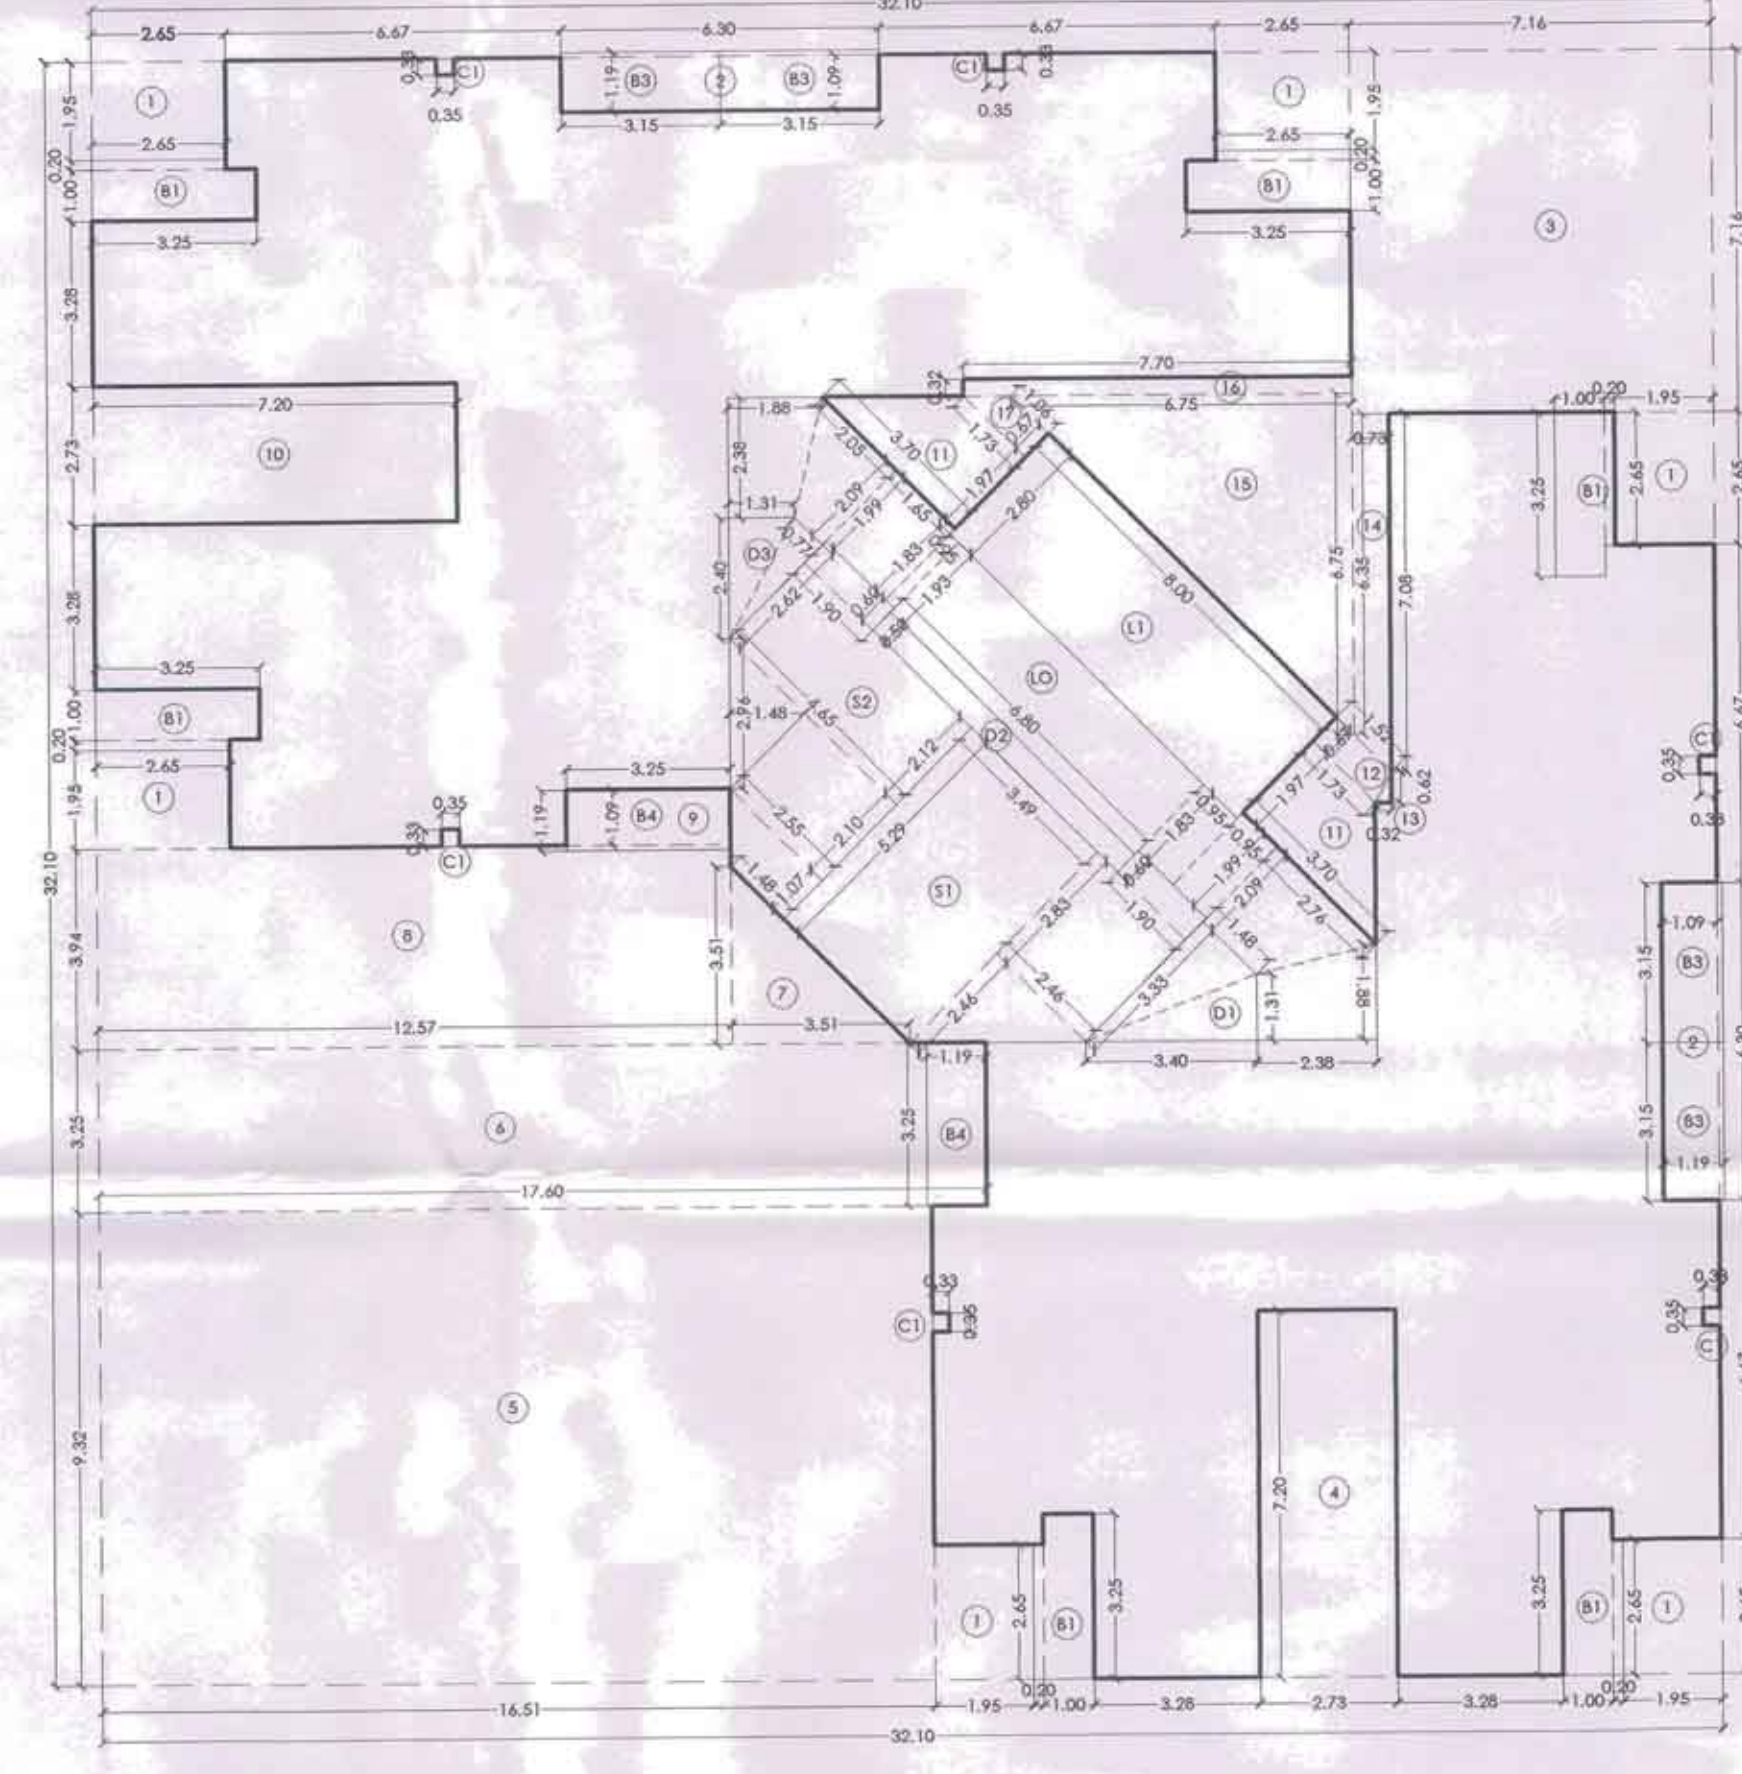

LINE AREA DIAGRAM FOR (BUILDING NO - B-G1 & 10-G1)
 36TH LOWER DUPLEX FLOOR PLAN
 SCALE: 1:500

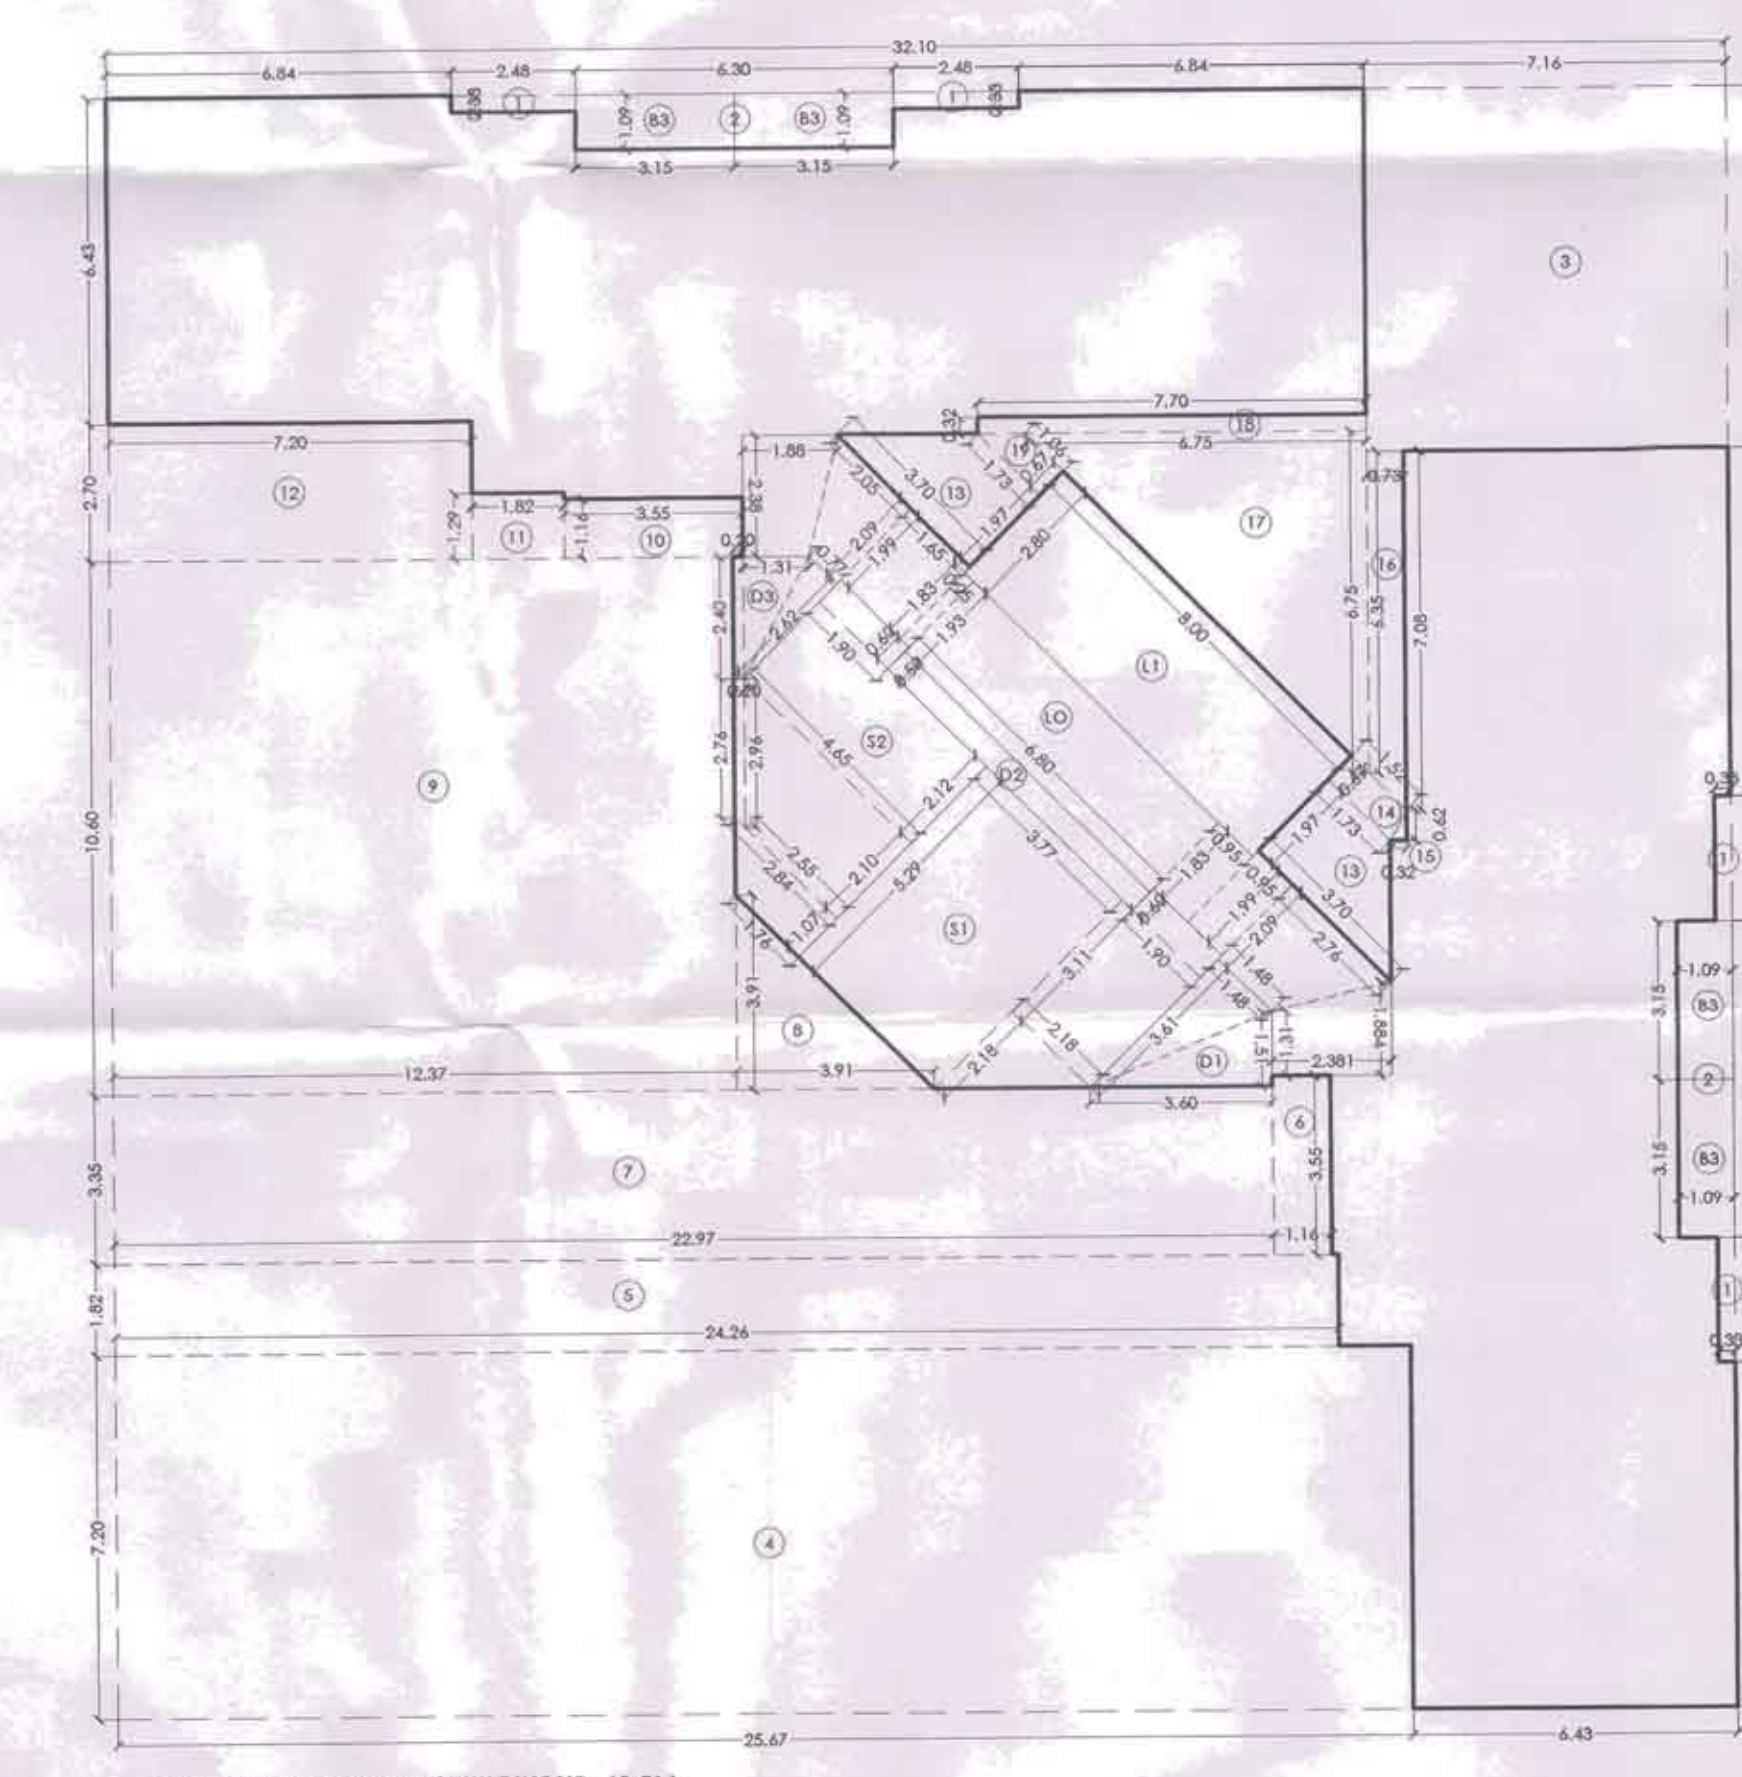

LINE AREA DIAGRAM FOR (BUILDING NO - 10-G1)
 STILT / 1ST PARKING FLOOR PLAN
 SCALE: 1:500

NO.	NO.	DESCRIPTION	UNIT	QTY
1	1	DOOR	NO.	1
2	2	DOOR	NO.	1
3	3	DOOR	NO.	1
4	4	DOOR	NO.	1
5	5	DOOR	NO.	1
6	6	DOOR	NO.	1
7	7	DOOR	NO.	1
8	8	DOOR	NO.	1
9	9	DOOR	NO.	1
10	10	DOOR	NO.	1
11	11	DOOR	NO.	1

DESCRIPTION OF PROPOSAL & PROPERTY
 PROPOSED DEVELOPMENT OF RETAIL HOUSING SCHEME ON LAYOUT
 BEARING S NO. 10/1, 10/2, 10/3, 10/4, 10/5, 10/6, 10/7, 10/8, 10/9, 10/10, 10/11,
 10/12, 10/13, 10/14, 10/15, 10/16, 10/17, 10/18, 10/19, 10/20, 10/21, 10/22,
 10/23, 10/24, 10/25, 10/26, 10/27, 10/28, 10/29, 10/30, 10/31, 10/32, 10/33,
 10/34, 10/35, 10/36, 10/37, 10/38, 10/39, 10/40, 10/41, 10/42, 10/43, 10/44,
 10/45, 10/46, 10/47, 10/48, 10/49, 10/50, 10/51, 10/52, 10/53, 10/54, 10/55,
 10/56, 10/57, 10/58, 10/59, 10/60, 10/61, 10/62, 10/63, 10/64, 10/65, 10/66,
 10/67, 10/68, 10/69, 10/70, 10/71, 10/72, 10/73, 10/74, 10/75, 10/76, 10/77,
 10/78, 10/79, 10/80, 10/81, 10/82, 10/83, 10/84, 10/85, 10/86, 10/87, 10/88,
 10/89, 10/90, 10/91, 10/92, 10/93, 10/94, 10/95, 10/96, 10/97, 10/98, 10/99,
 10/100, 10/101, 10/102, 10/103, 10/104, 10/105, 10/106, 10/107, 10/108, 10/109,
 10/110, 10/111, 10/112, 10/113, 10/114, 10/115, 10/116, 10/117, 10/118, 10/119,
 10/120, 10/121, 10/122, 10/123, 10/124, 10/125, 10/126, 10/127, 10/128, 10/129,
 10/420, 10/421, 10/422, 10/423, 10/424, 10/425, 10/426, 10/427, 10/428, 10/429,
 10/430, 10/431, 10/432, 10/433, 10/434, 10/435, 10/436, 10/437, 10/438

[illegible]

STAMP AND DATE OF RECEIPT OF PLAN

AS BUILT DRAWING APPROVED
The drawings and details mentioned
in this office's letter No.
CICCONARY PANVEL/KONB-84/002016/1653
Dated 11 MAY 2018
Approved
Associate Planner (N/AHA)

27TH FLOOR
① +113.50 M A.L.
② +113.40 M A.L.

28TH FLOOR
① +113.50 M A.L.
② +113.40 M A.L.

29TH FLOOR
① +113.50 M A.L.
② +113.40 M A.L.

LIFT SHAFT

27TH FLOOR
① +113.50 M A.L.
② +113.40 M A.L.

28TH FLOOR
① +113.50 M A.L.
② +113.40 M A.L.

29TH FLOOR
① +113.50 M A.L.
② +113.40 M A.L.

[illegible][illegible]

Architectural site plan of a residential development. The plan shows a large rectangular lot divided into several sections. At the top is a 'REAR YARD' with a 'HARDENED SURF' area. Below this is a 'REAR PORCH' and a 'REAR PATIO'. The central part of the lot contains a 'GARAGE' and a 'DRIVE' leading to a 'FRONT PORCH'. The front of the lot features a 'FRONT PORCH' and a 'FRONT PATIO'. The plan also shows a 'SIDE PORCH' and a 'SIDE PATIO'. Various dimensions are provided for different areas, such as '10'0" x 10'0"' for the front porch and '10'0" x 10'0"' for the side porch. A north arrow is located in the upper right corner. A scale bar indicates '1" = 10'0"'. The plan also includes a table with the following information:

NO.	DATE	BY	FOR	SCALE	REVISIONS
1	12/12	AMC	AMC	1" = 10'0"	
2	12/12	AMC	AMC	1" = 10'0"	
3	12/12	AMC	AMC	1" = 10'0"	
1	12/12	AMC	AMC	1" = 10'0"	
2	12/12	AMC	AMC	1" = 10'0"	
3	12/12	AMC	AMC	1" = 10'0"	
1ST BASEMENT FLOOR	-3.62 M LVL
2ND BASEMENT FLOOR	-5.42 M LVL
3RD BASEMENT FLOOR	-7.22 M LVL

NAME OF THE OWNER
M/S LUCINA LAND DEVELOPMENT LIMITED.

SIGNATURE

NAME, ADDRESS AND SIGNATURE OF ARCHITECT (L.S.)	SIGNATURE
--	------------------

Octave Consultants

Architects and Planning Consultants
 10th Floor, 100, Market Street, Market Street
 International Finance Centre, Tower 1, 100, Market Street
 Singapore 048933

SECTION - J - J (BLDG. - 9-C1) (37 FLOOR)

SCALE: 1:100

SECTION - J - J (BLDG. - 8-C1) (37 FLOOR)

SCALE: 1:100

SECTION - Y - Y (BLDG. - 9-C1 & 20-C1) (37 FLOOR)

SCALE: 1:100

SECTION - X - X (BLDG. - 8-G1 & 10-G1) (37 FLOOR)

SCALE: 1:100

SECTION - J - J (BLDG. - 20-C1) (37 FLOOR)

SCALE: 1:100

SECTION - G - G (BLDG. - 8-G1 & 10-G1) (37 FLOOR)

SCALE: 1:100

PART SECTION K-K (BLDG. - 8-G1 & 10-G1)

SCALE: 1:100

SECTION - G - G (BLDG. - 8-G1 & 10-G1) (37 FLOOR)

SCALE: 1:100

