

RENTAL BLDG

TENEMENT STATEMENT (RENTAL BLDG.)

BLDG. NO./TYPE	RENTAL UNIT (I)	BALWADI (II) (1 PER 200 UNITS)		WELFARE CENTER (III) (1 PER 200 UNITS)		METER ROOM (IV)	MANAGER ROOM (V) (1 PER 500 UNITS)		LETTER BOX (VI)	CONV. SHOP (VII)	CONV. SHOP AREA IN SQ.MT (VIII)	TOTAL (I+VII)
		REQ.	PROP.	REQ.	PROP.		REQ.	PROP.				
BLDG. NO. - 3	528	3	3	3	3	1	1	1	1	4	80.947	532
BLDG. NO. - 4	388	2	2	2	2	1	1	2	1	0	0.000	388
TOTAL	916	5	5	5	5	2	2	3	2	4	80.947	920

RENTAL R.G. AREA			
R.G. AREA STATEMENT			
TOTAL R.G. REQUIRED	8766.60	X	8.0%
R.G. PROVIDED		=	701.33
R.G. 1		=	404.14
R.G. 2		=	362.31
TOTAL R.G. PROVIDED		=	766.45

AMENITY SPACE (5%)	
RENTAL BUILDING	
REQUIRED	PROVIDED
461.38 SQ.MTS	461.38 SQ.MTS

COMMERCIAL AREA	
RENTAL BUILDING	
REQUIRED (15%)	PROVIDED (0.69%)
5259.960 SQ.MTS	242.841 SQ.MTS

BUILT UP AREA SUMMARY APPLIED FOR OCCUPATION CERTIFICATE (OC) RENTAL BLDG AS PER APPROVAL OF DIST. COLLECTOR RAIGAD DATED 05-09-2012

FLOORS	BLDG 3	BLDG 4
GR. FLOOR	218.010	0.000
1st FLOOR	648.354	582.817
2nd FLOOR	648.354	582.817
3rd FLOOR	648.354	582.817
4th FLOOR	648.354	582.817
5th FLOOR	648.354	582.817
6th FLOOR	648.354	582.817
7th FLOOR (REFUGE)	545.153	411.889
8th FLOOR	648.354	582.817
9th FLOOR	648.354	582.817
10th FLOOR	648.354	582.817
11th FLOOR	648.354	582.817
12th FLOOR (REFUGE)	545.153	411.889
13th FLOOR	648.354	0.000
14th FLOOR	648.354	0.000
TOTAL	9088.56	6651.95
TOTAL B.U. AREA	15740.51	

SALE BLDG AREA STATEMENTS

B. U. AREA SUMMARY (SALE BLDG.)	
FLOORS	BLDG NO. 2, WING I, J & K
1st FLOOR	315.44
2nd FLOOR	315.44
3rd FLOOR	315.44
4th FLOOR	315.44
5th FLOOR	315.44
6th FLOOR	315.44
7th FLOOR	315.44
8th FLOOR	315.44
9th FLOOR	315.44
10th FLOOR	315.44
11th FLOOR	315.44
12th FLOOR	315.44
13th FLOOR	315.44
14th FLOOR	315.44
15th FLOOR	315.44
16th FLOOR	315.44
17th FLOOR	315.44
18th FLOOR	315.44
19th FLOOR	315.44
20th FLOOR	315.44
21st FLOOR	315.44
22nd FLOOR	315.44
23rd FLOOR	315.44
24th FLOOR	315.44
25th FLOOR	315.44
26th FLOOR	315.44
27th FLOOR	315.44
28th FLOOR	315.44
29th FLOOR	315.44
30th FLOOR	315.44
TOTAL	9182.96
NO. OF BLDG	3.00
TOTAL AREA	27548.88

AMENITY SPACE (5%)	
SALE BUILDING	
REQUIRED	PROVIDED
1384.13 SQ.MTS	1384.13 SQ.MTS

PROVIDED PARKING STATEMENT				
FLOORS	BIG CAR	SMALL CAR	TOTAL CAR	TWO WHEELER
BASEMENT1	242	62	304	50
BASEMENT2	246	62	308	50
GROUND	172	81	253	60
P1 FLOOR	176	81	257	60
P2 FLOOR	151	31	182	0
P3 FLOOR	38	35	73	0
P4 FLOOR	148	38	186	0
P5 FLOOR	164	45	209	0
TOTAL	1337	435	1772	220


SALE R.G. AREA STATEMENT (IN SQ.MT.)			
TOTAL R.G. REQUIRED	26297.9	X	8.0%
R.G. PROVIDED (ON GROUND)		=	2103.83
R.G. 1		=	331.11
R.G. 2		=	531.11
R.G. 3		=	401.73
R.G. 4		=	1508.91
TOTAL R.G. PROVIDED (GR.)		=	2772.86
R.G. PROVIDED (ON PODIUM)		=	1562.84
TOTAL R.G. PROVIDED (GR + PODIUM)		=	4335.70

PLOT AREA SUMMARY (AS PER 7/12 EXTRACT)			
SURVEY NO.	HISSA NO.	VILLAGE NAME	AREA (IN SQ.MTS.)
173	0	AAKURLI	13810
45	2	SHILOTER RAICHUR	23100
TOTAL			36910

REQUIRED PARKING AREA STATEMENT (FOR BUILDING NO.2, WING I, J & K)				
AREA (CARPET AREA)	PARK. REQD.	NO. OF FLATS	NO. OF CARS	
UPTO 35.00 SQ.MT.	1 FOR 4 FLATS	510	128	
35.00 TO 45.00 SQ.MT.	1 FOR 2 FLATS	180	90	
45.00 TO 60.00 SQ.MT.	1 FOR 1 FLATS	0	0	
MORE THAN 60.00 SQ.MT.	2 FOR 1 FLATS	0	0	
TOTAL		690	218	
10% VISITORS PARKING			22	
TOTAL PARKING REQUIRED			240	
REQUIRED 10% TWO WHEELER PARKING			22	
TOTAL PARKING PROVIDED			240	

PROVIDED PARKING STATEMENT (FOR SALE COMPONENT) (BLDG. I, J & K)				
FLOORS	BIG CAR	SMALL CAR	TOTAL CAR	TWO WHEELER
GROUND	40	40	80	13
P1 FLOOR	40	47	87	4
P2 FLOOR	32	41	73	5
TOTAL	112	128	240	22

TENANTS STATEMENT (SALE BLDG NO.2, WING I, J & K)									
BLDG.	NO. OF FLATS	NO. FLOORS	TOTAL	TOTAL FLATS	UPTO 35	35 TO 45	45 TO 60	MORE THAN 60	
I	TYPICAL	8	25	200	230	150	50	0	0
J	REFUGE	8	5	30	20	10	0	0	0
J	TYPICAL	8	25	200	230	150	50	0	0
K	REFUGE	8	5	30	20	10	0	0	0
K	TYPICAL	8	25	200	230	150	50	0	0
K	REFUGE	8	5	30	20	10	0	0	0
TOTAL FLATS				690	510	180	0	0	
TOTAL FLATS				690					

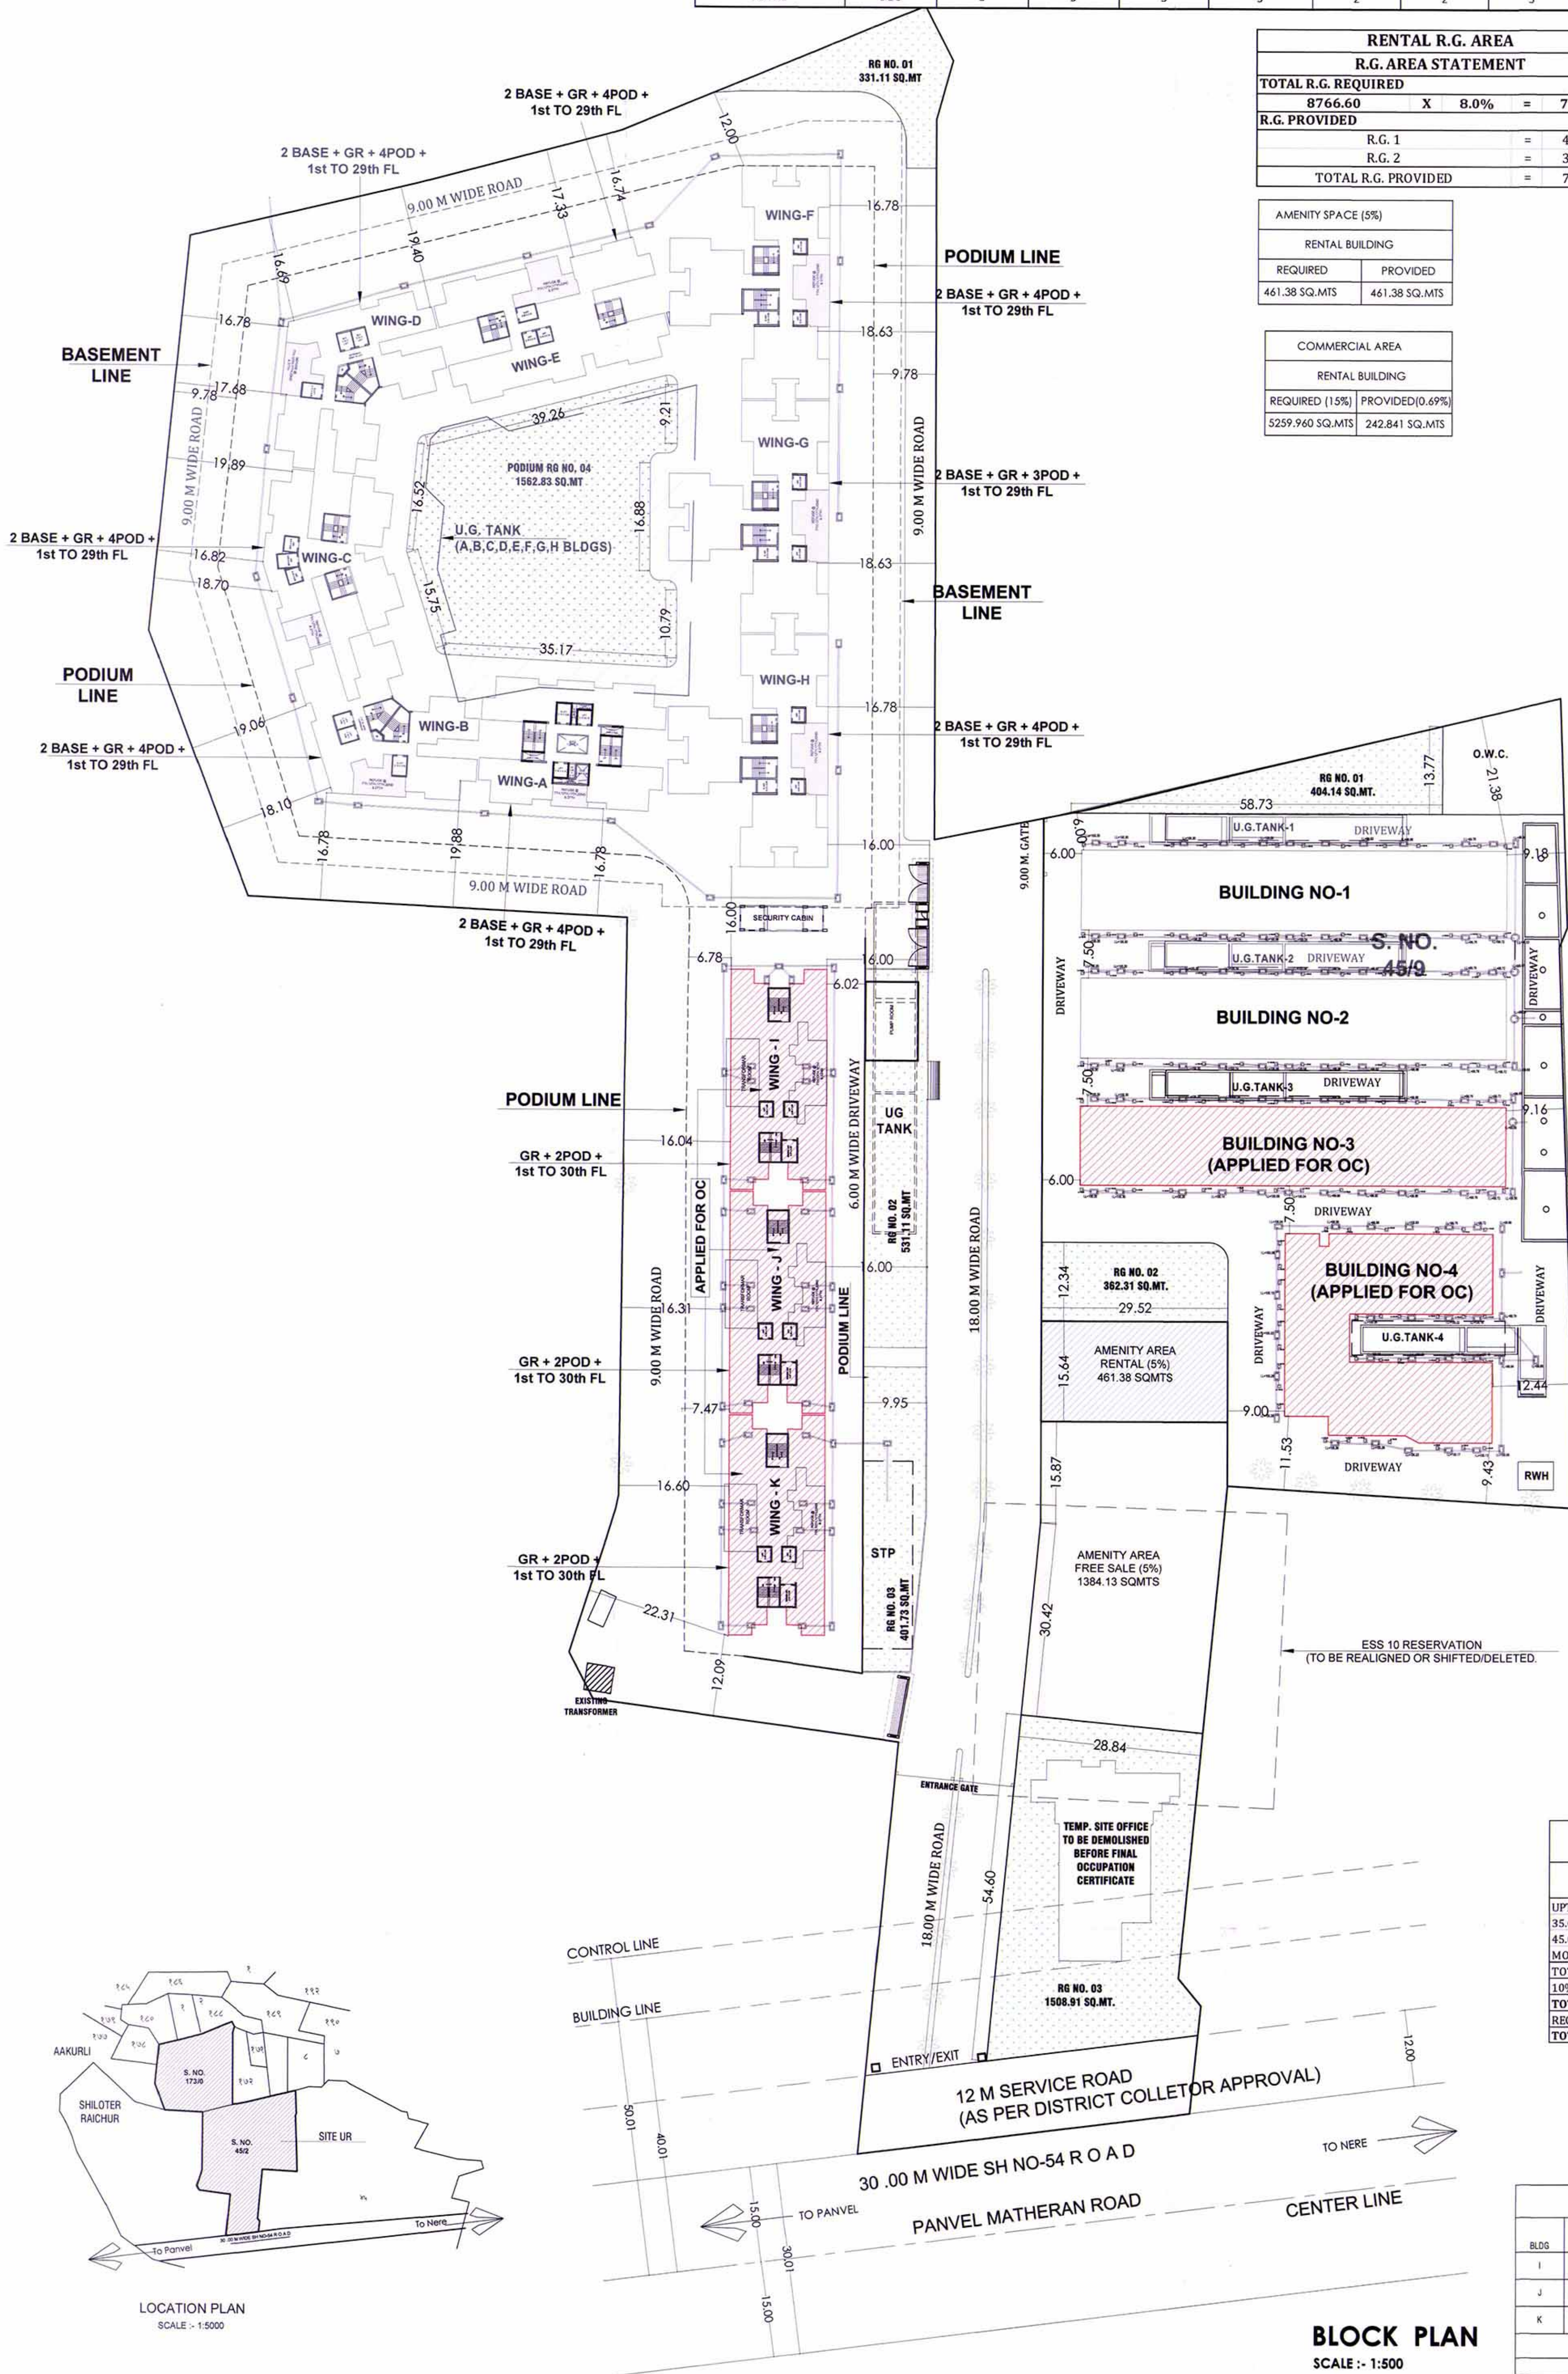BLOCK PLAN
SCALE :- 1:500

PROFORMA - B

01/10

CONTENTS OF SHEET

BLOCK & LOCATION PLAN, 7/12 AREA SUMMARY, BUILT AREA STATEMENT
RENTAL & SALE BLDG, R.G., AMENITY & PARKING AREA STATEMENT,
TENEMENT STATEMENT

STAMP OF DATE OF APPROVAL OF PLAN

AS BUILT DRAWING APPROVED
Subject to the conditions mentioned
in this office's letter No.:
CIDCO/NAINA/Revived/Sch/Notes/ask huz. B Akusli/BP-42/Rev/oc/2018/
2023
Dated 21 AUG 2018
Associate Planner (NAINA)

PROFORMA - A FOR OC (FOR BUILDING - SALE BUILDING NO.2, WING I, J & K & RENTAL - BUILDING NO. 3 & 4)

A	AREA STATEMENT	AREA IN SQ.MT.
1	AREA OF THE PROPOSAL APPROVED BY MMRDA (AS PER LC)	36910.00
2	AREA OF LAND AS PER 7/12 EXTRACTS AND NA ORDER	36910.00
3	AREA OF THE LAND AS MENTIONED IN N.A.	36910.00
4	AREA OF LAND AS PER PHYSICAL SURVEY	36923.00
5	AREA CONSIDERED (LEAST OF ABOVE)	36910.00
6	DEDUCTION FOR	
a)	ANY RESERVATION	NIL
7	GROSS AREA OF PLOT (5-6)	36910.00
8a)	AMENITY SPACE REQUIRED 5% OF 7	1845.50
b)	AMENITY SPACE PROVIDED	1845.51
9	NET AREA OF PLOT (7-8)	35064.49
	SALE PLOT (75% ON 8)	RENTAL PLOT (25% ON 8)
10	AREA OF PROPOSAL (IN PROPORTION 75:25)	26298.37
11	PERMISSIBLE FSI (ON 9)	3.00
12	PERMISSIBLE BUILT UP AREA (9x11)	105193.47
13	PERMISSIBLE COMMERCIAL AREA (15% OF 12)	15779.02
14	PROPOSED COMMERCIAL BUILT UP AREA IN RENTAL BLDG NO. 3 & 4	0.00
15	AMENITY SPACES REQUIRED (IN PROPORTION 75:25)	1384.13
16	AMENITY SPACES PROVIDED	1384.13
17	RECREATIONAL GROUND SPACE REQUIRED (8% OF 10)	2103.87
18	RECREATIONAL GROUND SPACE PROVIDED	2772.86
19	BUILT UP AREA APPROVED	103494.40
20	FSI RELEASED BY MMRDA FOR PART OC	1.38
21	PROPORTIONATE BUILT UP AREA OF FSI RELEASED BY MMRDA FOR PART OC (20 X 9)	48389.00
22	BUILT UP AREA FOR PART OC	27548.88
23	FSI UTILISED OUT OF FSI RELEASED FOR PART OC (22/9)	0.79

FORM OF CERTIFICATE

I, Ar. Devyani Khadilkar, for M/s Spaceage Consultants have been employed by the applicant as his Architect. I have examined the boundaries and the area of the plot and i do hereby certify that i have personally verified and checked all the statements made by applicant who is the owner in possession of the plot as in the above form and found them to be correct. Date : 03.08.2018

Signature of Owner
Signature of Design Architect
Signature of Architect.
MR. VINAY S. AGRAWAL AR. P.K. MADHAV AR.DEVYANI KHADILKAR

CERTIFICATE OF AREA

Certified that the plot under reference was surveyed by me on 05.06.2014 and the dimensions of side etc. of plot stated on plan are as measured on site and the area so worked out tallies with the area stated in document of ownership/T.P. Scheme Records/ Land Records Department /city survey record.

Signature of Owner
Signature of Design Architect
Signature of Architect.
MR. VINAY S. AGRAWAL AR. P.K. MADHAV AR.DEVYANI KHADILKAR

DESCRIPTION OF PROPOSAL & PROPERTY

PART OCCUPANCY CERTIFICATE OF BUILDING NO.2, WING I, J & K (SALE COMPONENT) & BUILDING NO.3 & 4 (PT) (RENTAL COMPONENT) FOR PROPOSED RENTAL HOUSING SCHEME ON LAND BEARING NEW S.NO.45/2, OLD S. NO. 45/4, 45/8, 45/9, 45/11(P), 45/12 (PT) AT VILLAGE - SHILOTER RAICHUR AND S.NO. 173/0 AT VILLAGE - AAKURLI TAL - PANVEL DIST - RAIGAD

NORTH JOB. NO. DRG. NO. DRAWN BY
SCALE DATE CHECKED BY
1:100

REVISIONS DESCRIPTION :

R-0

NAME AND ADDRESS OF DESIGN ARCHITECT SIGNATURE

AR. P.K. MADHAV
architects *interior designers
Off. NO. A-305 Shiv Chandra
Plot-21, Sec-11 Nr. Rly. Stn.
CIDCO Belapur, New Mumbai

NAME OF THE OWNER

SHRI. VINAY S. AGRAWAL

NAME OF ARCHITECT DEVYANI KHADILKAR

LICENSE NO CA/90/13184

ADDRESS

B-106, Natraj Building,
Mulund Goregaon Link Road
Mulund (w), Mumbai : 400 080

SCALE

SCALE


SCALE

SCALE

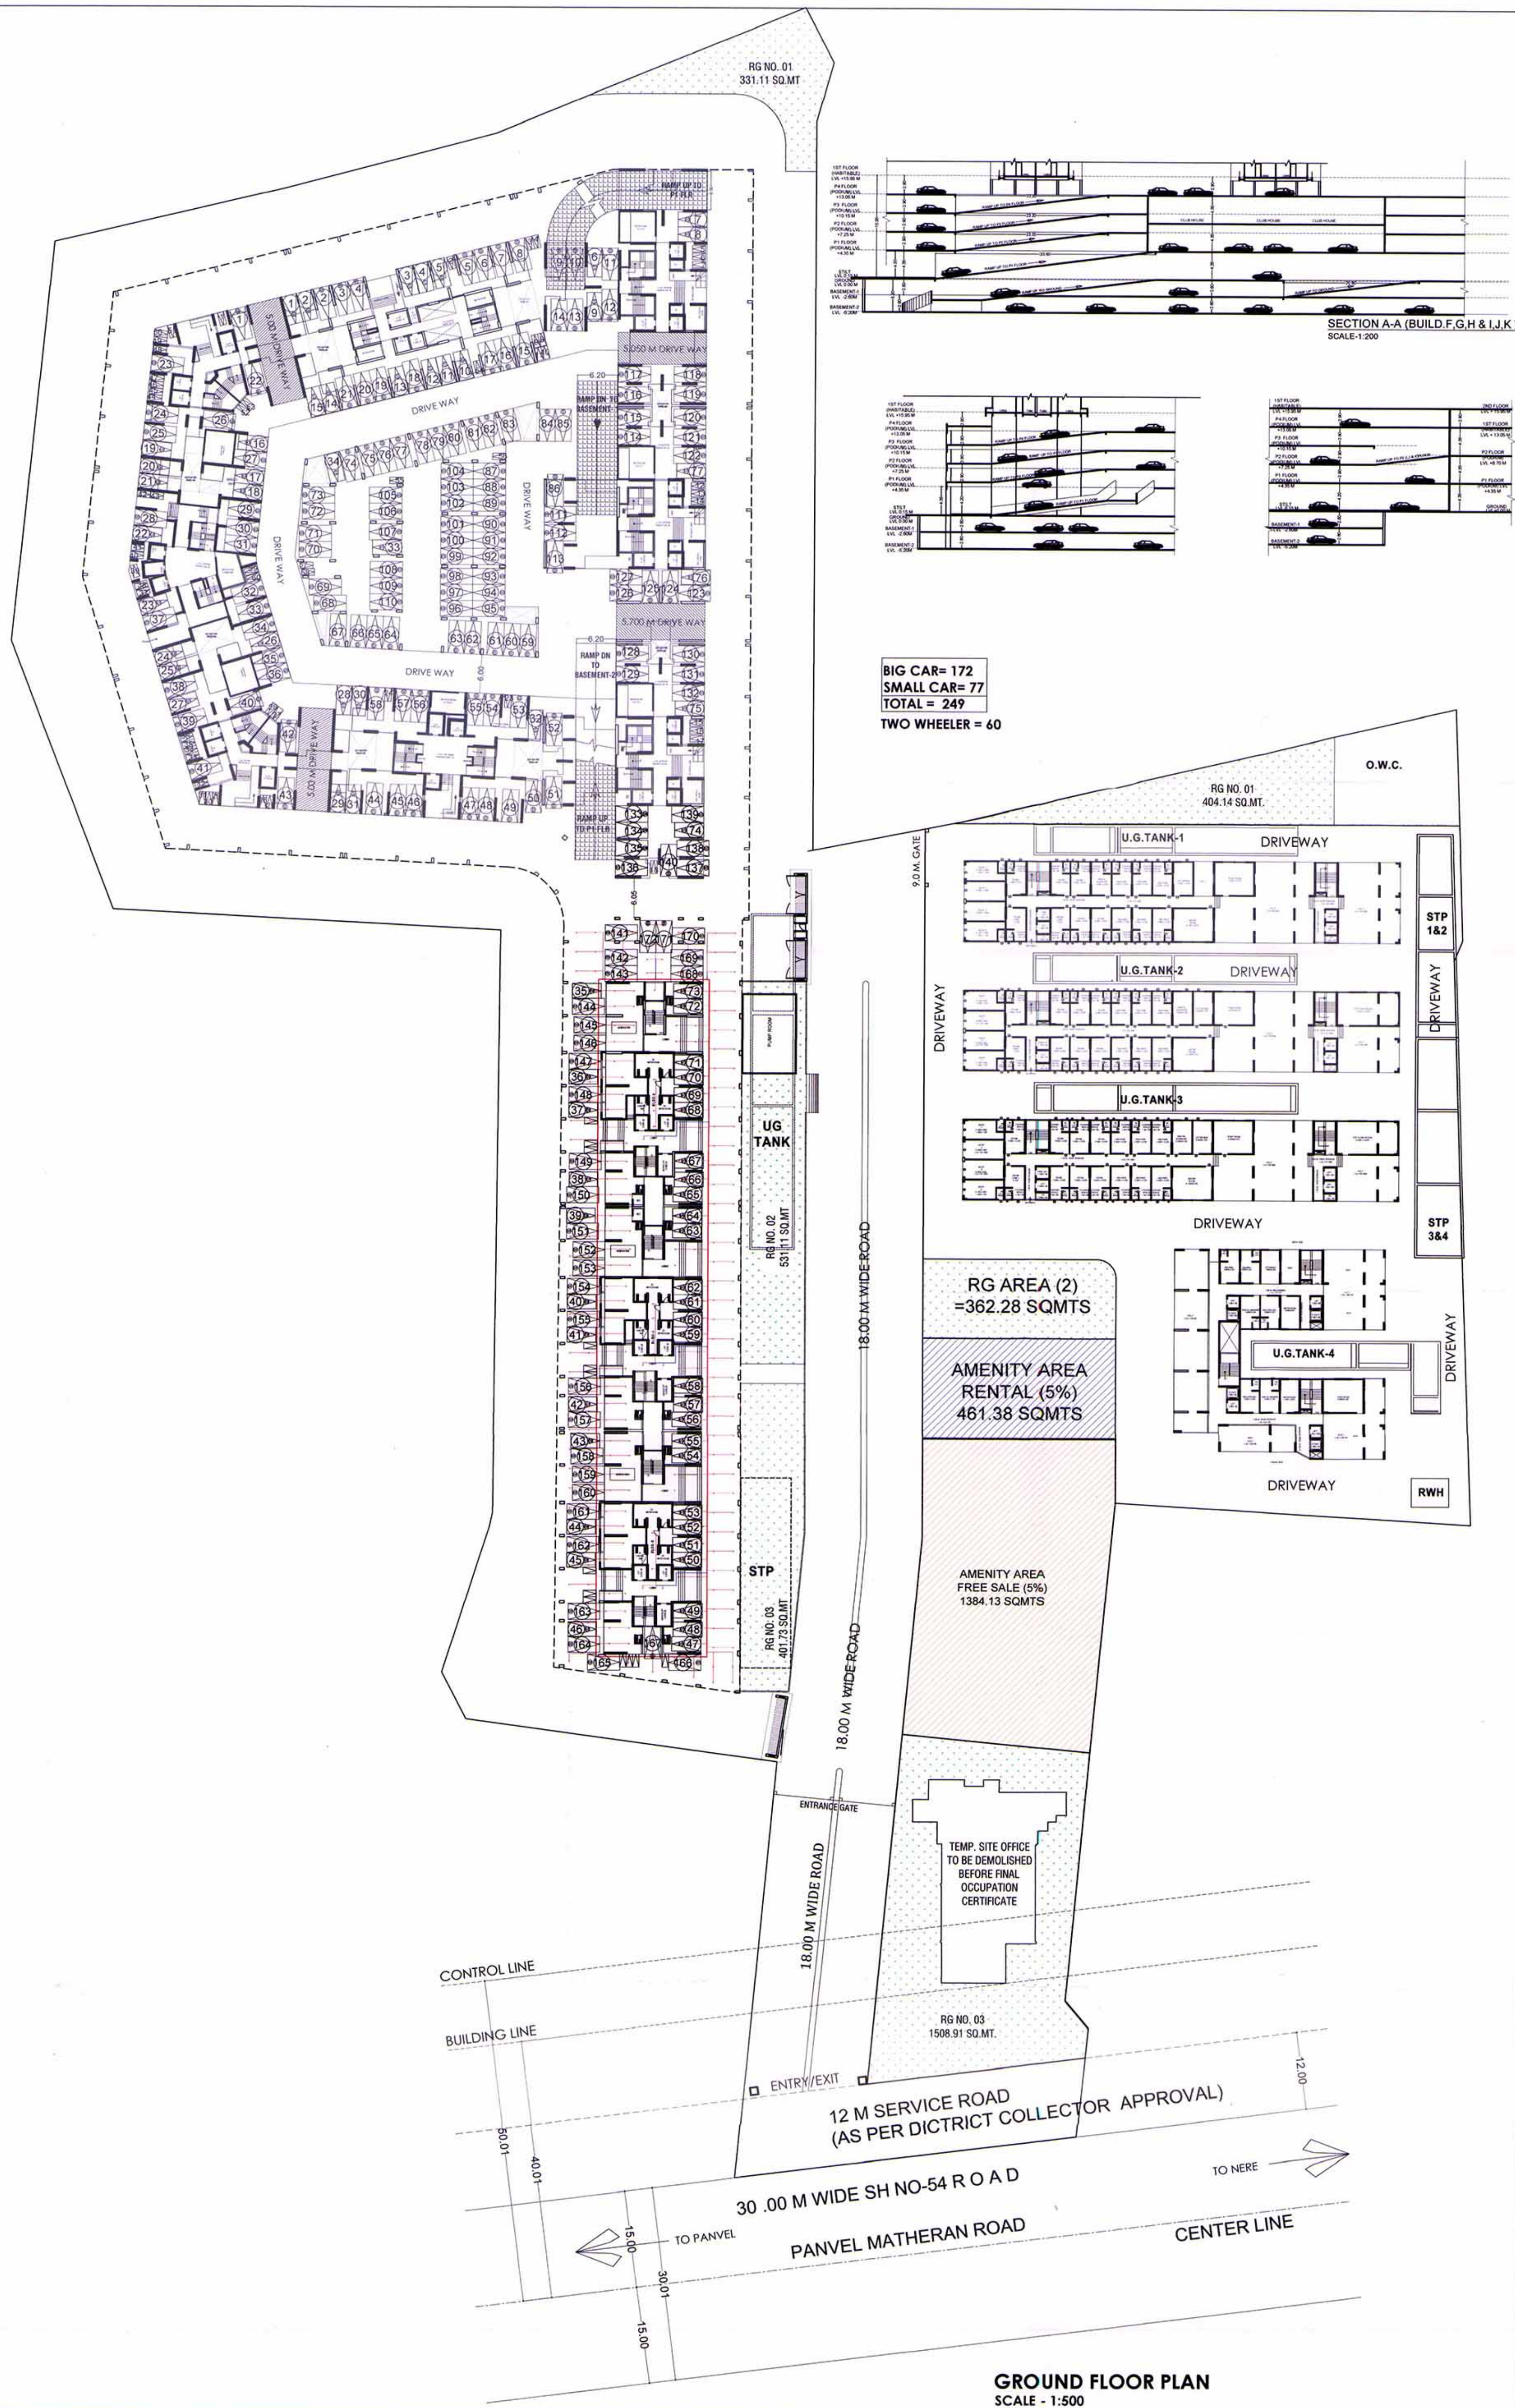**PROFORMA -B**

02/10

CONTENTS OF SHEET

BASEMENT ,GROUND FLOOR PLAN

STAMP OF DATE OF APPROVAL OF PLAN

AS BUILT DRAWING APPROVED
Subject to the conditions mentioned
in this office's letter No.:
CIDCO/NAINA/ Parveed/shilhotari
Dated 21 AUG 2018
(Signature)
Associate Planner (NAINA)

STAMP OF DATE OF RECEIPT OF PLAN

DESCRIPTION OF PROPOSAL & PROPERTY	
1. Project Title: [Project Title] 2. Project Description: [Project Description] 3. Project Location: [Project Location] 4. Project Status: [Project Status] 5. Project Budget: [Project Budget] 6. Project Timeline: [Project Timeline] 7. Project Risks: [Project Risks] 8. Project Benefits: [Project Benefits] 9. Project Objectives: [Project Objectives] 10. Project Deliverables: [Project Deliverables] 11. Project Stakeholders: [Project Stakeholders] 12. Project Sponsor: [Project Sponsor] 13. Project Manager: [Project Manager] 14. Project Team: [Project Team] 15. Project History: [Project History] 16. Project Future: [Project Future] 17. Project Conclusion: [Project Conclusion]	

PART OCCUPANCY CERTIFICATE OF BUILDING NO.2, WING I,J & K (SALE COMPONENT) & BUILDING NO.3 & 4 (PT) (RENTAL COMPONENT) FOR PROPOSED RENTAL HOUSING SCHEME ON LAND BEARING NEW S.NO.45/2, (OLD S. NO.- 45/4, 45/ 8B, 45/9, 45/11,45/18 (PT) AT VILLAGE - SHILOTER RAICHUR AND S.NO. 173/0 AT VILLAGE - AAKURLI TAL - PANVEL DIST - RAIGAD

NORTH	JOB. NO.	DRG. NO.	DRAWN BY
	-	02/10	-
	SCALE	DATE	CHECKED BY
	1:500	-	-

REVISIONS	DESCRIPTION :
------------------	----------------------

R-0		
NAME AND ADDRESS OF DESIGNER OR REQUESTOR		CHECKED BY

NAME AND ADDRESS OF DESIGN ARCHITECT	SIGNATURE
 VASTOSPATI design group	AR. P. K. MADHAV * architects * Interior designers Off NO: A-305 Shiv Chamber Plot-21, Sec-11 Nr. Rly. Stn. CBD Belapur, Navi Mumbai VASTOSPATI design Ar Ar P K MADHAV A-304/305, Shiv Chamber

Ar P K MADHAV
04/305, Shiv Chambers, Plot No-21
Sector-11, CBD Belapur, Navi Mumbai

NAME OF THE OWNER

SHRI. VINAY S. AGRAWAL

NAME OF ARCHITECT	DEVYANI KHADILKAR
-------------------	-------------------

☐ NO	☐ NO
☐ NO	☐ NO

LICENSE NO	CA/90/13184

[illegible]

ADDRESS



B-106, Natraj Building,
Mulund Goregaon Link Road
Mulund (w), Mumbai : 400 080

CONTENTS OF SHEET

PARKING FLOOR PLAN (P1 & P2)

STAMP OF DATE OF APPROVAL OF PLAN

AS BUILT DRAWING APPROVED
Subject to the conditions mentioned
in this office's letter No.:
CIDCO/NAINA/Panvel/Shilohar/Raichur/Akurli/8P-42/P1/P2/2018/2023
Dated 21 AUG-2018
Associate Planner (NAINA)



STAMP OF DATE OF RECEIPT OF PLAN

DESCRIPTION OF PROPOSAL & PROPERTY

PART OCCUPANCY CERTIFICATE OF BUILDING NO.2, WING I, J & K (SALE COMPONENT) & BUILDING NO.3 & 4 (PT) (RENTAL COMPONENT) FOR PROPOSED RENTAL HOUSING SCHEME ON LAND BEARING NEW S.NO.45/2, (OLD S. NO.- 45/4, 45/8, 45/9, 45/11(PT), 45/18 (PT) AT VILLAGE - SHILOTER RAICHUR AND S.NO. 173/0 AT VILLAGE - ANKURLI TAL - PANVEL DIST - RAIGAD

NORTH	JOB. NO.	DRG. NO.	DRAWN BY
		03/10	
	SCALE	DATE	CHECKED BY
	1:300		

REVISIONS DESCRIPTION:

R-0

NAME AND ADDRESS OF DESIGN ARCHITECT



VASTOSPATI

design group

AR. P. K. MADHAV
* architects * interior designers
Off. NO. A-305 Shiv Chamber
Plot-21, Sec-11 Nr. Rly. Stn.
CBD Belapur, Navi Mumbai

SIGNATURE

VASTOSPATI design group

Ar. P. K. - ADHAR

A-304/305, Shiv - chamber, Plot No-21,

Sector-11, CBD Belapur, Navi Mumbai

NAME OF THE OWNER

SHRI. VINAY S. AGRAWAL

SIGNATURE

NAME OF ARCHITECT

DEVYANI KHADILKAR

LICENSE NO.

CA/90/13184

ADDRESS

SPACE

CONSULTANTS

B-106, Natraj Building,

Mulund Goregaon Link Road

Mulund (w), Mumbai - 400 080


CONTENTS OF SHEET

1ST TO 4TH, 6TH TO 9TH, 11TH TO 14TH, 16TH TO 19TH, 21ST TO 24TH & 26TH TO 29TH TYPICAL FLOOR PLAN,
LINE AREA DIAGRAM & CALCULATION (SALE BLDG NO.2, WING I, J & K),
5TH, 10TH, 15TH & 20TH TYPICAL REFUGE FLOOR PLAN,
LINE AREA DIAGRAM & CALCULATION (SALE BLDG NO.2, WING I, J & K)

STAMP OF DATE OF APPROVAL OF PLAN

AS BUILT DRAWING APPROVED
Subject to the conditions mentioned
in this office's letter No..
CIDCO/NAINA/Panvel/shilohar/Pichur/BAW/4/BP/4/Pos/2018/2023
Dated 21 AUG 2018
Associate Planner (NAINA)


STAMP OF DATE OF RECEIPT OF PLAN

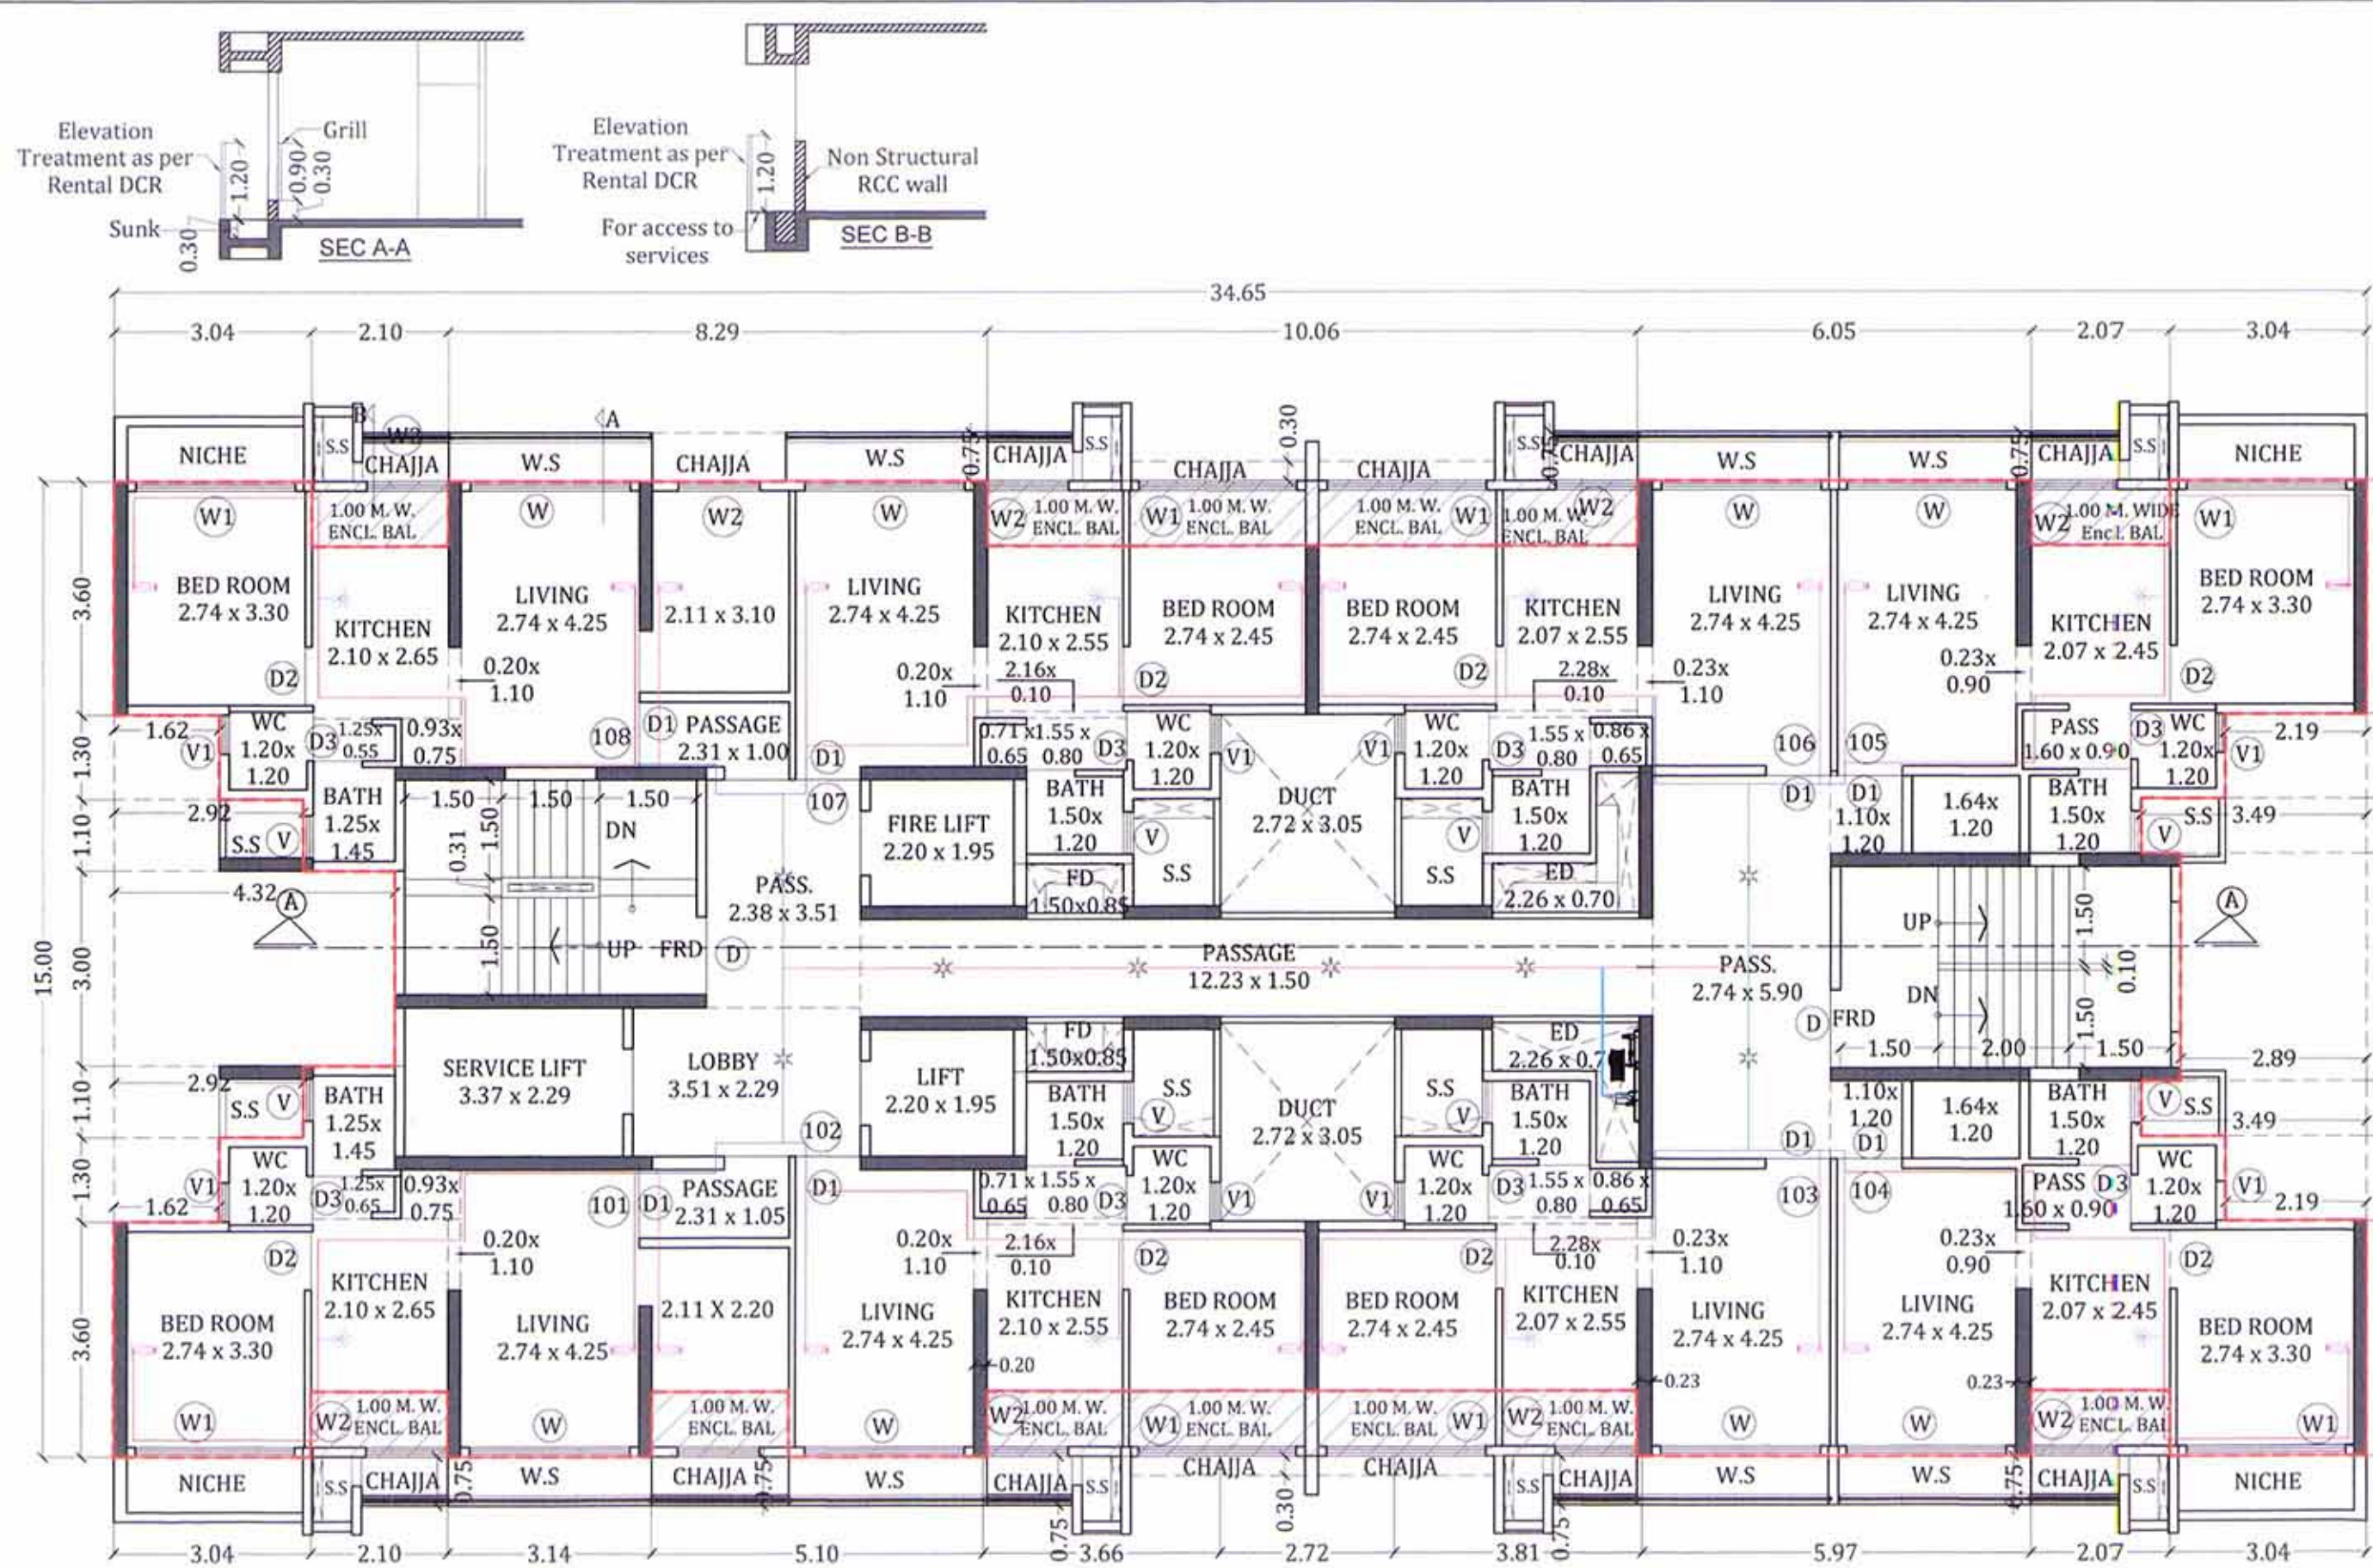

TYPICAL FLOOR PLAN (1ST TO 4TH, 6TH TO 9TH, 11TH TO 14TH, 16TH TO 19TH, 21ST TO 24TH & 26TH TO 29TH)

[BLDG NO.2, WING - I, J & K]


SCALE 1:100

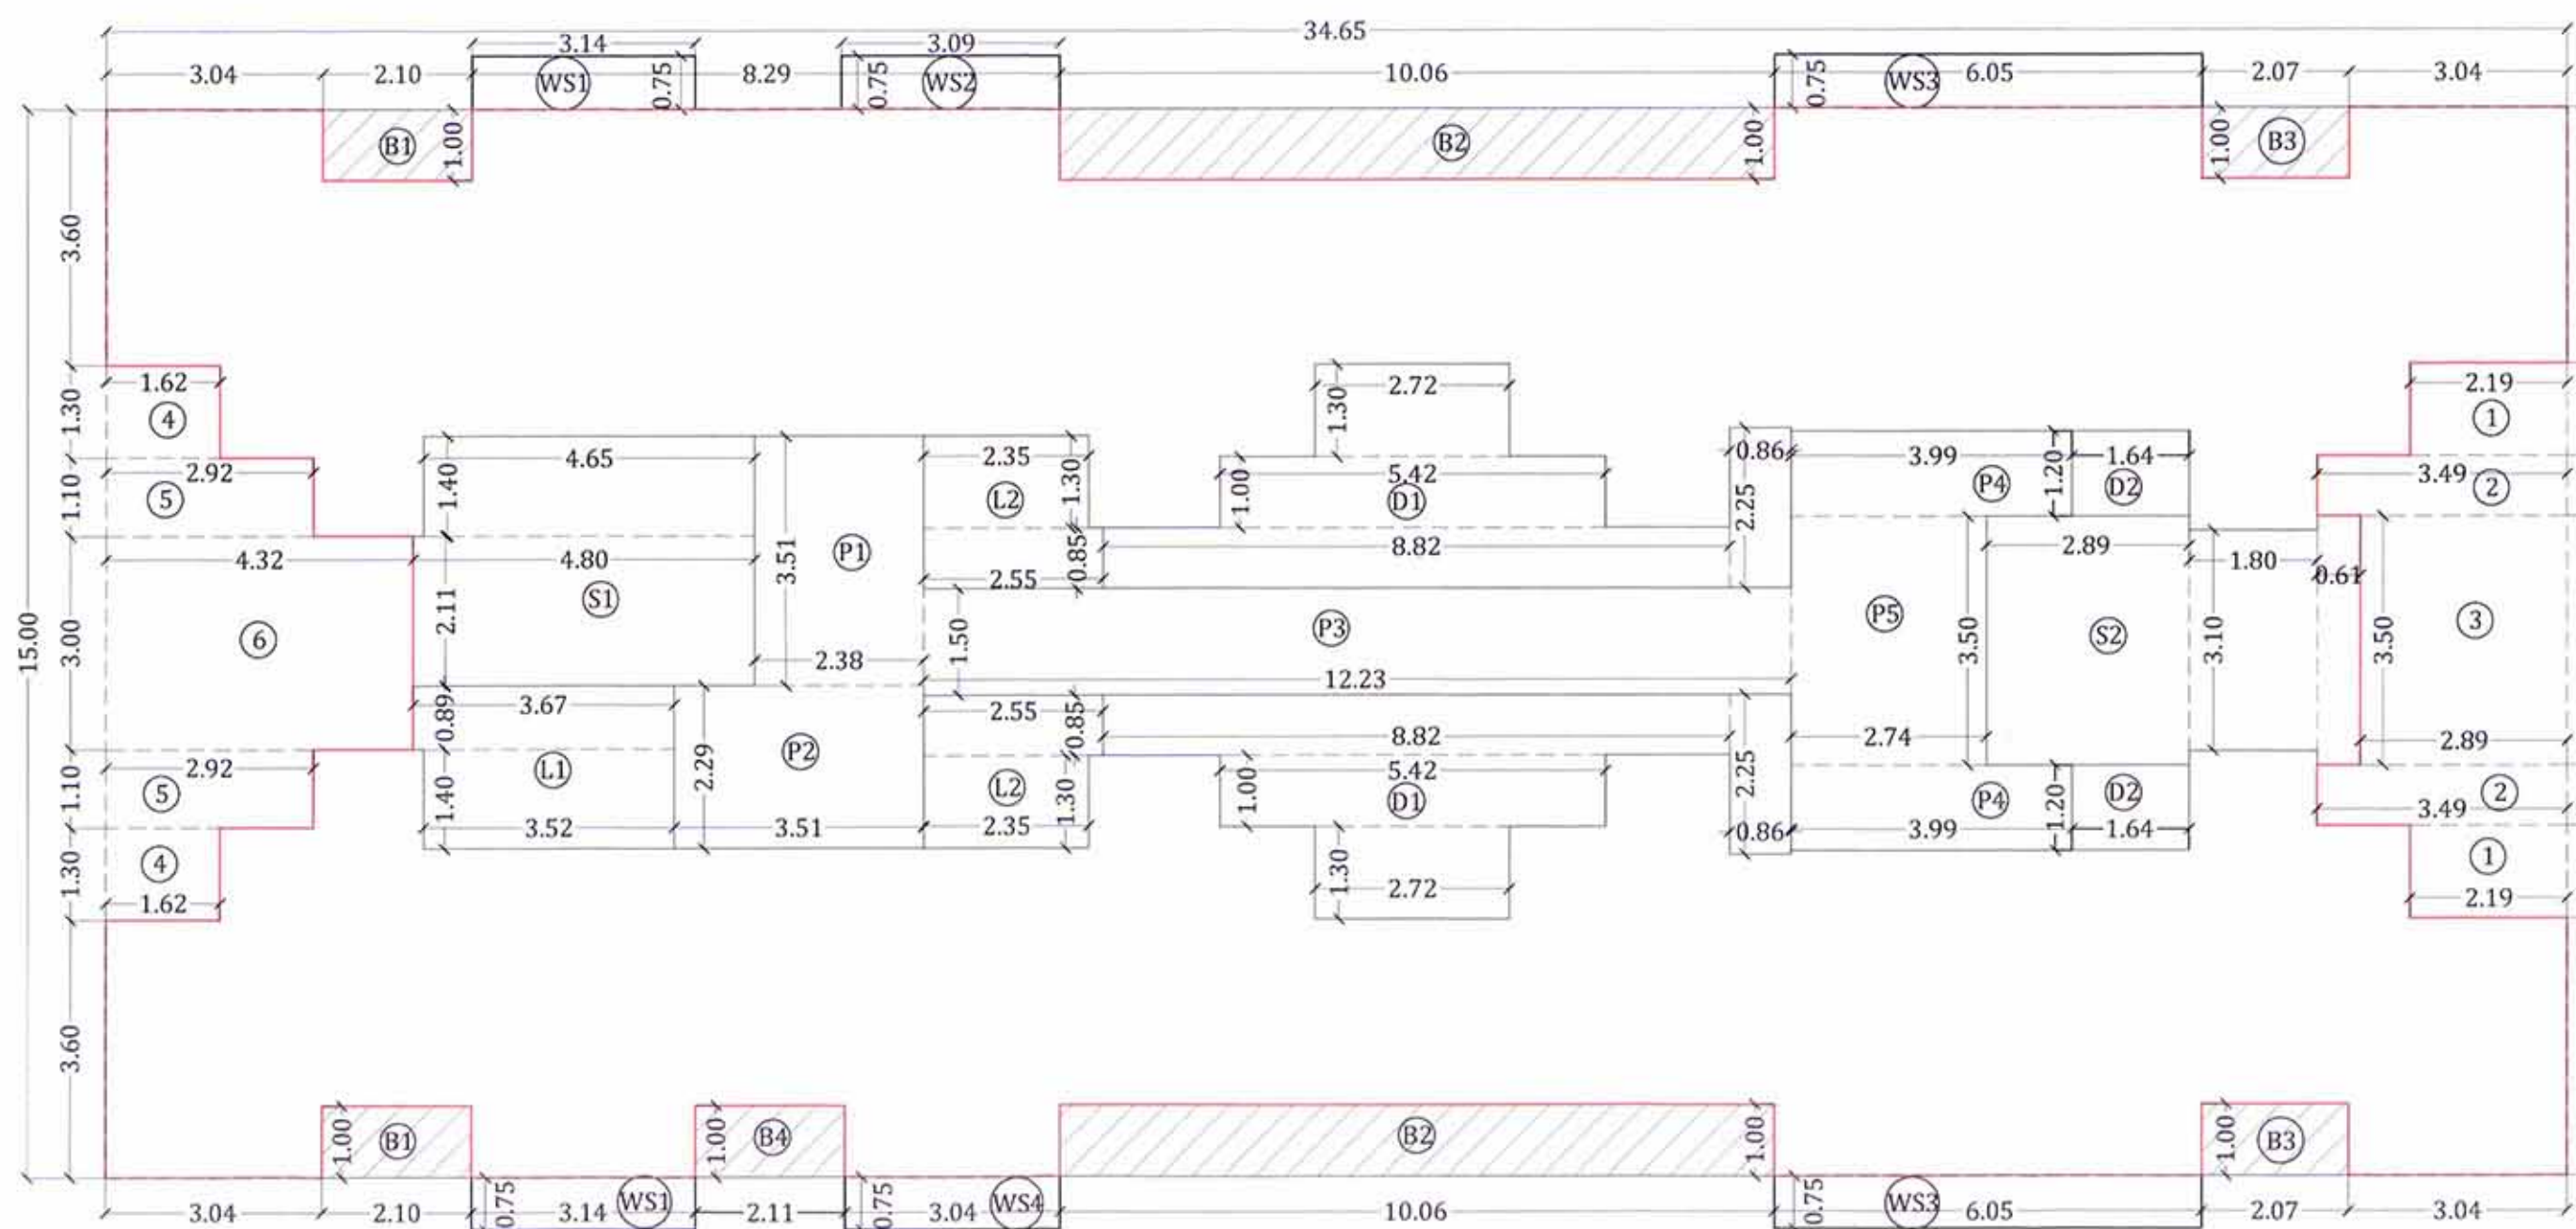

LINE AREA DIAGRAM OF TYPICAL FLOOR (1ST TO 4TH, 6TH TO 9TH, 11TH TO 14TH, 16TH TO 19TH, 21ST TO 24TH & 26TH TO 29TH)


[BLDG NO.2, WING - I, J & K]

SCALE 1:100

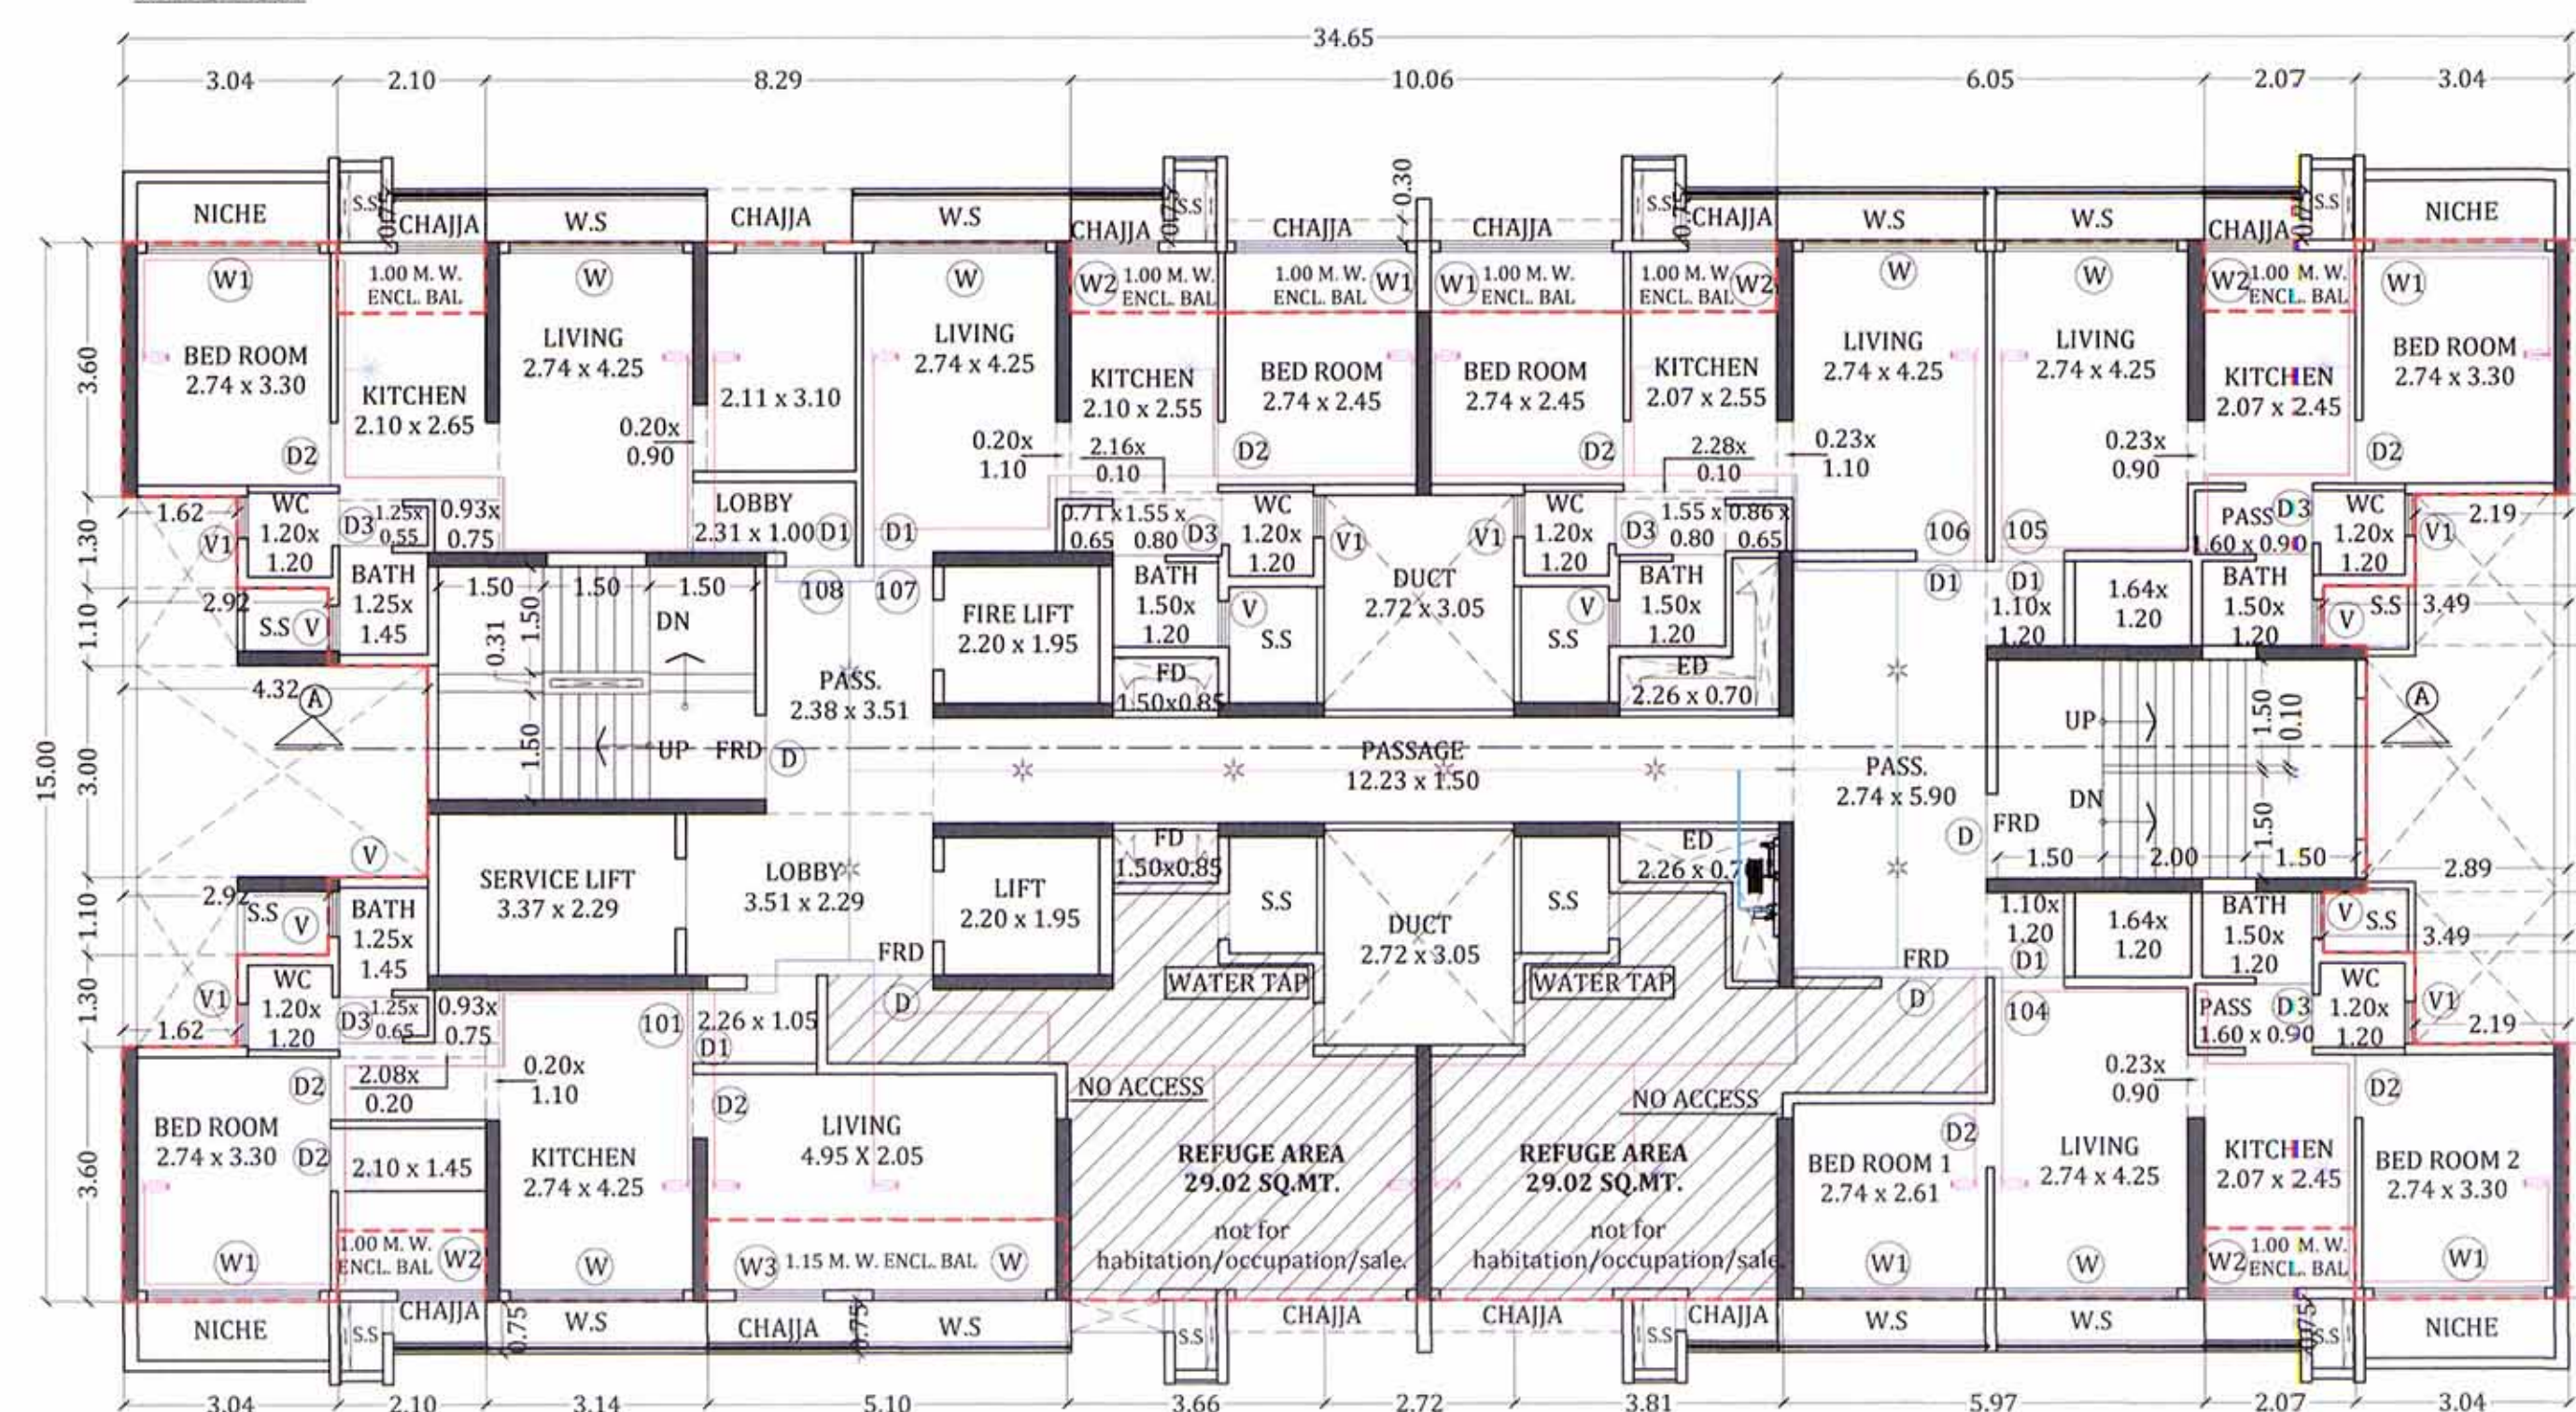

TYPICAL (PART REFUGE) FLOOR PLAN (5TH, 10TH, 15TH, 20TH & 25TH) [BLDG NO.2, WING - I, J & K]

SCALE 1:100

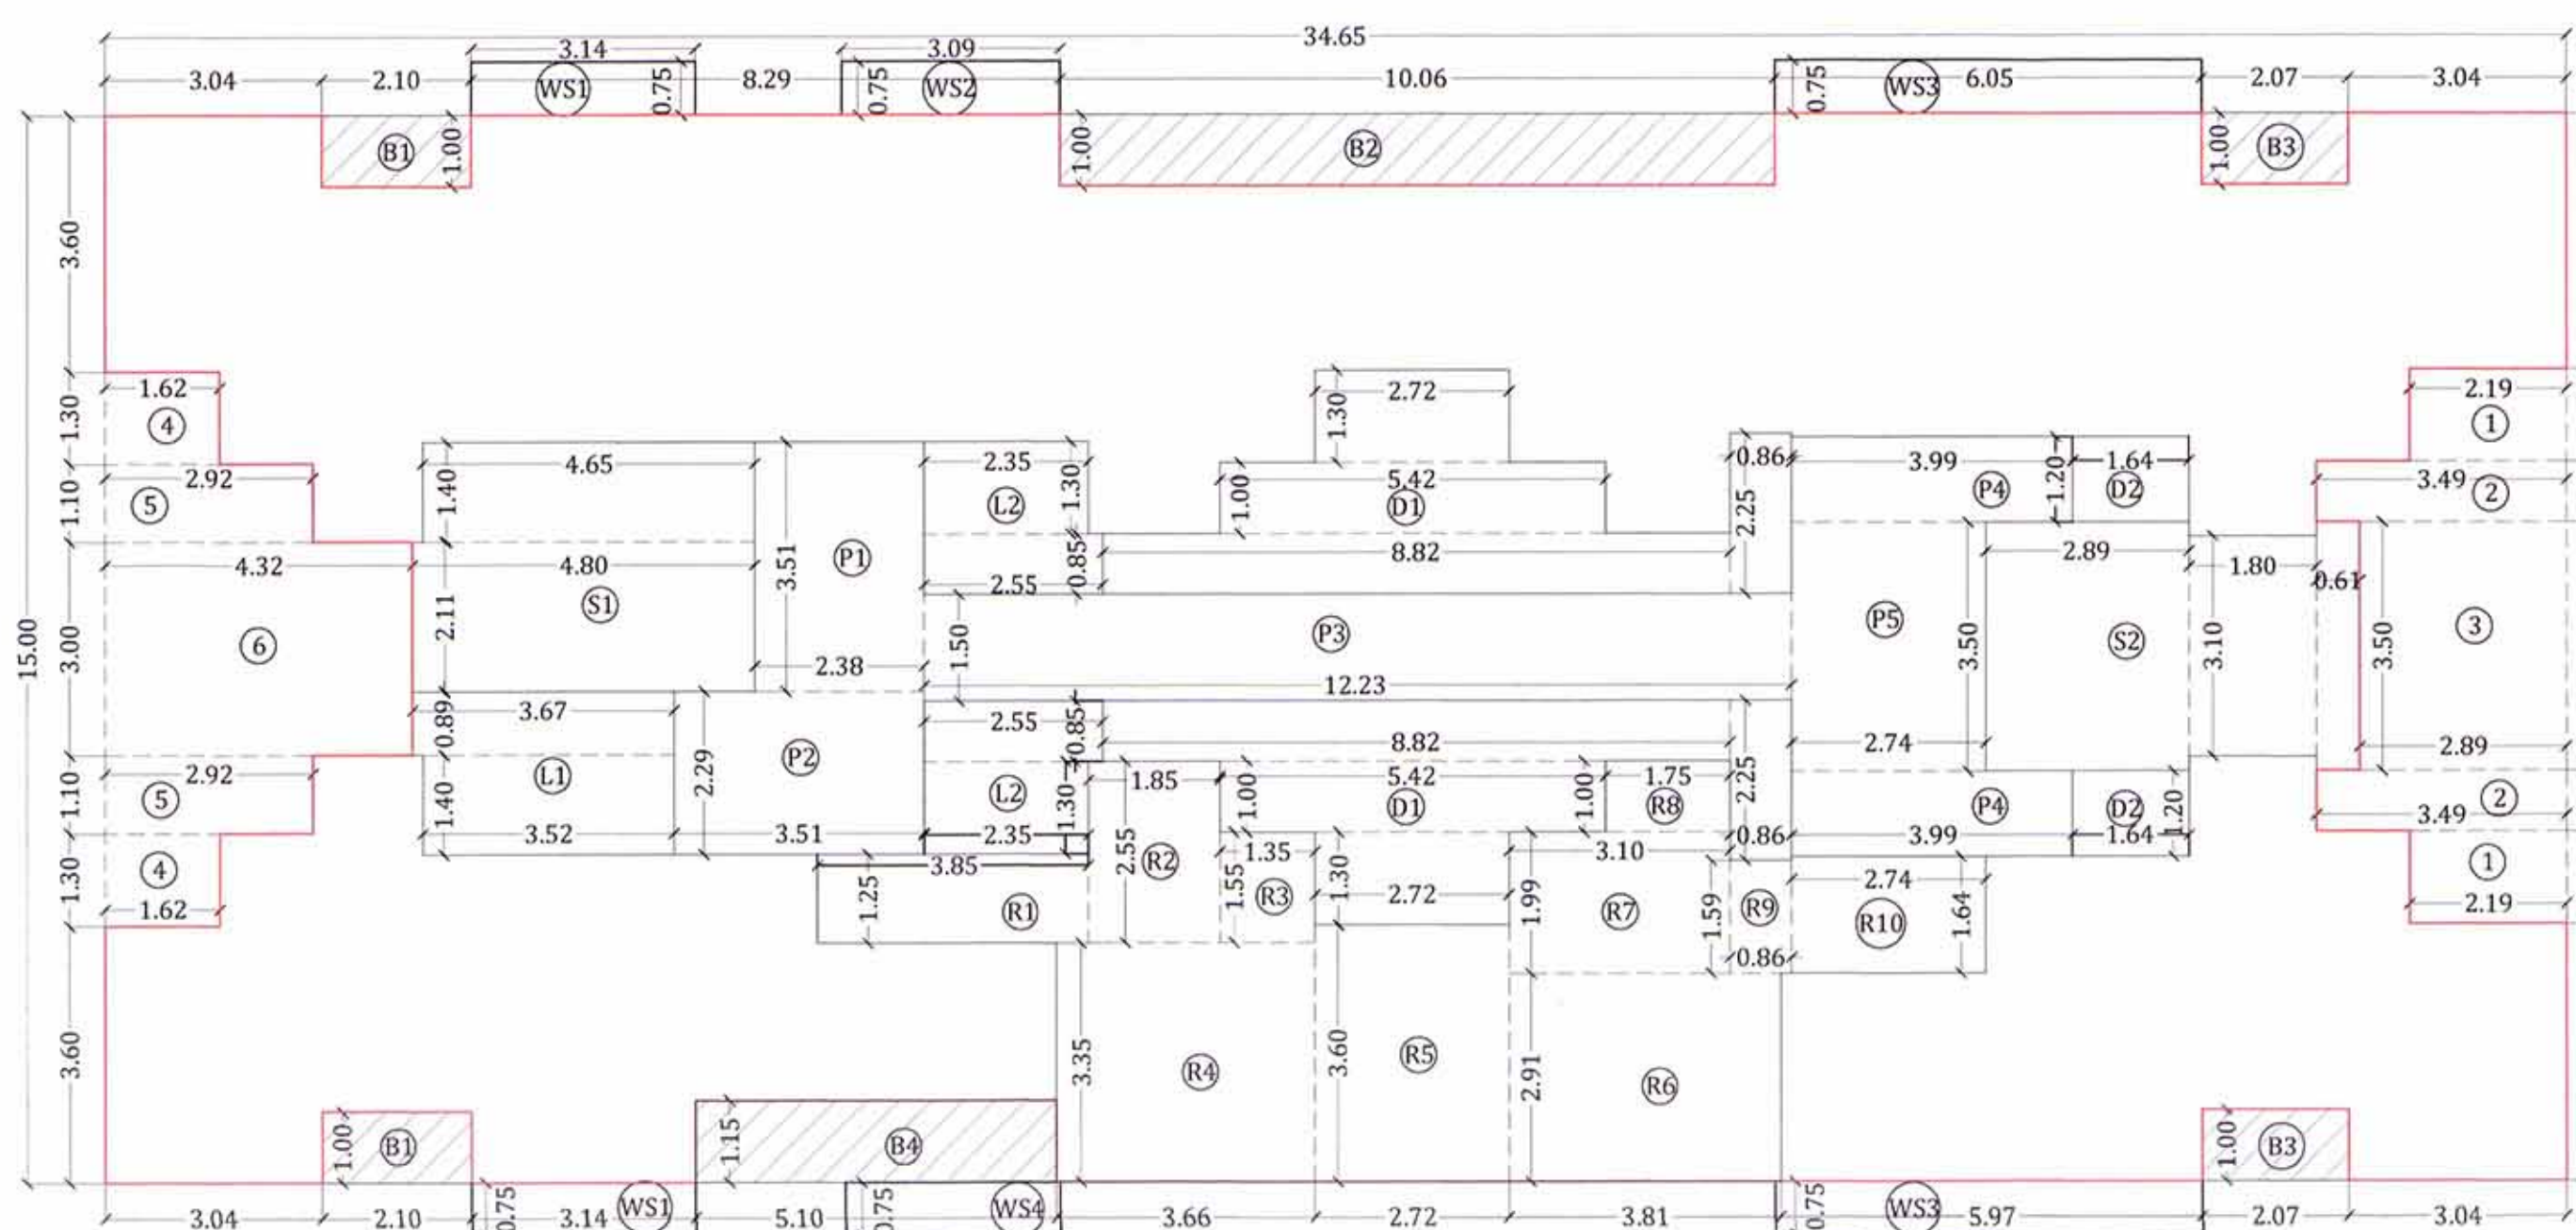

LINE AREA DIAGRAM(PART REFUGE) FLOOR PLAN (5TH, 10TH, 15TH, 20TH & 25TH)

[BLDG NO.2, WING - I, J & K] SCALE 1:100

CARPET AREA STATEMENT FOR TYPICAL FLOOR			
FOR FLAT NO. 108			
LIVING	2.74	x	4.25
"	0.93	x	0.75
"	0.20	x	1.10
"	0.20	x	1.10
KITCHEN	2.11	x	3.10
PASS	1.25	x	0.65
BED ROOM	2.74	x	3.30
BATH	1.25	x	1.45
WC	1.20	x	1.20
TOTAL AREA			= 37.65 SQ.MT.

CARPET AREA STATEMENT FOR TYPICAL FLOOR			
FOR FLAT NO. 101			
LIVING	2.74	x	4.25
"	0.93	x	0.75
"	0.20	x	1.10
"	0.20	x	1.10
KITCHEN	2.11	x	3.10
PASS	1.25	x	0.65
BED ROOM	2.74	x	3.30
BATH	1.25	x	1.45
WC	1.20	x	1.20
TOTAL AREA			= 35.88 SQ.MT.

CARPET AREA STATEMENT FOR TYPICAL FLOOR			
FOR FLAT NO. 102, 103, 106 & 107			
LIVING	2.74	x	4.25
"	0.20	x	1.10
KITCHEN	2.11	x	3.10
PASS	1.25	x	0.65
BED ROOM	2.74	x	3.30
BATH	1.25	x	1.45
WC	1.20	x	1.20
TOTAL AREA			= 29.09 SQ.MT.

CARPET AREA STATEMENT FOR REFUGE FLOOR			
FOR FLAT NO. 101			
LIVING	2.74	x	4.25
"	0.20	x	1.10
"	0.20	x	1.10
"	0.93	x	0.75
"	0.93	x	0.75
KITCHEN	2.11	x	3.10
PASS	1.25	x	0.65
BED ROOM	2.74	x	3.30
BATH	1.25	x	1.45
WC	1.20	x	1.20
TOTAL AREA			= 41.38 SQ.MT.

CARPET AREA STATEMENT FOR REFUGE FLOOR			
FOR FLAT NO. 104			
LIVING	2.74	x	4.25
"	0.23	x	0.90
"	0.23	x	0.90
KITCHEN	2.07	x	2.45
BED ROOM 1	2.74	x	2.61
BED ROOM 2	2.74	x	3.30
PASS	1.60	x	0.90
BATH	1.50	x	1.20
WC	1.20	x	1.20
TOTAL AREA			= 37.80 SQ.MT.

CARPET AREA STATEMENT FOR TYPICAL FLOOR			
FOR FLAT NO. 104 & 105			
LIVING	2.74	x	4.25
"	0.23	x	0.90
"	0.23	x	0.90
KITCHEN	2.07	x	2.45
BED ROOM	2.74	x	3.30
PASS	1.60	x	0.90
BATH	1.50	x	1.20
WC	1.20	x	1.20
TOTAL AREA			= 30.65 SQ.MT.

REFUGE AREA STATEMENT			
REFUGE AREA REQ. AT 5TH, 10TH, 15TH, 20TH & 25TH FOR (BLDG NO.2, WING I, J & K)	NO OF FLAT	X	FLOORS
5TH, 10TH, 15TH, 20TH & 25TH TYPICAL REFUGE FLOOR [A]	6.00	X	1.00
6TH TO 9TH, 11TH TO 14TH, 16TH TO 19TH, 21ST TO 24TH & 26TH TO 29TH TYPICAL FLOOR [A]	8.00	X	4.00
TOTAL FLAT			38
NO. OF PERSON PER FLAT [B]			5
TOTAL PERSON (C = A X B)			190
REQ. 0.3 SQ.MTS. PER PERSON			0.3
REQ. REFUGE AREA			57.00
REFUGE AREA FOR HANDICAPPED WHEELCHAIR			0.90
TOTAL REQ. REFUGE AREA			57.90
TOTAL PROVIDED REFUGE AREA			58.03

BUILT UP AREA CALCULATION FOR (BLDG NO.2, WING I, J & K)			
TYPICAL FLOOR (1ST TO 4TH, 6TH TO 9TH, 11TH TO 14TH, 16TH TO 19TH, 21ST TO 24TH & 26TH TO 29TH)			
ADDITION	A	34.65	x 15.00
STANDARD DEDUCTION	1	2.19	x 1.30
STAIRCASE, LIFT, LOBBY DEDUCTION	S1	4.65	x 1.40
PERM. BALCONY (C) (B x 10%)	B4	2.11	x 1.00
BALCONY AREA STATEMENT	B1	2.10	x 1.00
PROPOSED BALCONY (D)	D1	2.72	x 1.30
EXCESS BALCONY (E) (D - C)	E	0.59	x 1.00
TOTAL NET BUILT UP AREA (B + E)			297.06
ADD WS AREA (G)			18.38
TOTAL NET BUILT UP AREA (F + G)			315.44

BUILT UP AREA CALCULATION FOR (BLDG NO.2, WING I, J & K)			
TYPICAL (PART REFUGE) FLOOR (5TH, 10TH, 15TH, 20TH & 25TH)			
ADDITION	A	34.65	x 15.00
STANDARD DEDUCTION	1	2.19	x 1.30
STAIRCASE, LIFT, LOBBY DEDUCTION	S1	4.65	x 1.40
PERM. BALCONY (C) (B x 10%)	B4	2.11	x 1.00
BALCONY AREA STATEMENT	B1	2.10	x 1.00
PROPOSED BALCONY (D)	D1	2.72	x 1.30
EXCESS BALCONY (E) (D - C)	E	0.59	x 1.00
TOTAL NET BUILT UP AREA (B + E)			297.06
ADD WS AREA (G)			18.38
TOTAL NET BUILT UP AREA (F + G)			315.44

DOOR & WINDOW SCHEDULE			
DOOR	SIZE	TYPE	TYPE
D1	1.500 x 1.000	W	ALL SLIDING WINDOW
D2	1.500 x 1.000	W	ALL SLIDING WINDOW
D3	0.900 x 1.000	W	ALL SLIDING WINDOW
D4	0.750 x 1.000	W	ALL SLIDING WINDOW

LIGHT AND VENTILATION STATEMENT, BLDG NO.2, WING I, J & K, FLAT NO. 101			
ROOM	AREA OF ROOM (SQ.M)	AREA OF WIN. REQ. (SQ.M)	TYPE OF WINDOW
LIVING	11.710	2.882	W1
BED	9.000	1.508	W1
KITCHEN	6.810	0.802	W2
BATH	1.810	0.302	W
WC	1.440	0.240	W1

LIGHT AND VENTILATION STATEMENT, BLDG NO.2, WING I, J & K, FLAT NO. 102, 103, 106 & 107			
ROOM	AREA OF ROOM (SQ.M)	AREA OF WIN. REQ. (SQ.M)	TYPE OF WINDOW
LIVING	11.880	1.977	W
BED	9.000	1.508	W1
KITCHEN	6.810	0.802	W2
BATH	1.810	0.302	W
WC	1.440	0.240	W1


LIGHT AND VENTILATION STATEMENT, BLDG NO.2, WING I, J & K, FLAT NO. 104 & 105			
ROOM	AREA OF ROOM (SQ.M)	AREA OF WIN. REQ. (SQ.M)	TYPE OF WINDOW
LIVING	11.960	2.003	W
BED	9.000	1.508	W1
KITCHEN	6.810	0.802	W2
BATH	1.810	0.302	W
WC	1.440	0.240	W1

LIGHT AND VENTILATION STATEMENT, BLDG NO.2, WING I, J & K, FLAT NO. 108			
ROOM	AREA OF ROOM (SQ.M)	AREA OF WIN. REQ. (SQ.M)	TYPE OF WINDOW
LIVING	11.960	2.003	W
BED	9.000	1.508	W1
KITCHEN	6.810	0.802	W2
BATH	1.810	0.302	W
WC	1.440	0.240	W1


WALL SPECIFICATION			
ALL INTERNAL WALLS ARE 100 MM THICK			
ALL EXTERNAL WALLS ARE 150 MM THICK			
AND WHEREVER SHEAR WALLS COMING, THERE ARE 230 AND 200 MM THICKNESS			

DESCRIPTION OF PROPOSAL & PROPERTY


PART OCCUPANCY CERTIFICATE OF BUILDING NO.2, WING I, J & K (SALE COMPONENT) & BUILDING NO.3 & 4 (PT) (RENTAL COMPONENT) FOR PROPOSED RENTAL HOUSING SCHEME ON LAND BEARING N.W. S.40.45/2, (OLD S. NO. - 45/1, 45/2, 45/3, 45/286, 45

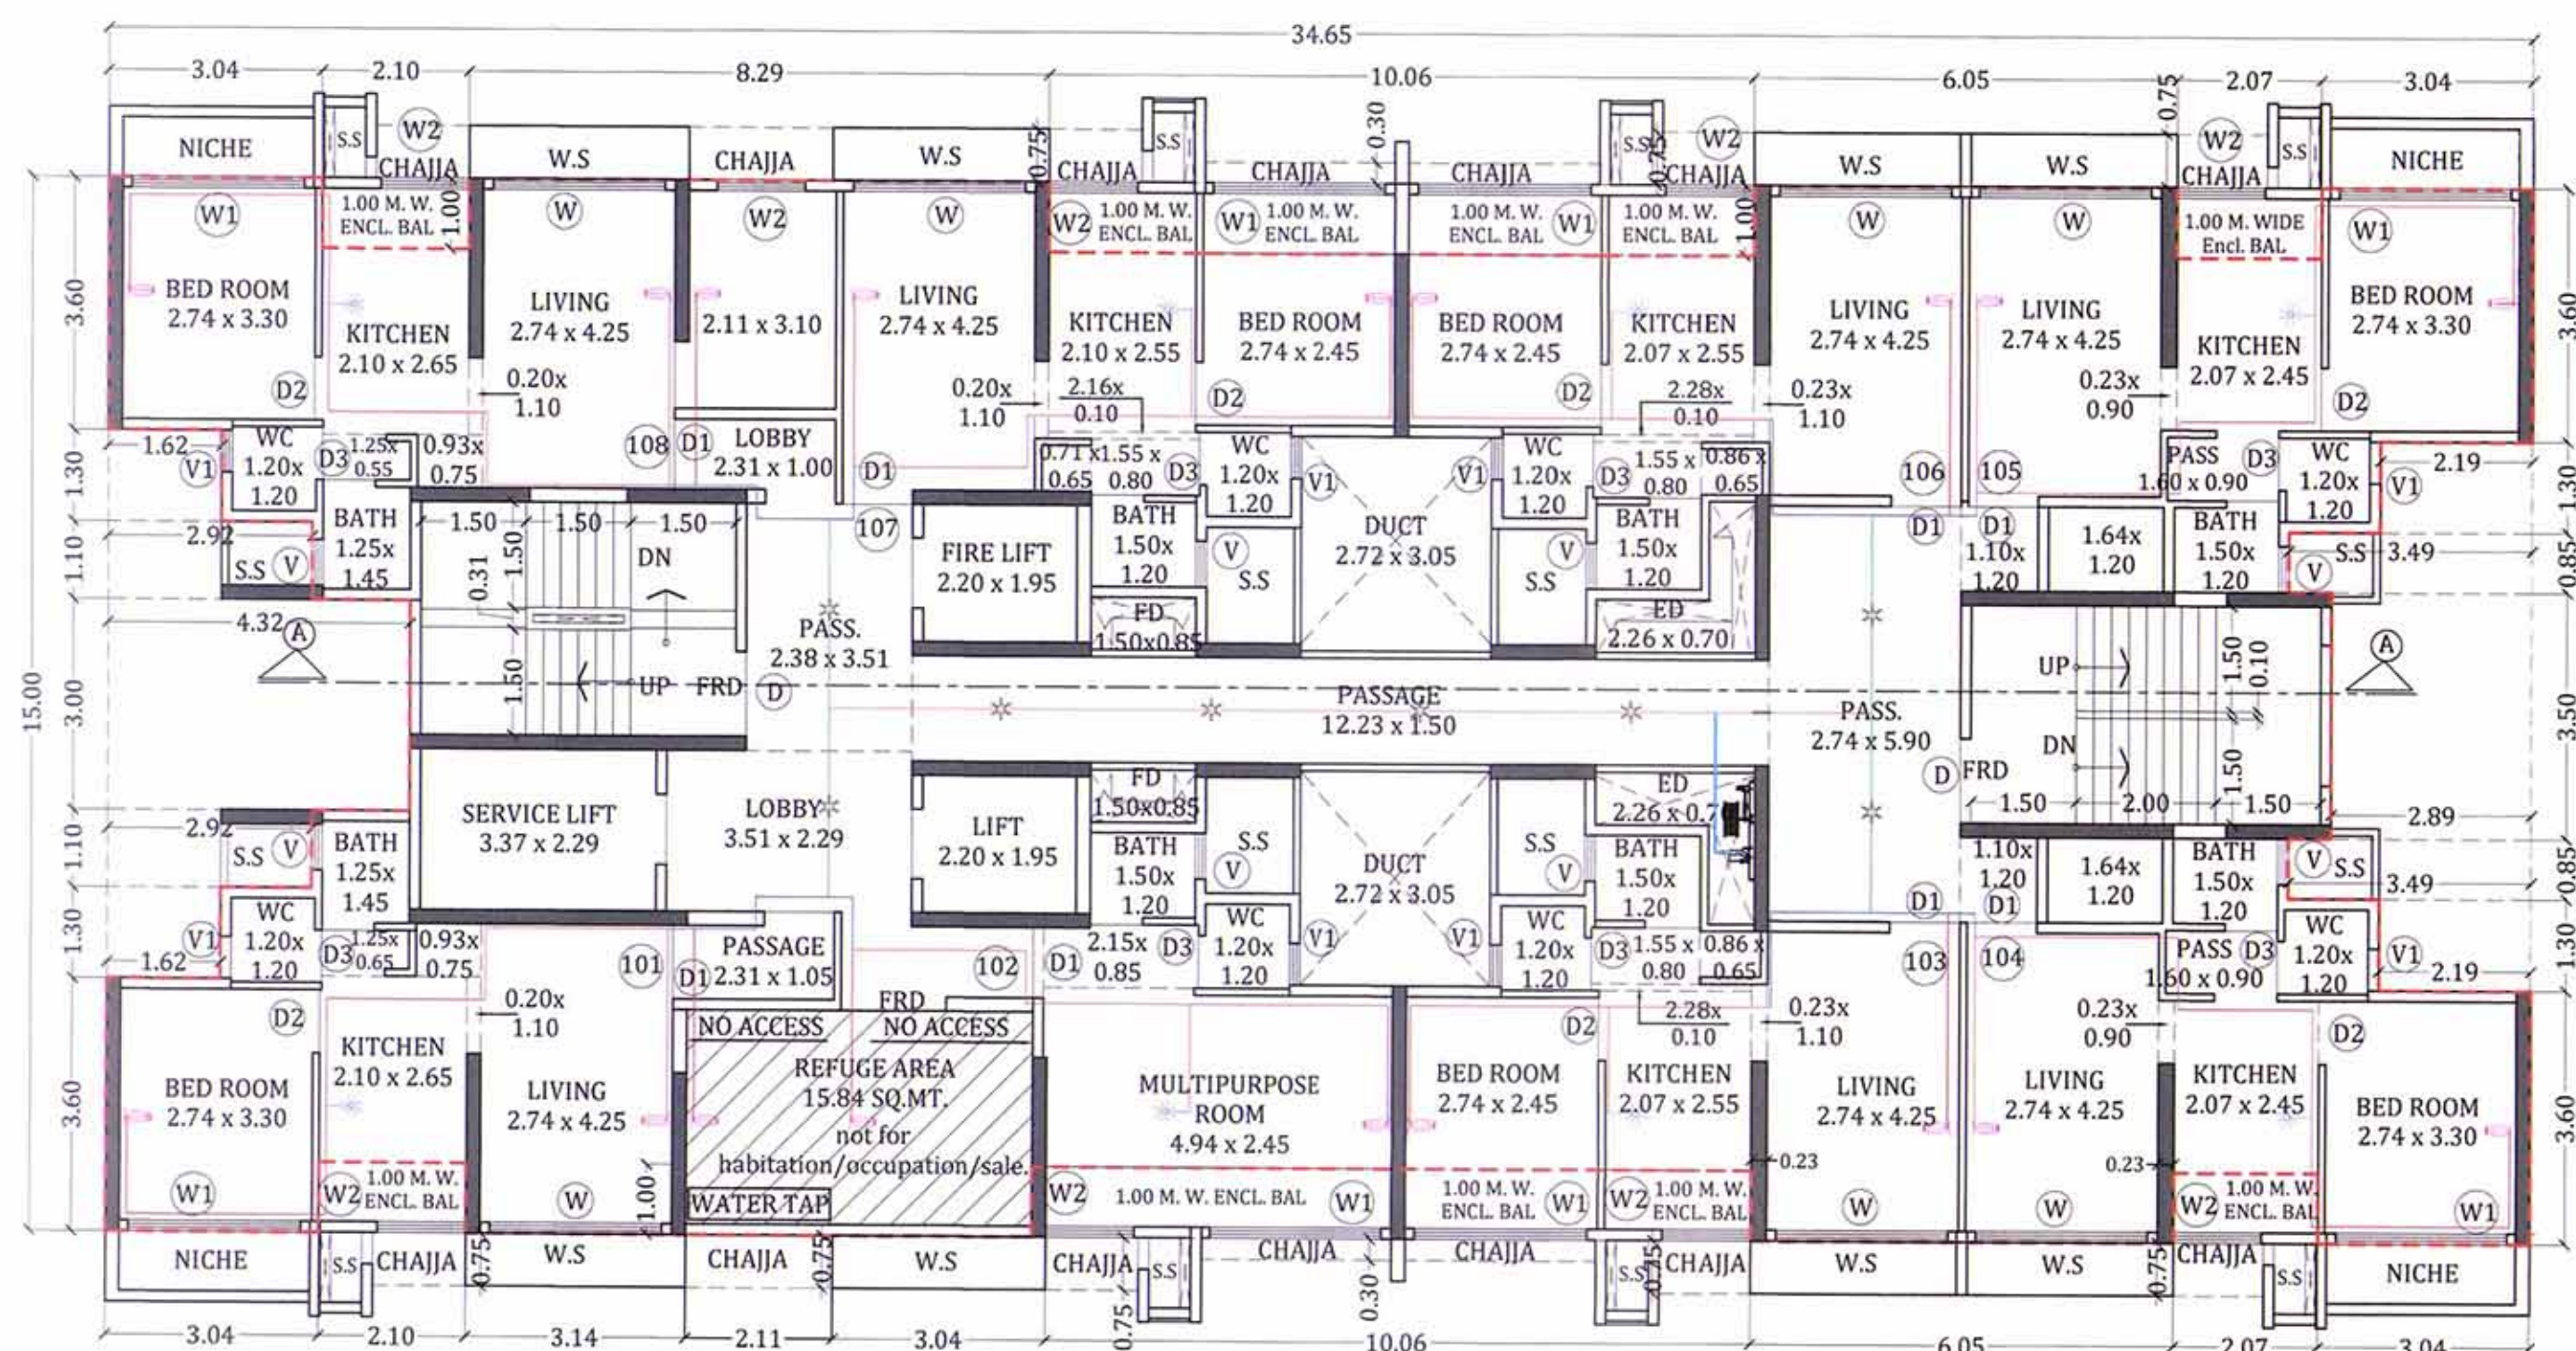

REFUGE FLOOR PLAN (30TH FLOOR)
[BLDG NO.2, WING - I, J & K]
SCALE 1:100

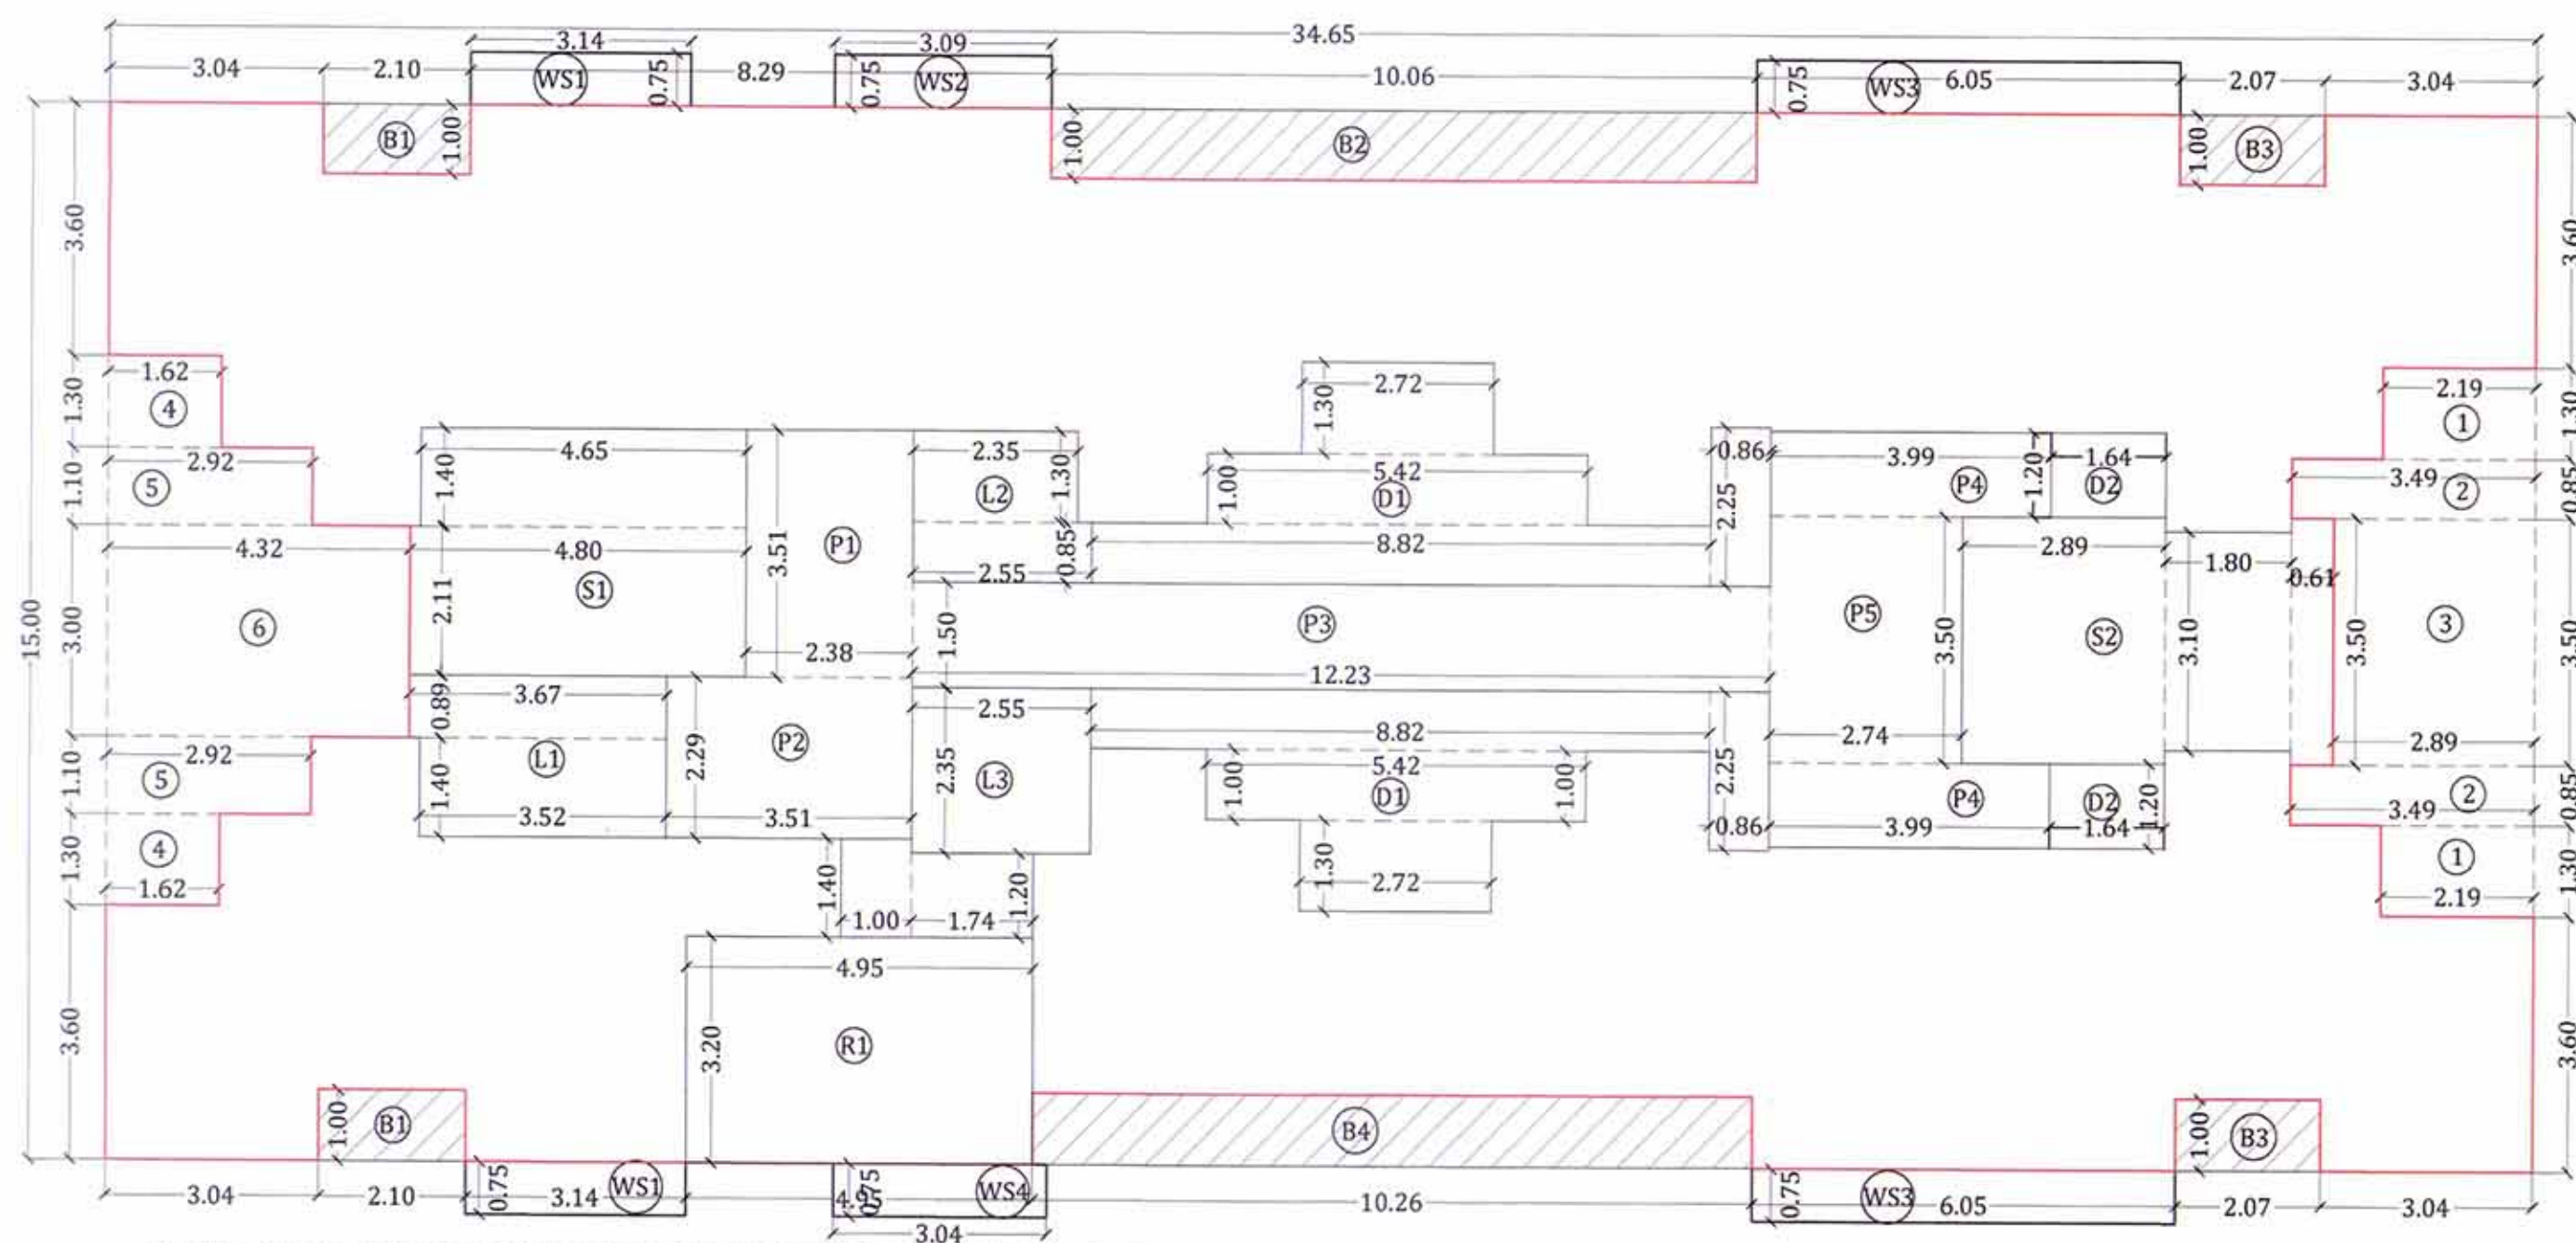

LINE AREA DIAGRAM(PART REFUGE) FOR 30TH FLOOR PLAN
[BLDG NO.2, WING - I, J & K]
SCALE 1:100

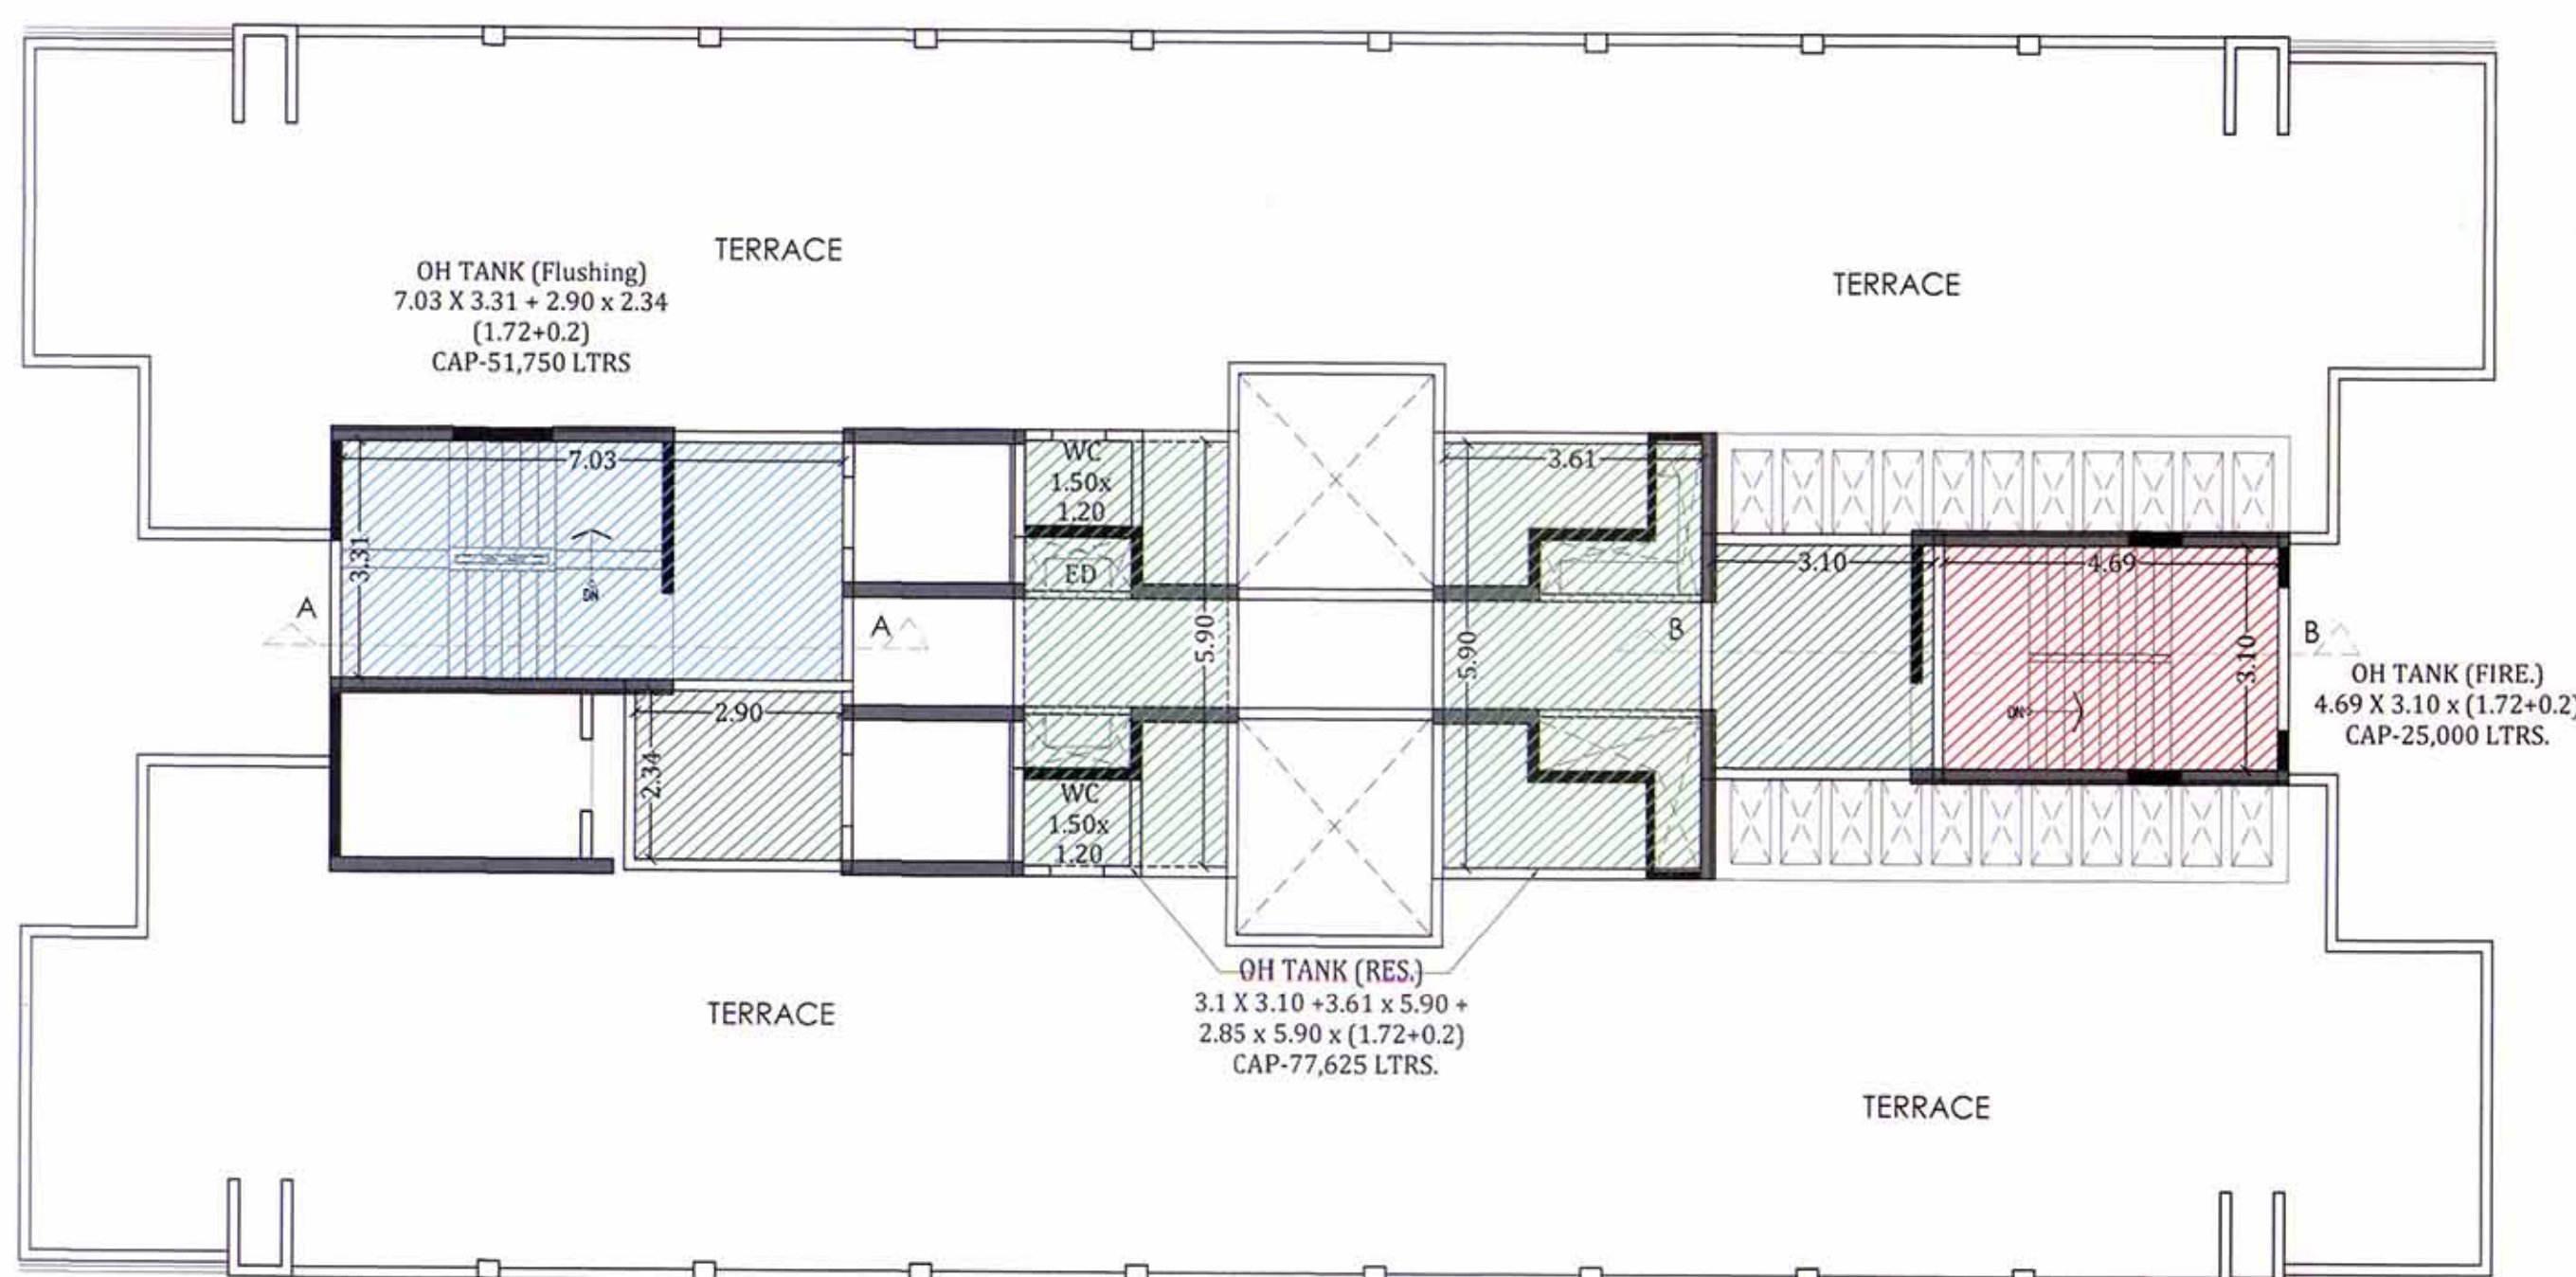


TERRACE FLOOR PLAN (BLDG NO.2, WING I, J & K)
SCALE :- 1:100

BUILT UP AREA CALCULATION FOR (BLDG NO.2, WING I, J & K)				
BUILT UP AREA CAL FOR 32ND REFUGE FLOOR				
ADDITION				
A	34.65	x	15.00	x 1 = 519.75 SQ.MT.
TOTAL (X)				= 519.75 SQ.MT.
STANDARD DEDUCTION				
1	2.19	x	1.30	x 2 = 5.69 SQ.MT.
2	3.49	x	0.85	x 2 = 5.93 SQ.MT.
3	2.89	x	3.50	x 1 = 10.12 SQ.MT.
4	1.62	x	1.30	x 2 = 4.21 SQ.MT.
5	2.92	x	1.10	x 2 = 6.42 SQ.MT.
6	4.32	x	3.00	x 1 = 12.96 SQ.MT.
B1	2.10	x	1.00	x 2 = 4.20 SQ.MT.
B2	10.06	x	1.00	x 1 = 10.06 SQ.MT.
B3	2.07	x	1.00	x 2 = 4.14 SQ.MT.
B4	10.26	x	1.00	x 1 = 10.26 SQ.MT.
TOTAL (Y1)				= 73.99 SQ.MT.
DUCT DEDUCTION				
D1	2.72	x	1.30	x 2 = 7.07 SQ.MT.
"	5.42	x	1.00	x 2 = 10.84 SQ.MT.
"	8.82	x	0.85	x 2 = 14.99 SQ.MT.
"	0.86	x	2.25	x 2 = 3.87 SQ.MT.
D2	1.64	x	1.20	x 2 = 3.94 SQ.MT.
TOTAL (Y2)				= 40.71 SQ.MT.
STAIRCASE, LIFT, LIFT LOBBY DEDUCTION				
S1	4.65	x	1.40	x 1 = 6.51 SQ.MT.
"	4.80	x	2.11	x 1 = 10.13 SQ.MT.
S2	2.89	x	3.50	x 1 = 10.12 SQ.MT.
"	1.80	x	1.30	x 1 = 5.58 SQ.MT.
"	0.61	x	3.50	x 1 = 2.14 SQ.MT.
L1	3.67	x	0.89	x 1 = 3.27 SQ.MT.
"	3.52	x	1.40	x 1 = 4.93 SQ.MT.
L2	2.55	x	0.85	x 1 = 2.17 SQ.MT.
"	2.35	x	1.30	x 1 = 3.06 SQ.MT.
L3	2.55	x	2.35	x 1 = 5.99 SQ.MT.
P1	2.38	x	3.51	x 1 = 8.35 SQ.MT.
P2	3.51	x	2.29	x 1 = 8.04 SQ.MT.
"	1.00	x	1.40	x 1 = 1.40 SQ.MT.
"	1.74	x	1.20	x 1 = 2.09 SQ.MT.
P3	12.23	x	1.50	x 1 = 18.35 SQ.MT.
P4	3.99	x	1.20	x 2 = 9.58 SQ.MT.
P5	2.74	x	3.50	x 1 = 9.59 SQ.MT.
TOTAL (Y3)				= 111.30 SQ.MT.
REFUGE DEDUCTION				
R1	4.95	x	3.20	x 1 = 15.84 SQ.MT.
TOTAL (Y4)				= 15.84 SQ.MT.
REFUGE REQUIRED (Y5)				
TOTAL DEDUCTION Y6 (Y1+Y2+Y3+Y4)				= 241.84 SQ.MT.
BUILT UP AREA (B) (X - Y6)				= 277.91 SQ.MT.
EXCESS REFUGE AREA (Y7) (Y4-Y5)				= 0.84 SQ.MT.
TOTAL BUILT UP AREA (C) (B+Y7)				= 278.75 SQ.MT.
PERM. BALCONY (D) (B x 10%)				= 27.79 SQ.MT.
BALCONY AREA STATEMENT				
B1	2.10	x	1.00	x 2 = 4.20 SQ.MT.
B2	10.06	x	1.00	x 1 = 10.06 SQ.MT.
B3	2.07	x	1.00	x 2 = 4.14 SQ.MT.
B4	10.26	x	1.00	x 1 = 10.26 SQ.MT.
PROPOSED BALCONY (E)				= 28.66 SQ.MT.
EXCESS BALCONY (F) (E - D)				= 0.87 SQ.MT.
TOTAL NET BUILT UP AREA (C + F)				= 279.62 SQ.MT.
ADD WS AREA (H)				= 18.38 SQ.MT.
TOTAL NET BUILT UP AREA (G + H)				= 298.00 SQ.MT.

CARPET AREA STATEMENT FOR 30th FLOOR				
FOR FLAT NO. 102, 103, 106 & 107				
MP ROOM	4.94	x	2.45	x 1 = 12.10 SQ.MT.
"	2.15	x	0.85	x 1 = 1.83 SQ.MT.
BATH	1.50	x	1.20	x 1 = 1.80 SQ.MT.
WC	1.20	x	1.20	x 1 = 1.44 SQ.MT.
TOTAL AREA				= 17.17 SQ.MT.

REFUGE AREA STATEMENT				
REFUGE AREA REQ. AT 30TH FOR (BLDG NO.2, WING I, J & K)	TOTAL NO. OF PERSON ABOVE FLOORS			
30TH PART REFUGE FLOOR [A]	8.00	X	1.00	8
TOTAL FLAT				8
NO. OF PERSON PER FLAT [B]				5
TOTAL PERSON (C = A X B)				40
REQ. 0.3 SQ.MTS. PER PERSON				0.3
TOTAL REQ. REFUGE AREA				12.00
MIN. REQ. REFUGE AREA				15.00
TOTAL PROVIDED REFUGE AREA				15.84

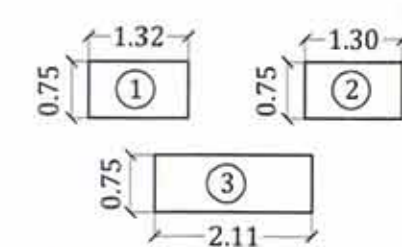

LINE AREA DIAGRAM OF CHAJJA
SCALE 1:100

CHAJJA AREA				
1	1.32	x	0.75	x 4 = 3.96 SQ.MT.
2	1.30	x	0.75	x 4 = 3.90 SQ.MT.
3	2.07	x	2.45	x 1 = 5.07 SQ.MT.
TOTAL AREA				= 12.93 SQ.MT.

PROFORMA - B		05/10																																										
CONTENTS OF SHEET																																												
30TH REFUGE FLOOR PLAN, LINE AREA DIAGRAM & CALCULATION (SALE BLDG NO.2, WING I, J & K)																																												
STAMP OF DATE OF APPROVAL OF PLAN																																												
AS BUILT DRAWING APPROVED Subject to the conditions mentioned in this office's letter No.: CIDCO/NAIPA/Panvel/Shiloter Raichur & Aakurli/BP-92/Partoc/2013/ Dated 21 AUG 2018 Associate Planner (NAIPA)																																												
STAMP OF DATE OF RECEIPT OF PLAN																																												
<table border="1"> <tr> <th colspan="6">DOOR & WINDOW SCHEDULED</th></tr> <tr> <th>DOOR</th><th>SIZE</th><th>TYPE</th><th>WINDOW</th><th>SIZE</th><th>TYPE</th></tr> <tr> <td>D1</td><td>1.50x2.10</td><td>FIRE RESISTANT DOOR</td><td>W1</td><td>2.40x1.00</td><td>ALLU SLIDING WINDOW</td></tr> <tr> <td>D2</td><td>0.90x2.10</td><td>PANELLED DOOR</td><td>W2</td><td>1.20x1.00</td><td>ALLU SLIDING WINDOW</td></tr> <tr> <td>D3</td><td>0.75x2.10</td><td>N FLUSH DOOR</td><td>W3</td><td>1.20x1.20</td><td>ALLU SLIDING WINDOW</td></tr> <tr> <td></td><td></td><td></td><td>V1</td><td>0.60x0.90</td><td>ALLU SLIDING WINDOW</td></tr> <tr> <td></td><td></td><td></td><td>V2</td><td>0.60x0.90</td><td>ALLU SLIDING WINDOW</td></tr> </table>			DOOR & WINDOW SCHEDULED						DOOR	SIZE	TYPE	WINDOW	SIZE	TYPE	D1	1.50x2.10	FIRE RESISTANT DOOR	W1	2.40x1.00	ALLU SLIDING WINDOW	D2	0.90x2.10	PANELLED DOOR	W2	1.20x1.00	ALLU SLIDING WINDOW	D3	0.75x2.10	N FLUSH DOOR	W3	1.20x1.20	ALLU SLIDING WINDOW				V1	0.60x0.90	ALLU SLIDING WINDOW				V2	0.60x0.90	ALLU SLIDING WINDOW
DOOR & WINDOW SCHEDULED																																												
DOOR	SIZE	TYPE	WINDOW	SIZE	TYPE																																							
D1	1.50x2.10	FIRE RESISTANT DOOR	W1	2.40x1.00	ALLU SLIDING WINDOW																																							
D2	0.90x2.10	PANELLED DOOR	W2	1.20x1.00	ALLU SLIDING WINDOW																																							
D3	0.75x2.10	N FLUSH DOOR	W3	1.20x1.20	ALLU SLIDING WINDOW																																							
			V1	0.60x0.90	ALLU SLIDING WINDOW																																							
			V2	0.60x0.90	ALLU SLIDING WINDOW																																							
<table border="1"> <tr> <th colspan="5">LIGHT AND VENTILATION STATEMENT</th></tr> <tr> <th>ROOM</th><th>AREA OF ROOM (SQ.M)</th><th>AREA OF WIN REQ. (SQ.M)</th><th>AREA OF WIN</th><th>TYPE OF WINDOW</th></tr> <tr> <td>LIVING</td><td>11.645</td><td>1.941</td><td>4.920</td><td>W</td></tr> <tr> <td>BED</td><td>9.042</td><td>1.507</td><td>3.598</td><td>W1</td></tr> <tr> <td>KITCHEN</td><td>5.595</td><td>0.928</td><td>2.018</td><td>W2</td></tr> <tr> <td>BATH</td><td>1.813</td><td>0.332</td><td>0.580</td><td>V</td></tr> <tr> <td>WC</td><td>1.440</td><td>0.240</td><td>0.540</td><td>V1</td></tr> </table>			LIGHT AND VENTILATION STATEMENT					ROOM	AREA OF ROOM (SQ.M)	AREA OF WIN REQ. (SQ.M)	AREA OF WIN	TYPE OF WINDOW	LIVING	11.645	1.941	4.920	W	BED	9.042	1.507	3.598	W1	KITCHEN	5.595	0.928	2.018	W2	BATH	1.813	0.332	0.580	V	WC	1.440	0.240	0.540	V1							
LIGHT AND VENTILATION STATEMENT																																												
ROOM	AREA OF ROOM (SQ.M)	AREA OF WIN REQ. (SQ.M)	AREA OF WIN	TYPE OF WINDOW																																								
LIVING	11.645	1.941	4.920	W																																								
BED	9.042	1.507	3.598	W1																																								
KITCHEN	5.595	0.928	2.018	W2																																								
BATH	1.813	0.332	0.580	V																																								
WC	1.440	0.240	0.540	V1																																								
WALL SPECIFICATION ALL INTERNAL WALLS ARE 100 MM THICK ALL EXTERNAL WALLS ARE 150 MM THICK AND WHEREVER SHEAR WALLS COMING, THERE ARE 230 AND 200 MM THICKNESS																																												
DESCRIPTION OF PROPOSAL & PROPERTY PART OCCUPANCY CERTIFICATE OF BUILDING NO.2, WING I, J & K (SALE COMPONENT) & BUILDING NO.3 & 4 (PT) (RENTAL COMPONENT) FOR PROPOSED RENTAL HOUSING SCHEME ON LAND BEARING NEW S.NO.45/2, (OLD S. NO. 45/4, 45/8, 45/9, 45/11(PT), 45/18 (PT) AT VILLAGE - SHILOTER RAICHUR AND S.NO. 173/0 AT VILLAGE - AAKURLI TAL - PANVEL DIST - RAIGAD																																												
NORTH	JOB. NO.	DRG. NO.	DRAWN BY																																									
	SCALE	DATE	CHECKED BY																																									
	1:100																																											
REVISIONS	DESCRIPTION :																																											
R-0																																												
NAME AND ADDRESS OF DESIGN ARCHITECT	SIGNATURE																																											
VASTOSPATI design group	AR. P.K.MADHAV Architects *Interior Designers Off.NO: A-305 Shiv Chamber Plot-21, Sec-11 Nr. Rly. Stn. CBD Belapur, Navi Mumbai		VASTOSPATI design group Architects Ar P K MADHAV A-304/305, Shiv Chambers, Plot No-21, Sector-11, CBD Belapur, Navi Mumbai																																									
NAME OF THE OWNER	SIGNATURE																																											
SHRI. VINAY S. AGRAWAL																																												
NAME OF ARCHITECT	DEVYANI KHADILKAR																																											
LICENSE NO	CA/90/13184																																											
ADDRESS	 B-106, Natraj Building, Mulund Goregaon Link Road Mulund (w), Mumbai : 400 080																																											

CONTENTS OF SHEET

SECTION AA (SALE BLDG NO.2, WING I, J & K)

STAMP OF DATE OF APPROVAL OF PLAN

AS BUILT DRAWING APPROVED
Subject to the conditions mentioned
in this office's letter No.
CIDCO/NAINA/ Panvel/Shiloter Raichur/Akudli /BP-12/Part 2/2018/2023
Dated 21 AUG 2019
Associate Planner (NAINA)

STAMP OF DATE OF RECEIPT OF PLAN

DESCRIPTION OF PROPOSAL & PROPERTY

DEVELOPMENT PERMISSION FOR PROPOSED RENTAL HOUSING SCHEME ON LAND BEARING NEW S.NO.45/2, (OLD S. NO. -45/4, 45/8B, 45/9, 45/11(P1), 45/18 (P1) AT VILLAGE - SHILOTER RAICHUR AND S.NO. 173/0 AT VILLAGE - AAKURLI TAL - PANVEL DIST - RAIGAD

NORTH	JOB. NO.	DRG. NO.	DRAWN BY
		06/10	
SCALE	DATE		
	1:100		
REVISIONS	DESCRIPTION :		
R-0			

NAME AND ADDRESS OF DESIGN ARCHITECT

AR. P. K. MADHAV
architects "Interior designers"
Off.No. A-305 Shiv Chamber
Plot-21, Sec-11 Nr. Rly. Stn.
CBD Belapur, Navi Mumbai

NAME OF THE OWNER

SHRI. VINAY S. AGRAWAL

NAME OF ARCHITECT


DEVYANI KHADILKAR

LICENSE NO

CA/90/13184

ADDRESS

SPACE AGE CONSULTANTS
B-106, Netraj Building,
Mulund Goregaon Link Road
Mulund (w), Mumbai - 400 060

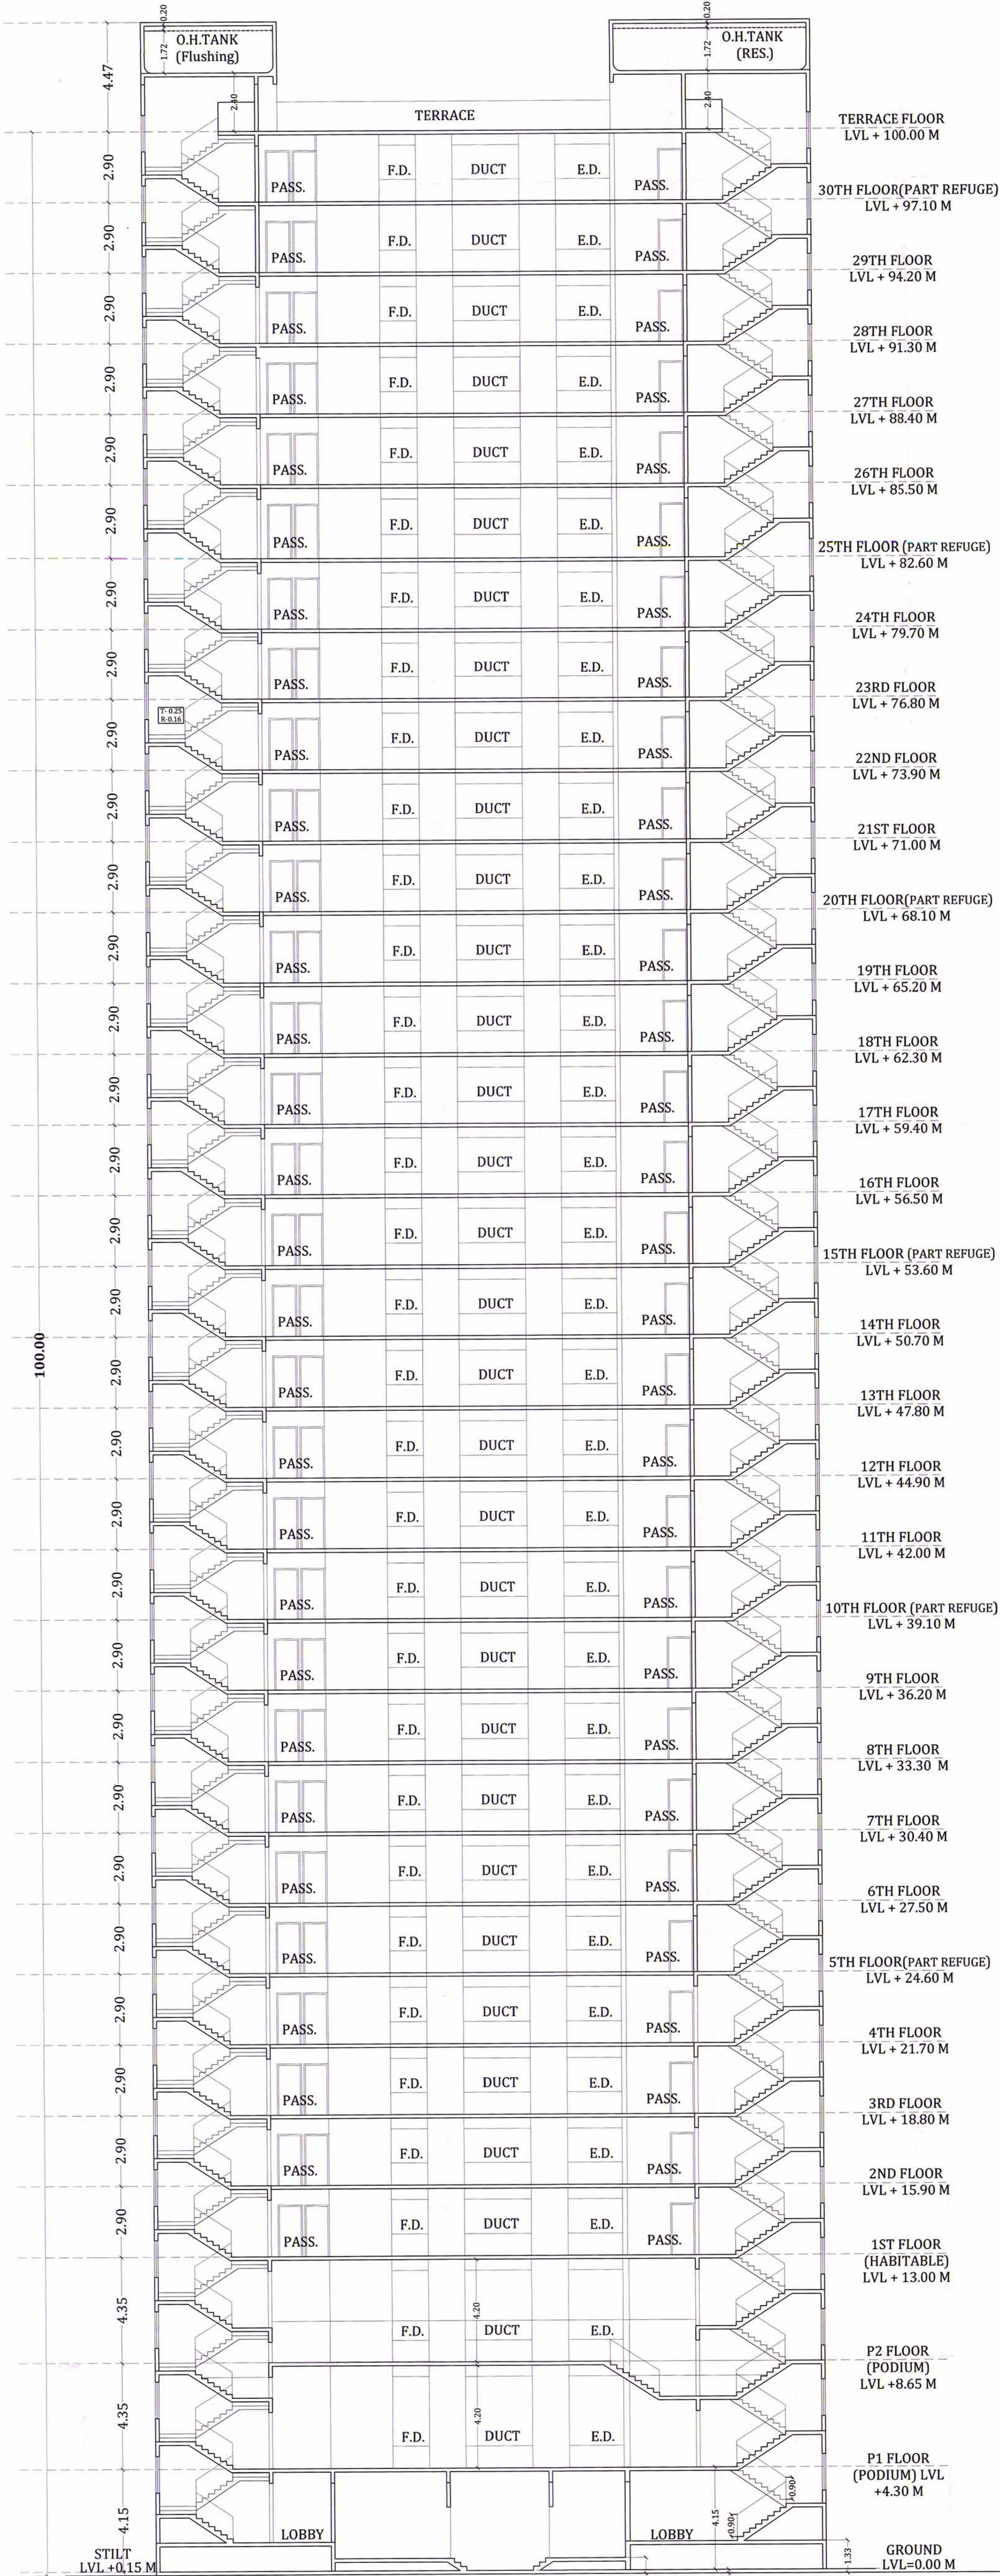

SECTION A-A(BLDG NO.2, WING I, J & K)
SCALE-1:100



PROFORMA -B		09/10
CONTENTS OF SHEET		
MMRDA RENTAL BLDG - SECTION & ELEVATION DETAILS OF BUILDING-4		
STAMP OF DATE OF APPROVAL OF PLAN		
AS BUILT DRAWING APPROVED Subject to the conditions mentioned in this office's letter No.: CIDCO/NAINA/Parvelli/Shilota/Raichur/Akurti/BP-42/Pastoc/2018/2023 Dated 21 AUG 2018 Associate Planner (NAINA)		
STAMP OF DATE OF RECEIPT OF PLAN		
DESCRIPTION OF PROPOSAL & PROPERTY		
PART OCCUPANCY CERTIFICATE OF BUILDING NO.2, WING I, J & K (SALE COMPONENT) & BUILDING NO.3 & 4 (PT) (RENTAL COMPONENT) FOR PROPOSED RENTAL HOUSING SCHEME ON LAND BEARING NEW S.NO.45/2, (OLD S. NO. - 45/4, 45/88, 45/9, 45/11(PT), 45/18 (PT) AT VILLAGE - SHILOTER RAICHUR AND S.NO. 173/8 AT VILLAGE - AAKURLI TAL - PANVEL DIST - RAIGAD		
NORTH	JOB. NO.	DRG. NO.
SCALE	DATE	CHECKED BY
1:100		
REVISIONS	DESCRIPTION :	
R-0		
NAME AND ADDRESS OF DESIGN ARCHITECT		
AR. P.K.MADHAV * architects *Interior designers Off.NO: A-305 Shiv Chamber Plot-21, Sec-11 Nr. Rly. Stn. CBD Belapur, Navi Mumbai		
NAME OF THE OWNER		
MR. VINAY S. AGRAWAL		
SIGNATURE		
NAME OF ARCHITECT		
DEVYANI KHADILKAR		
LICENSE NO		
CA/90/13184		
ADDRESS		
B-106, Natraj Building, Mulund Goregaon Link Road Mulund (w), Mumbai : 400 080		



SECTION-AA OF RENTAL BUILDING-3
SCALE:- 1:100

ELEVATION OF RENTAL BUILDING-3

PROFORMA -B

10/10

CONTENTS OF SHEET

MMRDA RENTAL BLDG - SECTION & ELEVATION DETAILS OF
BUILDING-1,2 & 3

STAMP OF DATE OF APPROVAL OF PLAN

AS BUILT DRAWING APPROVED
Subject to the conditions mentioned
in this office's letter No.:

CIDCO/NAINA/ Panvel/Shilota/Raichur & Akurli/BP-42/Partoc/2010/
2023

Dated 21 AUG 2018
Associate Planner (NAINA)

STAMP OF DATE OF RECEIPT OF PLAN

DESCRIPTION OF PROPOSAL & PROPERTY


PART OCCUPANCY CERTIFICATE OF BUILDING NO.2, WING I, J & K (SALE COMPONENT) &
BUILDING NO.3 & 4 (PT) (RENTAL COMPONENT) FOR PROPOSED RENTAL HOUSING SCHEME ON
LAND BEARING NEW S.NO.45/2, (OLD S. NO.- 45/4, 45/8, 45/9, 45/11(PT), 45/18 (PT) AT
VILLAGE - SHILOTER RAICHUR AND S.NO. 173/0 AT VILLAGE - AAKURLI TAL - PANVEL DIST - RAIGAD

NORTH	JOB. NO.	DRG. NO.	DRAWN BY
	SCALE	10/10	CHECKED BY
	1:100	DATE	

REVISIONS DESCRIPTION :

R-0

NAME AND ADDRESS OF DESIGN ARCHITECT

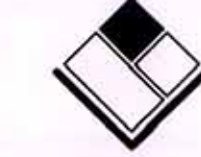

AR. P.K.MADHAV
* architects *Interior designers
Off.No: A-305 Shiv Chamber
Plot-21, Sec-11 Nr. Rly. Stn.
CBD Belapur, Navi Mumbai

NAME OF THE OWNER

MR. VINAY S. AGRAWAL

NAME OF ARCHITECT

DEVYANI KHADILKAR

LICENSE NO

CA/90/13184

ADDRESS



8-106, Natraj Building,
Mulund Goregaon Link Road
Mulund (w), Mumbai : 400 080