PLOT AREA SUMMARY

SR.NO.	S. NO. / H. NO.	N.A. AREA OF 7/12, OWNED BY THE APPLICANT	AREA OF RHS AS PER MMRDA APPROVAL DTD 02/11/2010	SWAPPING AREA DETAILS		AREA OF RHS ASPER MMRDA AAPROVAL DTD 28/03/2014	AREA UNDER RENTAL AMENITY	AREA UNDER SALE AMENITY	NET PLOT AREA (AFTER DEDUCTING AMENITY)	RENTAL PLOT AREA (25%)	SALE PLOT AREA (75%)
				DEDUCTED	ADDED						
1	95 / 1	1900.00	1900.00	0.00	0.00	1900.00	0.00	0.00	1900.00	0.00	1900.00
2	95 / 2	3500.00	3500.00	2612.00	0.00	888.00	0.00	0.00	888.00	0.00	888.00
3	95 / 3A	1800.00	1800.00	1706.00	0.00	94.00	0.00	0.00	94.00	0.00	94.00
4	98 / 1	2710.00	2710.00	2339.00	0.00	371.00	0.00	0.00	371.00	0.00	371.00
5	98 / 2	3970.00	3970.00	2681.98	0.00	1288.02	0.00	0.00	1288.02	0.00	1288.02
6	98 / 3	6580.00	6580.00	962.00	0.00	5618.00	0.00	0.00	5618.00	0.00	5618.00
7	98 / 4A	3780.00	3780.00								
8	98 / 4/B/1	3640.00	3640.00	2871.00	0.00	8319.00	0.00	0.00	8319.00	0.00	8319.00
9	98 / 4/B/2	3770.00	3770.00								
10	98 / 5	4431.00	4431.00	3060.00	0.00	1371.00	0.00	0.00	1371.00	0.00	1371.00
11	98 /T/3	800.00	800.00	0.00	0.00	800.00	0.00	0.00	800.00	0.00	800.00
12	98 / 8	2600.00	2600.00	0.00	0.00	2600.00	0.00	0.00	2600.00	0.00	2600.00
13	98 / 9	1720.00	1720.00	688.00	0.00	1032.00	0.00	0.00	1032.00	0.00	1032.00
14	98 / 10A	1460.00	1460.00	1010.00	0.00	5530.00	0.00	0.00	5530.00	0.00	5530.00
15	98 / 10B	5080.00	5080.00								
16	99	4400.00	4400.00	2933.00	0.00	1467.00	0.00	0.00	1467.00	0.00	1467.00
17	101 / 3	2120.00	2120.00	0.00	0.00	2120.00	0.00	0.00	2120.00	0.00	2120.00
18	101 / 4/A	2070.00	2070.00	0.00	0.00	2070.00	0.00	0.00	2070.00	0.00	2070.00
19	101 / 4/B	1240.00	1240.00	0.00	0.00	1240.00	0.00	0.00	1240.00	0.00	1240.00
20	101 / 4/C	1670.00	1670.00	0.00	0.00	1670.00	0.00	0.00	1670.00	0.00	1670.00
21	101 / 5	7180.00	7180.00	0.00	0.00	7180.00	0.00	0.00	7180.00	0.00	7180.00
22	101 / 6	3290.00	3290.00	0.00	0.00	3290.00	0.00	0.00	3290.00	0.00	3290.00
23	101 / 7	4200.00	4200.00	0.00	0.00	4200.00	0.00	0.00	4200.00	0.00	4200.00
24	101 / 8A	4430.00	4430.00	91.00	0.00	10239.00	0.00	0.00	10239.00	0.00	10239.00
25	101 / 8B	5900.00	5900.00								
26	101 / 9	5110.00	5110.00	0.00	0.00	5110.00	0.00	0.00	5110.00	0.00	5110.00
27	101 / 10/A	4400.00	4400.00	0.00	0.00	8450.00	2786.00	1266.00	4398.00	0.00	4398.00
28	101 / 10/B	4050.00	4050.00								
29	102	3920.00	3920.00	2333.00	0.00	1587.00	0.00	306.00	1281.00	0.00	1281.00
30	103 / 1	730.00	730.00	0.00	0.00	730.00	25.77	30.33	673.90	0.00	673.90
31	103 / 2	7210.00	7210.00	0.00	0.00	7210.00	344.00	6002.00	864.00	0.00	864.00
32	103 / 3	1240.00	1240.00	0.00	0.00	1240.00	0.00	1240.00	0.00	0.00	0.00
33	103 / 4	2960.00	2960.00	0.00	0.00	2960.00	0.00	623.00	2337.00	0.00	2337.00
34	110 / 10	5740.00	5740.00	0.00	0.00	5740.00	0.00	0.00	5740.00	4510.00	1230.00
35	110 / 11	6630.00	6630.00	0.00	0.00	6630.00	0.00	0.00	6630.00	605.00	6025.00
36	110/A	18250.00		0.00	0.00	16086.98	0.00	0.00	16086.98	16086.98	0.00
37	110 / 4	1770.00		0.00	1770.00	1770.00	0.00	0.00	1770.00	1770.00	0.00
38	110 / 5A	2900.00		0.00	2900.00	2900.00	0.00	0.00	2900.00	2900.00	0.00
39	110 / 6A	2530.00		0.00	2530.00	2530.00	0.00	0.00	2530.00	2530.00	0.00
TOTAL		**151681.00**	**126231.00**	**23286.98**	**23286.98**	**126231.00**	**3155.77**	**9467.33**	**113607.90**	**28401.98**	**85205.92**

BUILT UP AREA SUMMARY FOR O.C. (SALE + COMMERCIAL BLDG.)

FLOORS	BLDG NO. 1				BLDG NO. 2
	WING A	WING B	WING C	COMMERCIAL	
2nd BASEMENT	0.00	0.00	0.00	0.00	0.00
1st BASEMENT	0.00	0.00	0.00	0.00	0.00
GR FLOOR	0.00	0.00	0.00	1314.74	0.00
1st FLOOR	0.00	0.00	0.00	1015.69	0.00
2nd FLOOR	0.00	0.00	0.00	-	0.00
3rd FLOOR	626.810	624.900	626.810	-	948.590
4th FLOOR	626.810	624.900	626.810	-	948.590
5th FLOOR	626.810	624.900	626.810	-	948.590
6th FLOOR	626.810	624.900	626.810	-	948.590
7th FLOOR (REFUGE)	636.030	634.450	636.030	-	957.820
8th FLOOR	626.810	624.900	626.810	-	948.590
9th FLOOR (REFUGE)	636.030	634.450	636.030	-	957.820
10th FLOOR	626.810	624.900	626.810	-	948.590
11th FLOOR (REFUGE)	636.030	634.450	636.030	-	957.820
12th FLOOR	626.810	624.900	626.810	-	948.590
13th FLOOR (REFUGE)	636.030	634.450	636.030	-	957.820
14th FLOOR	626.810	624.900	626.810	-	948.590
15th FLOOR (REFUGE)	636.030	634.450	636.030	-	957.820
16th FLOOR	626.810	624.900	626.810	-	948.590
17th FLOOR (REFUGE)	636.030	634.450	636.030	-	957.820
18th FLOOR	626.810	624.900	626.810	-	948.590
19th FLOOR (REFUGE)	636.030	634.450	636.030	-	957.820
20th FLOOR	626.810	624.900	626.810	-	948.590
21st FLOOR (REFUGE)	636.030	634.450	636.030	-	957.820
22nd FLOOR	626.810	624.900	626.810	-	948.590
23rd FLOOR (REFUGE)	636.030	634.450	636.030	-	957.820
24th FLOOR	626.810	624.900	626.810	-	948.590
25th FLOOR (REFUGE)	636.030	634.450	636.030	-	957.820
26th FLOOR	626.810	624.900	626.810	-	948.590
27th FLOOR (REFUGE)	-	-	-	-	957.820
28th FLOOR	-	-	-	-	948.590
29th FLOOR (REFUGE)	-	-	-	-	957.820
30th FLOOR	-	-	-	-	948.590
31st FLOOR (REFUGE)	-	-	-	-	-
TOTAL	15135.64	15093.10	15135.64	2330.43	26671.28
TOTAL B.U. AREA			74366.09		

TENAMENT DETAIL WITH CARPET AREA STATEMENT (SALE BLDG)

BLDG NO. 1		NO. OF FLAT/ FLOOR	NO. FLOORS	TOTAL	TOTAL FLATS	UPTO 35	35 TO 45	45 TO 70	MORE THAN 70
WING A	TYPICAL	7	14	98	168	0	0	56	42
	REFUGE	7	10	70		0	0	40	30
WING B	TYPICAL	7	14	98	168	0	0	56	42
	REFUGE	7	10	70		0	0	40	30
WING C	TYPICAL	7	14	98	168	0	0	56	42
	REFUGE	7	10	70		0	0	40	30
BLDG NO. 2	TYPICAL	7	16	112	196	0	0	0	112
	REFUGE	7	12	84		0	0	0	84
TOTAL					**700**	**0**	**0**	**288**	**412**
TOTAL FLATS						**700**			

No. Of trees proposed to be planted		
	REQ. TREES	
	SALE	RENTAL
For R.G. Area 5 trees per 100 sqm.	369	396
ON Plot Area 1 tree per every 100 sqm.	779	205
TOTAL NO. OF TREES PROPOSED	1148	601

BALCONY AREA STATEMENT * (IN SQ.MT.)

BUILDING - 1 (WING A)

FLOORS	PERMISSIBLE BALCONY AREA	PROPOSED BALCONY AREA ENCL.	PROJECTED	TOTAL PROPOSED BALCONY
3rd,4th,5th,6th,8th,10th,12th,14th,16th,18th,20th,22nd,24th & 26th 7th,9th,11th,13th,15th,17th,19th,21st ,23rd,25th & 27th	58.350	55.838	45.812	101.650
TOTAL NO. OF FLOORS	24	24	24	24
TOTAL AREA	**1400.400**	**1340.112**	**1099.488**	**2439.600**
EXCESS BALCONY AREA COUNTED IN FSI @ RESPECTIVE FLOORS				**43.30**

BUILDING - 1 (WING - B)

FLOORS	PERMISSIBLE BALCONY	PROPOSED BALCONY AREA ENCL.	PROJECTED	TOTAL PROPOSED
3rd,4th,5th,6th,8th,10th,12th,14th,16th,18th,20th,22nd,24th & 26th 7th,9th,11th,13th,15th,17th,19th,21st ,23rd,25th & 27th	58.350	53.973	45.777	99.750
TOTAL NO. OF FLOORS	24	24	24	24
TOTAL AREA	**1400.400**	**1295.352**	**1098.648**	**2394.000**
EXCESS BALCONY AREA COUNTED IN FSI @ RESPECTIVE FLOORS				**41.400**

BUILDING - 1 (WING C)

FLOORS	PERMISSIBLE BALCONY	PROPOSED BALCONY AREA ENCL.	PROJECTED	TOTAL PROPOSED
3rd,4th,5th,6th,8th,10th,12th,14th,16th,18th,20th,22nd,24th & 26th 7th,9th,11th,13th,15th,17th,19th,21st ,23rd,25th & 27th	58.350	55.838	45.812	101.650
TOTAL NO. OF FLOORS	24	24	24	24
TOTAL AREA	**1400.400**	**1340.112**	**1099.488**	**2439.600**
EXCESS BALCONY AREA COUNTED IN FSI @ RESPECTIVE FLOORS				**43.30**

BUILDING - 2

FLOORS	PERMISSIBLE BALCONY	PROPOSED BALCONY AREA ENCL.	PROJECTED	TOTAL PROPOSED
3rd,4th,5th,6th,8th,10th,12th,14th,16th,18th,20th,22nd,24th,26th,28th & 30th 7th,9th,11th,13th,15th,17th,19th,21st ,23rd,25th,27th,29th & 31st	92.200	6.690	107.550	114.240
TOTAL NO. OF FLOORS	29	29	29	29
TOTAL AREA	**2673.800**	**194.010**	**3118.950**	**3312.960**
EXCESS BALCONY AREA COUNTED IN FSI @ TYPICAL FLOORS				**20.320**
EXCESS BALCONY AREA COUNTED IN FSI @ REFUGE FLOORS				**19.730**
TOTAL BALCONY AREA FOR BULDING NO.1, WING A,B & C & BULDING NO.2	**6875.000**	**4169.586**	**6416.574**	**10586.160**

REQUIRED PARKING AS PER SANCTIONED DCR OF NAINA (IDP) (FOR SALE COMPONENT) (BLDG. No.1, wing A,B & C)

AREA (CARPET AREA)	PARK. REQD.	NO. OF FLATS	NO. OF CARS
UPTO 35.00 SQ.MT.	1 FOR 4 FLATS	0	0
35.00 TO 45.00 SQ.MT	1 FOR 2 FLATS	0	0
45.00 TO 70.00 SQ.MT	1 FOR 1 FLATS	288	288
MORE THAN 70.00 SQ.MT.	2 FOR 1 FLATS	216	432
TOTAL		**504**	**720**
10% VISITORS PARKING			72
TOTAL PARKING REQUIRED (A)			**792**
COMM. PARKING REQUIRED (B)			**37**
OFFICE PARKING REQUIRED (C)			**52**
TOTAL REQUIRED (A+B+C)			**881**
TOTAL PARKING PROVIDED			**916**
10% TWO WHEELER PARKING REQUIRED			89

REQUIRED PARKING AS PER SANCTIONED DCR OF NAINA (IDP) (FOR SALE COMPONENT) (BLDG NO.2)

AREA (CARPET AREA)	PARK. REQD.	NO. OF FLATS	NO. OF CARS
UPTO 35.00 SQ.MT.	1 FOR 4 FLATS	0	0
35.00 TO 45.00 SQ.MT	1 FOR 2 FLATS	0	0
45.00 TO 70.00 SQ.MT	1 FOR 1 FLATS	0	0
MORE THAN 70.00 SQ.MT.	2 FOR 1 FLATS	196	392
TOTAL		**196**	**392**
10% VISITORS PARKING			40
TOTAL PARKING REQUIRED (A)			**432**
TOTAL PARKING PROVIDED			**444**
10% TWO WHEELER PARKING REQ.			44

REQUIRED PARKING FOR COMMERCIAL AS PER SANCTIONED DCR OF NAINA (IDP) (FOR SALE COMPONENT) (Commercial,Bldg no.1, wing A,B & C FOR SHOP)

USERS	PARKING PERMISSIBLE AS PER D.C. RULES	PARKING REQUIRED
PROPOSED AREA 1765.3	1 PARKING FOR 40 SQ.MT. UPTO 800 SQ.MT.	20
	& 1 PARKING FOR EVERY 80 SQ.MT. FOR EXCEEDING 800 SQ.MT. FLR AREA	13
TOTAL		**33**
10% VISITORS PARKING		4
TOTAL PARKING REQUIRED (B)		**37**

REQUIRED PARKING FOR OFFICE AS PER SANCTIONED DCR OF NAINA (IDP) (FOR SALE COMPONENT) (Commercial,Bldg no.1, wing A,B & C FOR OFFICE)

USERS	PARKING PERMISSIBLE AS PER D.C. RULES	PARKING REQUIRED
PROPOSED AREA 1402.01	1 PARKING FOR 30 SQ.MT. UPTO 1500 SQ.MT.	47
	& 1 PARKING FOR EVERY 60 SQ.MT. FOR EXCEEDING 1500 SQ.MT. FLR AREA	0
TOTAL		**47**
10% VISITORS PARKING		5
TOTAL PARKING REQUIRED (B)		**52**

PROPOSED PARKING STATEMENT (BLDG NO. 1, WING A, B & C)

FLOOR	BIG CAR	SMALL CAR	TOTAL CAR	TWO WHEELER
2nd BASEMENT	267	19	286	129
1st BASEMENT	267	19	286	-
GROUND FLR.	92	57	149	
1ST PODIUM FLR.	95	34	129	
2ND PODIUM FLR.	49	17	66	-
TOTAL	**770**	**146**	**916**	**129**

PROPOSED PARKING STATEMENT (BLDG NO. 2)

FLOOR	IN STILT CAR	OPEN CAR	TOTAL CAR	TWO WHEELER
2nd BASEMENT	98	18	116	37
1st BASEMENT	98	18	116	31
GROUND FLR.	43	40	83	0
1ST PODIUM FLR.	34	32	66	0
2ND PODIUM FLR.	36	27	63	-
TOTAL	**309**	**135**	**444**	**68**

RENTAL R.G. AREA STATEMENT

TOTAL R.G. REQUIRED			
28401.98	**X**	**8.0%**	**= 2272.16**
R.G. PROVIDED			
R.G. 1		=	1524.38
R.G. 2		=	321.60
R.G. 3		=	609.35
R.G. 4		=	88.70
R.G. 5		=	534.20
R.G. 6		=	732.50
R.G. 7		=	1496.26
R.G. 8		=	250.91
R.G. 9		=	487.04
R.G. 10		=	418.45
R.G.11		=	426.07
R.G. 12		=	382.21
R.G. 13		=	105.74
R.G. 14		=	227.02
R.G. 15		=	310.21
TOTAL R.G. PROVIDED		=	**7914.64**

TENAMENT AREA STATEMENT (HOUSES TO BE SOLD IN OPEN MARKET)

BUILDING - 1 (WING A)

FLOORS	FLAT NO.	CARPET AREA	BALCONY AREA ENCL.	BALCONY AREA PROJECTED	B/U AREA
3RD TO 27TH	1	55.900	14.092	2.817	64.166
	2	60.070	13.827	3.017	68.088
	3	60.070	13.827	3.017	68.117
	4	55.900	14.092	2.804	64.184
	5	87.590	0.000	10.679	101.790
	6	99.946	0.000	12.830	115.171
	7	88.061	0.000	10.648	102.417
TOTAL			55.838	45.812	
NO. OF FLOORS			24.000	24.000	
TOTAL AREA (A)			1340.112	1099.488	

BUILDING - 1 (WING B)

FLOOR NO.	FLAT NO.	CARPET AREA	BALCONY AREA ENCL.	BALCONY AREA PROJECTED	B/U AREA
3RD TO 27TH	1	55.229	13.247	2.803	63.790
	2	60.070	13.741	3.050	68.077
	3	60.070	13.741	3.050	68.077
	4	55.229	13.244	2.792	63.828
	5	88.284	0.00	10.677	102.397
	6	98.943	0.00	12.692	115.071
	7	88.103	0.00	10.713	102.397
TOTAL			55.573	45.777	
NO. OF FLOORS			24.000	24.000	
TOTAL AREA (B)			1295.352	1098.648	

BUILDING - 1 (WING C)

FLOOR NO.	FLAT NO.	CARPET AREA	BALCONY AREA ENCL.	BALCONY AREA PROJECTED	B/U AREA
3RD TO 27TH	1	55.900	14.092	2.817	64.166
	2	60.070	13.827	3.017	68.088
	3	60.070	13.827	3.017	68.117
	4	55.900	14.092	2.804	64.184
	5	87.590	0.000	10.679	101.790
	6	99.946	0.000	12.830	115.171
	7	88.061	0.000	10.648	102.417
TOTAL			55.838	45.812	
NO. OF FLOORS			24.000	24.000	
TOTAL AREA (C)			1340.112	1099.488	

BUILDING - 2

FLOOR NO.	FLAT NO.	CARPET AREA	BALCONY AREA ENCL.	BALCONY AREA PROJECTED	B/U AREA
3RD TO 31ST	1	100.491	0.00	14.050	116.731
	2	141.496	0.00	21.260	159.260
	3	141.496	0.00	21.260	159.260
	4	100.491	0.00	14.050	116.731
	5	89.818	3.38	7.525	103.416
	6	142.458	0.00	21.780	162.800
	7	89.818	3.38	7.575	103.494
TOTAL			6.690	107.550	
NO. OF FLOORS			28.000	29.000	
TOTAL AREA (D)			187.320	3011.490	
TOTAL AREA (A+B+C+D)			4162.896	6309.024	

NICHE AREA STATEMENT

BUILDING - 1 (WING-A)

FLOORS	PROPOSED NICHE IN SQM.
3RD TO 26TH	27.210

BUILDING - 1 (WING - B)

FLOORS	PROPOSED NICHE IN SQM.
3RD TO 26TH	27.930

BUILDING - 1 (WING-C)


FLOORS	PROPOSED NICHE IN SQM.
3RD TO 26TH	27.210


BUILDING - 2


FLOORS	PROPOSED NICHE IN SQM.
3RD TO 30TH	21.690

AMENITY AREA STATEMENT

TOTAL AMENITY REQUIRED			
126231.00	**X**	**10.0%**	**= 12623.10**
AMENITY PROVIDED			
RENTAL AMENITY		=	3155.77
SALE AMENITY		=	9467.33
TOTAL AMENITY PROVIDED		=	**12623.10**

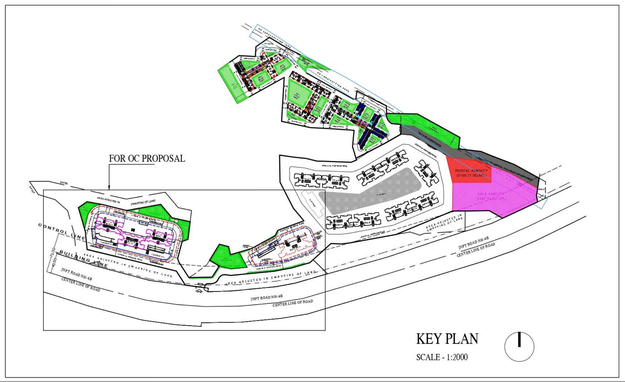

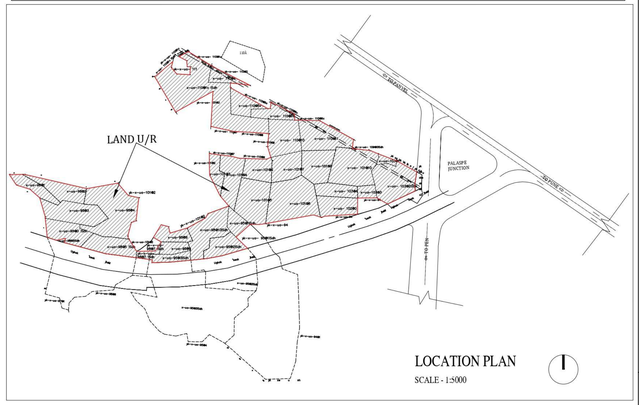

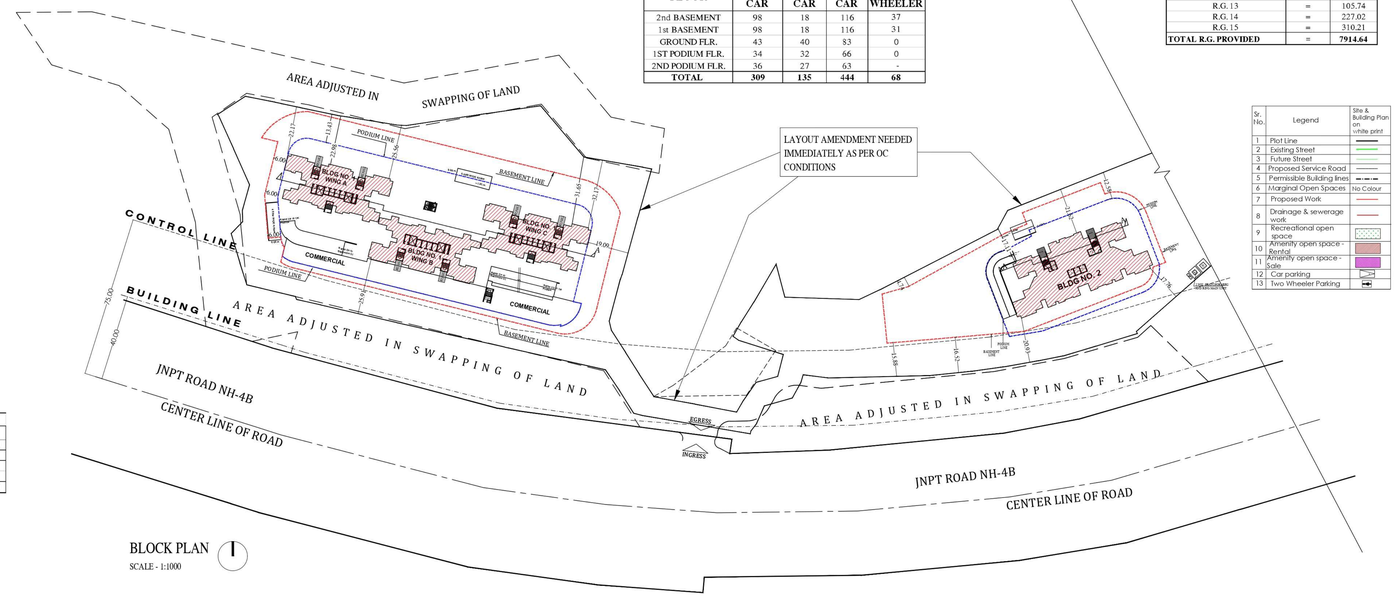

Sr. No.	Legend	Site & Building Plan on white print
1	Plot Line	
2	Existing Street	
3	Future Street	
4	Proposed Service Road	
5	Permissible Building lines	
6	Marginal Open Spaces	No Colour
7	Proposed Work	
8	Drainage & sewerage work	
9	Recreational open space	
10	Amenity open space - Rental	
11	Amenity open space - Sale	
12	Car parking	
13	Two Wheeler Parking	

STAMP FOR APPROVAL | 01/25

PART OC

This Part Occupancy Certificate is issued for Sale Building no 1 (A ,B ,C) (Till 26th Floor) & Building no 2 (Till 30th Floor), and As Built drawing is approved subject to conditions as mentioned in Part Occupancy Certificate bearing no. NAINA/6529/2021-CIDCO/NAINA/PANVEL/Kolkhe/BP- 00112/Part/ OC/ 2022/ 0217A. Dated 24.06.2022.

RAJA BHAGUJI WAGHMARE

Digitally signed by RAJA BHAGUJI WAGHMARE
Date: 2022.06.24 19:35:08 +05'30'

PROFORMA - A

A	AREA STATEMENT	AREA IN SQ.MT.
1	AREA OF LAND AS PER 7/12	151681.00
2	OVERALL AREA APPROVED BY MMRDA	149517.98
3	NET ELIGIBLE AREA OF PLOT FOR RHS (AFTER ADJUSTMENT OF SWAPPING AREA)	126231.00
4	AREA OF LAND AS PER MEASURMENT PLAN OF LAND RECORD OFFICE	126231.00
5	AREA OF LAND AS PER TRAINGULATION	126231.04
6	AREA CONSIDERED FOR PROPOSAL (LEAST OF ABOVE)	126231.00
7	DEDUCTION FOR AMENITY SPACE (10%) (REQUIRED = PROVIDED)	12623.10
8	NET AREA OF PLOT (6-7)	113697.90
		SALE PLOT (75% ON 8) / RENTAL PLOT (25% ON 8) *
9	AREA OF PROPOSAL (IN PROPORTION 75:25)	85205.92 / 28401.98
10	PERMISSIBLE FSI (ON 8)	3.00 / 1.00
11	PERMISSIBLE BUILT UP AREA (8 X 10)	340823.70 / 113607.90
12	PERMISSIBLE COMMERCIAL AREA (15% OF 11)	51123.56 / 17041.19
13	PROPOSED COMMERCIAL BUILT UP AREA	2307.55 / 849.18
14	AMENITY SPACE REQUIRED (IN PROPORTION 75:25)	9467.33 / 3155.77
15	AMENITY SPACE PROVIDED	9467.33 / 3155.77
16	RECREATIONAL GROUND SPACE REQUIRED (8% ON 9)	6816.47 / 2272.16
17	RECREATIONAL GROUND SPACE PROVIDED	7373.5 / 7914.64
18	APPROVED BUILT UP AREA AS PER CC DATED 21-02-2018	77063.86 / 113598.12
19	APPROVED BUILT UP AREA AS PER CC DATED 01-10-2019	35582.07 / 0.00
20	TOTAL PROPOSED BUILT UP AREA	112645.93 / 113598.12
21	BALANCE BUILT UP AREA	228177.77 / 9.78
22	PROPOSED BUA FOR OC AT THIS STAGE	74366.09 /
23	FSI CONSUMED	0.99 / 0.9999
24	FSI BALANCE	2.01 / 0.0001
25	TENAMENT APPROVED (RESIDENTIAL)	728 / 3243
26	UNITS APPROVED (COMMERCIAL)	52 / 24
27	TENAMENT PROPOSED FOR OC AT THIS STAGE (RESIDENTIAL)	700 / -
28	UNITS PROPOSED FOR OC AT THIS STAGE (COMMERCIAL)	53 / -
29	NO. OF TREES PROPOSED TO BE PLANTED	1148 / 601

* Rental calculation as per approved amended development permission no.CIDCO/NAINA/PANVEL/Kolkhe/BP-112/CC/2016/04389 dated 29-08-2016 & Revalidation no.CIDCO/NAINA/PANVEL/Kolkhe/BP-112/CC/Revalidation/2017/727. dated 03/10/2017.

CERTIFICATE OF AREA

Certified that the plot under reference was surveyed by me on 20.08.2014 and the dimensions of side etc. of plot stated on plan are as measured on site and the area so worked out tallies with the area stated in document of ownership/T.P. Scheme Records/ Land Records Department /city survey record.

Signature of Owner — Signature of Architect.

MANISH MADHU BATHIJA

M/s. PARADISE LIFESPACES LLP (P.O.A.H of Shri. Esmail Ebrahim Dhariwala & others)

AR.DEVYANI KHADILKAR

FORM OF CERTIFICATE

I, Ar. Devyani khadilkar, for M/s Spaceage Consultants have been employed by the applicant as his Architect. I have examined the boundaries and the area of the plot and i do hereby certify that i have personally verified and checked all the statement made by applicant who is the owner/lessee in possession of the plot as in the above form and found them to be correct.

Signature of Owner — Signature of Architect.

MANISH MADHU BATHIJA

M/s. PARADISE LIFESPACES LLP (P.O.A.H of Shri. Esmail Ebrahim Dhariwala & others)

AR.DEVYANI KHADILKAR

CONTENTS OF SHEET

BLOCK PLAN, LOCATION PLAN,KEY PLAN, BUILT UP AREA SUMMARY , RG. AREA STATEMENT, AMENITY AREA STATEMENT, TENAMENT STATEMENT, DETAILS.

DESCRIPTION OF PROPOSAL & PROPERTY

PROPOSED DEVELOPMENT FOR RENTAL HOUSING SCHEME ON LAND BEARING S.NO.95/1(pt),95/2(pt),95/3A (pt),98/1,98/2,98/3,98/4A,98/4/B/1,98/4/B/2, 98/5(pt),98/7/3(pt),98/8,98/9,98/10A,98/10B,99(pt),101/3,101/4/A,101/4/B, 101/4/C,101/5,101/6,101/7,101/8A,101/8B,101/9,101/10/A,101/10/B,102,103/1, 103/2(pt),103/3,103/4,110/1A(pt),110/4,110/5A,110/6A,110/10,110/11 at Village Kolkhe, Taluka - Panvel, District Raigad

NORTH	JOB. NO.	DRG. NO.	DRAWN BY
		01 / 25	
	SCALE	DATE	CHECKED BY
	1: 1000	-	-
REVISIONS	DESCRIPTION :		
R-0			
NAME OF THE OWNER			

MANISH MADHU BATHIJA

M/s. PARADISE LIFESPACES LLP (P.O.A.H of Shri. Esmail Ebrahim Dhariwala & others)


NAME & ADDRESS OF THE DESIGN ARCHITECT:

NAME OF ARCHITECT	M/s. DIMENSION ARCHITECTS
LICENSE NO	CA/ /
ADDRESS	PLOT NO.99, NEAR SAGAR VIHAR, SECTOR-08, VASHI, NAVI MUMBAI 400 703
NAME OF ARCHITECT	DEVYANI KHADILKAR
LIC. NO	CA/90/13184
ADDRESS	B-106, Natraj Building, Mulund Goregaon Link Road Mulund (w), Mumbai - 400 080

AMENITY CALCULATION FOR SALE & RENTAL

AMENITY OPEN SPACE (RENTAL)


ADDITION								
1	52.06	x	7.24	x	0.50	=	188.45	SQ.MT
2	65.42	x	12.94	x	0.50	=	293.87	SQ.MT
3	62.88	x	28.13	x	0.50	=	893.86	SQ.MT
4	72.82	x	13.14	x	0.50	=	478.43	SQ.MT
5	33.92	x	6.38	x	0.50	=	108.20	SQ.MT
6	71.93	x	33.17	x	0.50	=	1192.96	SQ.MT
TOTAL						=	**3155.77**	SQ.MT

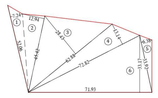

AMENITY OPEN SPACE (RENTAL)
SCALE : 1:1000

AMENITY OPEN SPACE (SALE)

ADDITION								
1	38.26	x	28.67	x	0.50	=	544.63	SQ.MT
2	87.48	x	21.36	x	0.50	=	934.29	SQ.MT
3	87.48	x	13.85	x	0.50	=	605.80	SQ.MT
4	94.17	x	9.78	x	0.50	=	460.49	SQ.MT
5	94.16	x	53.53	x	0.50	=	2520.13	SQ.MT
6	70.49	x	19.24	x	0.50	=	678.11	SQ.MT
7	72.02	x	32.90	x	0.50	=	1184.73	SQ.MT
8	89.61	x	14.15	x	0.50	=	633.99	SQ.MT
9	89.61	x	39.80	x	0.50	=	1703.24	SQ.MT
10	71.93	x	3.39	x	0.50	=	121.92	SQ.MT
TOTAL						=	**9467.33**	SQ.MT

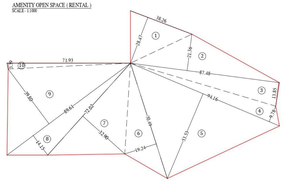

AMENITY OPEN SPACE (SALE)
SCALE : 1:1000

AMENITY AREA STATEMENT


TOTAL AMENITY REQUIRED		
126231.00 X 10.0%	=	12623.10
AMENITY PROVIDED		
RENTAL AMENITY	=	3155.77
SALE AMENITY	=	9467.33
TOTAL AMENITY PROVIDED	=	**12623.10**



LINE AREA DIA. FOR ROAD AREA UNDER NH17
SCALE:1:500

ROAD AREA UNDER NH-17

ADDITION								
1	33.81	x	13.64	x	0.50	=	225.43	SQ.MT
2	30.95	x	16.51	x	0.50	=	255.49	SQ.MT
3	17.12	x	10.44	x	0.50	=	89.38	SQ.MT
TOTAL						=	**570.80**	SQ.MT

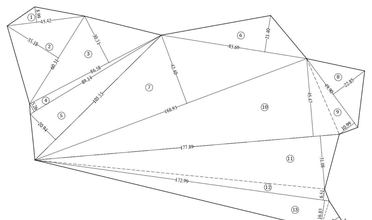

PLOT AREA CALCULATION
SCALE : 1:1000

PLOT AREA CALCULATION

ADDITION (S)								
1	45.42	x	8.99	x	0.50	=	204.16	SQ.MT
2	60.31	x	35.18	x	0.50	=	1060.05	SQ.MT
3	86.50	x	30.51	x	0.50	=	1320.78	SQ.MT
4	89.14	x	5.26	x	0.50	=	234.44	SQ.MT
5	103.55	x	20.94	x	0.50	=	1084.17	SQ.MT
6	85.69	x	21.40	x	0.50	=	916.88	SQ.MT
7	168.93	x	42.40	x	0.50	=	3581.32	SQ.MT
8	49.90	x	22.85	x	0.50	=	570.11	SQ.MT
9	49.90	x	10.99	x	0.50	=	274.20	SQ.MT
10	177.89	x	45.47	x	0.50	=	4044.33	SQ.MT
11	177.89	x	31.88	x	0.50	=	2764.41	SQ.MT
12	172.99	x	6.51	x	0.50	=	563.88	SQ.MT
13	172.99	x	16.03	x	0.50	=	1455.71	SQ.MT
14	33.65	x	12.99	x	0.50	=	218.56	SQ.MT
15	31.15	x	13.00	x	0.50	=	202.48	SQ.MT
16	36.31	x	14.55	x	0.50	=	264.16	SQ.MT
17	36.31	x	2.53	x	0.50	=	45.93	SQ.MT
18	37.52	x	6.49	x	0.50	=	121.75	SQ.MT
19	43.30	x	12.00	x	0.50	=	259.80	SQ.MT
20	14.29	x	6.51	x	0.50	=	46.51	SQ.MT
21	11.88	x	10.52	x	0.50	=	62.49	SQ.MT
22	11.88	x	1.57	x	2 /3	=	12.43	SQ.MT
23	13.10	x	4.81	x	0.50	=	31.51	SQ.MT
24	24.89	x	11.68	x	0.50	=	145.36	SQ.MT
25	22.27	x	11.84	x	0.50	=	131.84	SQ.MT
26	43.65	x	13.62	x	0.50	=	297.26	SQ.MT
27	43.65	x	14.28	x	0.50	=	311.66	SQ.MT
28	40.49	x	14.87	x	0.50	=	301.04	SQ.MT
29	38.57	x	15.11	x	0.50	=	291.40	SQ.MT
30	38.68	x	9.78	x	0.50	=	189.15	SQ.MT
31	86.59	x	36.02	x	0.50	=	1559.49	SQ.MT
32	86.59	x	25.86	x	0.50	=	1004.97	SQ.MT
33	82.33	x	19.96	x	0.50	=	821.65	SQ.MT
34	111.24	x	17.74	x	0.50	=	986.70	SQ.MT
35	111.24	x	33.35	x	0.50	=	1854.93	SQ.MT
36	105.41	x	40.80	x	0.50	=	2150.36	SQ.MT
37	105.41	x	10.65	x	0.50	=	561.31	SQ.MT
38	102.05	x	28.87	x	0.50	=	1473.09	SQ.MT
39	53.17	x	24.75	x	0.50	=	657.90	SQ.MT
40	66.04	x	17.78	x	0.50	=	587.10	SQ.MT
41	96.00	x	36.27	x	0.50	=	1740.96	SQ.MT
42	116.40	x	20.64	x	0.50	=	1201.25	SQ.MT
43	165.14	x	36.64	x	0.50	=	3025.36	SQ.MT
44	165.14	x	17.78	x	0.50	=	1468.09	SQ.MT
45	155.85	x	14.69	x	0.50	=	1144.72	SQ.MT
46	156.97	x	18.14	x	0.50	=	1423.72	SQ.MT
47	159.16	x	16.67	x	0.50	=	1326.60	SQ.MT
48	159.16	x	45.73	x	0.50	=	3639.19	SQ.MT
49	158.49	x	80.85	x	0.50	=	6406.96	SQ.MT
50	158.49	x	10.86	x	0.50	=	860.60	SQ.MT
51	202.59	x	88.22	x	0.50	=	8932.28	SQ.MT
52	223.70	x	10.05	x	0.50	=	1124.09	SQ.MT
53	264.77	x	16.61	x	0.50	=	2198.91	SQ.MT
54	75.07	x	10.82	x	0.50	=	410.46	SQ.MT
55	92.17	x	21.10	x	0.50	=	972.39	SQ.MT
56	341.83	x	44.35	x	0.50	=	7580.08	SQ.MT
57	342.14	x	32.96	x	0.50	=	5638.47	SQ.MT
58	342.14	x	53.66	x	0.50	=	9245.63	SQ.MT
59	294.21	x	22.34	x	0.50	=	3286.33	SQ.MT
60	222.67	x	7.86	x	0.50	=	914.39	SQ.MT
61	197.66	x	24.93	x	0.50	=	2463.83	SQ.MT
62	100.55	x	17.77	x	0.50	=	893.39	SQ.MT
63	197.66	x	63.39	x	0.50	=	6264.03	SQ.MT
64	135.37	x	22.92	x	0.50	=	1551.34	SQ.MT
65	94.53	x	5.58	x	0.50	=	263.72	SQ.MT
66	88.71	x	19.66	x	0.50	=	872.02	SQ.MT
67	75.26	x	11.31	x	0.50	=	425.60	SQ.MT
68	61.61	x	14.60	x	0.50	=	449.75	SQ.MT
69	75.26	x	44.45	x	0.50	=	1672.65	SQ.MT
70	58.16	x	5.28	x	0.50	=	153.54	SQ.MT
71	70.65	x	38.15	x	0.50	=	1347.65	SQ.MT
72	95.96	x	21.67	x	0.50	=	1038.96	SQ.MT
73	139.46	x	27.02	x	0.50	=	1884.10	SQ.MT
74	139.46	x	72.72	x	0.50	=	5078.77	SQ.MT
75	101.18	x	32.48	x	0.50	=	1643.16	SQ.MT
76	45.04	x	9.99	x	0.50	=	224.97	SQ.MT
77	58.56	x	15.62	x	0.50	=	457.35	SQ.MT
78	52.60	x	18.97	x	0.50	=	498.91	SQ.MT
79	87.29	x	39.68	x	0.50	=	1731.03	SQ.MT
80	87.29	x	11.27	x	0.50	=	491.88	SQ.MT
81	66.83	x	11.06	x	0.50	=	369.46	SQ.MT
82	54.76	x	22.94	x	0.50	=	628.10	SQ.MT
83	44.35	x	9.79	x	0.50	=	217.09	SQ.MT
84	99.79	x	60.11	x	0.50	=	2999.19	SQ.MT
85	93.40	x	29.06	x	0.50	=	1357.10	SQ.MT
86	88.97	x	37.95	x	0.50	=	1688.21	SQ.MT
TOTAL						=	**126256.21**	SQ.MT
DEDUCTION (Y)								
a	7.64	x	1.37	x	2 /3	=	6.98	SQ.MT
b	13.38	x	2.04	x	2 /3	=	18.20	SQ.MT
TOTAL						=	**25.17**	SQ.MT
TOTAL AREA OF PLOT (S-Y)						=	**126231.04**	SQ.MT

RENTAL RG AREA CALCULATION

RENTAL R.G. AREA STATEMENT


TOTAL R.G. REQUIRED		
28421.98 X 8.0%	=	2272.16
R.G. PROVIDED		
R.G. 1	=	1524.38
R.G. 2	=	321.60
R.G. 3	=	609.35
R.G. 4	=	88.70
R.G. 5	=	534.20
R.G. 6	=	732.50
R.G. 7	=	1496.26
R.G. 8	=	250.91
R.G. 9	=	487.04
R.G. 10	=	418.45
R.G. 11	=	426.07
R.G. 12	=	382.21
R.G. 13	=	105.95
R.G. 14	=	227.02
R.G. 15	=	310.21
TOTAL R.G. PROVIDED	=	**7916.64**



LINE AREA DIA. FOR RG.1 (RENTAL PLOT)
SCALE:1:500

R.G. 1 AREA CALCULATION


ADDITION								
1	25.32	x	3.64	x	0.50	=	46.08	SQ.MT
2	72.51	x	21.11	x	0.50	=	765.3	SQ.MT
3	72.51	x	16.55	x	0.50	=	672.5	SQ.MT
4	24.41	x	3.96	x	0.50	=	48.3	SQ.MT
TOTAL						=	**1532.29**	SQ.MT
DEDUCTION								
a	5.40	x	1.01	x	0.66	=	3.60	SQ.MT
b	6.31	x	0.70	x	0.66	=	4.31	SQ.MT
TOTAL						=	**7.91**	SQ.MT
TOTAL AREA						=	**1524.38**	SQ.MT

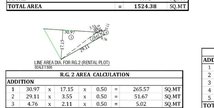

LINE AREA DIA. FOR RG.2 (RENTAL PLOT)
SCALE:1:500

R.G. 2 AREA CALCULATION


ADDITION								
1	30.97	x	17.15	x	0.50	=	265.57	SQ.MT
2	29.81	x	3.55	x	0.50	=	51.67	SQ.MT
3	4.76	x	2.11	x	0.50	=	5.02	SQ.MT
TOTAL						=	**322.26**	SQ.MT
DEDUCTION								
a	3.32	x	0.30	x	0.66	=	0.66	SQ.MT
TOTAL						=	**0.66**	SQ.MT
TOTAL AREA						=	**321.60**	SQ.MT

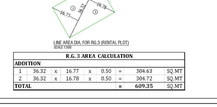

LINE AREA DIA. FOR RG.3 (RENTAL PLOT)
SCALE:1:500

R.G. 3 AREA CALCULATION

ADDITION								
1	38.82	x	16.77	x	0.50	=	304.63	SQ.MT
2	39.32	x	16.78	x	0.50	=	304.72	SQ.MT
TOTAL						=	**609.35**	SQ.MT

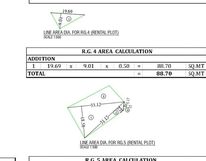

LINE AREA DIA. FOR RG.4 (RENTAL PLOT)
SCALE:1:500


R.G. 4 AREA CALCULATION

ADDITION								
1	19.69	x	9.01	x	0.50	=	88.70	SQ.MT
TOTAL						=	**88.70**	SQ.MT

LINE AREA DIA. FOR RG.5 (RENTAL PLOT)
SCALE:1:500

R.G. 5 AREA CALCULATION


ADDITION								
1	33.12	x	18.58	x	0.50	=	307.68	SQ.MT
2	31.15	x	3.35	x	0.50	=	52.18	SQ.MT
3	33.12	x	10.27	x	0.50	=	170.07	SQ.MT
4	5.17	x	1.25	x	0.66	=	4.27	SQ.MT
TOTAL						=	**534.20**	SQ.MT

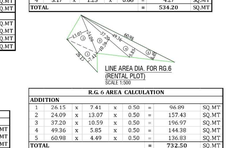

LINE AREA DIA. FOR RG.6
(RENTAL PLOT)
SCALE:1:500

R.G. 6 AREA CALCULATION


ADDITION								
1	24.15	x	7.41	x	0.50	=	44.99	SQ.MT
2	24.09	x	13.97	x	0.50	=	157.43	SQ.MT
3	37.20	x	10.59	x	0.50	=	196.97	SQ.MT
4	49.36	x	5.85	x	0.50	=	144.38	SQ.MT
5	60.98	x	4.49	x	0.50	=	136.83	SQ.MT
TOTAL						=	**732.50**	SQ.MT

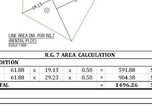

LINE AREA DIA. FOR RG.7
(RENTAL PLOT)
SCALE:1:500

R.G. 7 AREA CALCULATION


ADDITION								
1	61.88	x	19.13	x	0.50	=	591.88	SQ.MT
2	61.88	x	29.23	x	0.50	=	904.38	SQ.MT
TOTAL						=	**1496.26**	SQ.MT

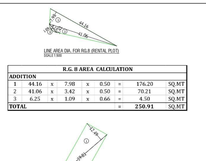

LINE AREA DIA. FOR RG.8 (RENTAL PLOT)
SCALE:1:500

R.G. 8 AREA CALCULATION


ADDITION								
1	44.16	x	7.98	x	0.50	=	176.20	SQ.MT
2	41.66	x	3.42	x	0.50	=	70.21	SQ.MT
3	6.25	x	1.09	x	0.66	=	4.50	SQ.MT
TOTAL						=	**250.91**	SQ.MT

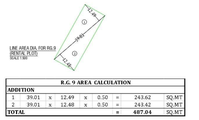

LINE AREA DIA. FOR RG.9
(RENTAL PLOT)
SCALE:1:500

R.G. 9 AREA CALCULATION


ADDITION								
1	29.01	x	12.49	x	0.50	=	243.62	SQ.MT
2	29.01	x	12.48	x	0.50	=	243.42	SQ.MT
TOTAL						=	**487.04**	SQ.MT

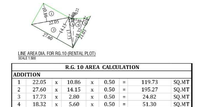

LINE AREA DIA. FOR RG.10 (RENTAL PLOT)
SCALE:1:500

R.G. 10 AREA CALCULATION


ADDITION								
1	22.05	x	10.86	x	0.50	=	119.73	SQ.MT
2	27.60	x	14.15	x	0.50	=	195.27	SQ.MT
3	17.73	x	2.88	x	0.50	=	24.82	SQ.MT
4	18.32	x	5.60	x	0.50	=	51.30	SQ.MT
5	21.03	x	2.64	x	0.50	=	27.76	SQ.MT
TOTAL						=	**418.88**	SQ.MT
DEDUCTION								
a	2.98	x	0.22	x	0.66	=	0.43	SQ.MT
TOTAL						=	**0.43**	SQ.MT
TOTAL AREA						=	**418.45**	SQ.MT

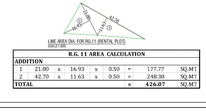

LINE AREA DIA. FOR RG.11 (RENTAL PLOT)
SCALE:1:500

R.G. 11 AREA CALCULATION


ADDITION								
1	21.00	x	16.93	x	0.50	=	177.77	SQ.MT
2	42.70	x	11.63	x	0.50	=	248.30	SQ.MT
TOTAL						=	**426.07**	SQ.MT

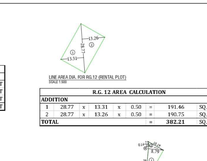

LINE AREA DIA. FOR RG.12 (RENTAL PLOT)
SCALE:1:500

R.G. 12 AREA CALCULATION


ADDITION								
1	28.77	x	13.31	x	0.50	=	191.46	SQ.MT
2	28.77	x	13.26	x	0.50	=	190.75	SQ.MT
TOTAL						=	**382.21**	SQ.MT

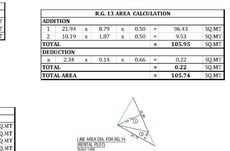

LINE AREA DIA. FOR RG.13 (RENTAL PLOT)
SCALE:1:500

R.G. 13 AREA CALCULATION

ADDITION								
1	21.94	x	8.79	x	0.50	=	96.43	SQ.MT
2	10.19	x	1.87	x	0.50	=	9.53	SQ.MT
TOTAL						=	**105.95**	SQ.MT
DEDUCTION								
a	2.36	x	0.14	x	0.66	=	0.22	SQ.MT
TOTAL						=	**0.22**	SQ.MT
TOTAL AREA						=	**105.74**	SQ.MT

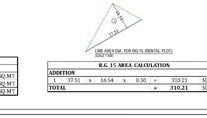

LINE AREA DIA. FOR RG.14
(RENTAL PLOT)
SCALE:1:500

R.G. 14 AREA CALCULATION

ADDITION								
1	21.89	x	14.74	x	0.50	=	161.33	SQ.MT
2	24.79	x	5.30	x	0.50	=	65.69	SQ.MT
TOTAL						=	**227.02**	SQ.MT

LINE AREA DIA. FOR RG.15 (RENTAL PLOT)
SCALE:1:500


R.G. 15 AREA CALCULATION

ADDITION								
1	72.51	x	16.54	x	0.50	=	310.21	SQ.MT
TOTAL						=	**310.21**	SQ.MT

SALE RG AREA CALCULATION

SALE R.G. AREA STATEMENT


TOTAL R.G. REQUIRED		
85205.92 X 8.0%	=	6816.47
R.G. PROVIDED		
R.G. 1	=	715.16
R.G. 2	=	1091.66
R.G. 3	=	575.11
R.G. 4	=	1861.19
R.G. 5	=	3128.02
TOTAL R.G. PROVIDED	=	7366.14

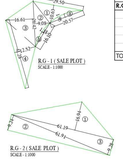

R.G. - 1 (SALE PLOT)
SCALE : 1:1000

R.G. 1 AREA CALCULATION (SALE)

ADDITION								
1	29.50	x	10.63	x	0.50	=	156.79	SQ.MT
2	26.42	x	9.08	x	0.50	=	119.9	SQ.MT
3	26.42	x	16.61	x	0.50	=	219.4	SQ.MT
4	41.28	x	12.52	x	0.50	=	258.4	SQ.MT
TOTAL						=	**754.57**	SQ.MT
DEDUCTION								
a	28.07	x	1.95	x	(2 / 3)	=	26.74	SQ.MT
b	16.10	x	1.18	x	(2 / 3)	=	12.67	SQ.MT
TOTAL						=	**39.41**	SQ.MT
TOTAL AREA						=	**715.16**	SQ.MT

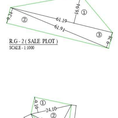

R.G. - 2 (SALE PLOT)
SCALE : 1:1000

R.G. 2 AREA CALCULATION (SALE)


ADDITION								
1	61.19	x	16.94	x	0.50	=	518.28	SQ.MT
2	61.91	x	9.24	x	0.50	=	286.11	SQ.MT
3	63.93	x	9.28	x	0.50	=	287.25	SQ.MT
TOTAL						=	**1091.66**	SQ.MT



R.G. - 3 (SALE PLOT)
SCALE : 1:1000

R.G. 3 AREA CALCULATION (SALE)

ADDITION								
1	24.10	x	9.16	x	0.50	=	110.38	SQ.MT
2	29.51	x	18.35	x	0.50	=	270.75	SQ.MT
3	33.14	x	10.39	x	0.50	=	172.16	SQ.MT
4	10.68	x	10.64	x	0.50	=	56.82	SQ.MT
5	12.04	x	0.37	x	0.50	=	2.23	SQ.MT
TOTAL						=	**612.34**	SQ.MT
DEDUCTION								
a	23.02	x	2.58	x	0.67	=	39.59	SQ.MT
b	10.68	x	0.37	x	0.67	=	2.63	SQ.MT
TOTAL						=	**42.23**	SQ.MT
TOTAL AREA						=	**570.11**	SQ.MT

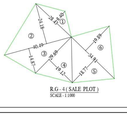

R.G. - 4 (SALE PLOT)
SCALE : 1:1000

R.G. 4 AREA CALCULATION (SALE)

ADDITION								
1	21.34	x	3.12	x	0.66	=	43.94	SQ.MT
2	57.55	x	18.77	x	0.50	=	540.11	SQ.MT
3	51.88	x	10.84	x	0.50	=	482.12	SQ.MT
4	90.56	x	21.63	x	0.50	=	979.41	SQ.MT
5	92.32	x	19.90	x	0.50	=	918.50	SQ.MT
6	92.32	x	3.55	x	0.50	=	163.87	SQ.MT
TOTAL						=	**3128.02**	SQ.MT

R.G. - 5 (SALE PLOT)
SCALE : 1:1000

R.G. 5 AREA CALCULATION (SALE)

ADDITION								
1	28.43	x	8.40	x	0.50	=	119.41	SQ.MT
2	40.49	x	24.18	x	0.50	=	489.52	SQ.MT
3	40.49	x	14.87	x	0.50	=	301.04	SQ.MT
4	29.69	x	19.12	x	0.50	=	283.84	SQ.MT
5	34.91	x	18.77	x	0.50	=	327.63	SQ.MT
6	34.91	x	19.89	x	0.50	=	347.11	SQ.MT
TOTAL						=	**1868.55**	SQ.MT

R.G. - 6 (SALE PLOT)
SCALE : 1:1000

R.G. - 7 (SALE PLOT)
SCALE : 1:1000

STAMP FOR APPROVAL | 02/25

PART OC

This Part Occupancy Certificate is issued for Sale Building no 1 (A ,B ,C) (Till 26th Floor) & Building no 2 (Till 30th Floor), and As Built drawing is approved subject to conditions as mentioned in Part Occupancy Certificate bearing no. NAINA/6529/2021-CIDCO/NAINA/PANVEL/Kolkhe/ BP- 00112/Part/ OC/ 2022/ 0217A. Dated 24.06.2022.

RAJA BHAGUJI WAGHMARE

Digitally signed by RAJA BHAGUJI WAGHMARE
Date: 2022.06.24 19:35:49 +05'30'

CONTENTS OF SHEET

PLOT AREA CALCULATION, AMENITY OPEN SPACE CALCULATION, R.G. AREA CALCULATION.

CERTIFICATE OF AREA

Certified that the plot under reference was surveyed by me on 20.08.2014 and the dimensions of side etc. of plot stated on plan are as measured on site and the area so worked out tallies with the area stated in document of ownership/T.P. Scheme Records/ Land Records Department /city survey record.

Signature of Owner

MANISH MADHU BATHIJA

Signature of Architect.

AR.DEVYANI KHADILKAR

M/s. PARADISE LIFESPACES LLP (P.O.A.H of Shri. Esmail Ebrahim Dhariwala & others)

FORM OF CERTIFICATE

I, Ar. Devyani khadilkar, for M/s Spaceage Consultants have been employed by the applicant as his Architect, I have examined the boundaries and the area of the plot and i do hereby certify that i have personally verified and checked all the statement made by applicant who is the owner/lessee in possession of the plot as in the above form and found them to be correct.

Signature of Owner

MANISH MADHU BATHIJA

Signature of Architect.

AR.DEVYANI KHADILKAR

M/s. PARADISE LIFESPACES LLP (P.O.A.H of Shri. Esmail Ebrahim Dhariwala & others)

CONTENTS OF SHEET

PLOT AREA CALCULATIO, RG AREA CALCULATION & AMENITY AREA CALCULATION

DESCRIPTION OF PROPOSAL & PROPERTY

PROPOSED DEVELOPMENT FOR RENTAL HOUSING SCHEME ON LAND BEARING S.NO.95/1(pt),95/2(pt),95/3A (pt),98/1,98/2,98/3,98/4A,98/4/B/1,98/4/B/2, 98/5(pt),98/7/1(pt),98/8/B/9,98/10A/1B,98/9P(pt),101/1,101/4/A,101/4/B, 101/4/C,101/5,101/6,101/7,101/8A,101/8B,101/9,101/10/A,101/10/B,102,103/1, 103/2(pt),103/3,103/4,110/1A(pt),110/4,110/5A,110/6A,110/10,110/11 at Village Kolkhe, Taluka - Panvel, District Raigad

NORTH	JOB. NO.	DRG. NO.	DRAWN BY
		02 / 25	
	SCALE	DATE	CHECKED BY
	1: 1000	-	-
REVISIONS	DESCRIPTION :		
R-0			

NAME OF THE OWNER

MANISH MADHU BATHIJA

M/s. PARADISE LIFESPACES LLP (P.O.A.H of Shri. Esmail Ebrahim Dhariwala & others)

NAME & ADDRESS OF THE DESIGN ARCHITECT:		
NAME OF ARCHITECT	M/s. DIMENSION ARCHITECTS	
LICENSE NO	CA/	
ADDRESS	PLOT NO.99, NEAR SAGAR VIHAR, SECTOR-08, VASHI, NAVI MUMBAI 400 703.	
NAME OF ARCHITECT	DEVYANI KHADILKAR	
LIC. NO	CA/90/13184	
ADDRESS	B-106, Natraj Building, Mulund Goregaon Link Road Mulund (w), Mumbai - 400 080	

GREY & BLACK WATER Tank Requirement

Building Number	Number of Tenement	Population	Water Requirement					Flow to Sewer			Total Flow to Septic Tank		Tank Provided	
			Flushing		Domestic		Total	Flushing -100%	Domestic -85%	Total	BLACK WATER	GREY WATER	Size	Capacity
			LPCD	LPD	LPCD	LPD	LPD	LPD	LPD	LPD	LPD	LPD		CUM
1	2	(3) = (2) X 5	4	(5) = (3) X (4)	6	(7) = (3) X (6)	(8) = (5) + (7)	(9) = (5) X 100%	(10) = (7) X 85%	(11) = (9) + (10)	(12) = (9)	(13)=10	14	15
BLDG.1	504	2520	45	113400	90	226800	340200	113400	192780	306180	113400	192780	256x1.3 Sq.mtr	332.82
BLDG.2	196	980	45	44100	90	88200	132300	44100	74970	119070	44100	74970	10.34x11.22x1.5	145

Note:
i. LPCD = 135Liter per capita per day.
ii. LPD = Liter per day.
iii. For Grey & Black water tank capacity Flushing & domestic flow to sewer will be 100% & 85% respectively.
iv. Size of STP tank is excluding freeboard.
v. Above STP tank capacity we have considered as per SEAC/2014/CR-187/TC-1 on dated 6th Feb. 2015

Water Storage Capacity Calculation

Building Number	Total Number of Units	Add\. Toilet	Populatio n	Water Requirement (In Liter)			Underground Water Tank provided		
				Add\. Toilet	Populatio n	Total	Tank Number	Size/ Dimensio n	Capacity (Liter)
1	2	3	(4) = (2) X 5	(5) = (3) X 180	(6) = (4) X 189	(7) = (5) + (6)	8	9	10
BUILDING 1									
WING A									
2BHK	96	100	480	18000	90720	108720	1		121621.5(Dom) 114120
3BHK	72	150	360	27000	68040	95040	1	23.10MX 4.95MX1.5M (Dom) 23.10x3.8 0x1.5 (Flushing)	(Flush)
WING B									
2BHK	96	100	480	18000	90720	108720	1		
3BHK	72	150	360	27000	68040	95040	1	120SQ M X1.5M (Dom) 12.94x6.5 0X1.5 (Flushing)	156000 (Dom) 109350 (Flush)
WING C									
2BHK	96	100	480	18000	90720	108720	1		
3BHK	72	150	360	27000	68040	95040	1	111.2SQ MX1.5M (Dom) 12.94x6.5 0x1.5 (Flushing)	144560 (Dom) 109350 (Flush)
Total	504	750	2520	135000	476280	611280	2		754880


PROVISION OF WATER STORAGE SHALL BE AS PER CONDITIONS MENTIONED IN O.C. LETTER.

BUILDING 2


BUILDING 2									
3BHK	112	232	560	41760	105840	147600			
4BHK	84	261	420	46980	79380	126360		1225Q M TRx1.66 (Dom) 10.34x11 22x1.66 (Flushing)	171885(Dom) 163500 (Flush)
Total	196	493	980	88740	185220	273960	1		335385

Commercial

BLDG NO.	No of Units	Population	Average daily Water Requirement		Total Domestic	Total Flushing	Underground Water Tank provided	
			15 liters Domestic (4)	30 liters flushing (5)	(6)= (3)x(4)	(7)= (3)x(5)	Size/ Dimension (8)	Capacity (Liter) 9
1	2	3						
SHOP	27	61	15	30	915	1830	2.0x2.0x1.5 (Dom) 3.80X2.68 x1.5 (Flush)	5200 (Dom) 13240 (Flush)
OFFICE	26	141	15	30	2115	4230		
TOTAL					3030	6060		18440

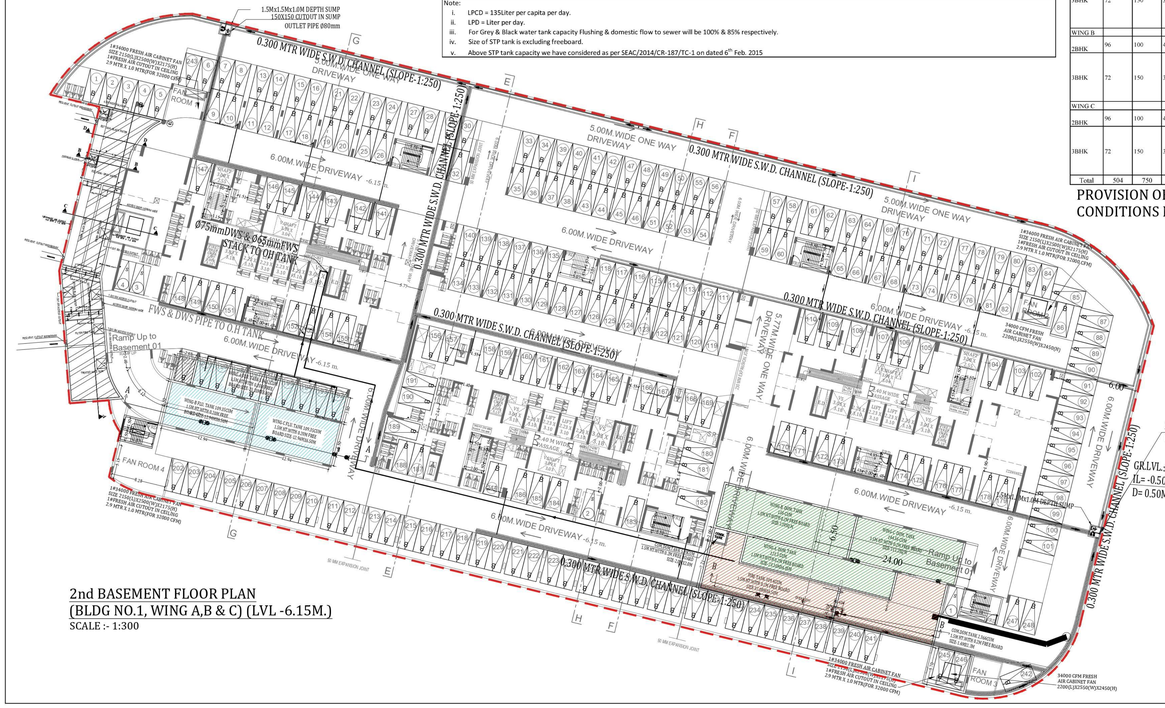


2nd BASEMENT FLOOR PLAN
(BLDG NO.1, WING A,B & C) (LVL -6.15M.)
SCALE :- 1:300

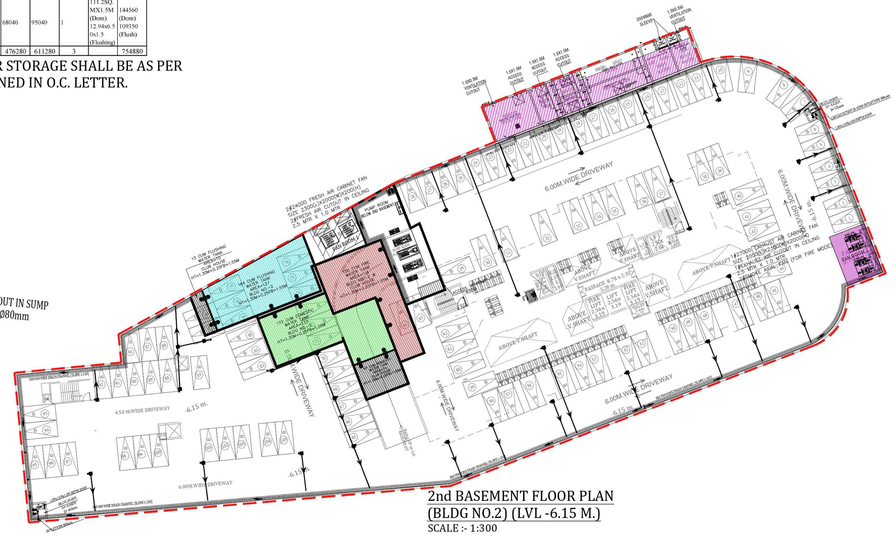
6.00M WIDE DRIVEWAY
6.15 m.
4.50 M WIDE DRIVEWAY
5.00M WIDE ONE WAY DRIVEWAY
FAN ROOM 1
FAN ROOM 2
FA



1st BASEMENT FLOOR PLAN
(BLDG NO.1, WING A,B & C) (LVL -2.55 M.)
SCALE :- 1:300

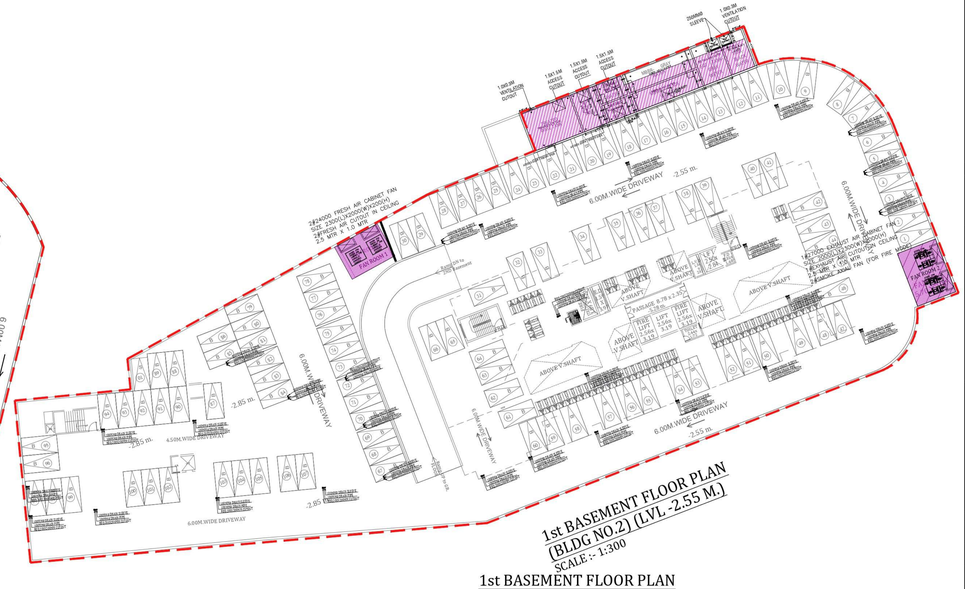

1st BASEMENT FLOOR PLAN
(BLDG NO.2) (LVL -2.55 M.)
SCALE :- 1:300

PROFORMA -B | 04 / 25

CONTENTS OF SHEET

1ST BASEMENT SERVICES PLAN (BLDG NO.1, WING A,B & C) (BLDG NO.2)

STAMP AND DATE OF APPROVAL OF PLAN

PART OC

This Part Occupancy Certificate is issued for Sale Building no 1 (A ,B ,C) (Till 26th Floor) & Building no 2 (Till 30th Floor), and As Built drawing is approved subject to conditions as mentioned in Part Occupancy Certificate bearing no. NAINA/6529/2021-CIDCO/NAINA/PANVEL/Kolkhe/BP- 00112/Part/ OC/ 2022/ 0217A. Dated 24.06.2022.

RAJA BHAGUJI WAGHMARE

Digitally signed by RAJA BHAGUJI WAGHMARE
Date: 2022.06.24 19:36:44 +05'30'

DESCRIPTION OF PROPOSAL & PROPERTY

PROPOSED DEVELOPMENT FOR RENTAL HOUSING SCHEME ON LAND BEARING S.NO.95/1(pt), 95/2(pt),95/3A(pt),98/1,98/2,98/3,98/4A,98/4/B/1,98/4/B/2,98/5(pt),98/7/3(pt),98/8,98/9, 98/10A,98/10B,99(pt),101/3,101/4/A,101/4/B,101/4/C,101/5,101/6,101/7,101/8A,101/8B,101/9, 101/10/A,101/10/B,102,103/1,103/2(pt),103/3,103/4,110/1A(pt),110/4,110/5A,110/6A,110/10, 110/11 at Village Kolkhe, Taluka - Panvel, District Raigad

NORTH	JOB. NO.	DRG. NO.	DRAWN BY
		04 / 25	-
	SCALE	DATE	CHECKED BY
	1: 300	-	-
REVISIONS	DESCRIPTION :		
R-0			
NAME OF THE OWNER			

MANISH MADHU BATHIJA

M/S. PARADISE LIFESPACES LLP.
(P.O.A.H. of Shri. Esmail Ebrahim Dhariwala & others)


MEP CONSULTANTS :-


ANIL VERMA & ASSOCIATES
1101Cyber One, Next to Odisha Bhawan
Opposite CIDCO Exhibition Center
Sector - 30 A, Vashi Navi Mumbai - 400703
PH : +91-2227810366 / 87 / 88

NAME & ADDRESS OF THE DESIGN ARCHITECT:

NAME OF ARCHITECT	M/s. DIMENSION ARCHITECTS
LICENSE NO	CA/ /
ADDRESS	PLOT NO.99, NEAR SAGAR VIHAR, SECTOR-08, VASHI, NAVI MUMBAI 400 703.

NAME OF ARCHITECT	DEVYANI KHADILKAR	
LIC. NO	CA/90/13184	
ADDRESS	B-106, Natraj Building, Mulund Goregaon Link Road Mulund (w), Mumbai : 400 080	

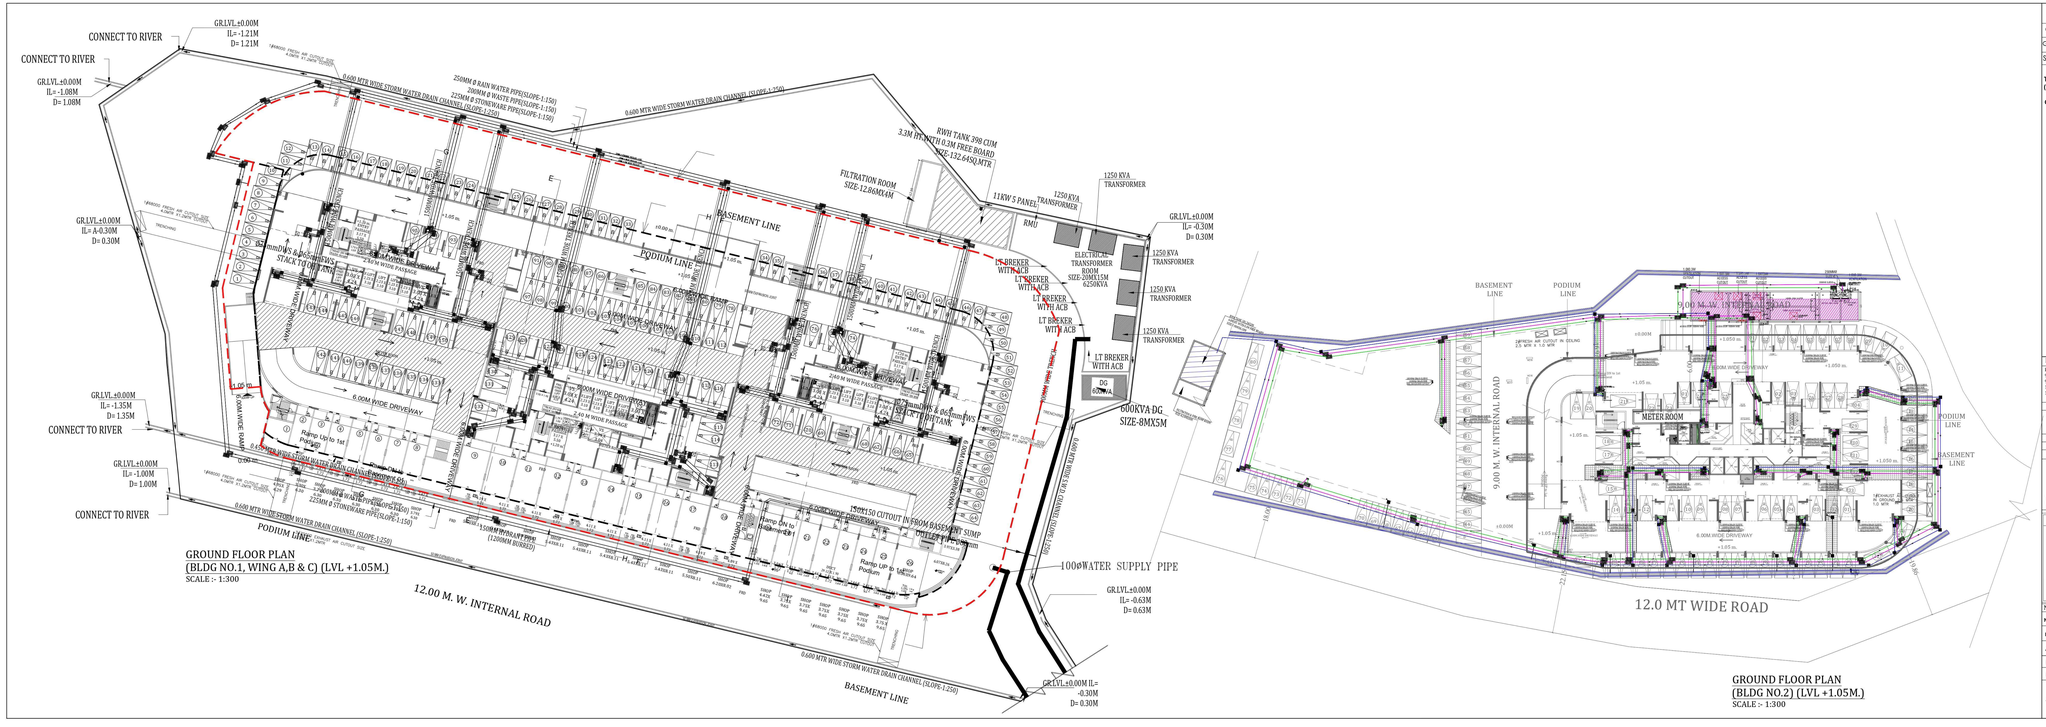
CONNECT TO RIVER
GR.LVL.+0.00M IL= -1.21M D= 1.21M
GR.LVL.+0.00M IL= -1.08M D= 1.08M
GR.LVL.+0.00M IL= A-0.30M D= 0.30M
GR.LVL.+0.00M IL= -1.35M D= 1.35M
GR.LVL.+0.00M IL= -1.00M D= 1.00M
0.600 MTR WIDE STORM WATER DRAIN CHANNEL (SLOPE-1:250)
250MM Ø RAIN WATER PIPE(SLOPE-1:150)
200MM Ø WASTE PIPE(SLOPE-1:150)
225MM Ø STONEWARE PIPE(SLOPE-1:150)
RWH TANK 398 CUM 3.3M HEIGHT+0.3M FREE BOARD SIZE-132.64SQ.MTR
FILTRATION ROOM SIZE-12.86MX4M
11KW 5 PANEL
RMU
1250 KVA TRANSFORMER
ELECTRICAL TRANSFORMER ROOM SIZE-20MX15M 625KVA
LT BREKER WITH ACB
BASEMENT LINE
PODIUM LINE
6.00M WIDE DRIVEWAY
7.50 M WIDE PASSAGE
Ramp Up to 1st Podium
Ramp Up to 1st Podium
Ramp Up to 1st Podium

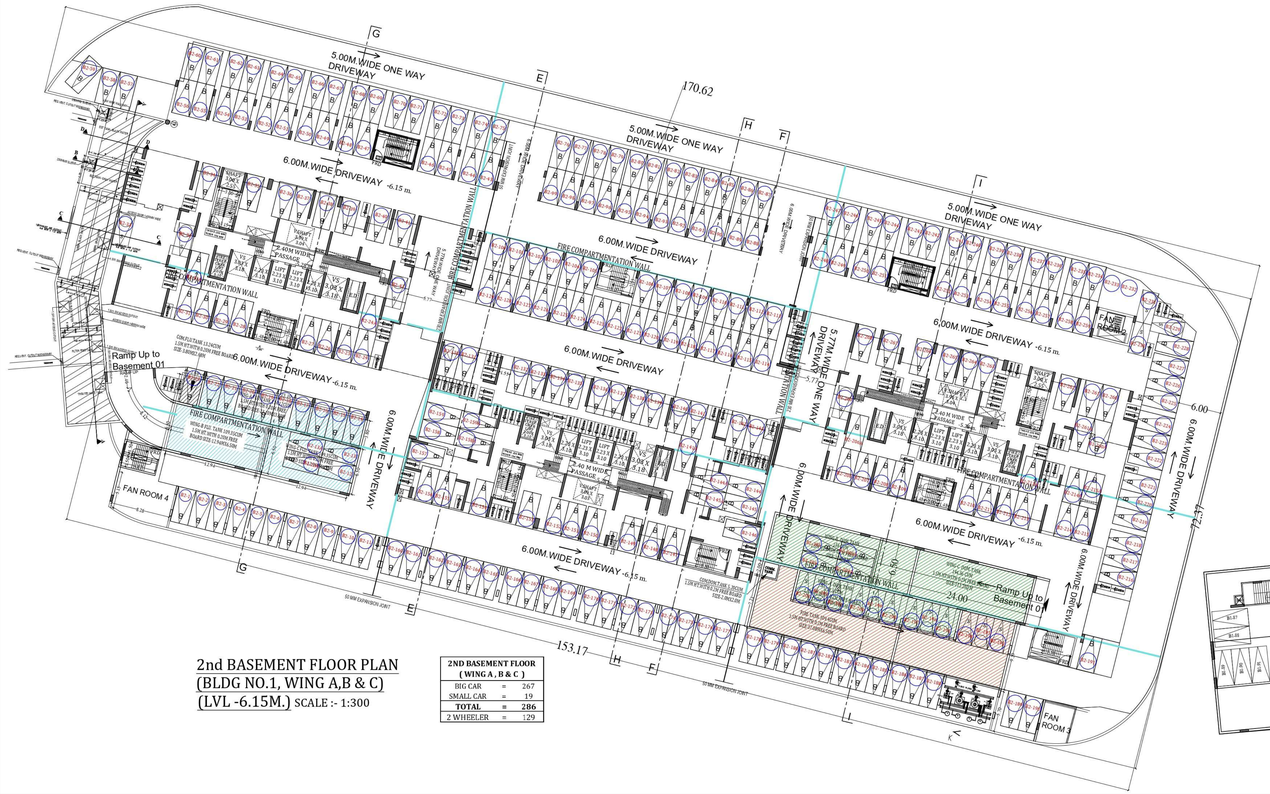

2nd BASEMENT FLOOR PLAN
(BLDG NO.1, WING A,B & C)
(LVL -6.15M.) SCALE :- 1:300


2ND BASEMENT FLOOR (WING A , B & C)		
BIG CAR	=	267
SMALL CAR	=	19
TOTAL	=	**286**

Legend

BIG CAR THUS SHOWN — 2.50 × 5.00

SMALL CAR THUS SHOWN — 2.30 × 4.50

2 WHEELER THUS SHOWN — 2.00

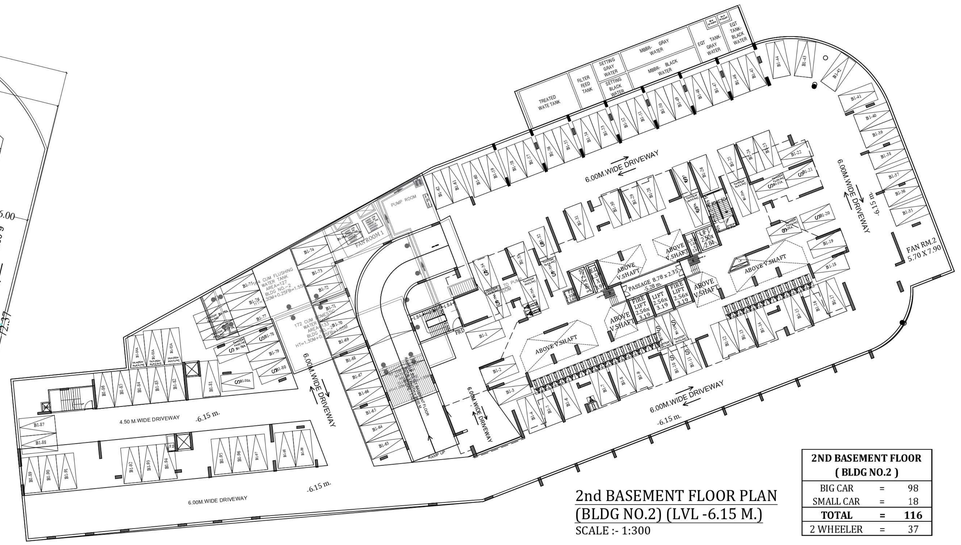

2nd BASEMENT FLOOR PLAN
(BLDG NO.2) (LVL -6.15 M.)
SCALE :- 1:300

2ND BASEMENT FLOOR (BLDG NO.2)		
BIG CAR	=	98
SMALL CAR	=	18
TOTAL	=	**116**
2 WHEELER	=	37

PROFORMA B	06/25

CONTENTS OF SHEET

2ND BASEMENT FLOOR PLAN (BLDG NO.1, WING A,B & C) (BLDG NO.2)


STAMP AND DATE OF APPROVAL OF PLAN

PART OC

This Part Occupancy Certificate is issued for Sale Building no 1 (A ,B ,C) (Till 26th Floor) & Building no 2 (Till 30th Floor), and As Built drawing is approved subject to conditions as mentioned in Part Occupancy Certificate bearing no. NAINA/6529/2021-CIDCO/NAINA/PANVEL/Kolkhe/ BP- 00112/Part/ OC/ 2022/ 0217A. Dated 24.06.2022.

RAJA BHAGUJI WAGHMARE

Digitally signed by RAJA BHAGUJI WAGHMARE
Date: 2022.06.24 19:37:44 +05'30'

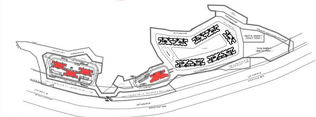

KEY PLAN

DESCRIPTION OF PROPOSAL & PROPERTY


PROPOSED DEVELOPMENT FOR RENTAL HOUSING SCHEME ON LAND BEARING S.NO 95/1(pt), 95/2(pt),95/5A(pt),98/1/86/2,98/3,98/4A,98/4/B/1,98/4/B/2,98/5(pt),98/7/3(pt),98/8/98/9, 98/10A,98/108,99(pt),101/3,101/4/A,101/4/B,101/4/C,101/5,101/6,101,77,101,8A,101,8B,101,9, 101/10/A,101/10/B,102,103/1,103/2(pt),103/3,103/4,110/4A(pt),110/4,110/5A,110/6A,110/10, 110/11 at Village Kolkhe, Taluka - Panvel, District Raigad

NORTH	JOB. NO.	DRG. NO.	DRAWN BY
		06 / 25	
	SCALE	DATE	CHECKED BY
	1: 300		
REVISIONS	DESCRIPTION :		
R-0			
NAME OF THE OWNER			

MANISH MADHU BATHIJA


M/S. PARADISE LIFESPACES LLP.
(P.O.A.H. of Shri. Esmail Ebrahim Dhariwala & others)


NAME OF ARCHITECT	M/s. DIMENSION ARCHITECTS	
LICENSE NO	CA/ /	
ADDRESS	**PLOT NO.99, NEAR SAGAR VIHAR, SECTOR-08, VASHI, NAVI MUMBAI 400 703**	
NAME OF ARCHITECT	DEVYANI KHADILKAR	
UC. NO	CA/90/13184	
ADDRESS	B-106, Natraj Building, Mulund Goregaon Link Road Mulund (w), Mumbai : 400 080	

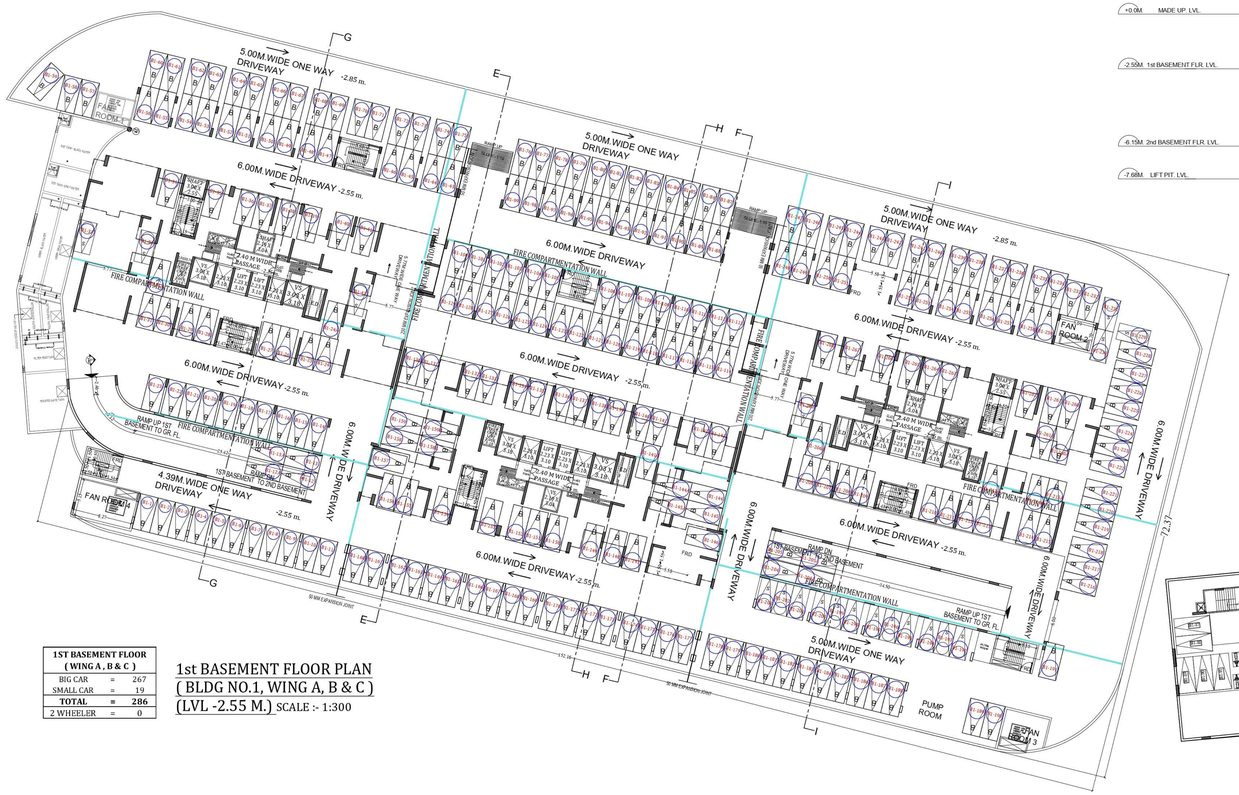

1ST BASEMENT FLOOR (WING A , B & C)		
BIG CAR	=	267
SMALL CAR	=	19
TOTAL	**=**	**286**
2 WHEELER	=	0

1st BASEMENT FLOOR PLAN
(BLDG NO.1, WING A, B & C)
(LVL -2.55 M.) SCALE :- 1:300

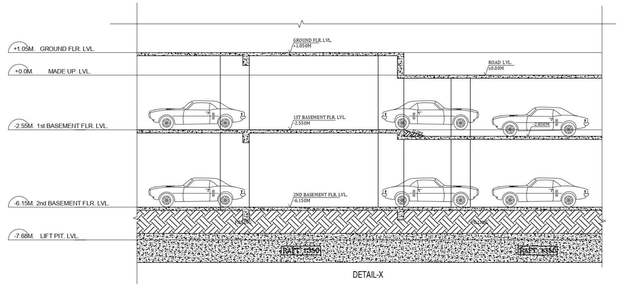

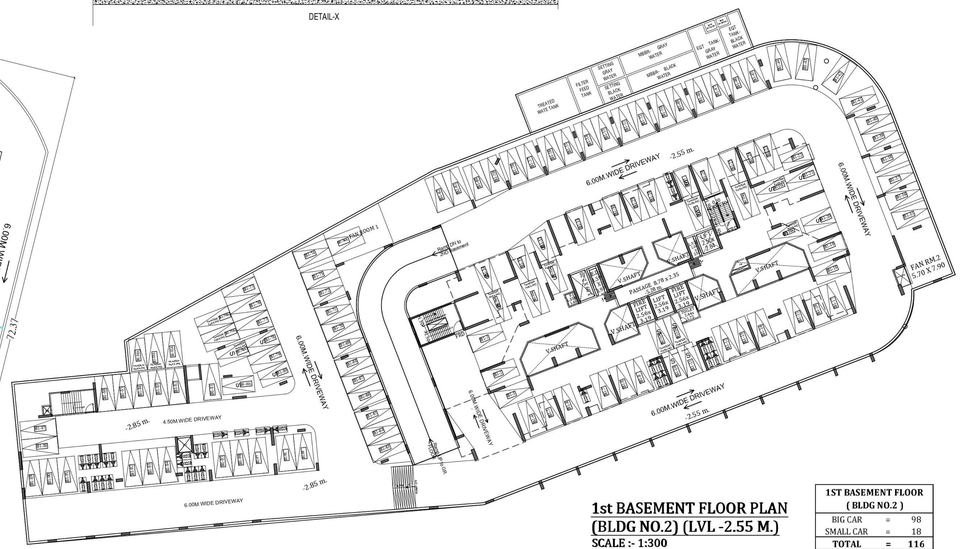

1st BASEMENT FLOOR PLAN
(BLDG NO.2) (LVL -2.55 M.)
SCALE :- 1:300

1ST BASEMENT FLOOR (BLDG NO.2)		
BIG CAR	=	98
SMALL CAR	=	18
TOTAL	**=**	**116**
2 WHEELER	=	31

Legend

BIG CAR THUS SHOWN — 2.50 × 5.00

SMALL CAR THUS SHOWN — 2.30 × 4.50

2 WHEELER THUS SHOWN — 0.75 × 2.00

PROFORMA B	07/25

CONTENTS OF SHEET

1ST BASEMENT FLOOR PLAN (BLDG NO.1, WING A,B & C) (BLDG NO.2)

STAMP AND DATE OF APPROVAL OF PLAN

PART OC

This Part Occupancy Certificate is issued for Sale Building no 1 (A ,B ,C) (Till 26th Floor) & Building no 2 (Till 30th Floor), and As Built drawing is approved subject to conditions as mentioned in Part Occupancy Certificate bearing no. NAINA/6529/2021-CIDCO/NAINA/PANVEL/Kolkhe/ BP- 00112/Part/ OC/ 2022/ 0217A. Dated 24.06.2022.

RAJA BHAGUJI WAGHMARE

Digitally signed by RAJA BHAGUJI WAGHMARE
Date: 2022.06.24 19:38:11 +05'30'



KEY PLAN

DESCRIPTION OF PROPOSAL & PROPERTY


PROPOSED DEVELOPMENT FOR RENTAL HOUSING SCHEME ON LAND BEARING S.NO.95/1(pt), 95/2(pt),95/3A(pt),98/1,98/2,98/3,98/4A,98/4/B/1,98/4/B/2,98/5(pt),98/7/3(pt),98/8,98/9, 98/10A,98/10R,99(pt),101/3,101/4/A,101/4/B,101/4/C,101/5,101/6,101/7,101/8A,101/8B,101/9, 101/10/A,101/10/B,102,103/1,103/2(pt),103/3,103/4,110/1A(pt),110/4,110/5A,110/6A,110/10, 110/11 at Village Kolkhe, Taluka - Panvel, District Raigad


NORTH	JOB. NO.	DRG. NO.	DRAWN BY
		07 / 25	
	SCALE	DATE	CHECKED BY
	1: 300		
REVISIONS	DESCRIPTION :		
R.0			
NAME OF THE OWNER			


MANISH MADHU BATHIJA


M/S. PARADISE LIFESPACES LLP.
(P.O.A.H. of Shri. Esmail Ebrahim Dhariwala & others)

NAME OF ARCHITECT	M/s. DIMENSION ARCHITECTS	
LICENSE NO	CA/ /	
ADDRESS	PLOT NO.99, NEAR SAGAR VIHAR, SECTOR-08, VASHI, NAVI MUMBAI 400 703	
NAME OF ARCHITECT	DEVYANI KHADILKAR	
LIC. NO	CA/90/13184	
ADDRESS	B-106, Natraj Building, Mulund Goregaon Link Road Mulund (w), Mumbai : 400 080	

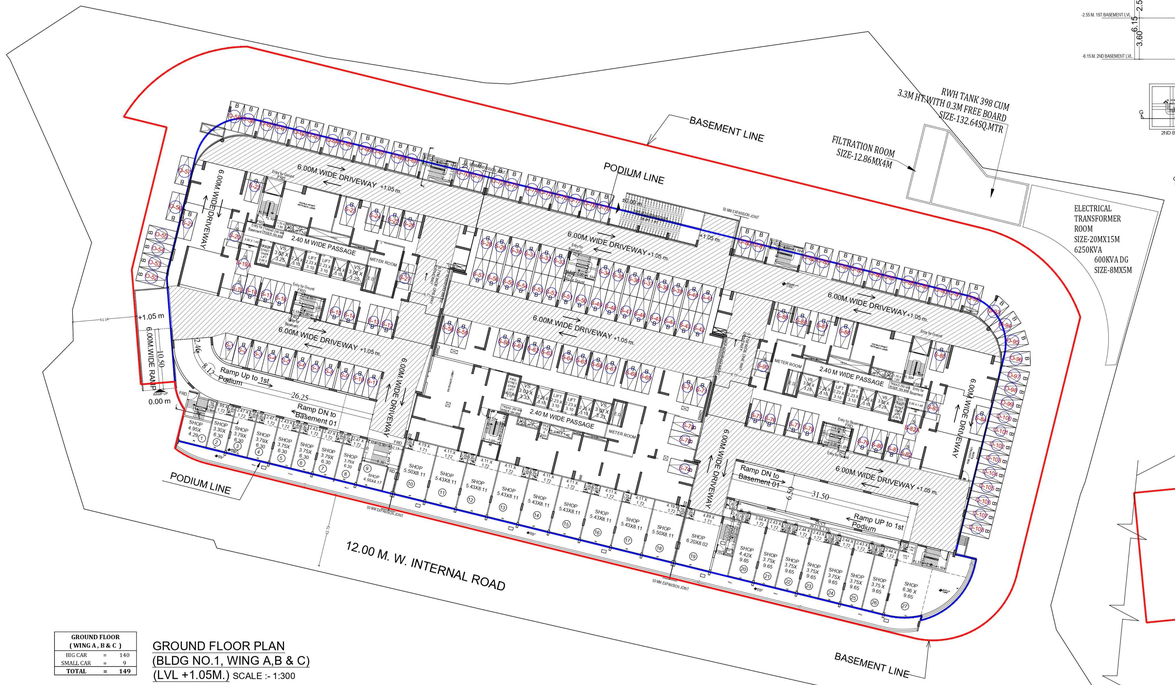

BASEMENT LINE
PODIUM LINE
RWH TANK 398 CUM
3.3M HT WITH 0.3M FREE BOARD
SIZE-132.64SQ.MTR
FILTRATION ROOM
SIZE-12.98MX4M
ELECTRICAL
TRANSFORMER
ROOM
SIZE-20MX15M
6250KVA
600KVA DG
SIZE-8MX5M
6.00M WIDE DRIVEWAY +1.05 m
2.40 M WIDE PASSAGE
Ramp Up to 1st Podium
Ramp DN to Basement 01
SHOP 4.40X 9.65
SHOP 3.30X 9.65
SHOP 3.70X 9.65
SHOP 4.43X8.11
SHOP 5.43X8.11
SHOP 5.30X8.11
SHOP 4.20X8.02
SHOP 3.70X 9.65
SHOP 4.40X 9.65

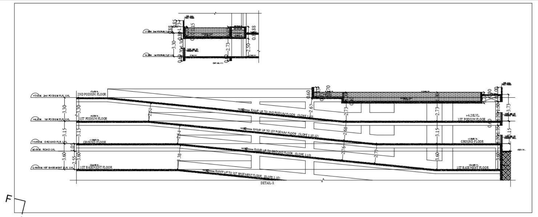


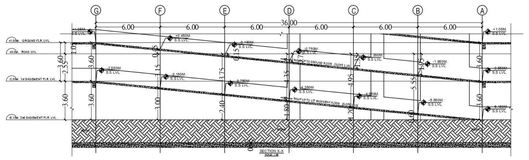

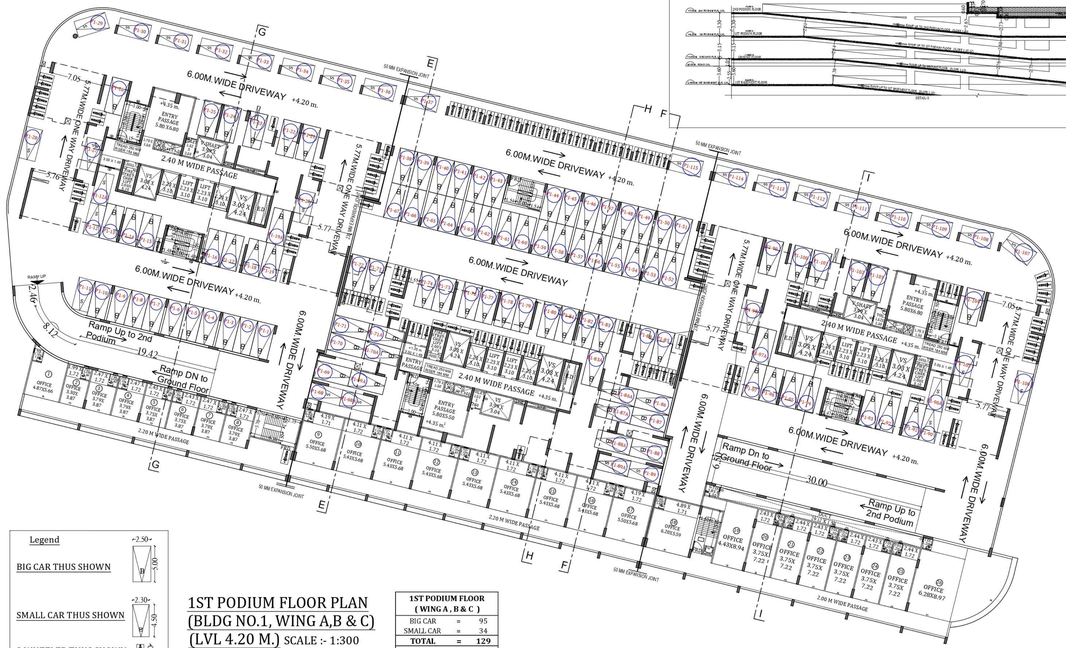
6.00M.WIDE DRIVEWAY +4.20 m.
2.40 M WIDE PASSAGE
Ramp Up to 2nd Podium
Ramp DN to Ground Floor
Ramp Dn to Ground Floor
Ramp Up to 2nd Podium
19.42
30.00
5 TYMWIDE ONE WAY DRIVEWAY
6.00M WIDE DRIVEWAY
7.05m WIDE ONE WAY DRIVEWAY
2.20 M WIDE PASSAGE
10 MM EXPANSION JOINT
ENTRY PASSAGE 1.80X5.55
ENTRY PASSAGE 3.80X5.55
ENTRY PASSAGE 1.80X5.55
OFFICE 3.75X7.22
OFFICE 3.70X7.22
OFFICE 3.75X7.22
OFFICE 6.28X8.97
OFFICE 3.70X5.54
OFFICE 3.70X5.58
OFFICE 3.70X5.68
OFFICE 3.70X5.68
OFFICE 3.70X5.68



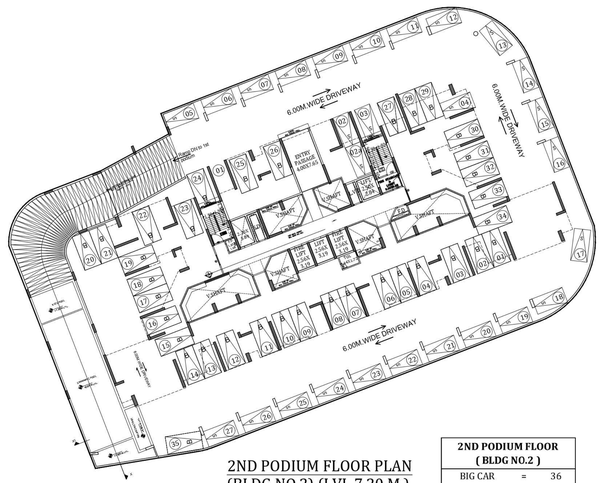

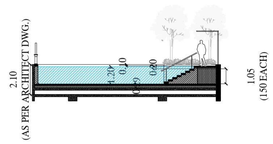

Legend

BIG CAR THUS SHOWN — 2.50 × 5.00

SMALL CAR THUS SHOWN — 2.30 × 5.00

2 WHEELER THUS SHOWN — 2.00 × 1.00

2ND PODIUM FLOOR PLAN
(BLDG NO.1, WING A,B & C)
(LVL 7.20 M.) SCALE :- 1:300

2ND PODIUM FLOOR (WING A , B & C)		
BIG CAR	=	49
SMALL CAR	=	17
TOTAL	**=**	**66**
2 WHEELER	=	0

2ND PODIUM FLOOR PLAN
(BLDG NO.2) (LVL 7.20 M.)
SCALE :- 1:300

2ND PODIUM FLOOR (BLDG NO.2)		
BIG CAR	=	36
SMALL CAR	=	27
TOTAL	**=**	**63**

PROFORMA B | 10/25

CONTENTS OF SHEET


2ND PODIUM FLOOR PLAN

STAMP AND DATE OF APPROVAL OF PLAN

PART OC
This Part Occupancy Certificate is issued for Sale Building no 1 (A ,B ,C) (Till 26th Floor) & Building no 2 (Till 30th Floor), and As Built drawing is approved subject to conditions as mentioned in Part Occupancy Certificate bearing no. NAINA/6529/2021-CIDCO/NAINA/PANVEL/Kolkhe/ BP- 00112/Part/ OC/ 2022/ 0217A. Dated 24.06.2022.

RAJA BHAGUJI WAGHMARE

Digitally signed by RAJA BHAGUJI WAGHMARE
Date: 2022.06.24 19:39:39 +05'30'

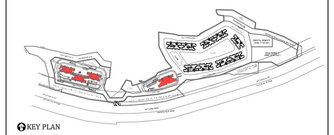

KEY PLAN

DESCRIPTION OF PROPOSAL & PROPERTY

PROPOSED DEVELOPMENT FOR RENTAL HOUSING SCHEME ON LAND BEARING S.NO.95/1(pt), 95/2(pt),95/3A(pt),98/1,98/2,98/3,98/4A,98/4/B/1,98/4/B/2,98/5(pt),98/7/3(pt),98/8,98/9, 98/10A,98/108,99(pt),101/3,101/4/A,101/4/B,101/4/C,101/5,101/6,101/7,101/8A,101/8B,101/9, 101/10/A,101/10/B,102,103/1,103/2(pt),103/3,103/4,110/1A(pt),110/4,110/5A,110/6A,110/10, 110/11 at Village Kolkhe, Taluka - Panvel, District Raigad


NORTH	JOB. NO.	DRG. NO.	DRAWN BY
		10 / 25	
	SCALE	DATE	CHECKED BY
	1: 300		
REVISIONS	DESCRIPTION :		
R-0			
NAME OF THE OWNER			

MANISH MADHU BATHUA


M/S. PARADISE LIFESPACES LLP.
(P.O.A.H. of Shri. Esmail Ebrahim Dhariwala & others)

NAME OF ARCHITECT	**M/s. DIMENSION ARCHITECTS**
LICENSE NO	**CA/ /**
ADDRESS	**PLOT NO.99, NEAR SAGAR VIHAR, SECTOR-08, VASHI, NAVI MUMBAI 400 703**

NAME OF ARCHITECT	DEVYANI KHADILKAR
LIC. NO	CA/90/13184
ADDRESS	B-106, Nataraj Building, Mulund Goregaon Link Road Mulund (w), Mumbai : 400 080

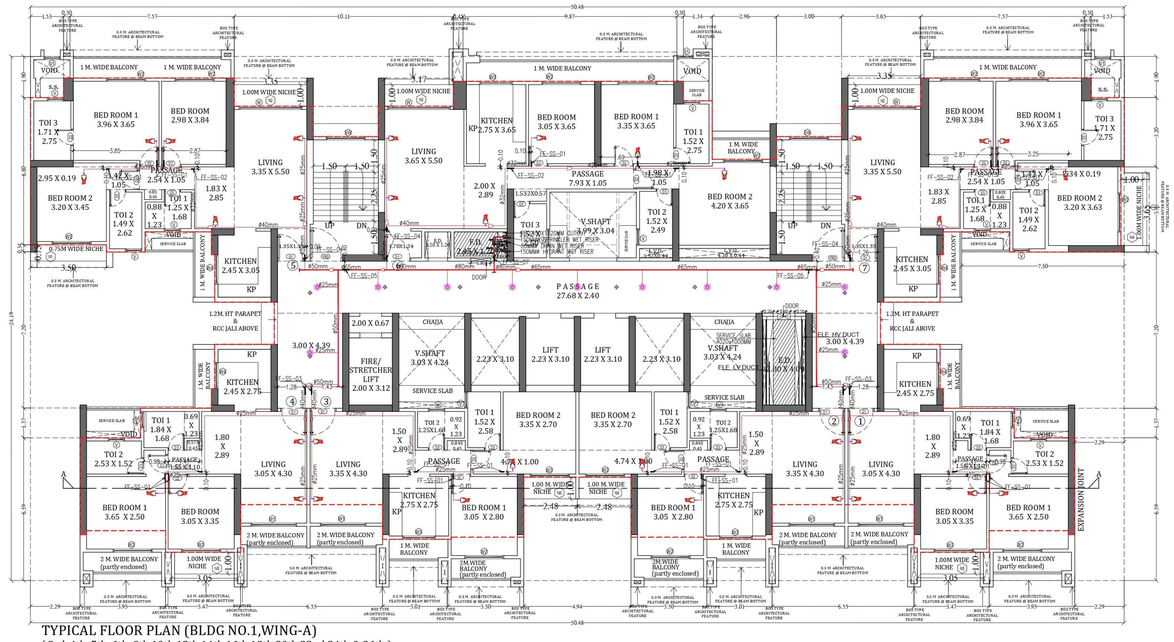

TYPICAL FLOOR PLAN (BLDG NO.1,WING-A)
(3rd, 4th, 5th, 6th, 8th,10th,12th,14th,16th,18th,20th,22nd,24th & 26th)
SCALE :- 1:100

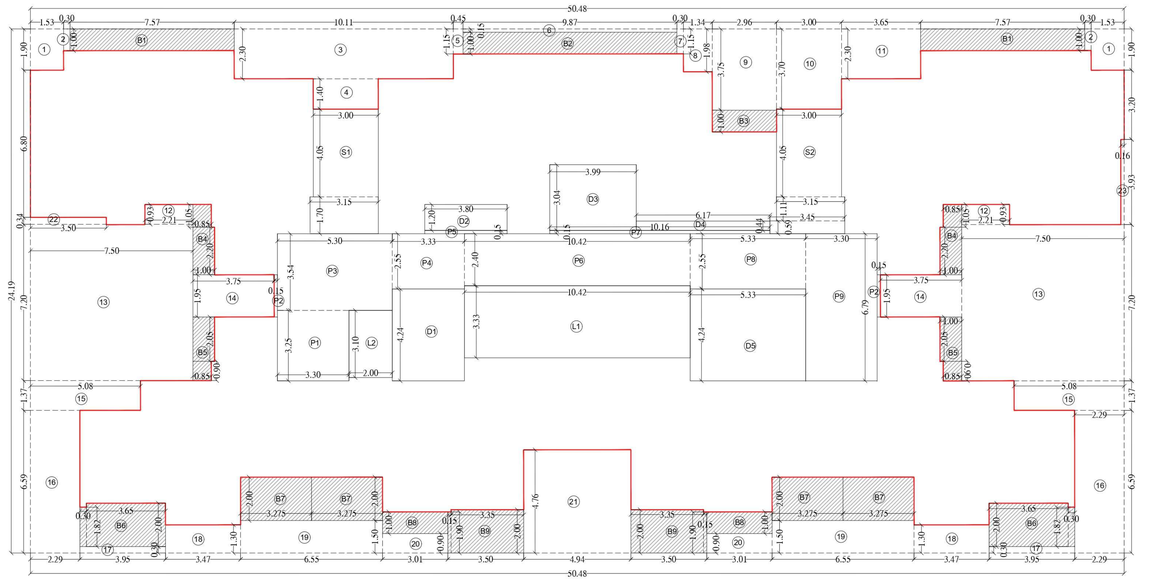

LINE DIAGRAM FOR TYPICAL FLOOR PLAN (BLDG NO.1,WING- A)
(3rd, 4th, 5th, 6th, 8th,10th,12th,14th,16th,18th,20th,22nd,24th & 26th) SCALE :- 1:100

BUILT UP AREA CALCULATION FOR TYPICAL FLOOR PLAN
(BLDG NO.1, WING A)
(3rd, 4th, 5th, 6th, 8th,10th,12th,14th,16th,18th,20th,22nd,24th & 26th)

ADDITION (X)								
A	50.48	x	24.19	x	1	=	1221.11	SQ.MT.
TOTAL						=	**1221.11**	**SQ.MT.**
STANDARD DEDUCTION (Y1)								
1	1.53	x	1.90	x	2	=	5.81	SQ.MT.
2	0.300	x	1.00	x	2	=	0.600	SQ.MT.
3	10.11	x	2.30	x	1	=	23.25	SQ.MT.
4	3.00	x	1.40	x	1	=	4.20	SQ.MT.
5	0.450	x	1.15	x	1	=	0.518	SQ.MT.
6	9.870	x	0.15	x	1	=	1.481	SQ.MT.
7	0.300	x	1.15	x	1	=	0.345	SQ.MT.
8	1.34	x	1.98	x	1	=	2.65	SQ.MT.
9	2.96	x	3.75	x	1	=	11.10	SQ.MT.
10	3.00	x	3.70	x	1	=	11.10	SQ.MT.
11	3.65	x	2.30	x	1	=	8.40	SQ.MT.
12	2.21	x	0.93	x	2	=	4.11	SQ.MT.
13	7.50	x	7.20	x	2	=	108.00	SQ.MT.
14	3.75	x	1.95	x	2	=	14.63	SQ.MT.
15	5.08	x	1.37	x	2	=	13.92	SQ.MT.
16	2.29	x	6.59	x	2	=	30.18	SQ.MT.
17	3.95	x	0.30	x	2	=	2.370	SQ.MT.
18	3.47	x	1.30	x	2	=	9.02	SQ.MT.
19	6.550	x	1.50	x	2	=	19.650	SQ.MT.
20	3.01	x	0.90	x	2	=	5.42	SQ.MT.
21	4.940	x	4.76	x	1	=	23.514	SQ.MT.
22	3.50	x	0.34	x	1	=	1.190	SQ.MT.
23	0.16	x	3.93	x	1	=	0.629	SQ.MT.
B1	7.570	x	1.00	x	2	=	15.140	SQ.MT.
B2	9.870	x	1.00	x	1	=	9.870	SQ.MT.
B3	2.96	x	1.00	x	1	=	2.96	SQ.MT.
B4	0.85	x	1.05	x	2	=	1.79	SQ.MT.
"	1.00	x	2.20	x	2	=	4.40	SQ.MT.
B5	1.00	x	2.05	x	2	=	4.10	SQ.MT.
"	0.85	x	0.90	x	2	=	1.53	SQ.MT.
B6 (Encl)	3.65	x	2.00	x	2	=	14.60	SQ.MT.
"	0.30	x	1.82	x	2	=	1.09	SQ.MT.
B7 (Encl)	3.275	x	2.00	x	4	=	26.18	SQ.MT.
B8	3.01	x	1.00	x	2	=	6.02	SQ.MT.
B9 (Encl)	3.35	x	2.00	x	2	=	13.40	SQ.MT.
"	0.15	x	1.90	x	2	=	0.57	SQ.MT.
TOTAL						=	**403.73**	**SQ.MT.**
DUCT DEDUCTION (Y2)								
D1	3.33	x	4.24	x	1	=	14.12	SQ.MT.
D2	3.80	x	1.20	x	1	=	4.56	SQ.MT.
D3	3.99	x	3.04	x	1	=	12.13	SQ.MT.
D4	6.17	x	0.44	x	1	=	2.71	SQ.MT.
D5	5.33	x	4.24	x	1	=	22.60	SQ.MT.
TOTAL						=	**56.12**	**SQ.MT.**
STAIRCASE,LIFT,LIFT LOBBY DEDUCTION (Y3)								
S1	3.00	x	4.05	x	1	=	12.150	SQ.MT.
"	3.15	x	1.70	x	1	=	5.355	SQ.MT.
S2	3.00	x	4.05	x	1	=	12.15	SQ.MT.
"	3.15	x	1.11	x	1	=	3.497	SQ.MT.
"	3.45	x	0.59	x	1	=	2.036	SQ.MT.
L1	10.42	x	3.33	x	1	=	34.70	SQ.MT.
L2	2.00	x	3.10	x	1	=	6.20	SQ.MT.
TOTAL						=	**76.09**	**SQ.MT.**
PASSAGE DEDUCTION (Y4)								
P1	3.30	x	3.25	x	1	=	10.725	SQ.MT.
P2	0.15	x	1.95	x	2	=	0.585	SQ.MT.
P3	5.30	x	3.54	x	1	=	18.76	SQ.MT.
P4	3.33	x	2.55	x	1	=	8.49	SQ.MT.
P5	3.80	x	0.15	x	1	=	0.57	SQ.MT.
P6	10.42	x	2.40	x	1	=	25.01	SQ.MT.
P7	10.16	x	0.15	x	1	=	1.52	SQ.MT.
P8	5.33	x	2.55	x	1	=	13.59	SQ.MT.
P9	3.30	x	6.79	x	1	=	22.41	SQ.MT.
TOTAL						=	**101.66**	**SQ.MT.**
TOTAL DEDUCTION (Y5) (Y1+Y2+Y3+Y4)						=	**637.60**	SQ.MT.
TOTAL BUILT UP AREA (X-Y5)						=	**583.51**	SQ.MT.
PERM. BALCONY (Y7) (Y6 x 10%)						=	**58.35**	**SQ.MT.**
BALCONY AREA STATEMENT								
B1	7.570	x	1.00	x	2	=	15.140	SQ.MT.
B2	9.870	x	1.00	x	1	=	9.870	SQ.MT.
B3	2.96	x	1.00	x	1	=	2.96	SQ.MT.
B4	0.85	x	1.05	x	2	=	1.79	SQ.MT.
"	1.00	x	2.20	x	2	=	4.40	SQ.MT.
B5	1.00	x	2.05	x	2	=	4.10	SQ.MT.
"	0.85	x	0.90	x	2	=	1.53	SQ.MT.
B6 (Encl)	3.65	x	2.00	x	2	=	14.60	SQ.MT.
"	0.30	x	1.82	x	2	=	1.09	SQ.MT.
B7 (Encl)	3.275	x	2.00	x	4	=	26.18	SQ.MT.
B8	3.01	x	1.00	x	2	=	6.020	SQ.MT.
B9 (Encl)	3.35	x	2.00	x	2	=	13.40	SQ.MT.
"	0.15	x	1.90	x	2	=	0.57	SQ.MT.
TOTAL (Y8)						=	**101.65**	**SQ.MT.**
EXCESS BALCONY (Y9) (Y8-Y7)						=	**43.30**	**SQ.MT.**
NET BUILT UP AREA (Y6+Y9)						=	**626.81**	**SQ.MT.**

NICHE AREA STATEMENT FOR BLDG 1
(WING A) (FOR TYPICAL FLOORS)

N1	3.50	x	0.75	x	1	=	2.63 SQ.MT.
N2	3.35	x	1.00	x	2	=	6.70 SQ.MT.
N3	3.17	x	1.00	x	1	=	3.17 SQ.MT.
N4	3.65	x	1.00	x	1	=	3.65 SQ.MT.
N5	3.05	x	1.00	x	2	=	6.10 SQ.MT.
N6	2.48	x	1.00	x	2	=	4.96 SQ.MT.
TOTAL AREA						=	**27.21 SQ.MT.**

CARPET AREA STATEMENT FOR TYPICAL FLOOR
(BLDG NO.1,WING A)

FLAT NO. 1	=	55.90 SQ.MT.
FLAT NO. 2	=	60.07 SQ.MT.
FLAT NO. 3	=	60.07 SQ.MT.
FLAT NO. 4	=	55.90 SQ.MT.
FLAT NO. 5	=	87.59 SQ.MT.
FLAT NO.6	=	98.95 SQ.MT.
FLAT NO.7	=	88.06 SQ.MT.

LIGHT AND VENTILATION STATEMENT (BLDG 1,WING A, FLAT NO 1 & 4)

ROOM	AREA OF ROOM (SQM)	AREA OF WIN REQ. (SQM)	AREA OF WIN	TYPE OF WINDOW
LIVING	18.320	3.053	4.520	W1
BED ROOM	10.220	1.703	3.060	W2A
BED ROOM 1	9.130	1.522	3.870	W2
KITCHEN	9.740	1.123	3.230	W3
TOILET 1	3.940	0.657	0.710	V
TOILET 2	3.850	0.642	0.710	V

LIGHT AND VENTILATION STATEMENT (BLDG 1,WING A, FLAT NO 2 & 3)

ROOM	AREA OF ROOM (SQM)	AREA OF WIN REQ. (SQM)	AREA OF WIN	TYPE OF WINDOW
LIVING	18.740	3.123	4.520	W1
BED ROOM 1	8.540	1.423	3.060	W2A
BED ROOM 2	13.780	2.297	3.870	W2
KITCHEN	7.560	1.260	3.230	W3
TOILET 1	3.920	0.653	0.710	V
TOILET 2	3.230	0.538	0.710	V2

LIGHT AND VENTILATION STATEMENT (BLDG 1,WING A, FLAT NO 5 & 7)

ROOM	AREA OF ROOM (SQM)	AREA OF WIN REQ. (SQM)	AREA OF WIN	TYPE OF WINDOW
LIVING	25.460	4.243	4.900	W1A
BED ROOM	11.440	1.907	3.870	W2
BED ROOM 1	14.450	2.408	3.870	W2
BED ROOM 2	13.090	2.182	3.060	W2A
KITCHEN	7.470	1.245	3.230	W3
TOILET 1	3.180	0.530	0.710	V
TOILET 2	3.900	0.650	0.710	V
TOILET 3	4.700	0.783	0.810	V1

LIGHT AND VENTILATION STATEMENT (BLDG 1,WING A , FLAT NO 6)

ROOM	AREA OF ROOM (SQM)	AREA OF WIN REQ. (SQM)	AREA OF WIN	TYPE OF WINDOW
LIVING	27.960	4.660	4.900	W1A
BED ROOM	11.130	1.855	3.870	W2
BED ROOM 1	12.230	2.038	3.870	W2
BED ROOM 2	17.410	2.902	3.870	W2
KITCHEN	10.040	1.673	3.230	W3
TOILET 1	4.180	0.697	0.710	V
TOILET 2	3.780	0.630	0.710	V
TOILET 3	3.800	0.633	0.710	V

(BLDG NO.1,WING A) | 11 / 25

CONTENTS OF SHEET

TYPICAL FLOOR PLAN & CALCULATION

STAMP AND DATE OF APPROVAL OF PLAN

PART OC
This Part Occupancy Certificate is issued for Sale Building no 1 (A ,B ,C) (Till 26th Floor) & Building no 2 (Till 30th Floor), and As Built drawing is approved subject to conditions as mentioned in Part Occupancy Certificate bearing no. NAINA/6529/2021-CIDCO/NAINA/PANVEL/Kolkhe/BP- 00112/Part/ OC/ 2022/ 0217A. Dated 24.06.2022.

RAJA BHAGUJI WAGHMARE
Digitally signed by RAJA BHAGUJI WAGHMARE
Date: 2022.06.24 19:40:07 +05'30'


DOOR SCHEDULE

BI NO	D NO	SIZE	LINTEL LVL	DESCRIPTION	REMARK
1.	FRD	1.5 X 2.30	2.30	FIRE RESISTANT DOOR	STAIRCASE
2.	D-1	1.2 X 2.30	2.30	T.W FRAME WITH W.P FLUSH DOOR	MAIN DOOR
3.	D-2	0.9 X 2.30	2.30	T.W FRAME WITH W.P FLUSH DOOR	BED ROOM
4.	D-3	0.75 X 2.30	2.30	MARBLE/GRANITE FRAME WITH FRP DOOR	TOILET

WINDOW SCHEDULE

BI NO	W NO.	SIZE	SILL LVL	LINTEL LVL	AREA (IN SQ.MT.)	DESCRIPTION	REMARK
1	SW-1	2.0 X 2.15	0.15	2.30	4.30	RAILING (FIXED GLASS WINDOW	STAIRCASE
2	W-1	2.1 X 2.15	0.15	2.30	4.52	ALUMINUM SLIDING WINDOW	LIVING ROOM
3	W-1A	2.9 X 1.70	0.60	2.30	4.93	ALUMINUM SLIDING WINDOW	LIVING ROOM
4	W-2	1.8 X 2.15	0.15	2.30	3.87	ALUMINUM SLIDING WINDOW	BED ROOM
5	W-2A	1.8 X 1.70	0.60	2.30	3.06	ALUMINUM SLIDING WINDOW	BED ROOM
6	W-3	1.5 X 2.15	0.15	2.30	3.23	ALUMINUM SLIDING WINDOW	KITCHEN
7	V	0.85 X 1.76	0.54	2.30	1.50	LOUVERS VENTILATOR	TOILETS & DUCT
8	V1	0.75 X 0.95	1.35	2.30	0.81	LOUVERS VENTILATOR	TOILETS & DUCT
9	V2	0.75 X 0.95	1.35	2.30	0.62	LOUVERS VENTILATOR	DUCT

NOTE :-
1) HABITABLE ROOM INCLUDES BEDROOM & LIVING ROOM
2) REFUGE AREAS ARE PROVIDED AT MIDLANDING OF EVERY ALTERNATE FLOOR
3) ALL DIMENSIONS ARE IN METERS

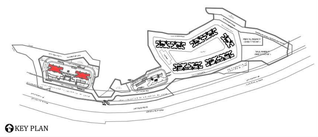

KEY PLAN

DESCRIPTION OF PROPOSAL & PROPERTY


PROPOSED DEVELOPMENT FOR RENTAL HOUSING SCHEME ON LAND BEARING S.NO.95/1(pt), 95/2(pt),95/3A(pt),98/1,98/2,98/3,98/4A,98/4B/1,98/4/B/2,98/5(pt),98/7/3(pt),98/8,98/9, 98/10A,98/10B,99(pt),101/3,101/4/A,101/4/B,101/4/C,101/5,101/6,101/7,101/8A,101/8B,101/9, 101/10/A,101/10/B,102,103/1,103/2(pt),103/3,103/4,110/1A(pt),110/4,110/5A,110/6A,110/10, 110/11 at Village Kolkhe, Taluka - Panvel, District Raigad

NORTH	JOB. NO.	DRG. NO.	DRAWN BY
		11 / 25	
	SCALE	DATE	CHECKED BY
	1: 100		
REVISIONS	DESCRIPTION :		
R-0			


NAME OF THE OWNER

M/S. PARADISE LIFESPACES LLP.
(P.O.A.H. of Shri. Esmail Ebrahim Dhariwala & others)

MANISH MADHU BATHIJA
Digitally signed by MANISH MADHU BATHIJA
DN: c=IN, o=Personal, title=6529, pseudonym=8A4D4A4D4A4D4

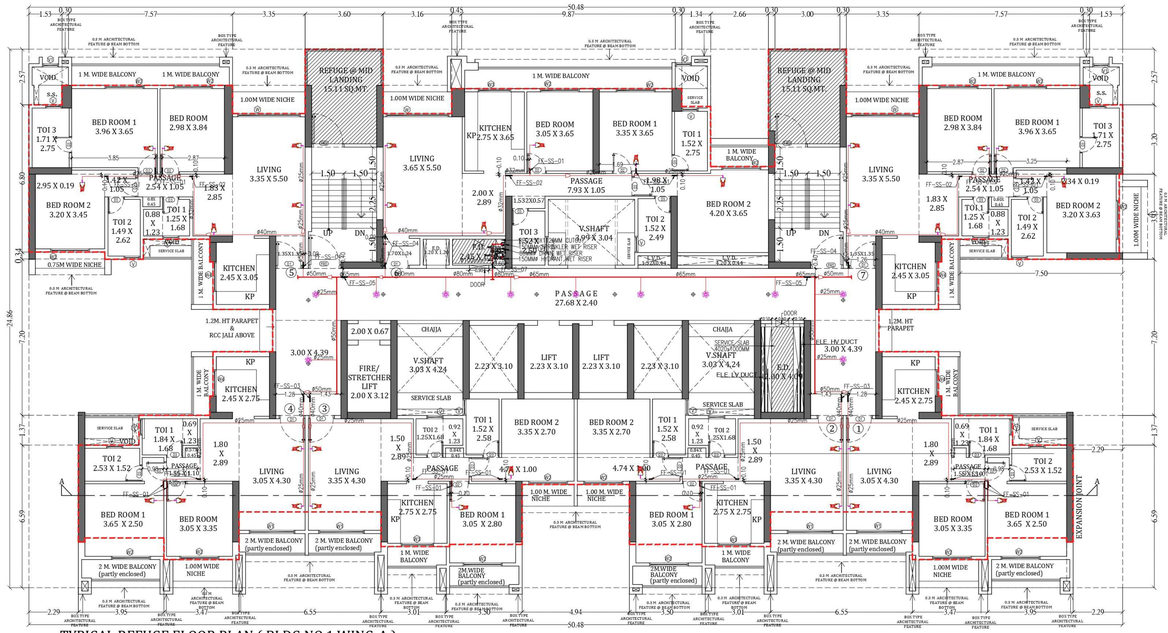

TYPICAL REFUGE FLOOR PLAN (BLDG NO.1,WING-A)
(7th, 9th,11th,13th,15th,17th,19th,21st,23rd & 25th)
SCALE :- 1:100

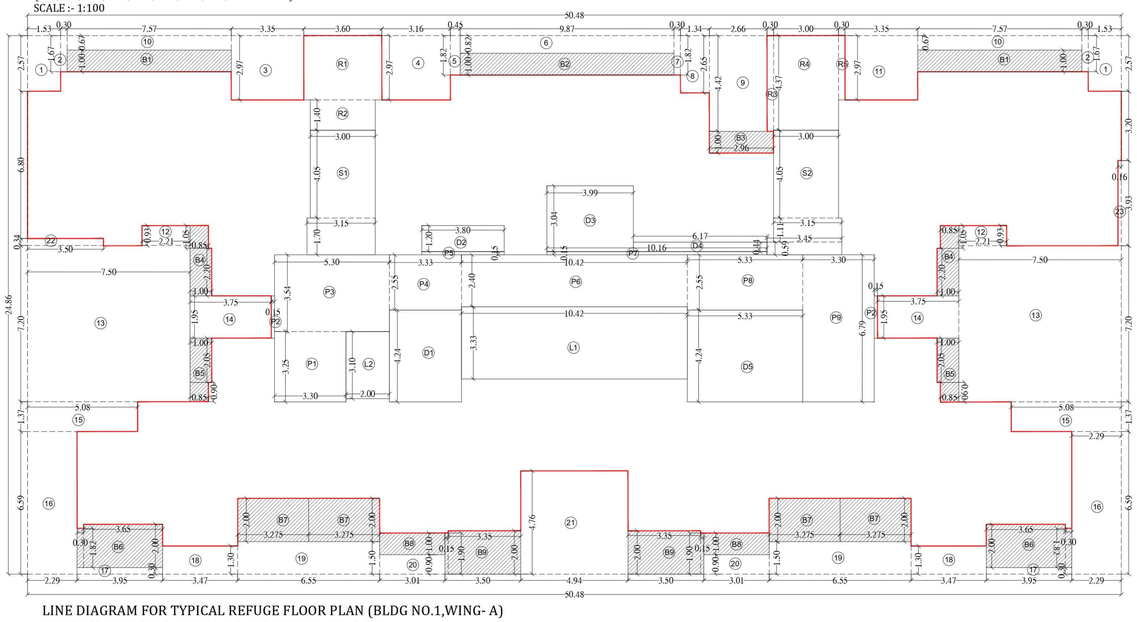

LINE DIAGRAM FOR TYPICAL REFUGE FLOOR PLAN (BLDG NO.1,WING- A)
(7th, 9th,11th,13th,15th,17th,19th,21st,23rd & 25th) SCALE :- 1:100

BUILT UP AREA CALCULATION FOR TYPICAL FLOOR PLAN (BLDG NO.1, WING A)
(7TH, 9th, 11th, 13th, 15th, 17th, 19th, 21st, 23rd & 25th)

ADDITION (X)								
A	50.48	x	24.86	x	1	=	1254.93	SQ.MT.
TOTAL						=	**1254.93**	**SQ.MT.**
STANDARD DEDUCTION (Y1)								
1	1.53	x	2.57	x	2	=	7.860	SQ.MT.
2	0.300	x	1.67	x	2	=	1.002	SQ.MT.
3	3.35	x	2.97	x	1	=	9.950	SQ.MT.
4	3.16	x	2.97	x	1	=	9.382	SQ.MT.
5	0.450	x	1.82	x	1	=	0.819	SQ.MT.
6	9.870	x	0.82	x	1	=	8.093	SQ.MT.
7	0.300	x	1.82	x	1	=	0.546	SQ.MT.
8	1.34	x	2.65	x	1	=	3.55	SQ.MT.
9	2.66	x	4.42	x	1	=	11.76	SQ.MT.
10	7.57	x	0.67	x	2	=	10.14	SQ.MT.
11	3.35	x	2.97	x	1	=	9.95	SQ.MT.
12	2.21	x	0.93	x	2	=	4.11	SQ.MT.
13	7.50	x	7.20	x	2	=	108.00	SQ.MT.
14	3.75	x	1.95	x	2	=	14.63	SQ.MT.
15	5.08	x	1.37	x	2	=	13.92	SQ.MT.
16	2.29	x	6.59	x	2	=	30.18	SQ.MT.
17	3.95	x	0.300	x	2	=	2.370	SQ.MT.
18	3.47	x	1.30	x	2	=	9.02	SQ.MT.
19	6.550	x	1.50	x	2	=	19.650	SQ.MT.
20	3.01	x	0.90	x	2	=	5.42	SQ.MT.
21	4.940	x	4.76	x	1	=	23.514	SQ.MT.
22	3.50	x	0.340	x	1	=	1.190	SQ.MT.
23	0.16	x	3.930	x	1	=	0.629	SQ.MT.
B1	7.570	x	1.00	x	2	=	15.140	SQ.MT.
B2	9.870	x	1.00	x	1	=	9.870	SQ.MT.
B3	2.96	x	1.00	x	1	=	2.96	SQ.MT.
B4	0.85	x	1.05	x	2	=	1.79	SQ.MT.
"	1.00	x	2.20	x	2	=	4.40	SQ.MT.
B5	1.00	x	2.05	x	2	=	4.10	SQ.MT.
"	0.85	x	0.90	x	2	=	1.53	SQ.MT.
B6 (Encl)	3.65	x	2.00	x	2	=	14.60	SQ.MT.
"	0.30	x	1.82	x	2	=	1.09	SQ.MT.
B7 (Encl)	3.275	x	2.00	x	4	=	26.18	SQ.MT.
B8	3.01	x	1.00	x	2	=	6.02	SQ.MT.
B9 (Encl)	3.35	x	2.00	x	2	=	13.40	SQ.MT.
"	0.15	x	1.90	x	2	=	0.57	SQ.MT.
TOTAL						=	**407.34**	**SQ.MT.**
DUCT DEDUCTION (Y2)								
D1	3.33	x	4.24	x	1	=	14.12	SQ.MT.
D2	3.80	x	1.20	x	1	=	4.56	SQ.MT.
D3	3.99	x	3.04	x	1	=	12.13	SQ.MT.
D4	6.17	x	0.44	x	1	=	2.71	SQ.MT.
D5	5.33	x	4.24	x	1	=	22.60	SQ.MT.
TOTAL						=	**56.12**	**SQ.MT.**
STAIRCASE,LIFT,LIFT LOBBY DEDUCTION (Y3)								
S1	3.00	x	4.05	x	1	=	12.150	SQ.MT.
"	3.15	x	1.70	x	1	=	5.355	SQ.MT.
S2	3.00	x	4.05	x	1	=	12.15	SQ.MT.
"	3.15	x	1.11	x	1	=	3.497	SQ.MT.
"	3.45	x	0.59	x	1	=	2.036	SQ.MT.
L1	10.42	x	3.33	x	1	=	34.70	SQ.MT.
L2	2.00	x	3.10	x	1	=	6.20	SQ.MT.
TOTAL						=	**76.09**	**SQ.MT.**
PASSAGE DEDUCTION (Y4)								
P1	3.30	x	3.25	x	1	=	10.725	SQ.MT.
P2	0.15	x	1.95	x	2	=	0.585	SQ.MT.
P3	5.30	x	3.54	x	1	=	18.76	SQ.MT.
P4	3.33	x	2.55	x	1	=	8.49	SQ.MT.
P5	3.80	x	0.15	x	1	=	0.57	SQ.MT.
P6	10.42	x	2.40	x	1	=	25.01	SQ.MT.
P7	10.16	x	0.15	x	1	=	1.52	SQ.MT.
P8	5.33	x	2.55	x	1	=	13.59	SQ.MT.
P9	3.30	x	6.79	x	1	=	22.41	SQ.MT.
TOTAL						=	**101.66**	**SQ.MT.**
REFUGE DEDUCTION (Y5) @ MIDLANDING OF STAIRCASE								
R1	3.60	x	2.97	x	1	=	10.69	SQ.MT.
R2	3.00	x	1.40	x	1	=	4.20	SQ.MT.
R3	0.30	x	4.42	x	1	=	1.33	SQ.MT.
R4	3.00	x	4.37	x	1	=	13.11	SQ.MT.
R5	0.30	x	2.97	x	1	=	0.89	SQ.MT.
TOTAL						=	**30.22**	**SQ.MT.**
REFUGE REQUIRED (Y6)							**21.00**	SQ.MT.
TOTAL DEDUCTION (Y7) (Y1+Y2+Y3+Y4+Y5)							**671.42**	SQ.MT.
TOTAL BUILT UP AREA (Y8) (X-Y7)						=	**583.51**	SQ.MT.
EXCESS REFUGE AREA (Y9) (Y5-Y6)						=	**9.22**	SQ.MT.
PERM. BALCONY (Y10) (Y8 x 10%)						=	**58.35**	**SQ.MT.**
BALCONY AREA STATEMENT								
B1	7.570	x	1.00	x	2	=	15.140	SQ.MT.
B2	9.870	x	1.00	x	1	=	9.870	SQ.MT.
B3	2.96	x	1.00	x	1	=	2.96	SQ.MT.
B4	0.85	x	1.05	x	2	=	1.79	SQ.MT.
"	1.00	x	2.20	x	2	=	4.40	SQ.MT.
B5	1.00	x	2.05	x	2	=	4.10	SQ.MT.
"	0.85	x	0.90	x	2	=	1.53	SQ.MT.
B6 (Encl)	3.65	x	2.00	x	2	=	14.60	SQ.MT.
"	0.30	x	1.82	x	2	=	1.09	SQ.MT.
B7 (Encl)	3.275	x	2.00	x	4	=	26.18	SQ.MT.
B8	3.01	x	1.00	x	2	=	6.02	SQ.MT.
B9 (Encl)	3.35	x	2.00	x	2	=	13.40	SQ.MT.
"	0.15	x	1.90	x	2	=	0.57	SQ.MT.
TOTAL (Y11)						=	**101.65**	**SQ.MT.**
EXCESS BALCONY (Y12) (Y11-Y10)						=	**43.30**	**SQ.MT.**
NET BUILT UP AREA (Y8+Y9+Y12)						=	**636.03**	**SQ.MT.**

REFUGE AREA STATEMENT

REFUGE AREA REQ. AT MIDLANDING OF STAIRCASE 7TH,9TH,11TH,13TH,15TH,17TH,19TH,21 ST,23RD,25TH & 27TH (BLDG NO.1, WING - A)	TOTAL NO. OF PERSON ABOVE FLOORS			
	NO OF FLAT	X	FLOORS	TOTAL
3RD,4TH,5TH,6TH,8TH,10TH,12TH,14TH, 16TH,18TH,20TH,22ND,24TH & 26TH TYPICAL FLOOR	7.00	X	1.00	7
7TH,9TH,11TH,13TH,15TH,17TH,19TH,21 ST,,23RD,25TH & 27TH REFUGE FLOOR	7.00	X	1.00	7
TOTAL NO. OF FLAT				14
NO. OF PERSON PER FLAT				5
TOTAL PERSON				70
REQ. 0.3 SQ.MTS. PER PERSON				0.3
TOTAL REQ. REFUGE AREA				21.00
TOTAL PROVIDED REFUGE AREA				30.22

LIGHT AND VENTILATION STATEMENT (BLDG 1,WING A FLAT NO 1 & 4)

ROOM	AREA OF ROOM (SQM)	AREA OF WIN REQ. (SQM)	AREA OF WIN	TYPE OF WINDOW
LIVING	18.320	3.053	4.520	W1
BED ROOM	10.220	1.703	3.060	W2A
BED ROOM 1	9.130	1.522	3.870	W2
KITCHEN	6.740	1.123	3.230	W3
TOILET 1	3.940	0.657	0.710	V
TOILET 2	3.850	0.642	0.710	V

LIGHT AND VENTILATION STATEMENT (BLDG 1,WING A FLAT NO 2 & 3)

ROOM	AREA OF ROOM (SQM)	AREA OF WIN REQ. (SQM)	AREA OF WIN	TYPE OF WINDOW
LIVING	18.740	3.123	4.520	W1
BED ROOM 1	8.540	1.423	3.060	W2A
BED ROOM 2	13.780	2.297	3.870	W2
KITCHEN	7.560	1.260	3.230	W3
TOILET 1	3.920	0.653	0.710	V
TOILET 2	3.230	0.538	0.710	V

LIGHT AND VENTILATION STATEMENT (BLDG 1,WING A FLAT NO 5 & 7)

ROOM	AREA OF ROOM (SQM)	AREA OF WIN REQ. (SQM)	AREA OF WIN	TYPE OF WINDOW
LIVING	25.460	4.243	4.930	W1A
BED ROOM	11.640	1.907	3.870	W2
BED ROOM 1	14.450	2.408	3.870	W2
BED ROOM 2	13.090	2.182	3.060	W2A
KITCHEN	7.470	1.245	3.230	W3
TOILET 1	3.180	0.530	0.710	V
TOILET 2	3.900	0.650	0.710	V
TOILET 3	4.700	0.783	0.810	V1

LIGHT AND VENTILATION STATEMENT (BLDG 1,WING A , FLAT NO 6)

ROOM	AREA OF ROOM (SQM)	AREA OF WIN REQ. (SQM)	AREA OF WIN	TYPE OF WINDOW
LIVING	27.990	4.960	4.930	W1A
BED ROOM	11.100	1.855	3.870	W2
BED ROOM 1	12.200	2.038	3.870	W2
BED ROOM 2	17.410	2.902	3.870	W2
KITCHEN	10.040	1.673	3.230	W3
TOILET 1	4.180	0.697	0.710	V
TOILET 2	3.780	0.630	0.710	V
TOILET 3	3.800	0.633	0.710	V

(BLDG NO.1,WING A) | 12 / 25

CONTENTS OF SHEET

TYPICAL REFUGE FLOOR PLAN & CALCULATION

STAMP AND DATE OF APPROVAL OF PLAN

PART OC

This Part Occupancy Certificate is issued for Sale Building no 1 (A ,B ,C) (Till 26th Floor) & Building no 2 (Till 30th Floor), and As Built drawing is approved subject to conditions as mentioned in Part Occupancy Certificate bearing no. NAINA/6529/2021-CIDCO/NAINA/PANVEL/Kolkhe/ BP- 00112/Part/ OC/ 2022/ 0217A. Dated 24.06.2022.

RAJA BHAGUJI WAGHMARE

Digitally signed by RAJA BHAGUJI WAGHMARE
Date: 2022.06.24 19:40:37 +05'30'


DOOR SCHEDULE

SI NO.	D NO.	SIZE	LEVEL M/M	DESCRIPTION	REMARK
1.	FRD	1.5 X 2.30	2.30	FIRE RESISTANT DOOR	STAIRCASE
2.	D-1	1.2 X 2.30	2.30	T.W FRAME WITH W.P FLUSH DOOR	MAIN DOOR
3.	D-2	0.9 X 2.30	2.30	T.W FRAME WITH W.P FLUSH DOOR	BED ROOM
4.	D-3	0.75 X 2.30	2.30	MARBLE/GRANITE FRAME WITH FRP DOOR	TOILET

WINDOW SCHEDULE

SI NO.	W NO.	SIZE	SILL LVL	LINTEL LVL	AREA (IN SQ.MT.)	DESCRIPTION	REMARK
1	SW-1	2.0 X 2.15	0.15	2.30	4.30	RAILING / FIXED GLASS WINDOW	STAIRCASE
2	W-1	2.1 X 2.15	0.15	2.30	4.52	ALUMINUM SLIDING WINDOW	LIVING ROOM
3	W-1A	2.9 X 1.70	0.60	2.30	4.93	ALUMINUM SLIDING WINDOW	LIVING ROOM
4	W-2	1.8 X 2.15	0.15	2.30	3.87	ALUMINUM SLIDING WINDOW	BED ROOM
5	W-2A	1.8 X 1.70	0.60	2.30	3.06	ALUMINUM SLIDING WINDOW	BED ROOM
6	W-3	1.5 X 2.15	0.15	2.30	3.23	ALUMINUM SLIDING WINDOW	KITCHEN
7	V	0.85 X 1.76	0.54	2.30	1.50	LOUVERS VENTILATOR	TOILETS & DUCT
8	V1	0.75 X 0.95	1.35	2.30	0.81	LOUVERS VENTILATOR	TOILETS & DUCT
9	V2	0.75 X 0.95	1.35	2.30	0.62	LOUVERS VENTILATOR	DUCT

NOTE :-
1) HABITABLE ROOM INCLUDES BEDROOM & LIVING ROOM
2) REFUGE AREAS ARE PROVIDED AT MIDLANDING OF EVERY ALTERNATE FLOOR
3) ALL DIMENSIONS ARE IN METERS

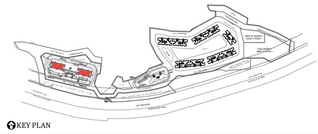

KEY PLAN

DESCRIPTION OF PROPOSAL & PROPERTY

PROPOSED DEVELOPMENT FOR RENTAL HOUSING SCHEME ON LAND BEARING S.NO.95/1(pt), 95/2(pt),95/3A(pt),98/1,99/2,98/3,98/4A,98/4/B,1,98/4/B/2,98/5(pt),98/7/3(pt),98/8,98/9, 98/10A,98/10B,99(pt),101/3,101/4/A,101/4/B,101/4/C,101/5,101/6,101/7,101/8A,101/8B,101/9, 101/10/A,101/10/B,102,103/1,103/2(pt),103/3,103/4,110/1A(pt),110/4,110/5A,110/6A,110/10, 110/11 at Village Kolkhe, Taluka - Panvel, District Raigad

NORTH	JOB. NO.	DRG. NO.	DRAWN BY
		12 / 25	
	SCALE	DATE	CHECKED BY
	1: 100		
REVISIONS	DESCRIPTION :		
R-0			


NAME OF THE OWNER

M/S. PARADISE LIFESPACES LLP.
(P.O.A.H. of Shri. Esmail Ebrahim Dhariwala & others)


MANISH MADHU BATHIJA

NAME & ADDRESS OF THE DESIGN ARCHITECT:

NAME OF ARCHITECT	M/s. DIMENSION ARCHITECTS	
LICENSE NO	CA/ /	
ADDRESS	PLOT NO.99, NEAR SAGAR VIHAR, SECTOR-08, VASHI, NAVI MUMBAI 400 703	
NAME OF ARCHITECT	DEVYANI KHADILKAR	
LIC. NO	CA/90/13184	
ADDRESS	B-106, Natraj Building, Mulund Goregaon Link Road Mulund (w), Mumbai : 400 080	

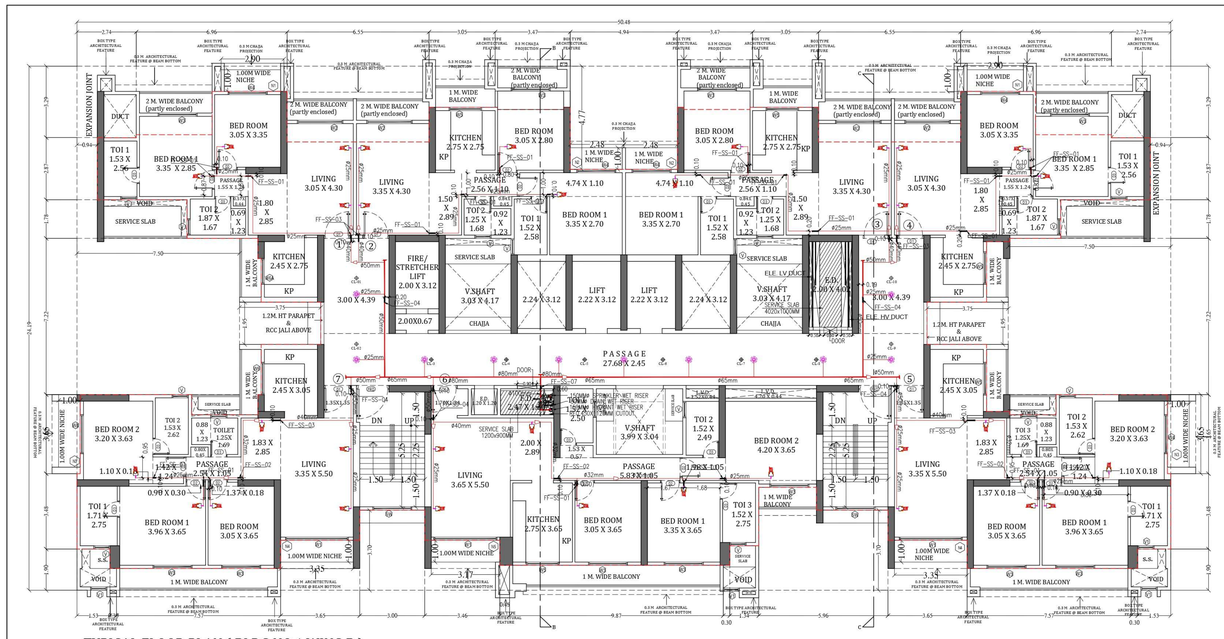

TYPICAL FLOOR PLAN (BLDG NO.1,WING B)
(3rd, 4th, 5th, 6th, 8th,10th,12th,14th,16th,18th,20th,22nd,24th & 26th)
SCALE :- 1:100

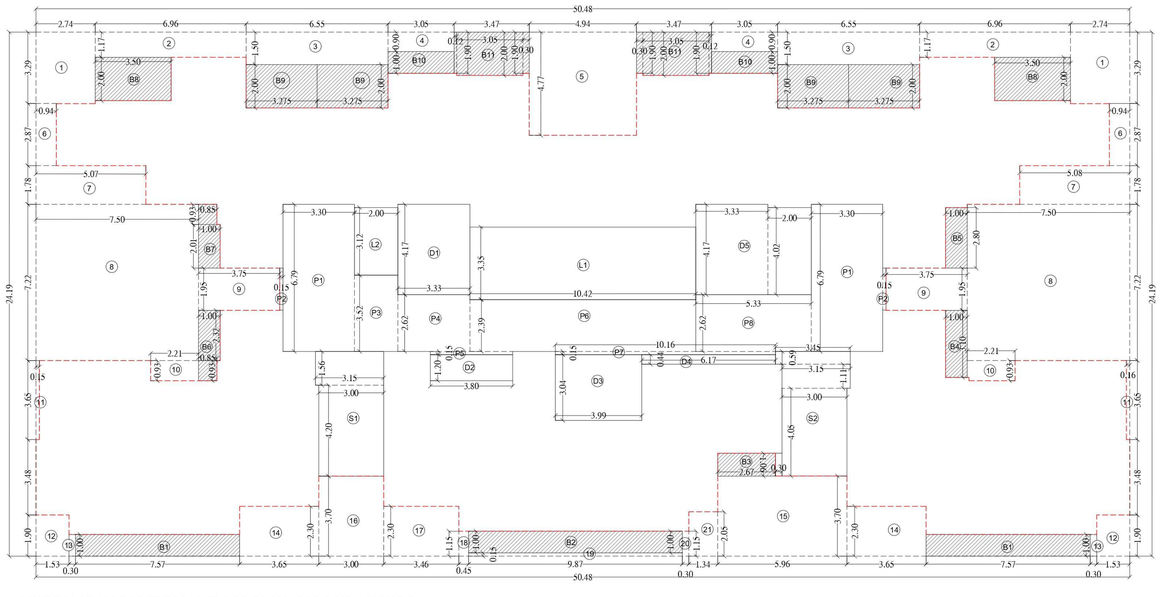

LINE DIAGRAM FOR TYPICAL FLOOR PLAN (BLDG NO.1,WING B)
(3rd, 4th, 5th, 6th, 8th,10th,12th,14th,16th,18th,20th,22nd,24th & 26th)
SCALE :- 1:100

BUILT UP AREA CALCULATION FOR TYPICAL FLOOR PLAN
(BLDG NO.1, WING B)
(3rd, 4th, 5th, 6th, 8th,10th,12th,14th,16th,18th,20th,22nd,24th & 26th)

ADDITION (X)								
A	50.48	x	24.19	x	1	=	1221.11	SQ.MT.
TOTAL						=	**1221.11**	**SQ.MT.**
STANDARD DEDUCTION (Y1)								
1	2.74	x	3.29	x	2	=	18.03	SQ.MT.
2	6.96	x	1.17	x	2	=	16.27	SQ.MT.
3	6.55	x	1.50	x	2	=	19.64	SQ.MT.
4	3.05	x	0.90	x	2	=	5.48	SQ.MT.
5	4.94	x	4.77	x	1	=	23.52	SQ.MT.
6	0.94	x	2.87	x	2	=	5.37	SQ.MT.
7	5.08	x	1.78	x	2	=	18.07	SQ.MT.
8	7.50	x	7.22	x	2	=	108.23	SQ.MT.
9	3.75	x	1.95	x	2	=	14.61	SQ.MT.
10	2.21	x	0.93	x	2	=	4.10	SQ.MT.
11	0.16	x	3.65	x	2	=	1.17	SQ.MT.
12	1.53	x	1.90	x	2	=	5.80	SQ.MT.
13	0.30	x	1.00	x	2	=	0.60	SQ.MT.
14	3.65	x	2.30	x	2	=	16.77	SQ.MT.
15	5.96	x	3.70	x	1	=	22.03	SQ.MT.
16	3.00	x	3.70	x	1	=	11.10	SQ.MT.
17	3.46	x	2.30	x	1	=	7.96	SQ.MT.
18	0.45	x	1.15	x	1	=	0.52	SQ.MT.
19	9.87	x	0.15	x	1	=	1.48	SQ.MT.
20	0.30	x	1.15	x	1	=	0.35	SQ.MT.
21	1.34	x	2.05	x	1	=	2.75	SQ.MT.
B1	7.57	x	1.00	x	2	=	15.14	SQ.MT.
B2	9.87	x	1.00	x	1	=	9.87	SQ.MT.
B3	2.67	x	1.06	x	1	=	2.83	SQ.MT.
B4	1.00	x	3.10	x	1	=	3.10	SQ.MT.
B5	1.00	x	2.80	x	1	=	2.80	SQ.MT.
B6	1.00	x	2.32	x	1	=	2.32	SQ.MT.
"	0.85	x	0.93	x	1	=	0.79	SQ.MT.
B7	0.85	x	0.93	x	1	=	0.79	SQ.MT.
"	1.00	x	2.01	x	1	=	2.01	SQ.MT.
B8 (Encl)	3.50	x	2.00	x	2	=	14.00	SQ.MT.
B9 (Encl)	3.275	x	2.00	x	4	=	26.20	SQ.MT.
B10	3.05	x	1.00	x	2	=	6.10	SQ.MT.
B11 (Encl)	3.05	x	2.00	x	2	=	12.20	SQ.MT.
"	0.12	x	1.90	x	2	=	0.46	SQ.MT.
"	0.30	x	1.90	x	2	=	1.14	SQ.MT.
TOTAL						=	**403.60**	**SQ.MT.**
DUCT DEDUCTION (Y2)								
D1	3.33	x	4.17	x	1	=	13.89	SQ.MT.
D2	3.80	x	1.20	x	1	=	4.56	SQ.MT.
D3	3.99	x	3.04	x	1	=	12.13	SQ.MT.
D4	6.17	x	0.44	x	1	=	2.71	SQ.MT.
D5	3.33	x	4.17	x	1	=	13.89	SQ.MT.
"	2.00	x	4.02	x	1	=	8.04	SQ.MT.
TOTAL						=	**55.22**	**SQ.MT.**
STAIRCASE,LIFT,LIFT LOBBY DEDUCTION (Y3)								
S1	3.00	x	4.20	x	1	=	12.60	SQ.MT.
"	3.15	x	1.56	x	1	=	4.91	SQ.MT.
S2	3.00	x	4.05	x	1	=	12.15	SQ.MT.
"	3.15	x	1.11	x	1	=	3.50	SQ.MT.
"	3.45	x	0.59	x	1	=	2.04	SQ.MT.
"	0.30	x	1.06	x	1	=	0.32	SQ.MT.
L1	10.42	x	3.35	x	1	=	34.91	SQ.MT.
L2	2.00	x	3.12	x	1	=	6.24	SQ.MT.
TOTAL						=	**76.67**	**SQ.MT.**
PASSAGE DEDUCTION (Y4)								
P1	3.30	x	6.79	x	2	=	44.814	SQ.MT.
P2	0.15	x	1.94	x	2	=	0.58	SQ.MT.
P3	2.00	x	3.52	x	1	=	7.04	SQ.MT.
P4	3.33	x	2.62	x	1	=	8.73	SQ.MT.
P5	3.80	x	0.15	x	1	=	0.57	SQ.MT.
P6	10.42	x	2.39	x	1	=	24.90	SQ.MT.
P7	10.16	x	0.15	x	1	=	1.52	SQ.MT.
P8	5.33	x	2.62	x	1	=	13.97	SQ.MT.
TOTAL						=	**102.12**	**SQ.MT.**
TOTAL DEDUCTION (Y5) (Y1+Y2+Y3+Y4)							**637.61**	SQ.MT.
TOTAL BUILT UP AREA (Y6) (X-Y5)						=	**583.50**	SQ.MT.
PERM. BALCONY (Y7) (Y6 x 10%)						=	**58.35**	**SQ.MT.**
BALCONY AREA STATEMENT								
B1	7.57	x	1.00	x	2	=	15.14	SQ.MT.
B2	9.87	x	1.00	x	1	=	9.87	SQ.MT.
B3	2.67	x	1.06	x	1	=	2.83	SQ.MT.
B4	1.00	x	3.10	x	1	=	3.10	SQ.MT.
B5	1.00	x	2.80	x	1	=	2.80	SQ.MT.
B6	1.00	x	2.32	x	1	=	2.32	SQ.MT.
"	0.85	x	0.93	x	1	=	0.79	SQ.MT.
B7	0.85	x	0.93	x	1	=	0.79	SQ.MT.
"	1.00	x	2.01	x	1	=	2.01	SQ.MT.
B8 (Encl)	3.50	x	2.00	x	2	=	14.00	SQ.MT.
B9 (Encl)	3.275	x	2.00	x	4	=	26.20	SQ.MT.
B10	3.05	x	1.00	x	2	=	6.10	SQ.MT.
B11 (Encl)	3.05	x	2.00	x	2	=	12.20	SQ.MT.
"	0.12	x	1.90	x	2	=	0.46	SQ.MT.
"	0.30	x	1.90	x	2	=	1.14	SQ.MT.
TOTAL (Y8)						=	**99.75**	**SQ.MT.**
EXCESS BALCONY (Y9) (Y8-Y7)						=	**41.40**	**SQ.MT.**
NET BUILT UP AREA (Y9+Y6)						=	**624.90**	**SQ.MT.**

NICHE AREA STATEMENT FOR
BLDG 1 (WING B) (FOR TYPICAL FLOORS)

N1	2.90	x	1.00	x	2	=	5.80 SQ.MT.
N2	2.480	x	1.00	x	2	=	4.960 SQ.MT.
N3	1.00	x	3.65	x	2	=	7.30 SQ.MT.
N4	3.35	x	1.00	x	2	=	6.70 SQ.MT.
N5	3.17	x	1.00	x	1	=	3.17 SQ.MT.
TOTAL AREA						=	**27.93 SQ.MT.**

CARPET AREA STATEMENT FOR TYPICAL FLOOR
(BLDG NO.1, WING B)

FLAT NO. 1	=	55.23	SQ.MT.
FLAT NO. 2	=	60.07	SQ.MT.
FLAT NO. 3	=	60.07	SQ.MT.
FLAT NO. 4	=	55.23	SQ.MT.
FLAT NO. 5	=	88.28	SQ.MT.
FLAT NO.6	=	98.94	SQ.MT.
FLAT NO.7	=	88.10	SQ.MT.

LIGHT AND VENTILATION STATEMENT
(BLDG 1,WING B FLAT NO 1 & 4)

ROOM	AREA OF ROOM (SQM)	AREA OF WIN REQ. (SQM)	AREA OF WIN PROV.(SQM)	TYPE OF WINDOW PROVD.
LIVING	18.240	3.040	4.520	W1
BED ROOM	10.220	1.703	3.060	W2A
BED ROOM 1	9.550	1.592	3.870	W2
KITCHEN	6.740	1.123	3.230	W3
TOILET 1	3.920	0.653	0.710	V
TOILET 2	3.970	0.662	0.710	V

LIGHT AND VENTILATION STATEMENT
(BLDG 1,WING B FLAT NO 2 & 3)

ROOM	AREA OF ROOM (SQM)	AREA OF WIN REQ. (SQM)	AREA OF WIN PROV.(SQM)	TYPE OF WINDOW PROVD.
LIVING	18.740	3.123	4.520	W1
BED ROOM	8.540	1.423	3.060	W2A
BED ROOM 1	14.260	2.377	3.870	W2
KITCHEN	7.560	1.260	3.230	W3
TOILET 1	3.920	0.653	0.710	V
TOILET 2	3.230	0.538	0.710	V

LIGHT AND VENTILATION STATEMENT
(BLDG 1,WING B FLAT NO 5 & 7)

ROOM	AREA OF ROOM (SQM)	AREA OF WIN REQ. (SQM)	AREA OF WIN PROV.(SQM)	TYPE OF WINDOW PROVD.
LIVING	25.460	4.243	4.930	W1A
BED ROOM	11.380	1.897	3.870	W2
BED ROOM 1	14.720	2.453	3.870	W2
BED ROOM 2	13.570	2.262	3.060	W2A
KITCHEN	7.470	1.245	3.230	W3
TOILET 1	4.700	0.783	0.810	V1
TOILET 2	4.010	0.668	0.710	V
TOILET 3	3.190	0.532	0.710	V

LIGHT AND VENTILATION STATEMENT
(BLDG 1,WING B FLAT NO 6)

ROOM	AREA OF ROOM (SQM)	AREA OF WIN REQ. (SQM)	AREA OF WIN PROV.(SQM)	TYPE OF WINDOW PROVD.
LIVING	27.990	4.660	4.930	W1A
BED ROOM	11.130	1.855	3.870	W2
BED ROOM 1	12.230	2.038	3.870	W2
BED ROOM 2	17.410	2.902	3.870	W2
KITCHEN	10.040	1.673	3.230	W3
TOILET 1	3.800	0.633	0.710	V
TOILET 2	3.780	0.630	0.710	V
TOILET 3	4.180	0.697	0.710	V

(BLDG NO.1,WING B) | 13 / 25

CONTENTS OF SHEET

TYPICAL FLOOR PLAN & CALCULATION

STAMP AND DATE OF APPROVAL OF PLAN

PART OC
This Part Occupancy Certificate is issued for Sale Building no 1 (A ,B ,C) (Till 26th Floor) & Building no 2 (Till 30th Floor), and As Built drawing is approved subject to conditions as mentioned in Part Occupancy Certificate bearing no. NAINA/6529/2021-CIDCO/NAINA/PANVEL/Kolkhe/ BP- 00112/Part/ OC/ 2022/ 0217A. Dated 24.06.2022.

RAJA BHAGUJI WAGHMARE

Digitally signed by RAJA BHAGUJI WAGHMARE
Date: 2022.06.24 19:41:06 +05'30'


DOOR SCHEDULE

Sr.NO.	D.NO	SIZE	LINTEL LVL	DESCRIPTION	REMARK
1.	FRD	1.5 X 2.30	2.30	FIRE RESISTANT DOOR	STAIRCASE
2.	D-1	1.2 X 2.30	2.30	T.W FRAME WITH W.P FLUSH DOOR	MAIN DOOR
3.	D-2	0.9 X 2.30	2.30	T.W FRAME WITH W.P FLUSH DOOR	BED ROOM
4.	D-3	0.75 X 2.30	2.30	MARBLE/GRANITE FRAME WITH FRK DOOR	TOILET

WINDOW SCHEDULE

SR.NO.	W.NO.	SIZE	SILL LVL	LINTEL LVL	AREA (IN SQ.MT.)	DESCRIPTION	REMARK
1	SW-1	2.0 X 2.15	0.15	2.30	4.30	RAILING / FIXED GLASS WINDOW	STAIRCASE
2	W-1	2.1 X 2.15	0.15	2.30	4.52	ALUMINUM SLIDING WINDOW	LIVING ROOM
3	W-1A	2.9 X 1.70	0.60	2.30	4.93	ALUMINUM SLIDING WINDOW	LIVING ROOM
4	W-2	1.8 X 2.15	0.15	2.30	3.87	ALUMINUM SLIDING WINDOW	BED ROOM
5	W-2A	1.6 X 1.70	0.60	2.30	3.06	ALUMINUM SLIDING WINDOW	BED ROOM
6	W-3	1.5 X 2.15	0.15	2.30	3.23	ALUMINUM SLIDING WINDOW	KITCHEN
7	V	0.85 X 1.76	0.54	2.30	1.50	LOUVERS VENTILATOR	TOILETS & DUCT
8	V1	0.75 X 0.95	1.35	2.30	0.81	LOUVERS VENTILATOR	TOILETS & DUCT
9	V2	0.75 X 0.95	1.35	2.30	0.62	LOUVERS VENTILATOR	DUCT

NOTE :-
1) HABITABLE ROOM INCLUDES BEDROOM & LIVING ROOM
2) REFUGE AREAS ARE PROVIDED AT MIDLANDING OF EVERY ALTERNATE FLOOR
3) ALL DIMENSIONS ARE IN METERS

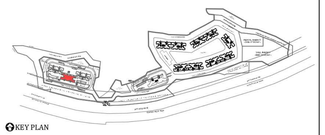

KEY PLAN

DESCRIPTION OF PROPOSAL & PROPERTY

PROPOSED DEVELOPMENT FOR RENTAL HOUSING SCHEME ON LAND BEARING S.NO.95/1(pt), 95/2(pt),95/3A(pt),98/1,98/2,98/3,98/4A,98/4/B/1,98/4/B/2,98/5(pt),98/7/3(pt),98/8,98/9, 98/10A,98/10B,98(pt),101/5,101/4/A,101/4/B,101/4/C,101/5,101/6,101/7,101/8A,101/8B,101/9, 101/10/A,101/10/B,102,103/1,103/2(pt),103/3,103/4,110/1A(pt),110/4,110/5A,110/6A,110/10, 110/11 at Village Kolkhe, Taluka - Panvel, District Raigad

NORTH	JOB. NO.	DRG. NO.	DRAWN BY
		13 / 25	
	SCALE	DATE	CHECKED BY
	1: 100	-	-
REVISIONS	DESCRIPTION :		
R-0			


NAME OF THE OWNER

MANISH MADHU BATHIJA


M/S. PARADISE LIFESPACES LLP.
(P.O.A.H. of Shri. Esmail Ebrahim Dhariwala & others)

NAME & ADDRESS OF THE DESIGN ARCHITECT:

NAME OF ARCHITECT	M/s. DIMENSION ARCHITECTS
LICENSE NO	CA/ /
ADDRESS	PLOT NO.99, NEAR SAGAR VIHAR, SECTOR-08, VASHI, NAVI MUMBAI 400 703
NAME OF ARCHITECT	DEVYANI KHADILKAR
LIC. NO	CA/90/13184
ADDRESS	B-106, Natraj Building, Mulund Goregaon Link Road Mulund (w), Mumbai : 400 080

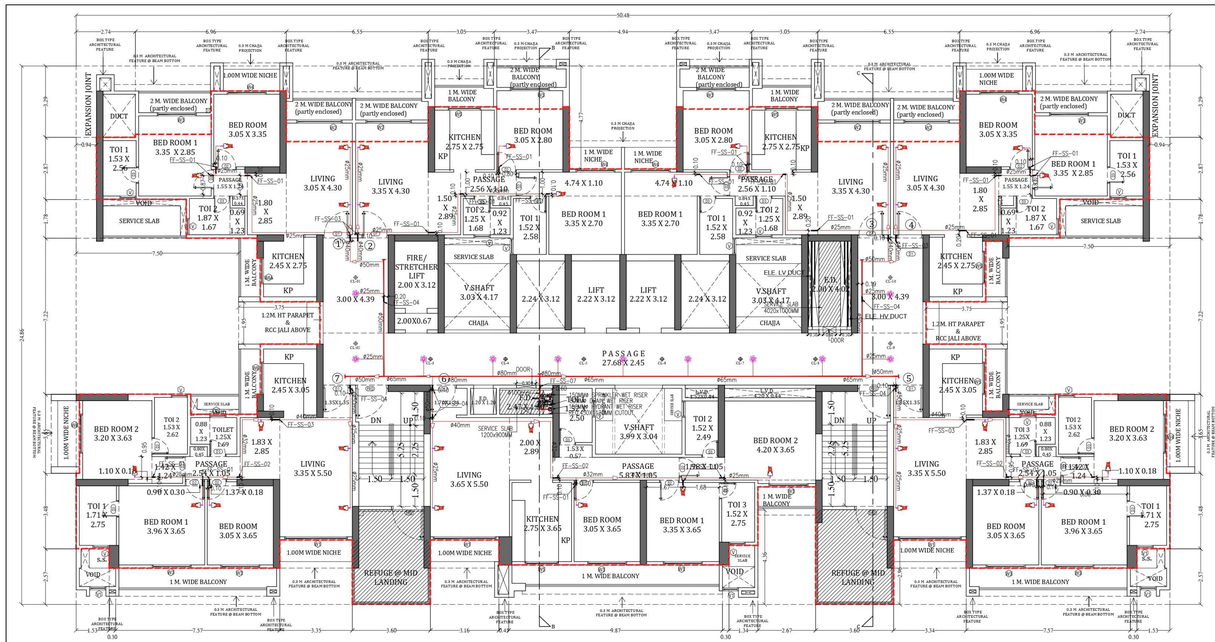

TYPICAL REFUGE FLOOR PLAN (BLDG NO.1,WING B)
(7th, 9th,11th,13th,15th,17th,19th,21st,23rd & 25th)
SCALE :- 1:100

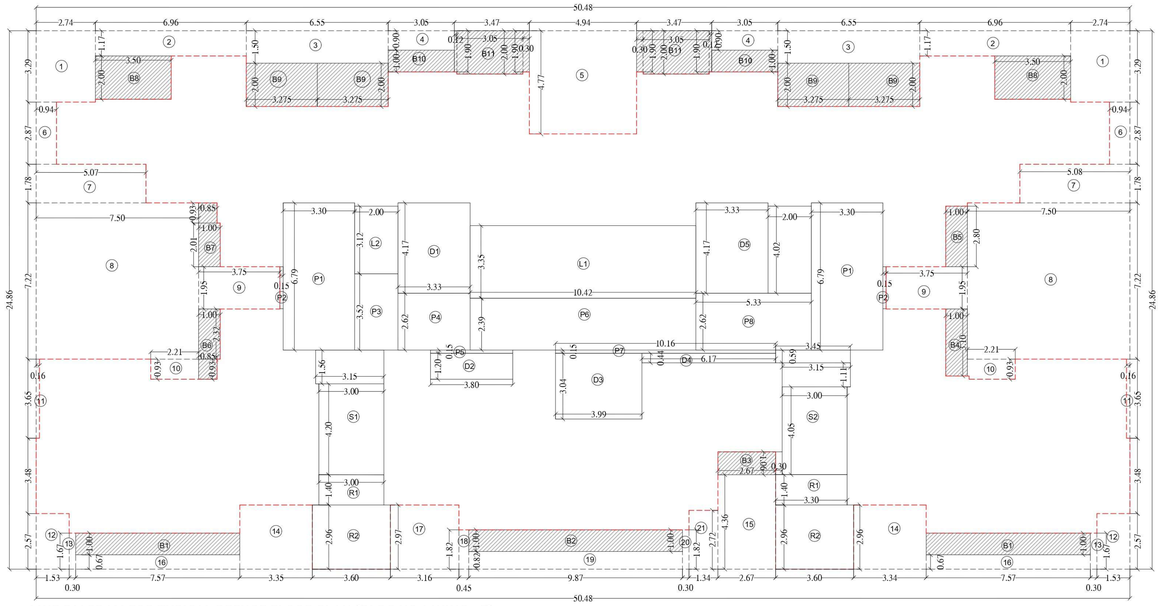

LINE DIAGRAM FOR TYPICAL REFUGE FLOOR PLAN (BLDG NO.1,WING - B)
(7th, 9th,11th,13th,15th,17th,19th,21st,23rd & 25th)
SCALE :- 1:100

BUILT UP AREA CALCULATION FOR TYPICAL FLOOR PLAN
(BLDG NO.1, WING B)
(7th,9th,11th,13th,15th,17th,19th,21st,23rd & 25th)

ADDITION (X)								
A	50.48	x	24.86	x	1	=	1254.93	SQ.MT.
TOTAL						=	**1254.93**	**SQ.MT.**
STANDARD DEDUCTION (Y1)								
1	2.74	x	3.29	x	2	=	18.03	SQ.MT.
2	6.96	x	1.17	x	2	=	16.27	SQ.MT.
3	6.55	x	1.50	x	2	=	19.64	SQ.MT.
4	3.05	x	0.90	x	2	=	5.48	SQ.MT.
5	4.94	x	4.77	x	1	=	23.52	SQ.MT.
6	0.94	x	2.87	x	2	=	5.37	SQ.MT.
7	5.08	x	1.78	x	2	=	18.07	SQ.MT.
8	7.50	x	7.22	x	2	=	108.23	SQ.MT.
9	3.75	x	1.95	x	2	=	14.61	SQ.MT.
10	2.21	x	0.93	x	2	=	4.10	SQ.MT.
11	0.16	x	3.65	x	2	=	1.17	SQ.MT.
12	1.53	x	2.57	x	2	=	7.86	SQ.MT.
13	0.30	x	1.67	x	2	=	1.00	SQ.MT.
14	3.34	x	2.96	x	2	=	19.74	SQ.MT.
15	2.67	x	4.36	x	1	=	11.63	SQ.MT.
16	7.57	x	0.67	x	2	=	10.14	SQ.MT.
17	3.16	x	2.90	x	1	=	9.16	SQ.MT.
18	0.45	x	1.82	x	1	=	0.82	SQ.MT.
19	9.87	x	0.82	x	1	=	8.09	SQ.MT.
20	0.30	x	1.82	x	1	=	0.55	SQ.MT.
21	1.34	x	2.72	x	1	=	3.64	SQ.MT.
B1	7.57	x	1.00	x	2	=	15.14	SQ.MT.
B2	9.87	x	1.00	x	1	=	9.87	SQ.MT.
B3	2.67	x	1.06	x	1	=	2.83	SQ.MT.
B4	1.00	x	3.10	x	1	=	3.10	SQ.MT.
B5	1.00	x	2.80	x	1	=	2.80	SQ.MT.
B6	1.00	x	2.32	x	1	=	2.32	SQ.MT.
"	0.85	x	0.93	x	1	=	0.79	SQ.MT.
B7	0.85	x	0.93	x	1	=	0.79	SQ.MT.
"	1.00	x	2.01	x	1	=	2.01	SQ.MT.
B8 (Encl)	3.50	x	2.00	x	2	=	14.00	SQ.MT.
B9 (Encl)	3.275	x	2.00	x	4	=	26.20	SQ.MT.
B10	3.05	x	1.00	x	2	=	6.10	SQ.MT.
B11 (Encl)	3.05	x	2.00	x	2	=	12.20	SQ.MT.
"	0.12	x	1.90	x	2	=	0.46	SQ.MT.
"	0.30	x	1.90	x	2	=	1.14	SQ.MT.
TOTAL						=	**406.87**	**SQ.MT.**
DUCT DEDUCTION (Y2)								
D1	3.33	x	4.17	x	1	=	13.89	SQ.MT.
D2	3.80	x	1.20	x	1	=	4.56	SQ.MT.
D3	3.99	x	3.04	x	1	=	12.13	SQ.MT.
D4	6.17	x	0.44	x	1	=	2.71	SQ.MT.
D5	3.33	x	4.17	x	1	=	13.89	SQ.MT.
"	2.00	x	4.02	x	1	=	8.04	SQ.MT.
TOTAL						=	**55.22**	**SQ.MT.**
STAIRCASE,LIFT,LIFT LOBBY DEDUCTION (Y3)								
S1	3.00	x	4.20	x	1	=	12.60	SQ.MT.
"	3.15	x	1.56	x	1	=	4.91	SQ.MT.
S2	3.00	x	4.05	x	1	=	12.15	SQ.MT.
"	3.15	x	1.11	x	1	=	3.50	SQ.MT.
"	3.45	x	0.59	x	1	=	2.04	SQ.MT.
"	0.30	x	1.06	x	1	=	0.32	SQ.MT.
L1	10.42	x	3.35	x	1	=	34.91	SQ.MT.
L2	2.00	x	3.12	x	1	=	6.24	SQ.MT.
TOTAL						=	**76.67**	**SQ.MT.**
PASSAGE DEDUCTION (Y4)								
P1	3.30	x	6.79	x	2	=	44.814	SQ.MT.
P2	0.15	x	1.94	x	2	=	0.58	SQ.MT.
P3	2.00	x	3.52	x	1	=	7.04	SQ.MT.
P4	3.33	x	2.62	x	1	=	8.73	SQ.MT.
P5	3.80	x	0.15	x	1	=	0.57	SQ.MT.
P6	10.42	x	2.39	x	1	=	24.90	SQ.MT.
P7	10.16	x	0.15	x	1	=	1.52	SQ.MT.
P8	5.33	x	2.62	x	1	=	13.97	SQ.MT.
TOTAL						=	**102.12**	**SQ.MT.**
REFUGE DEDUCTION (Y5) @ MIDLANDING OF STAIRCASE								
R1	3.30	x	1.40	x	2	=	9.24	SQ.MT.
R2	3.60	x	2.96	x	2	=	21.31	SQ.MT.
TOTAL						=	**30.55**	**SQ.MT.**
REFUGE REQUIRED (Y6)						=	**21.00**	**SQ.MT.**
TOTAL DEDUCTION (Y7) (Y1+Y2+Y3+Y4+Y5)							**671.43**	SQ.MT.
TOTAL BUILT UP AREA (Y8) (X-Y7)						=	**583.50**	SQ.MT.
EXCESS REFUGE AREA (Y9) (Y5-Y6)						=	**9.55**	SQ.MT.
PERM. BALCONY (Y10) (Y8 x 10%)						=	**58.35**	**SQ.MT.**
BALCONY AREA STATEMENT								
B1	7.57	x	1.00	x	2	=	15.14	SQ.MT.
B2	9.87	x	1.00	x	1	=	9.87	SQ.MT.
B3	2.67	x	1.06	x	1	=	2.83	SQ.MT.
B4	1.00	x	3.10	x	1	=	3.10	SQ.MT.
B5	1.00	x	2.80	x	1	=	2.80	SQ.MT.
B6	1.00	x	2.32	x	1	=	2.32	SQ.MT.
"	0.85	x	0.93	x	1	=	0.79	SQ.MT.
B7	0.85	x	0.93	x	1	=	0.79	SQ.MT.
"	1.00	x	2.01	x	1	=	2.01	SQ.MT.
B8 (Encl)	3.50	x	2.00	x	2	=	14.00	SQ.MT.
B9 (Encl)	3.275	x	2.00	x	4	=	26.20	SQ.MT.
B10	3.05	x	1.00	x	2	=	6.10	SQ.MT.
B11 (Encl)	3.05	x	2.00	x	2	=	12.20	SQ.MT.
"	0.12	x	1.90	x	2	=	0.46	SQ.MT.
"	0.30	x	1.90	x	2	=	1.14	SQ.MT.
TOTAL (Y11)						=	**99.75**	**SQ.MT.**
EXCESS BALCONY (Y12) (Y11-Y10)						=	**41.40**	**SQ.MT.**
NET BUILT UP AREA (Y8+Y9+Y12)						=	**634.45**	**SQ.MT.**

REFUGE AREA STATEMENT

REFUGE AREA REQ. AT MIDLANDING OF STAIRCASE	TOTAL NO. OF PERSON ABOVE FLOORS			
7TH,9TH,11TH,13TH,15TH,17TH,19TH,21ST,23RD,25TH & 27TH (BLDG NO.1,WING - B)	NO OF FLAT	X	FLOORS	TOTAL
3RD,4TH,5TH,6TH,8TH,10TH,12TH,14TH, 16TH,18TH,20TH,22ND,24TH & 26TH TYPICAL FLOOR	7.00	X	1.00	7
7TH,9TH,11TH,13TH,15TH,17TH,19TH,21ST,23RD,25TH & 27TH REFUGE FLOOR	7.00	X	1.00	7
TOTAL NO. OF FLAT				14
NO. OF PERSON PER FLAT				5
TOTAL PERSON				70
REQ. 0.3 SQ.MTS. PER PERSON				0.3
TOTAL REQ. REFUGE AREA				21.00
TOTAL PROVIDED REFUGE AREA				30.55

NICHE AREA STATEMENT FOR BLDG 1 (WING B) (FOR TYPICAL FLOORS)

N1	2.90	x	1.00	x	2	=	5.80	SQ.MT.
N2	2.480	x	1.00	x	2	=	4.960	SQ.MT.
N3	1.00	x	3.65	x	2	=	7.30	SQ.MT.
N4	3.35	x	1.00	x	2	=	6.70	SQ.MT.
N5	3.17	x	1.00	x	1	=	3.17	SQ.MT.
TOTAL AREA						=	**27.93**	**SQ.MT.**

LIGHT AND VENTILATION STATEMENT
(BLDG 1,WING B FLAT NO 1 & 4)

ROOM	AREA OF ROOM (SQM)	AREA OF WIN REQ. (SQM)	AREA OF WIN PROV.(SQM)	TYPE OF WINDOW PROVD.
LIVING	18.240	3.040	4.520	W1
BED ROOM	10.220	1.703	3.060	W2A
BED ROOM 1	9.550	1.592	3.870	W2
KITCHEN	6.740	1.123	3.230	W3
TOILET 1	3.920	0.653	0.710	V
TOILET 2	3.970	0.662	0.710	V

LIGHT AND VENTILATION STATEMENT (
(BLDG 1,WING B FLAT NO 2 & 3)

ROOM	AREA OF ROOM (SQM)	AREA OF WIN REQ. (SQM)	AREA OF WIN PROV.(SQM)	TYPE OF WINDOW PROVD.
LIVING	18.740	3.123	4.520	W1
BED ROOM	8.540	1.423	3.060	W2A
BED ROOM 1	14.260	2.377	3.870	W2
KITCHEN	7.560	1.260	3.230	W3
TOILET 1	3.920	0.653	0.710	V
TOILET 2	3.230	0.538	0.710	V

LIGHT AND VENTILATION STATEMENT
(BLDG 1,WING B FLAT NO 5 & 7)

ROOM	AREA OF ROOM (SQM)	AREA OF WIN REQ. (SQM)	AREA OF WIN PROV.(SQM)	TYPE OF WINDOW PROVD.
LIVING	25.460	4.243	4.930	W1A
BED ROOM	11.380	1.897	3.870	W2
BED ROOM 1	14.720	2.453	3.870	W2
BED ROOM 2	13.570	2.262	3.060	W2A
KITCHEN	7.470	1.245	3.230	W3
TOILET 1	4.700	0.783	0.810	V1
TOILET 2	4.010	0.668	0.710	V
TOILET 3	3.190	0.532	0.710	V

LIGHT AND VENTILATION STATEMENT
(BLDG 1,WING B FLAT NO 6)

ROOM	AREA OF ROOM (SQM)	AREA OF WIN REQ. (SQM)	AREA OF WIN PROV.(SQM)	TYPE OF WINDOW PROVD.
LIVING	27.960	4.660	4.930	W1A
BED ROOM	11.130	1.855	3.870	W2
BED ROOM 1	12.230	2.038	3.870	W2
BED ROOM 2	17.410	2.902	3.870	W2
KITCHEN	10.040	1.673	3.230	W3
TOILET 1	3.800	0.633	0.710	V
TOILET 2	3.780	0.630	0.710	V
TOILET 3	4.180	0.697	0.710	V

(BLDG NO.1,WING B) | 14 / 25

CONTENTS OF SHEET

TYPICAL REFUGE FLOOR PLAN & CALCULATION

STAMP AND DATE OF APPROVAL OF PLAN

PART OC
This Part Occupancy Certificate is issued for Sale Building no 1 (A ,B ,C) (Till 26th Floor) & Building no 2 (Till 30th Floor), and As Built drawing is approved subject to conditions as mentioned in Part Occupancy Certificate bearing no. NAINA/6529/2021-CIDCO/NAINA/PANVEL/Kolkhe/ BP- 00112/Part/ OC/ 2022/ 0217A. Dated 24.06.2022.

RAJA BHAGUJI WAGHMARE
Digitally signed by RAJA BHAGUJI WAGHMARE
Date: 2022.06.24 19:41:48 +05'30'


DOOR SCHEDULE

SI NO.	D NO.	SIZE	LINTEL LVL.	DESCRIPTION	REMARK
1.	FRD	1.5 X 2.30	2.30	FIRE RESISTANT DOOR	STAIRCASE
2.	D-1	1.2 X 2.30	2.30	T.W FRAME WITH W.P FLUSH DOOR	MAIN DOOR
3.	D-2	0.9 X 2.30	2.30	T.W FRAME WITH W.P FLUSH DOOR	BED ROOM
4.	D-3	0.75 X 2.30	2.30	MARBLE/GRANITE FRAME WITH FRP DOOR	TOILET

WINDOW SCHEDULE

SI NO.	W NO.	SIZE	SILL LVL.	LINTEL LVL.	AREA (IN SQ. MT.)	DESCRIPTION	REMARK
1	SW-1	2.0 X 2.15	0.15	2.30	4.30	RAILING / RIVED GLASS WINDOW	STAIRCASE
2	W-1	2.1 X 2.15	0.15	2.30	4.52	ALUMINUM SLIDING WINDOW	LIVING ROOM
3	W-1A	2.9 X 1.70	0.60	2.30	4.93	ALUMINUM SLIDING WINDOW	LIVING ROOM
4	W-2	1.8 X 2.15	0.15	2.30	3.87	ALUMINUM SLIDING WINDOW	BED ROOM
5	W-2A	1.8 X 1.70	0.60	2.30	3.06	ALUMINUM SLIDING WINDOW	BED ROOM
6	W-3	1.5 X 2.15	0.15	2.30	3.23	ALUMINUM SLIDING WINDOW	KITCHEN
7	V	0.85 X 1.76	0.54	2.30	1.50	LOUVERS VENTILATOR	TOILETS & DUCT
8	V1	0.75 X 0.95	1.35	2.30	0.81	LOUVERS VENTILATOR	TOILETS & DUCT
9	V2	0.75 X 0.95	1.35	2.30	0.62	LOUVERS VENTILATOR	DUCT

NOTE :-
1) HABITABLE ROOM INCLUDES BEDROOM & LIVING ROOM
2) REFUGE AREAS ARE PROVIDED AT MIDLANDING OF EVERY ALTERNATE FLOOR
3) ALL DIMENSIONS ARE IN METERS

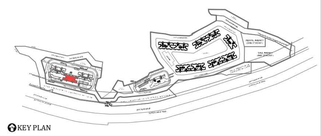

KEY PLAN

DESCRIPTION OF PROPOSAL & PROPERTY

PROPOSED DEVELOPMENT FOR RENTAL HOUSING SCHEME ON LAND BEARING S.NO:95/1(pt), 95/2(pt),95/3A(pt),98/1,98/2,98/3,98/4A,98/4/B,98/1,98/4/B/2,98/5(pt),98/7/3(pt),98/8,98/9, 98/10A,98/10B,99(pt),101/3,101/4/A,101/4/B,101/4/C,101/5,101/6,101/7,101/8A,101/8B,101/9, 101/10/A,101/10/B,102,103/1,103/2(pt),103/3,103/4,110/1A(pt),110/4,110/5A,110/6A,110/10, 110/11 at Village Kolkhe, Taluka - Panvel, District Raigad

NORTH	JOB. NO.	DRG. NO.	DRAWN BY
		14 / 25	-
	SCALE	DATE	CHECKED BY
	1: 100	-	-


REVISIONS	DESCRIPTION :	
R-0		

NAME OF THE OWNER


MANISH MADHU BATHIJA

M/S. PARADISE LIFESPACES LLP.
(P.O.A.H. of Shri. Esmail Ebrahim Dhariwala & others)

NAME & ADDRESS OF THE DESIGN ARCHITECT:	
NAME OF ARCHITECT	M/s. DIMENSION ARCHITECTS
LICENSE NO	CA/ /
ADDRESS	PLOT NO.99, NEAR SAGAR VIHAR, SECTOR-08, VASHI, NAVI MUMBAI 400 703
NAME OF ARCHITECT	DEVYANI KHADILKAR
LIC. NO	CA/90/13184
ADDRESS	B-106, Natraj Building, Mulund Goregaon Link Road Mulund (w), Mumbai - 400 080

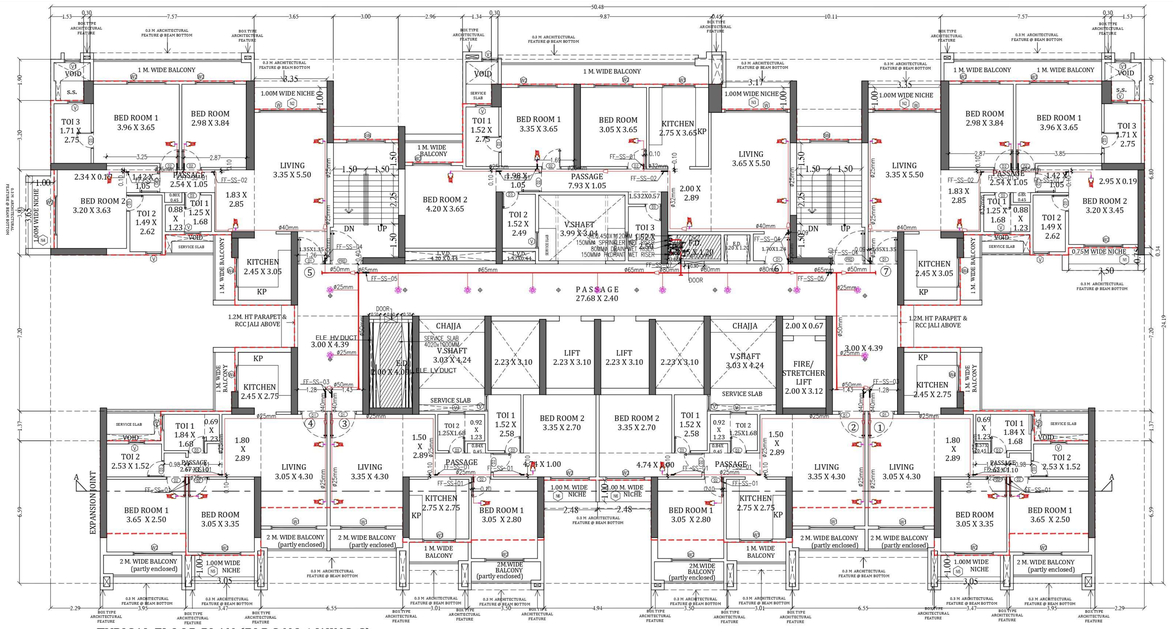

TYPICAL FLOOR PLAN (BLDG NO.1,WING-C)
(3rd, 4th, 5th, 6th, 8th,10th,12th,14th,16th,18th,20th,22nd,24th & 26th)
SCALE :- 1:100

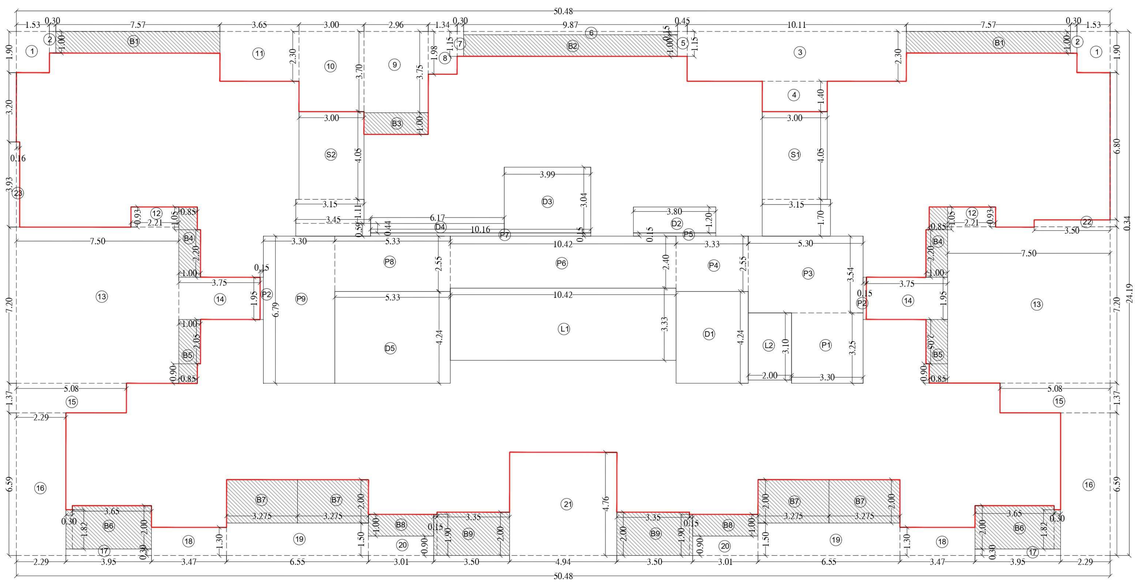

LINE DIAGRAM FOR TYPICAL FLOOR PLAN (BLDG NO.1,WING-C)
(3rd, 4th, 5th, 6th, 8th,10th,12th,14th,16th,18th,20th,22nd,24th & 26th) SCALE :- 1:100

BUILT UP AREA CALCULATION FOR TYPICAL FLOOR PLAN (BLDG NO.1, WING-C) (3rd, 4th, 5th, 6th, 8th,10th,12th,14th,16th,18th,20th,22nd,24th & 26th)

ADDITION (X)								
A	50.48	x	24.19	x	1	=	1221.11	SQ.MT.
TOTAL						=	**1221.11**	**SQ.MT.**
STANDARD DEDUCTION (Y1)								
1	1.53	x	1.00	x	2	=	5.81	SQ.MT.
2	0.300	x	1.00	x	2	=	0.600	SQ.MT.
3	10.11	x	2.30	x	1	=	23.25	SQ.MT.
4	3.00	x	1.40	x	1	=	4.20	SQ.MT.
5	0.450	x	1.15	x	1	=	0.518	SQ.MT.
6	9.870	x	0.15	x	1	=	1.481	SQ.MT.
7	0.300	x	1.15	x	1	=	0.345	SQ.MT.
8	1.34	x	1.98	x	1	=	2.65	SQ.MT.
9	2.96	x	3.75	x	1	=	11.10	SQ.MT.
10	3.00	x	3.70	x	1	=	11.10	SQ.MT.
11	3.65	x	2.30	x	1	=	8.40	SQ.MT.
12	2.21	x	0.93	x	2	=	4.11	SQ.MT.
13	7.50	x	7.20	x	2	=	108.00	SQ.MT.
14	3.75	x	1.95	x	2	=	14.63	SQ.MT.
15	5.08	x	1.37	x	2	=	13.92	SQ.MT.
16	2.29	x	6.59	x	2	=	30.18	SQ.MT.
17	3.95	x	0.30	x	2	=	2.370	SQ.MT.
18	3.47	x	1.30	x	2	=	9.02	SQ.MT.
19	6.550	x	1.50	x	2	=	19.650	SQ.MT.
20	3.01	x	0.90	x	2	=	5.42	SQ.MT.
21	4.940	x	4.76	x	1	=	23.514	SQ.MT.
22	3.50	x	0.34	x	1	=	1.190	SQ.MT.
23	0.16	x	3.93	x	1	=	0.629	SQ.MT.
B1	7.570	x	1.00	x	2	=	15.140	SQ.MT.
B2	9.870	x	1.00	x	1	=	9.870	SQ.MT.
B3	2.96	x	1.00	x	1	=	2.96	SQ.MT.
B4	0.85	x	1.05	x	2	=	1.79	SQ.MT.
"	1.00	x	2.20	x	2	=	4.40	SQ.MT.
B5	1.00	x	2.05	x	2	=	4.10	SQ.MT.
"	0.85	x	0.90	x	2	=	1.53	SQ.MT.
B6 (Encl)	3.65	x	2.00	x	2	=	14.60	SQ.MT.
"	0.30	x	1.82	x	2	=	1.09	SQ.MT.
B7 (Encl)	3.275	x	2.00	x	4	=	26.18	SQ.MT.
B8	3.01	x	1.00	x	2	=	6.02	SQ.MT.
B9 (Encl)	3.35	x	2.00	x	2	=	13.40	SQ.MT.
"	0.15	x	1.90	x	2	=	0.57	SQ.MT.
TOTAL						=	**403.73**	**SQ.MT.**
DUCT DEDUCTION (Y2)								
D1	3.33	x	4.24	x	1	=	14.12	SQ.MT.
D2	3.80	x	1.20	x	1	=	4.56	SQ.MT.
D3	3.99	x	3.04	x	1	=	12.13	SQ.MT.
D4	6.17	x	0.44	x	1	=	2.71	SQ.MT.
D5	5.33	x	4.24	x	1	=	22.60	SQ.MT.
TOTAL						=	**56.12**	**SQ.MT.**
STAIRCASE,LIFT,LIFT LOBBY DEDUCTION (Y3)								
S1	3.00	x	4.05	x	1	=	12.150	SQ.MT.
"	3.15	x	1.70	x	1	=	5.355	SQ.MT.
S2	3.00	x	4.05	x	1	=	12.15	SQ.MT.
"	3.15	x	1.11	x	1	=	3.497	SQ.MT.
"	3.45	x	0.59	x	1	=	2.036	SQ.MT.
L1	10.42	x	3.33	x	1	=	34.70	SQ.MT.
L2	2.00	x	3.10	x	1	=	6.20	SQ.MT.
TOTAL						=	**76.09**	**SQ.MT.**
PASSAGE DEDUCTION (Y4)								
P1	3.30	x	3.25	x	1	=	10.725	SQ.MT.
P2	0.15	x	1.95	x	2	=	0.585	SQ.MT.
P3	5.30	x	3.54	x	1	=	18.76	SQ.MT.
P4	3.33	x	2.55	x	1	=	8.49	SQ.MT.
P5	3.80	x	0.15	x	1	=	0.57	SQ.MT.
P6	10.42	x	2.40	x	1	=	25.01	SQ.MT.
P7	10.16	x	0.15	x	1	=	1.52	SQ.MT.
P8	5.33	x	2.55	x	1	=	13.59	SQ.MT.
P9	3.30	x	6.79	x	1	=	22.41	SQ.MT.
TOTAL						=	**101.66**	**SQ.MT.**
TOTAL DEDUCTION (Y5) (Y1+Y2+Y3+Y4)						=	**637.60**	SQ.MT.
TOTAL BUILT UP AREA (Y6) (X-Y5)						=	**583.51**	SQ.MT.
PERM. BALCONY (Y7) (Y6 x 10%)						=	**58.35**	**SQ.MT.**
BALCONY AREA STATEMENT								
B1	7.570	x	1.00	x	2	=	15.140	SQ.MT.
B2	9.870	x	1.00	x	1	=	9.870	SQ.MT.
B3	2.96	x	1.00	x	1	=	2.96	SQ.MT.
B4	0.85	x	1.05	x	2	=	1.79	SQ.MT.
"	1.00	x	2.20	x	2	=	4.40	SQ.MT.
B5	1.00	x	2.05	x	2	=	4.10	SQ.MT.
"	0.85	x	0.90	x	2	=	1.53	SQ.MT.
B6 (Encl)	3.65	x	2.00	x	2	=	14.60	SQ.MT.
"	0.30	x	1.82	x	2	=	1.09	SQ.MT.
B7 (Encl)	3.275	x	2.00	x	4	=	26.18	SQ.MT.
B8	3.01	x	1.00	x	2	=	6.020	SQ.MT.
B9 (Encl)	3.35	x	2.00	x	2	=	13.40	SQ.MT.
"	0.15	x	1.90	x	2	=	0.57	SQ.MT.
TOTAL (Y8)						=	**101.65**	**SQ.MT.**
EXCESS BALCONY (Y9) (Y8-Y7)						=	**43.30**	**SQ.MT.**
NET BUILT UP AREA (Y6+Y9)						=	**626.81**	**SQ.MT.**

NICHE AREA STATEMENT FOR BLDG 1 (WING C) (FOR TYPICAL FLOORS)

N1	3.50	x	0.75	x	1	=	2.63 SQ.MT.
N2	3.35	x	1.00	x	2	=	6.70 SQ.MT.
N3	3.17	x	1.00	x	1	=	3.17 SQ.MT.
N4	3.65	x	1.00	x	1	=	3.65 SQ.MT.
N5	3.05	x	1.00	x	2	=	6.10 SQ.MT.
N6	2.48	x	1.00	x	2	=	4.96 SQ.MT.
TOTAL AREA						=	**27.21 SQ.MT.**

CARPET AREA STATEMENT FOR TYPICAL FLOOR (BLDG NO.1,WING C)

FLAT NO. 1	=	55.90 SQ.MT.
FLAT NO. 2	=	60.07 SQ.MT.
FLAT NO. 3	=	60.07 SQ.MT.
FLAT NO. 4	=	55.90 SQ.MT.
FLAT NO. 5	=	87.59 SQ.MT.
FLAT NO. 6	=	98.95 SQ.MT.
FLAT NO.7	=	88.06 SQ.MT.

LIGHT AND VENTILATION STATEMENT (BLDG 1,WING C, FLAT NO 1 & 4)

ROOM	AREA OF ROOM (SQM)	AREA OF WIN REQ. (SQM)	AREA OF WIN	TYPE OF WINDOW
LIVING	18.320	3.053	4.520	W1
BED ROOM	10.220	1.703	3.060	W2A
BED ROOM 1	9.130	1.522	3.870	W2
KITCHEN	6.740	1.123	3.230	W3
TOILET 1	3.940	0.657	0.710	V
TOILET 2	3.850	0.642	0.710	V

LIGHT AND VENTILATION STATEMENT (BLDG 1,WING C, FLAT NO 2 & 3)

ROOM	AREA OF ROOM (SQM)	AREA OF WIN REQ. (SQM)	AREA OF WIN	TYPE OF WINDOW
LIVING	18.740	3.123	4.520	W1
BED ROOM 1	8.540	1.423	3.060	W2A
BED ROOM 2	13.780	2.297	3.870	W2
KITCHEN	7.560	1.260	3.230	W3
TOILET 1	3.920	0.653	0.710	V
TOILET 2	3.230	0.538	0.710	V

LIGHT AND VENTILATION STATEMENT (BLDG 1,WING C, FLAT NO 5 & 7)

ROOM	AREA OF ROOM (SQM)	AREA OF WIN REQ. (SQM)	AREA OF WIN	TYPE OF WINDOW
LIVING	25.460	4.243	4.930	W1A
BED ROOM	11.440	1.907	3.870	W2
BED ROOM 1	14.450	2.408	3.870	W2
BED ROOM 2	13.090	2.182	3.060	W2A
KITCHEN	7.470	1.245	3.230	W3
TOILET 1	3.180	0.530	0.710	V
TOILET 2	3.900	0.650	0.710	V
TOILET 3	4.700	0.783	0.810	V1

LIGHT AND VENTILATION STATEMENT (BLDG 1,WING C , FLAT NO 6)

ROOM	AREA OF ROOM (SQM)	AREA OF WIN REQ. (SQM)	AREA OF WIN	TYPE OF WINDOW
LIVING	27.960	4.660	4.930	W1A
BED ROOM	11.130	1.855	3.870	W2
BED ROOM 1	12.230	2.038	3.870	W2
BED ROOM 2	17.410	2.902	3.870	W2
KITCHEN	10.040	1.673	3.230	W3
TOILET 1	4.150	0.692	0.710	V
TOILET 2	3.780	0.630	0.710	V
TOILET 3	3.800	0.633	0.710	V

(BLDG NO.1,WING-C) | 15 / 25

CONTENTS OF SHEET

TYPICAL FLOOR PLAN & CALCULATION

STAMP AND DATE OF APPROVAL OF PLAN

PART OC

This Part Occupancy Certificate is issued for Sale Building no 1 (A ,B ,C) (Till 26th Floor) & Building no 2 (Till 30th Floor), and As Built drawing is approved subject to conditions as mentioned in Part Occupancy Certificate bearing no. NAINA/6529/2021-CIDCO/NAINA/PANVEL/Kolkhe/ BP- 00112/Part/ OC/ 2022/ 0217A. Dated 24.06.2022.

RAJA BHAGUJI WAGHMARE

Digitally signed by RAJA BHAGUJI WAGHMARE
Date: 2022.06.24 19:42:22 +05'30'


DOOR SCHEDULE

Sr.NO.	D.NO	SIZE	LINTEL LVL.	DESCRIPTION	REMARK
1.	F/ND	1.5 X 2.30	2.30	FIRE RESISTANT DOOR	STAIRCASE
2	D-1	1.2 X 2.30	2.30	T.W FRAME WITH W.P FLUSH DOOR	MAIN DOOR
3.	D-2	0.9 X 2.30	2.30	T.W FRAME WITH W.P FLUSH DOOR	BED ROOM
4.	D-3	0.75 X 2.30	2.30	MARBLE/GRANITE FRAME WITH FRP DOOR	TOILET

WINDOW SCHEDULE

Sr.NO	W.NO	SIZE	SILL LVL	LINTEL LVL	AREA (IN SQ.MT.)	DESCRIPTION	REMARK
1	SW-1	2.0 X 2.15	0.15	2.30	4.30	RAILING / FIXED GLASS WINDOW	STAIRCASE
2	W-1	2.1 X 2.15	0.15	2.30	4.52	ALUMINIUM SLIDING WINDOW	LIVING ROOM
3	W-1A	2.9 X 1.70	0.60	2.30	4.93	ALUMINIUM SLIDING WINDOW	LIVING ROOM
4	W-2	1.8 X 2.15	0.15	2.30	3.87	ALUMINIUM SLIDING WINDOW	BED ROOM
5	W-2A	1.8 X 1.70	0.60	2.30	3.06	ALUMINIUM SLIDING WINDOW	BED ROOM
6	W-3	1.5 X 2.15	0.15	2.30	3.23	ALUMINIUM SLIDING WINDOW	KITCHEN
7	V	0.65 X 1.76	0.54	2.30	1.50	LOUVERS VENTILATOR	TOILETS & DUCT
8	V1	0.75 X 0.95	1.35	2.30	0.81	LOUVERS VENTILATOR	TOILETS & DUCT
9	V2	0.75 X 0.95	1.35	2.30	0.62	LOUVERS VENTILATOR	DUCT

NOTE :-
1) HABITABLE ROOM INCLUDES BEDROOM & LIVING ROOM
2) REFUGE AREAS ARE PROVIDED AT MIDLANDING OF EVERY ALTERNATE FLOOR
3) ALL DIMENSIONS ARE IN METERS

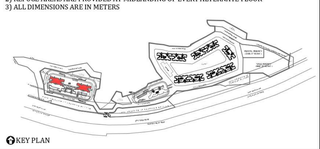

KEY PLAN

DESCRIPTION OF PROPOSAL & PROPERTY

PROPOSED DEVELOPMENT FOR RENTAL HOUSING SCHEME ON LAND BEARING S.NO.95/1(pt), 95/2(pt),95/3A(pt),98/1,98/2,98/3,98/4A,98/4/B/1,98/4/B/2,98/5(pt),98/7/2(pt),98/8,98/9, 98/10A,98/10B,98(pt),101/3,101/4/A,101/4/B,101/4/C,101/5,101/6,101/7,101/8A,101/8B,101/9, 101/10/A,101/10/B,102,103/1,103/2(pt),103/3,103/4,110/1A(pt),110/4,110/5A,110/6A,110/10, 110/11 at Village Kolkhe, Taluka - Panvel, District Raigad


NORTH	JOB. NO.	DRG. NO.	DRAWN BY
		15 / 25	-
	SCALE	DATE	CHECKED BY
	1: 100	-	-
REVISIONS	DESCRIPTION :		
R-0			
NAME OF THE OWNER			

MANISH MADHU BATHIJA


M/S. PARADISE LIFESPACES LLP.
(P.O.A.H. of Shri. Esmail Ebrahim Dhariwala & others)

NAME & ADDRESS OF THE DESIGN ARCHITECT:

NAME OF ARCHITECT	M/s. DIMENSION ARCHITECTS
LICENSE NO	CA/ /
ADDRESS	PLOT NO.99, NEAR SAGAR VIHAR, SECTOR-08, VASHI, NAVI MUMBAI 400 703
NAME OF ARCHITECT	DEVYANI KHADILKAR
LIC. NO	CA/90/13184
ADDRESS	B-106, Natraj Building, Mulund Goregaon Link Road Mulund (w), Mumbai : 400 080

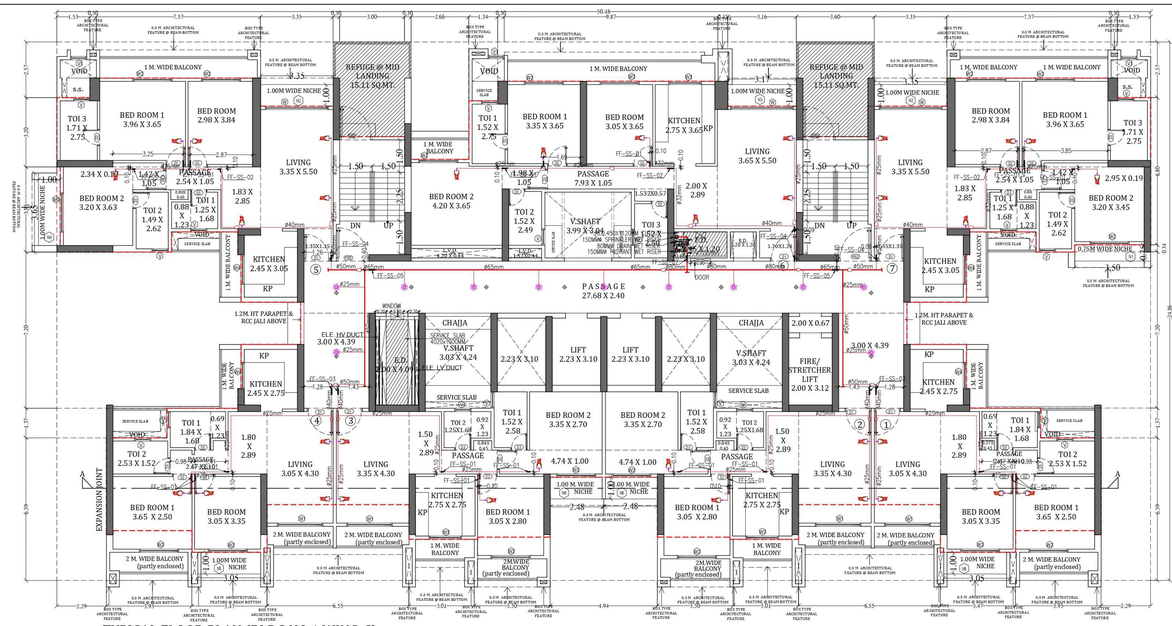

TYPICAL FLOOR PLAN (BLDG NO.1,WING-C)
(7th, 9th,11th,13th,15th,17th,19th,21st,23rd & 25th)
SCALE :- 1:100

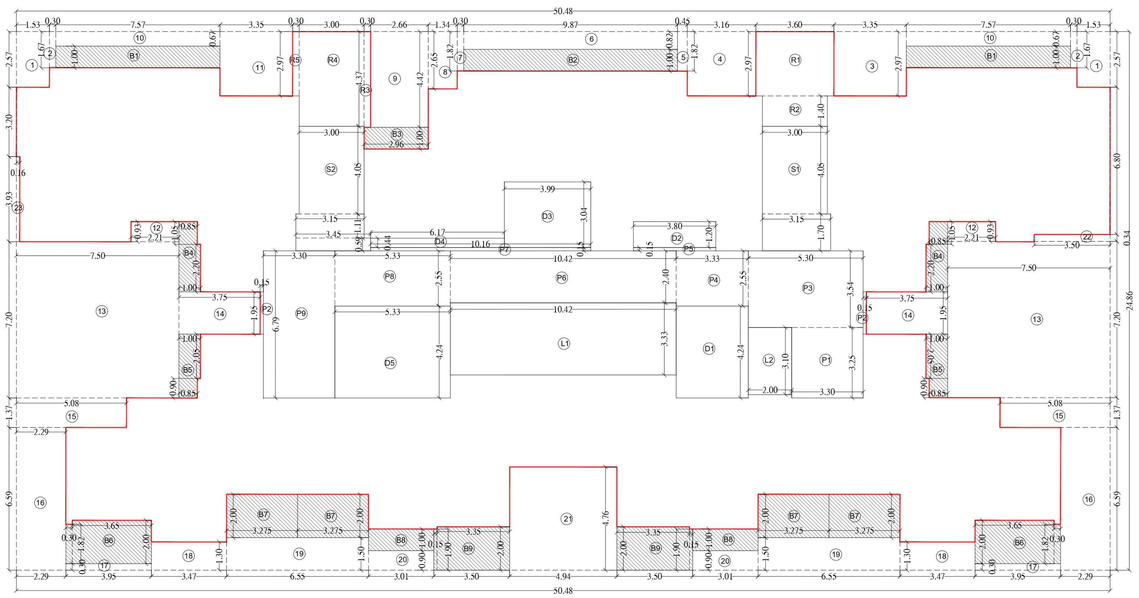

LINE DIAGRAM FOR TYPICAL REFUGE FLOOR PLAN (BLDG NO.1,WING-C)
(7th, 9th,11th,13th,15th,17th,19th,21st,23rd & 25th) SCALE :- 1:100

BUILT UP AREA CALCULATION FOR TYPICAL FLOOR PLAN (BLDG NO.1, WING-C)
(7TH, 9th, 11th, 13th, 15th, 17th, 19th, 21st, 23rd & 25th)

ADDITION (X)								
A	50.48	x	24.86	x	1	=	1254.93	SQ.MT.
TOTAL						=	**1254.93**	**SQ.MT.**
STANDARD DEDUCTION (Y1)								
1	1.53	x	2.57	x	2	=	7.860	SQ.MT.
2	0.300	x	1.67	x	2	=	1.002	SQ.MT.
3	3.35	x	2.97	x	1	=	9.950	SQ.MT.
4	3.16	x	2.97	x	1	=	9.382	SQ.MT.
5	0.450	x	1.82	x	1	=	0.819	SQ.MT.
6	9.870	x	0.82	x	1	=	8.093	SQ.MT.
7	0.300	x	1.82	x	1	=	0.546	SQ.MT.
8	1.34	x	2.65	x	1	=	3.55	SQ.MT.
9	2.66	x	4.42	x	1	=	11.76	SQ.MT.
10	7.57	x	0.67	x	2	=	10.14	SQ.MT.
11	3.35	x	2.97	x	1	=	9.95	SQ.MT.
12	2.21	x	0.93	x	2	=	4.11	SQ.MT.
13	7.50	x	7.20	x	2	=	108.00	SQ.MT.
14	3.75	x	1.95	x	2	=	14.63	SQ.MT.
15	5.08	x	1.37	x	2	=	13.92	SQ.MT.
16	2.29	x	6.59	x	2	=	30.18	SQ.MT.
17	3.95	x	0.300	x	2	=	2.370	SQ.MT.
18	3.47	x	1.30	x	2	=	9.02	SQ.MT.
19	6.550	x	1.50	x	2	=	19.650	SQ.MT.
20	3.01	x	0.90	x	2	=	5.42	SQ.MT.
21	4.940	x	4.76	x	1	=	23.514	SQ.MT.
22	3.50	x	0.340	x	1	=	1.190	SQ.MT.
23	0.16	x	3.930	x	1	=	0.629	SQ.MT.
B1	7.570	x	1.00	x	2	=	15.140	SQ.MT.
B2	9.870	x	1.00	x	1	=	9.870	SQ.MT.
B3	2.96	x	1.00	x	1	=	2.96	SQ.MT.
B4	0.85	x	1.05	x	2	=	1.79	SQ.MT.
"	1.00	x	2.20	x	2	=	4.40	SQ.MT.
B5	1.00	x	2.05	x	2	=	4.10	SQ.MT.
"	0.85	x	0.90	x	2	=	1.53	SQ.MT.
B6 (Encl)	3.65	x	2.00	x	2	=	14.60	SQ.MT.
"	0.30	x	1.82	x	2	=	1.09	SQ.MT.
B7 (Encl)	3.275	x	2.00	x	4	=	26.18	SQ.MT.
B8	3.01	x	1.00	x	2	=	6.02	SQ.MT.
B9 (Encl)	3.35	x	2.00	x	2	=	13.40	SQ.MT.
"	0.15	x	1.90	x	2	=	0.57	SQ.MT.
TOTAL						=	**407.34**	**SQ.MT.**
DUCT DEDUCTION (Y2)								
D1	3.33	x	4.24	x	1	=	14.12	SQ.MT.
D2	3.80	x	1.20	x	1	=	4.56	SQ.MT.
D3	3.99	x	3.04	x	1	=	12.13	SQ.MT.
D4	6.17	x	0.44	x	1	=	2.71	SQ.MT.
D5	5.33	x	4.24	x	1	=	22.60	SQ.MT.
TOTAL						=	**56.12**	**SQ.MT.**
STAIRCASE,LIFT,LIFT LOBBY DEDUCTION (Y3)								
S1	3.00	x	4.05	x	1	=	12.150	SQ.MT.
"	3.15	x	1.70	x	1	=	5.355	SQ.MT.
S2	3.00	x	4.05	x	1	=	12.15	SQ.MT.
"	3.15	x	1.11	x	1	=	3.497	SQ.MT.
"	3.45	x	0.59	x	1	=	2.036	SQ.MT.
L1	10.42	x	3.33	x	1	=	34.70	SQ.MT.
L2	2.00	x	3.10	x	1	=	6.20	SQ.MT.
TOTAL						=	**76.09**	**SQ.MT.**
PASSAGE DEDUCTION (Y4)								
P1	3.30	x	3.25	x	1	=	10.725	SQ.MT.
P2	0.15	x	1.95	x	2	=	0.585	SQ.MT.
P3	5.30	x	3.54	x	1	=	18.76	SQ.MT.
P4	3.33	x	2.55	x	1	=	8.49	SQ.MT.
P5	3.80	x	0.15	x	1	=	0.57	SQ.MT.
P6	10.42	x	2.40	x	1	=	25.01	SQ.MT.
P7	10.16	x	0.15	x	1	=	1.52	SQ.MT.
P8	5.33	x	2.55	x	1	=	13.59	SQ.MT.
P9	3.30	x	6.79	x	1	=	22.41	SQ.MT.
TOTAL						=	**101.66**	**SQ.MT.**
REFUGE DEDUCTION (Y5) @ MIDLANDING OF STAIRCASE								
R1	3.60	x	2.97	x	1	=	10.69	SQ.MT.
R2	3.00	x	1.40	x	1	=	4.20	SQ.MT.
R3	0.30	x	4.42	x	1	=	1.33	SQ.MT.
R4	3.00	x	4.37	x	1	=	13.11	SQ.MT.
R5	0.30	x	2.97	x	1	=	0.89	SQ.MT.
TOTAL						=	**30.22**	**SQ.MT.**
REFUGE REQUIRED (Y6)						=	**21.00**	SQ.MT.
TOTAL DEDUCTION (Y7) (Y1+Y2+Y3+Y4+Y5)						=	**671.42**	SQ.MT.
TOTAL BUILT UP AREA (Y8) (X-Y7)						=	**583.51**	SQ.MT.
EXCESS REFUGE AREA (Y9) (Y5-Y6)						=	**9.22**	SQ.MT.
PERM. BALCONY (Y10) (Y8 x 10%)						=	**58.35**	**SQ.MT.**
BALCONY AREA STATEMENT								
B1	7.570	x	1.00	x	2	=	15.140	SQ.MT.
B2	9.870	x	1.00	x	1	=	9.870	SQ.MT.
B3	2.96	x	1.00	x	1	=	2.96	SQ.MT.
B4	0.85	x	1.05	x	2	=	1.79	SQ.MT.
"	1.00	x	2.20	x	2	=	4.40	SQ.MT.
B5	1.00	x	2.05	x	2	=	4.10	SQ.MT.
"	0.85	x	0.90	x	2	=	1.53	SQ.MT.
B6 (Encl)	3.65	x	2.00	x	2	=	14.60	SQ.MT.
"	0.30	x	1.82	x	2	=	1.09	SQ.MT.
B7 (Encl)	3.275	x	2.00	x	4	=	26.18	SQ.MT.
B8	3.01	x	1.00	x	2	=	6.02	SQ.MT.
B9 (Encl)	3.35	x	2.00	x	2	=	13.40	SQ.MT.
"	0.15	x	1.90	x	2	=	0.57	SQ.MT.
TOTAL (Y11)						=	**101.65**	**SQ.MT.**
EXCESS BALCONY (Y12) (Y11-Y10)						=	**43.30**	**SQ.MT.**
NET BUILT UP AREA (Y8+Y9+Y12)						=	**636.03**	**SQ.MT.**

REFUGE AREA STATEMENT

REFUGE AREA REQ. AT MIDLANDING OF STAIRCASE 7TH,9TH,11TH,13TH,15TH,17TH,19TH,21ST,23RD,25TH & 27TH (BLDG NO.1,WING - C)	TOTAL NO. OF PERSON ABOVE FLOORS			
	NO OF FLAT	X	FLOORS	TOTAL
3RD,4TH,5TH,6TH,8TH,10TH,12TH,14TH, 16TH,18TH,20TH,22ND,24TH & 26TH TYPICAL FLOOR	7.00	X	1.00	7
7TH,9TH,11TH,13TH,15TH,17TH,19TH,21ST,23RD,25TH & 27TH REFUGE FLOOR	7.00	X	1.00	7
TOTAL NO. OF FLAT				14
NO. OF PERSON PER FLAT				5
TOTAL PERSON				70
REQ. 0.3 SQ.MTS. PER PERSON				0.3
TOTAL REQ. REFUGE AREA				21.00
TOTAL PROVIDED REFUGE AREA				30.22

LIGHT AND VENTILATION STATEMENT (BLDG 1,WING C, FLAT NO 1 & 4)

ROOM	AREA OF ROOM (SQM)	AREA OF WIN REQ. (SQM)	AREA OF WIN	TYPE OF WINDOW
LIVING	18.320	3.053	4.520	W1
BED ROOM	10.220	1.703	3.060	W2A
BED ROOM 1	9.130	1.522	3.870	W2
KITCHEN	6.740	1.123	3.230	W3
TOILET 1	3.940	0.657	0.710	V
TOILET 2	3.850	0.642	0.710	V

LIGHT AND VENTILATION STATEMENT (BLDG 1,WING C, FLAT NO 2 & 3)

ROOM	AREA OF ROOM (SQM)	AREA OF WIN REQ. (SQM)	AREA OF WIN	TYPE OF WINDOW
LIVING	18.740	3.123	4.520	W1
BED ROOM 1	8.540	1.423	3.060	W2A
BED ROOM 2	13.780	2.297	3.870	W2
KITCHEN	7.560	1.260	3.230	W3
TOILET 1	3.920	0.653	0.710	V
TOILET 2	3.230	0.538	0.710	V

LIGHT AND VENTILATION STATEMENT (BLDG 1,WING C, FLAT NO 5 & 7)

ROOM	AREA OF ROOM (SQM)	AREA OF WIN REQ. (SQM)	AREA OF WIN	TYPE OF WINDOW
LIVING	25.460	4.243	4.930	W1A
BED ROOM	11.440	1.907	3.870	W2
BED ROOM 1	14.450	2.408	3.870	W2
BED ROOM 2	13.060	2.162	3.060	W2A
KITCHEN	7.470	1.245	3.230	W3
TOILET 1	3.180	0.530	0.710	V
TOILET 2	3.900	0.650	0.710	V
TOILET 3	4.700	0.783	0.810	V1

LIGHT AND VENTILATION STATEMENT (BLDG 1,WING C , FLAT NO 6)

ROOM	AREA OF ROOM (SQM)	AREA OF WIN REQ. (SQM)	AREA OF WIN	TYPE OF WINDOW
LIVING	27.960	4.660	4.930	W1A
BED ROOM	11.130	1.855	3.870	W2
BED ROOM 1	12.230	2.038	3.870	W2
BED ROOM 2	17.410	2.902	3.870	W2
KITCHEN	10.040	1.673	3.230	W3
TOILET 1	4.180	0.697	0.710	V
TOILET 2	3.780	0.630	0.710	V
TOILET 3	3.800	0.633	0.710	V

(BLDG NO.1,WING- C) | 16 / 25

CONTENTS OF SHEET

TYPICAL REFUGE FLOOR PLAN & CALCULATION

STAMP AND DATE OF APPROVAL OF PLAN

PART OC

This Part Occupancy Certificate is issued for Sale Building no 1 (A ,B ,C) (Till 26th Floor) & Building no 2 (Till 30th Floor), and As Built drawing is approved subject to conditions as mentioned in Part Occupancy Certificate bearing no. NAINA/6529/2021-CIDCO/NAINA/PANVEL/Kolkhe/ BP- 00112/Part/ OC/ 2022/ 0217A. Dated 24.06.2022.

RAJA BHAGUJI WAGHMARE

Digitally signed by RAJA BHAGUJI WAGHMARE
Date: 2022.06.24 19:43:04 +05'30'


DOOR SCHEDULE

Sr.NO.	D.NO.	SIZE	LEVEL ADJ.	DESCRIPTION	REMARK
1.	FRD	1.5 X 2.30	2.30	FIRE RESISTANT DOOR	STAIRCASE
2.	D-1	1.2 X 2.30	2.30	T.W FRAME WITH W.P FLUSH DOOR	MAIN DOOR
3.	D-2	0.9 X 2.30	2.30	T.W FRAME WITH W.P FLUSH DOOR	BED ROOM
4.	D-3	0.75 X 2.30	2.30	MARBLE/GRANITE FRAME WITH FRP DOOR	TOILET

WINDOW SCHEDULE

Sr.NO.	W.NO.	SIZE	SILL LVL	LINTEL LVL	AREA (R.S.M.F.)	DESCRIPTION	REMARK
1	SW-1	2.0 X 2.15	0.15	2.30	4.30	RAILING / FIXED GLASS WINDOW	STAIRCASE
2	W-1	2.1 X 2.15	0.15	2.30	4.52	ALUMINIUM SLIDING WINDOW	LIVING ROOM
3	W-1A	2.9 X 1.70	0.60	2.30	4.93	ALUMINIUM SLIDING WINDOW	LIVING ROOM
4	W-2	1.8 X 2.15	0.15	2.30	3.87	ALUMINIUM SLIDING WINDOW	BED ROOM
5	W-2A	1.8 X 1.70	0.60	2.30	3.06	ALUMINIUM SLIDING WINDOW	BED ROOM
6	W-3	1.5 X 2.15	0.15	2.30	3.23	ALUMINIUM SLIDING WINDOW	KITCHEN
7	V	0.85 X 1.76	0.54	2.30	1.50	LOUVERS VENTILATOR	TOILETS & DUCT
8	V1	0.75 X 0.95	1.35	2.30	0.81	LOUVERS VENTILATOR	TOILETS & DUCT
9	V2	0.75 X 0.95	1.35	2.30	0.62	LOUVERS VENTILATOR	DUCT

NOTE :-
1) HABITABLE ROOM INCLUDES BEDROOM & LIVING ROOM
2) REFUGE AREAS ARE PROVIDED AT MIDLANDING OF EVERY ALTERNATE FLOOR
3) ALL DIMENSIONS ARE IN METERS

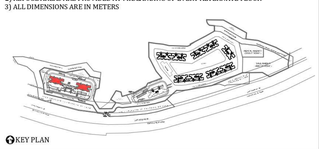

KEY PLAN

DESCRIPTION OF PROPOSAL & PROPERTY

PROPOSED DEVELOPMENT FOR RENTAL HOUSING SCHEME ON LAND BEARING S.NO.95/1(pt), 95/2(pt),95/3A(pt),98/1,98/2,98/3,98/4A,98/4/B/1,98/4/B/2,98/5(pt),98/7/3(pt),98/8,98/9, 98/10A,98/10B,98/9(pt),101/3,101/4/A,101/4/B,101/4/C,101/5,101/6,101/7,101/8A,101/8B,101/9, 101/10/A,101/10/B,102,103/1,103/2(pt),103/3,103/4,110/1A(pt),110/4,110/5A,110/6A,110/10, 110/11 at Village Kolkhe, Taluka - Panvel, District Raigad


NORTH	JOB. NO.	DRG. NO.	DRAWN BY
		16 / 25	-
	SCALE	DATE	CHECKED BY
	1: 100	-	-
REVISIONS	DESCRIPTION :		
R-0			
NAME OF THE OWNER			

MANISH MADHU BATHIJA


M/S. PARADISE LIFESPACES LLP.
(P.O.A.H. of Shri. Esmail Ebrahim Dhariwala & others)

NAME & ADDRESS OF THE DESIGN ARCHITECT:

NAME OF ARCHITECT	M/s. DIMENSION ARCHITECTS
LICENSE NO	CA/ /
ADDRESS	PLOT NO.99, NEAR SAGAR VIHAR, SECTOR-08, VASHI, NAVI MUMBAI 400 703
NAME OF ARCHITECT	DEVYANI KHADILKAR
LIC. NO	CA/90/13184
ADDRESS	B-106, Natraj Building, Mulund Goregaon Link Road Mulund (w), Mumbai : 400 080

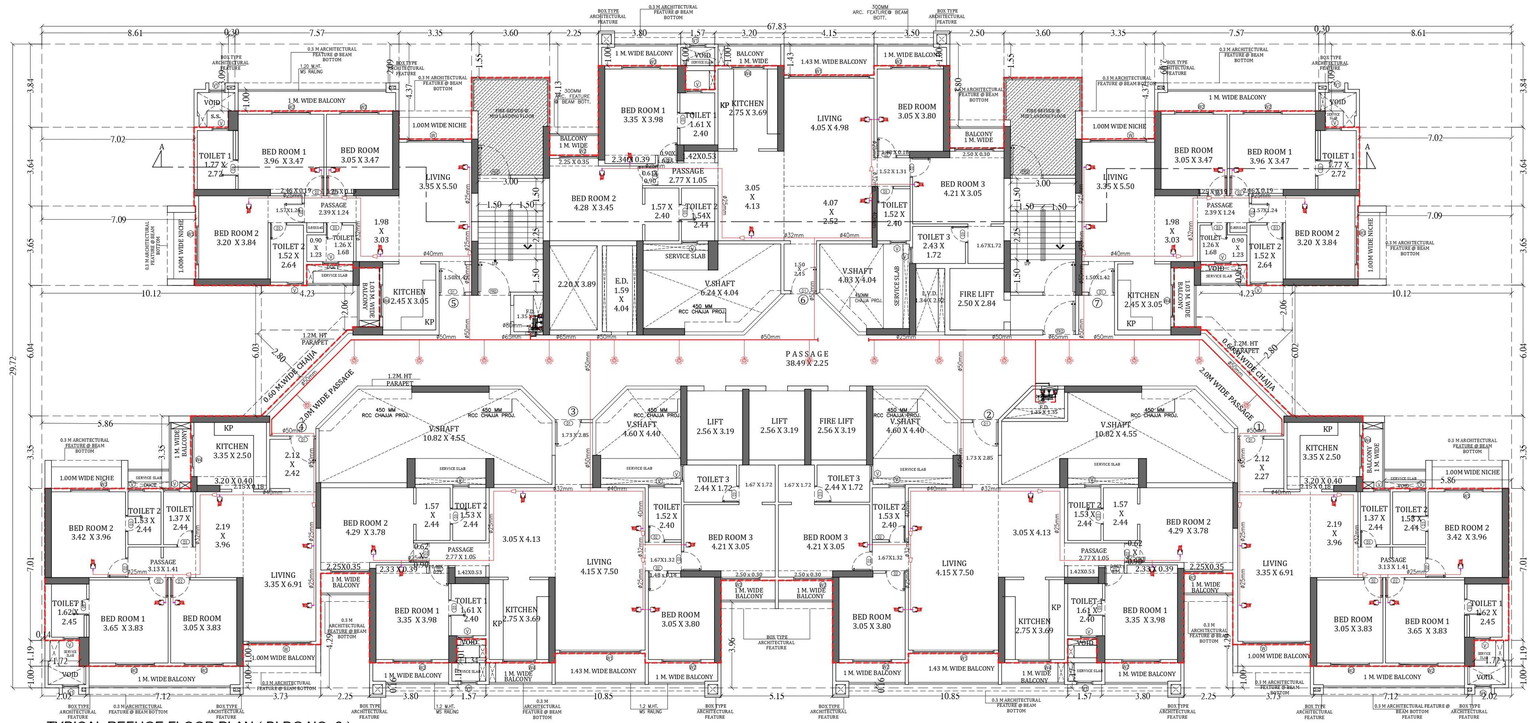

TYPICAL REFUGE FLOOR PLAN (BLDG NO. 2)
(7th, 9th,11th,13th,15th,17th,19th,21st,23rd,25th,27th & 29th)
SCALE :- 1:100

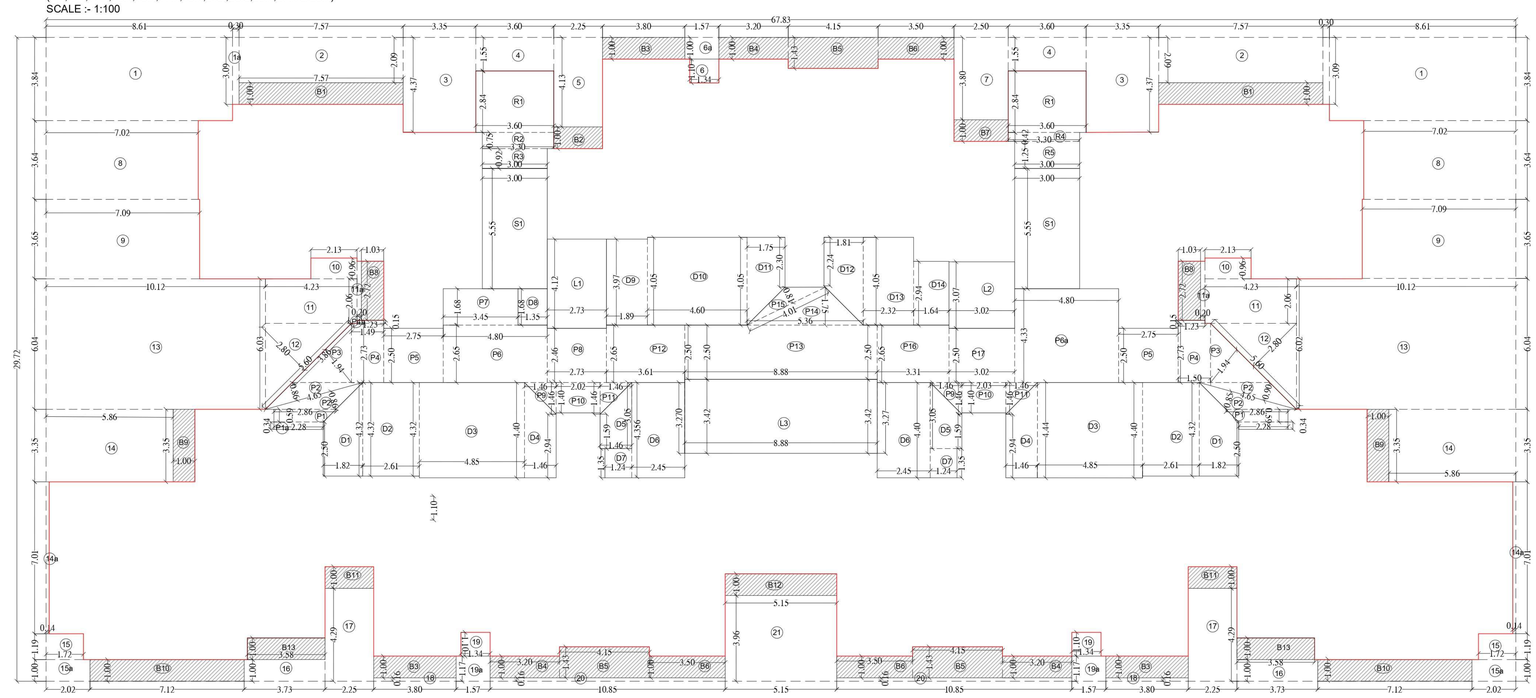

LINE DIAGRAM FOR TYPICAL REFUGE FLOOR PLAN (BLDG NO. 2)
(7th, 9th,11th,13th,15th,17th,19th,21st,23rd,25th,27th & 29th)
SCALE :- 1:100

LIGHT AND VENTILATION STATEMENT (BLDG 2, FLAT NO 1 & 4)

ROOM	AREA OF ROOM (SQM)	AREA OF WIN REQ. (SQM)	AREA OF WIN PROV.(SQM)	TYPE OF WINDOW PROVD.
LIVING	36.970	6.162	6.230	W1B
BED ROOM	11.680	1.947	3.870	W2
BED ROOM 1	13.970	2.328	3.870	W2
BED ROOM 2	13.540	2.257	3.060	W2A
KITCHEN	10.050	1.675	3.225	W3
TOILET	3.340	0.557	0.720	V
TOILET 1	3.960	0.660	0.720	V
TOILET 2	3.730	0.622	0.720	V

LIGHT AND VENTILATION STATEMENT (BLDG 2,FLAT NO 2 & 3)

ROOM	AREA OF ROOM (SQM)	AREA OF WIN REQ. (SQM)	AREA OF WIN PROV.(SQM)	TYPE OF WINDOW PROVD.
LIVING	45.970	7.662	8.060	W
BED ROOM	11.590	1.932	3.870	W2
BED ROOM 1	14.460	2.410	3.870	W2
BED ROOM 2	20.230	3.372	3.870	W2
BED ROOM 3	16.580	2.763	3.870	W2
KITCHEN	10.140	1.690	3.225	W3
TOILET	3.670	0.612	0.720	V
TOILET 1	3.860	0.643	0.720	V
TOILET 2	3.730	0.622	0.720	V
TOILET 3	4.190	0.698	0.720	V

LIGHT AND VENTILATION STATEMENT (BLDG 2, FLAT NO 5 & 7)

ROOM	AREA OF ROOM (SQM)	AREA OF WIN REQ. (SQM)	AREA OF WIN PROV.(SQM)	TYPE OF WINDOW PROVD.
LIVING	26.550	4.425	4.420	W1A
BED ROOM	10.810	1.802	3.870	W2
BED ROOM 1	14.180	2.363	3.870	W2
BED ROOM 2	14.210	2.368	3.060	W2A
KITCHEN	7.470	1.245	3.225	W3
TOILET	3.230	0.538	0.720	V
TOILET 1	4.810	0.802	0.860	V1
TOILET 2	2.490	0.415	0.720	V

LIGHT AND VENTILATION STATEMENT (BLDG 2, FLAT NO 6)

ROOM	AREA OF ROOM (SQM)	AREA OF WIN REQ. (SQM)	AREA OF WIN PROV.(SQM)	TYPE OF WINDOW PROVD.
LIVING	46.820	7.803	8.060	W
BED ROOM	11.880	1.980	3.870	W2
BED ROOM 1	14.460	2.410	3.870	W2
BED ROOM 2	20.230	3.372	3.870	W2
BED ROOM 3	16.460	2.743	3.870	W2
KITCHEN	10.140	1.690	3.225	W3
TOILET	3.640	0.607	0.720	V
TOILET 1	3.860	0.643	0.720	V
TOILET 2	3.750	0.625	0.720	V
TOILET 3	4.170	0.695	0.720	V

REFUGE AREA STATEMENT

REFUGE AREA REQ. AT (7th,9th,11th,13th,15th,17th,19th,21st, 23rd,25th,27th & 29th) (BLDG NO.2)	TOTAL NO. OF PERSON ABOVE FLOORS			
	NO OF FLAT	X	FLOORS	TOTAL
(7th,9th,11th,13th,15th,17th,19th,21st, 23rd,25th,27th & 29th)-TYPICAL REFUGE FLOOR	7.00	X	1.00	7
(4th,5th,6th,8th,10th,12th,14th,16th, 18th,20th,22nd,24th,26th,28th & 30th) TYPICAL FLOOR	7.00	X	1.00	7
TOTAL NO. OF FLAT				14
NO. OF PERSON PER FLAT				5
TOTAL PERSON				70
REQ. 0.3 SQ.MTS. PER PERSON				0.3
TOTAL REQ. REFUGE AREA				21.00
TOTAL PROVIDED REFUGE AREA				30.82

BUILT UP AREA CALCULATION FOR TYPICAL FLOOR PLAN (7TH,9TH,11TH,13TH,15TH,17TH,19TH,21ST,23RD,25TH,27TH,29 TH)

ADDITION (X)										
A	67.83	x	29.72	x	1	1	1	=	2015.91	SQ.MT.
TOTAL								=	**2015.91**	**SQ.MT.**
STANDARD DEDUCTION (Y1)										
1	8.61	x	3.84	x	1	X	2	=	66.16	SQ.MT.
1a	0.30	x	3.09	x	1	X	2	=	1.88	SQ.MT.
2	7.57	x	2.09	x	1	X	2	=	31.66	SQ.MT.
3	3.35	x	4.37	x	1	X	2	=	29.31	SQ.MT.
4	3.60	x	1.55	x	1	X	2	=	11.14	SQ.MT.
5	2.25	x	4.13	x	1	X	1	=	9.27	SQ.MT.
6	1.34	x	1.10	x	1	X	1	=	1.48	SQ.MT.
6a	1.57	x	1.00	x	1	X	1	=	1.57	SQ.MT.
7	2.50	x	3.80	x	1	X	1	=	9.48	SQ.MT.
8	7.02	x	3.64	x	1	X	2	=	51.13	SQ.MT.
9	7.09	x	3.65	x	1	X	2	=	51.79	SQ.MT.
10	2.13	x	0.96	x	1	X	2	=	4.10	SQ.MT.
11	4.23	x	2.06	x	1	X	2	=	17.44	SQ.MT.
11a	0.20	x	2.72	x	1	X	2	=	1.09	SQ.MT.
12	5.60	x	2.80	x	0.5	X	2	=	15.69	SQ.MT.
13	10.12	x	6.04	x	1	X	2	=	122.30	SQ.MT.
14	5.86	x	3.35	x	1	X	2	=	39.29	SQ.MT.
14a	0.14	x	7.01	x	1	X	2	=	2.02	SQ.MT.
15	1.72	x	1.19	x	1	X	2	=	4.10	SQ.MT.
15a	2.02	x	1.00	x	1	X	2	=	4.05	SQ.MT.
16	3.73	x	1.00	x	1	X	2	=	7.47	SQ.MT.
17	2.25	x	4.29	x	1	X	2	=	19.34	SQ.MT.
18	3.80	x	0.16	x	1	X	2	=	1.22	SQ.MT.
19	1.34	x	1.10	x	1	X	2	=	2.96	SQ.MT.
19a	1.57	x	1.17	x	1	X	2	=	3.68	SQ.MT.
20	10.85	x	0.16	x	1	X	2	=	3.47	SQ.MT.
21	5.15	x	3.96	x	1	X	1	=	20.41	SQ.MT.
B1	7.57	x	1.00	x	1	X	2	=	15.15	SQ.MT.
B2	2.25	x	1.00	x	1	X	1	=	2.25	SQ.MT.
B3	3.80	x	1.00	x	1	X	3	=	11.40	SQ.MT.
B4	3.20	x	1.00	x	1	X	3	=	9.60	SQ.MT.
B5	4.15	x	1.43	x	1	X	3	=	17.80	SQ.MT.
B6	3.50	x	1.00	x	1	X	3	=	10.50	SQ.MT.
B7	2.50	x	1.00	x	1	X	1	=	2.50	SQ.MT.
B8	1.03	x	2.72	x	1	X	2	=	5.60	SQ.MT.
B9	1.00	x	3.35	x	1	X	2	=	6.70	SQ.MT.
B10	7.12	x	1.00	x	1	X	2	=	14.24	SQ.MT.
B11	2.25	x	1.00	x	1	X	2	=	4.50	SQ.MT.
B12	5.15	x	1.00	x	1	X	1	=	5.15	SQ.MT.
B13	3.58	x	1.00	x	1	X	2	=	7.16	SQ.MT.
TOTAL								=	**646.06**	**SQ.MT.**
DUCT DEDUCTION (Y2)										
D1	1.82	x	(2.5 + 4.32)	x	0.50	x	2	=	12.41	SQ.MT.
D2	4.61	x	4.32	x	1	X	2	=	22.55	SQ.MT.
D3	4.85	x	4.40	x	1	X	2	=	42.68	SQ.MT.
D4	1.46	x	(4.4 + 2.94)	x	0.50	x	2	=	10.72	SQ.MT.
D5	1.46	x	(1.59 + 3.05)	x	0.50	x	2	=	6.77	SQ.MT.
D6	2.45	x	4.40	x	1	X	2	=	21.56	SQ.MT.
D7	1.24	x	1.35	x	1	X	2	=	3.35	SQ.MT.
D8	1.35	x	1.68	x	1	X	1	=	2.27	SQ.MT.
D9	1.89	x	3.97	x	1	X	1	=	7.50	SQ.MT.
D10	4.60	x	4.05	x	1	X	1	=	18.63	SQ.MT.
D11	1.75	x	(4.05 + 2.30)	x	0.50	x	1	=	5.56	SQ.MT.
D12	1.81	x	(2.24 + 4.05)	x	0.50	x	1	=	5.69	SQ.MT.
D13	2.32	x	4.05	x	1	X	1	=	9.40	SQ.MT.
D14	1.64	x	2.94	x	1	X	1	=	4.82	SQ.MT.
TOTAL								=	**173.91**	**SQ.MT.**
STAIRCASE,LIFT,LIFT LOBBY DEDUCTION (Y3)										
S1	3.00	x	5.55	x	1	X	2	=	33.30	SQ.MT.
L1	2.73	x	4.12	x	1	X	1	=	11.25	SQ.MT.
L2	3.02	x	3.07	x	1	X	1	=	9.27	SQ.MT.
L3	8.88	x	3.42	x	1	X	1	=	30.37	SQ.MT.
TOTAL								=	**84.19**	**SQ.MT.**
PASSAGE DEDUCTION (Y4)										
P1	0.59	x	(2.86 + 2.28)	x	0.50	x	2	=	3.03	SQ.MT.
P1a	2.28	x	0.34	x	1.00	X	2	=	1.55	SQ.MT.
P2	4.65	x	0.86	x	0.50	X	4	=	8.00	SQ.MT.
P3	3.86	x	1.94	x	0.50	X	2	=	7.49	SQ.MT.
P4	1.49	x	2.73	x	1	X	2	=	8.14	SQ.MT.
P4a	1.23	x	0.15	x	1	X	2	=	0.37	SQ.MT.
P5	2.75	x	2.50	x	1	X	2	=	13.75	SQ.MT.
P6	4.80	x	2.65	x	1	X	1	=	12.72	SQ.MT.
P6a	4.80	x	4.33	x	1	X	1	=	20.78	SQ.MT.
P7	3.45	x	1.68	x	1	X	1	=	5.80	SQ.MT.
P8	2.73	x	2.46	x	1	X	1	=	6.72	SQ.MT.
P9	1.46	x	1.46	x	0.5	X	2	=	2.13	SQ.MT.
P10	2.02	x	1.40	x	1.00	X	2	=	5.66	SQ.MT.
P11	1.46	x	1.46	x	0.50	X	2	=	2.13	SQ.MT.
P12	3.61	x	2.65	x	1	X	1	=	9.57	SQ.MT.
P13	8.88	x	2.50	x	1	X	1	=	22.20	SQ.MT.
P14	5.36	x	1.75	x	0.50	X	1	=	4.69	SQ.MT.
P15	4.01	x	0.81	x	0.50	X	1	=	1.62	SQ.MT.
P16	3.31	x	2.65	x	1	X	1	=	8.77	SQ.MT.
P17	3.02	x	2.50	x	1	X	1	=	7.55	SQ.MT.
TOTAL								=	**152.66**	**SQ.MT.**
REFUGE DEDUCTION (Y5)										
R1	3.60	x	2.84	x	1	X	2	=	20.45	SQ.MT.
R2	3.30	x	0.75	x	1.00	X	1	=	2.48	SQ.MT.
R3	3.00	x	0.92	x	1.00	X	1	=	2.76	SQ.MT.
R4	3.30	x	0.42	x	1	X	1	=	1.39	SQ.MT.
R5	3.00	x	1.25	x	1	X	1	=	3.75	SQ.MT.
TOTAL								=	**30.82**	**SQ.MT.**
REQUIRED REFUGE AREA (Y6)								=	**21.00**	SQ.MT.
TOTAL DEDUCTION (Y7) (Y1+Y2+Y3+Y4+Y5)								=	**1087.64**	SQ.MT.
TOTAL BUILT UP AREA (Y8) (X-Y7)								=	**928.27**	SQ.MT.
EXECES REFUGE AREA (Y9)								=	**9.82**	**SQ.MT.**
PERM. BALCONY (Y10) (Y8 x 10%)								=	**92.83**	**SQ.MT.**
BALCONY AREA STATEMENT										
B1	7.57	x	1.00	x	1	X	2	=	15.15	SQ.MT.
B2	2.25	x	1.00	x	1	X	1	=	2.25	SQ.MT.
B3	3.80	x	1.00	x	1	X	3	=	11.40	SQ.MT.
B4	3.20	x	1.00	x	1	X	3	=	9.60	SQ.MT.
B5	4.15	x	1.43	x	1	X	3	=	17.80	SQ.MT.
B6	3.50	x	1.00	x	1	X	3	=	10.50	SQ.MT.
B7	2.50	x	1.00	x	1	X	1	=	2.50	SQ.MT.
B8	1.03	x	2.72	x	1	X	2	=	5.60	SQ.MT.
B9	1.00	x	3.35	x	1	X	2	=	6.70	SQ.MT.
B10	7.12	x	1.00	x	1	X	2	=	14.24	SQ.MT.
B11	2.25	x	1.00	x	1	X	2	=	4.50	SQ.MT.
B12	5.15	x	1.00	x	1	X	1	=	5.15	SQ.MT.
B13	3.58	x	1.00	x	1	X	2	=	7.16	SQ.MT.
TOTAL (Y11)								=	**112.55**	**SQ.MT.**
EXCESS BALCONY (Y12) (Y9-Y8)								=	**19.73**	**SQ.MT.**
NET BUILT UP AREA (Y8+Y9+12)								=	**957.82**	**SQ.MT.**

(BLDG NO.2) | 17 / 25

CONTENTS OF SHEET

TYPICAL REFUGE FLOOR PLAN & CALCULATION

STAMP AND DATE OF APPROVAL OF PLAN

PART OC
This Part Occupancy Certificate is issued for Sale Building no 1 (A ,B ,C) (Till 26th Floor) & Building no 2 (Till 30th Floor), and As Built drawing is approved subject to conditions as mentioned in Part Occupancy Certificate bearing no. NAINA/6529/2021-CIDCO/NAINA/PANVEL/Kolkhe/ BP- 00112/Part/ OC/ 2022/ 0217A. Dated 24.06.2022.

RAJA BHAGUJI WAGHMARE

Digitally signed by RAJA BHAGUJI WAGHMARE
Date: 2022.06.24 19:43:50 +05'30'


DOOR SCHEDULE

Sr.NO.	D.NO.	SIZE	LINTEL LVL	DESCRIPTION	REMARK
1.	FRD	1.5 X 2.30	2.30	FIRE REISISTANT DOOR	STAIRCASE
2.	D-1	1.2 X 2.30	2.30	T.W FRAME WITH W.P FLUSH DOOR	MAIN DOOR
3.	D-2	0.9 X 2.30	2.30	T.W FRAME WITH W.P FLUSH DOOR	BED ROOM
4.	D-3	0.75 X 2.30	2.30	MARBLE/GRANITE FRAME WITH FRP DOOR	TOILET

WINDOW SCHEDULE

Sr.NO.	W.NO.	SIZE	SILL LVL	LINTEL LVL	AREA IN SQ.FT.	DESCRIPTION	REMARK
1	SW-1	2.0 X 2.15	0.15	2.30	4.30	RAILING / FIXED GLASS WINDOW	STAIRCASE
2	W	3.75 X 2.15	0.15	2.30	8.06	ALUMINUM SLIDING WINDOW	LIVING ROOM WIND.G. FLAT 2,3,6
3	W-1A	2.60 X 1.70	0.60	2.30	4.42	ALUMINUM SLIDING WINDOW	LIVING ROOM
4	W-1B	2.90 X 2.15	0.15	2.30	6.23	ALUMINUM SLIDING WINDOW	LIVING ROOM WIND.G. FLAT 1,4,5
5	W-2	1.8 X 2.15	0.15	2.30	3.87	ALUMINUM SLIDING WINDOW	BED ROOM
6	W-2A	1.8 X 1.70	0.60	2.30	3.06	ALUMINUM SLIDING WINDOW	BED ROOM
7	W-3	1.5 X 2.15	0.15	2.30	3.22	ALUMINUM SLIDING WINDOW	KITCHEN
8	V	0.85 X 1.76	0.54	2.30	1.50	LOUVERS VENTILATOR	TOILETS & DUCT
9	V1	0.90 X 0.95	1.35	2.30	0.85	LOUVERS VENTILATOR	TOILETS & DUCT
10	V2	0.65 X 0.95	1.35	2.30	0.61	LOUVERS VENTILATOR	TOILETS & DUCT

NOTE :-
1) HABITABLE ROOM INCLUDES BEDROOM & LIVING ROOM
2) REFUGE AREAS ARE PROVIDED AT MIDLANDING OF EVERY ALTERNATE FLOOR
3) ALL DIMENSIONS ARE IN METERS

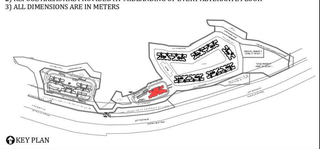

KEY PLAN

DESCRIPTION OF PROPOSAL & PROPERTY


PROPOSED DEVELOPMENT FOR RENTAL HOUSING SCHEME ON LAND BEARING S.NO.95/1(pt), 95/2(pt),95/3A(pt),98/1/98/2/98/3/98/4A/98/4/B/1/98/4/B/2/98/5(pt),98/7/3(pt),98/8/98/9, 98/10A/98/10B,99(pt),101/3,101/4/A,101/4/B,101/4/C,101/5,101/6,101/7,101/8A,101/8B,101/9, 101/10/A,101/10/B,102,103/1,103/2(pt),103/3,103/4,110/1A(pt),110/4,110/5A,110/6A,110/10, 110/11 at Village Kolkhe, Taluka - Panvel, District Raigad

NORTH	JOB. NO.	DRG. NO.	DRAWN BY
		17 / 25	-
	SCALE	DATE	CHECKED BY
	1: 100	-	-
REVISIONS	DESCRIPTION :		
R-0			
NAME OF THE OWNER			


MANISH MADHU BATHIJA

M/S. PARADISE LIFESPACES LLP.
(P.O.A.H. of Shri. Esmail Ebrahim Dhariwala & others)

NAME & ADDRESS OF THE DESIGN ARCHITECT:	
NAME OF ARCHITECT	M/s. DIMENSION ARCHITECTS
LICENSE NO	CA/ /
ADDRESS	PLOT NO.99, NEAR SAGAR VIHAR, SECTOR-08, VASHI, NAVI MUMBAI 400 703
NAME OF ARCHITECT	DEVYANI KHADILKAR
LIC. NO	CA/90/13184
ADDRESS	B-106, Natraj Building, Mulund Goregaon Link Road Mulund (w), Mumbai : 400 080

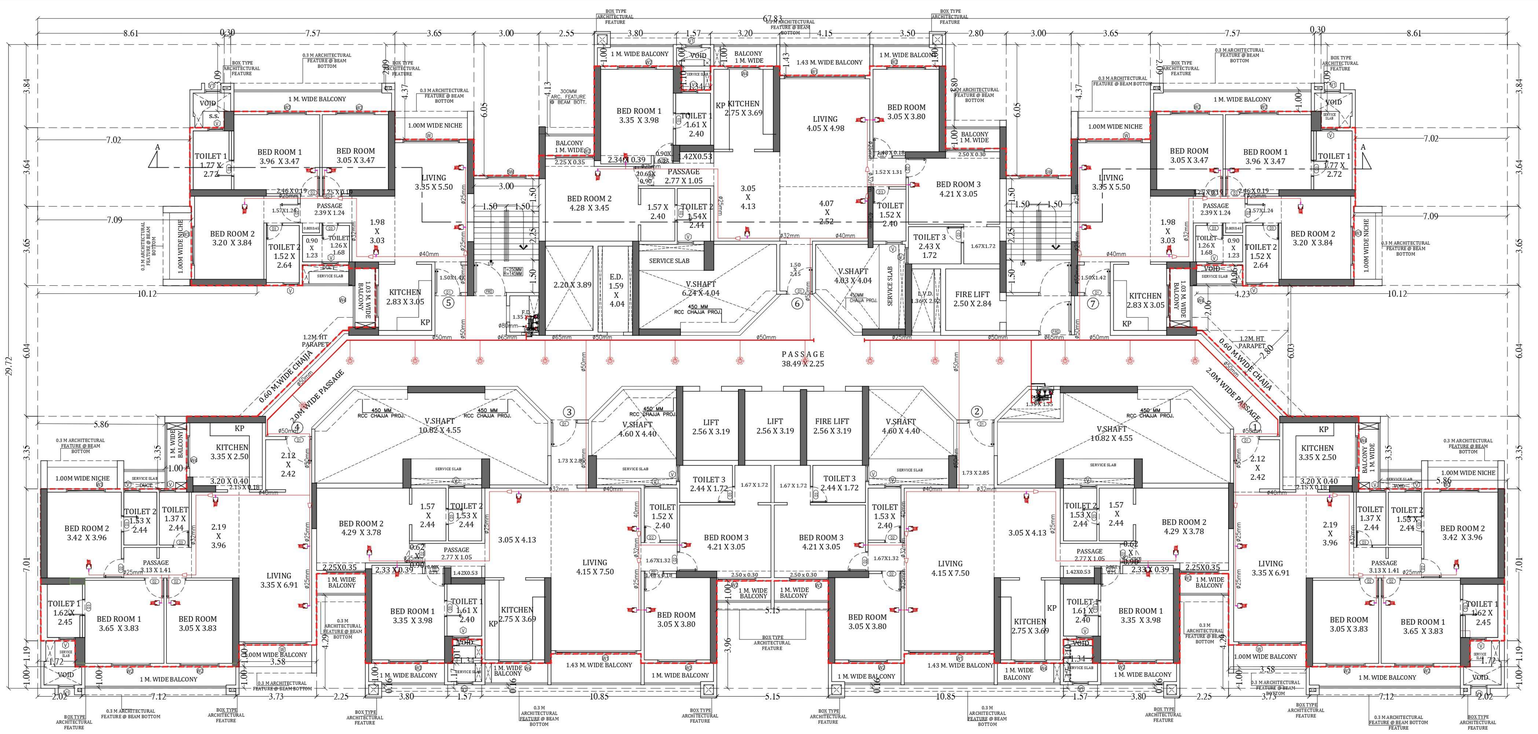

TYPICAL FLOOR PLAN (BLDG NO. 2)
(3RD,4TH,5th, 6th, 8th,10th,12th,14th,16th,18th,20th,22nd,24th,26th,28th & 30th)
SCALE :- 1:100

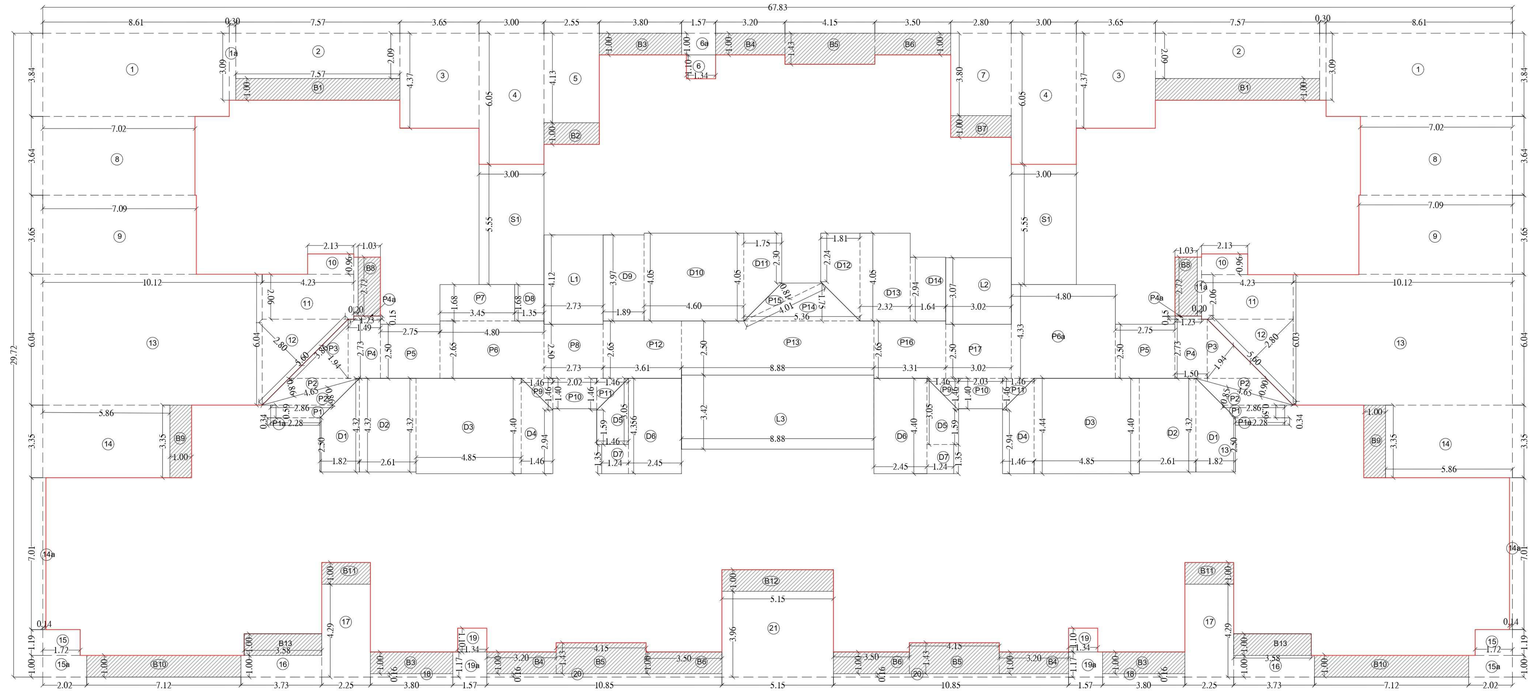

LINE DIAGRAM FOR TYPICAL FLOOR PLAN (BLDG NO. 2)
(3RD,4TH,5th, 6th, 8th,10th,12th,14th,16th,18th,20th,22nd,24th,26th,28th & 30th)
SCALE :- 1:100

BUILT UP AREA CALCULATION FOR TYPICAL FLOOR PLAN (3rd,4th5th, 6th, 8th,10th,12th,14th,16th,18th,20th,22nd,24th,26th,28th & 30th)

ADDITION (X)										
A	67.83	x	29.72	x	1	1	=	2015.91	SQ.MT.
TOTAL							=	**2015.91**	**SQ.MT.**
STANDARD DEDUCTION (Y1)										
1	8.61	x	3.84	x	1	X 2	=	66.16	SQ.MT.
1a	0.30	x	3.09	x	1	X 2	=	1.88	SQ.MT.
2	7.57	x	2.09	x	1	X 2	=	31.66	SQ.MT.
3	3.65	x	4.37	x	1	X 2	=	31.94	SQ.MT.
4	3.00	x	6.05	x	1	X 2	=	36.30	SQ.MT.
5	2.55	x	4.13	x	1	X 2	=	10.55	SQ.MT.
6	1.34	x	1.10	x	1	X 1	=	1.48	SQ.MT.
6a	1.57	x	1.00	x	1	X 1	=	1.57	SQ.MT.
7	2.80	x	3.80	x	1	X 1	=	10.66	SQ.MT.
8	7.02	x	3.64	x	1	X 2	=	51.13	SQ.MT.
9	7.09	x	3.65	x	1	X 2	=	51.79	SQ.MT.
10	2.13	x	0.96	x	1	X 2	=	4.10	SQ.MT.
11	4.23	x	2.06	x	1	X 2	=	17.44	SQ.MT.
11a	0.20	x	2.72	x	1	X 2	=	1.09	SQ.MT.
12	5.60	x	2.80	x	0.5	X 2	=	15.69	SQ.MT.
13	10.12	x	6.04	x	1	X 2	=	122.30	SQ.MT.
14	5.86	x	3.35	x	1	X 2	=	39.29	SQ.MT.
14a	0.14	x	7.01	x	1	X 2	=	2.02	SQ.MT.
15	1.72	x	1.19	x	1	X 2	=	4.10	SQ.MT.
15a	2.02	x	1.00	x	1	X 2	=	4.05	SQ.MT.
16	3.73	x	1.00	x	1	X 2	=	7.47	SQ.MT.
17	2.25	x	4.29	x	1	X 2	=	19.34	SQ.MT.
18	3.80	x	0.16	x	1	X 2	=	1.22	SQ.MT.
19	1.34	x	1.10	x	1	X 2	=	2.96	SQ.MT.
19a	1.57	x	1.17	x	1	X 2	=	3.68	SQ.MT.
20	10.85	x	0.16	x	1	X 2	=	3.47	SQ.MT.
21	5.15	x	3.96	x	1	X 1	=	20.41	SQ.MT.
B1	7.57	x	1.00	x	1	X 2	=	15.15	SQ.MT.
B2	2.55	x	1.00	x	1	X 1	=	2.55	SQ.MT.
B3	3.80	x	1.00	x	1	X 3	=	11.40	SQ.MT.
B4	3.20	x	1.00	x	1	X 3	=	9.60	SQ.MT.
B5	4.15	x	1.43	x	1	X 3	=	17.80	SQ.MT.
B6	3.50	x	1.00	x	1	X 3	=	10.50	SQ.MT.
B7	2.80	x	1.00	x	1	X 1	=	2.80	SQ.MT.
B8	1.03	x	2.72	x	1	X 2	=	5.60	SQ.MT.
B9	1.00	x	3.35	x	1	X 2	=	6.70	SQ.MT.
B10	7.12	x	1.00	x	1	X 2	=	14.24	SQ.MT.
B11	2.25	x	1.00	x	1	X 2	=	4.50	SQ.MT.
B12	5.15	x	1.00	x	1	X 1	=	5.15	SQ.MT.
B13	3.58	x	1.00	x	1	X 2	=	7.16	SQ.MT.
TOTAL							=	**676.88**	**SQ.MT.**
DUCT DEDUCTION (Y2)										
D1	1.82	x	(2.5 + 4.32)	x	0.50	x 2	=	12.41	SQ.MT.
D2	2.61	x	4.32	x	1	X 2	=	22.55	SQ.MT.
D3	4.85	x	4.40	x	1	X 2	=	42.68	SQ.MT.
D4	1.46	x	(4.4 + 2.94)	x	0.50	x 2	=	10.72	SQ.MT.
D5	1.46	x	(1.59 + 3.05)	x	0.50	x 2	=	6.77	SQ.MT.
D6	2.45	x	4.40	x	1	X 2	=	21.56	SQ.MT.
D7	1.24	x	1.35	x	1	X 2	=	3.35	SQ.MT.
D8	1.35	x	1.68	x	1	X 1	=	2.27	SQ.MT.
D9	1.89	x	3.97	x	1	X 1	=	7.50	SQ.MT.
D10	4.60	x	4.05	x	1	X 1	=	18.63	SQ.MT.
D11	1.75	x	(4.05 + 2.30)	x	0.50	x 1	=	5.56	SQ.MT.
D12	1.81	x	(2.24 + 4.05)	x	0.50	x 1	=	5.69	SQ.MT.
D13	2.32	x	4.05	x	1	X 1	=	9.40	SQ.MT.
D14	1.64	x	2.94	x	1	X 1	=	4.82	SQ.MT.
TOTAL							=	**173.91**	**SQ.MT.**
STAIRCASE LIFT,LIFT LOBBY DEDUCTION (Y3)										
S1	3.00	x	5.55	x	1	X 2	=	33.30	SQ.MT.
L1	2.73	x	4.12	x	1	X 1	=	11.25	SQ.MT.
L2	3.02	x	3.07	x	1	X 1	=	9.27	SQ.MT.
L3	8.88	x	3.42	x	1	X 1	=	30.37	SQ.MT.
TOTAL							=	**84.19**	**SQ.MT.**
PASSAGE DEDUCTION (Y4)										
P1	0.59	x	(2.86 + 2.28)	x	0.50	x 2	=	3.03	SQ.MT.
P1a	2.28	x	0.34	x	1.00	X 2	=	1.55	SQ.MT.
P2	4.65	x	0.86	x	0.50	X 4	=	8.00	SQ.MT.
P3	3.86	x	1.94	x	0.50	X 2	=	7.49	SQ.MT.
P4	1.49	x	2.73	x	1	X 2	=	8.14	SQ.MT.
P4a	1.23	x	0.15	x	1	X 2	=	0.37	SQ.MT.
P5	2.75	x	2.50	x	1	X 2	=	13.75	SQ.MT.
P6	4.80	x	2.65	x	1	X 1	=	12.72	SQ.MT.
P6a	4.80	x	4.33	x	1	X 1	=	20.78	SQ.MT.
P7	3.45	x	1.68	x	1	X 1	=	5.80	SQ.MT.
P8	2.73	x	2.46	x	1	X 1	=	6.72	SQ.MT.
P9	1.46	x	1.46	x	0.5	X 2	=	2.13	SQ.MT.
P10	2.02	x	1.40	x	1.00	X 2	=	5.66	SQ.MT.
P11	1.46	x	1.46	x	0.50	X 2	=	2.13	SQ.MT.
P12	3.61	x	2.65	x	1	X 1	=	9.57	SQ.MT.
P13	8.88	x	2.50	x	1	X 1	=	22.20	SQ.MT.
P14	5.36	x	1.75	x	0.50	X 1	=	4.69	SQ.MT.
P15	4.01	x	0.81	x	0.50	X 1	=	1.62	SQ.MT.
P16	3.31	x	2.65	x	1	X 1	=	8.77	SQ.MT.
P17	3.02	x	2.50	x	1	X 1	=	7.55	SQ.MT.
TOTAL							=	**152.66**	**SQ.MT.**
TOTAL DEDUCTION (Y5) (Y1+Y2+Y3+Y4)								**1087.64**	SQ.MT.
TOTAL BUILT UP AREA (Y6) (X-Y5)							=	**928.27**	**SQ.MT.**
PERM. BALCONY (Y7) (Y6 x 10%)							=	**92.83**	**SQ.MT.**
BALCONY AREA STATEMENT										
B1	7.57	x	1.00	x	1	X 2	=	15.15	SQ.MT.
B2	2.55	x	1.00	x	1	X 1	=	2.55	SQ.MT.
B3	3.80	x	1.00	x	1	X 3	=	11.40	SQ.MT.
B4	3.20	x	1.00	x	1	X 3	=	9.60	SQ.MT.
B5	4.15	x	1.43	x	1	X 3	=	17.80	SQ.MT.
B6	3.50	x	1.00	x	1	X 3	=	10.50	SQ.MT.
B7	2.80	x	1.00	x	1	X 1	=	2.80	SQ.MT.
B8	1.03	x	2.72	x	1	X 2	=	5.60	SQ.MT.
B9	1.00	x	3.35	x	1	X 2	=	6.70	SQ.MT.
B10	7.12	x	1.00	x	1	X 2	=	14.24	SQ.MT.
B11	2.25	x	1.00	x	1	X 2	=	4.50	SQ.MT.
B12	5.15	x	1.00	x	1	X 1	=	5.15	SQ.MT.
B13	3.58	x	1.00	x	1	X 2	=	7.16	SQ.MT.
TOTAL (Y8)							=	**113.15**	**SQ.MT.**
EXCESS BALCONY (Y9) (Y8-Y7)							=	**20.32**	**SQ.MT.**
NET BUILT UP AREA (Y9+Y6)							=	**948.59**	**SQ.MT.**

LIGHT AND VENTILATION STATEMENT (BLDG 2, FLAT NO 1 & 4)

ROOM	AREA OF ROOM (SQM)	AREA OF WIN REQ. (SQM)	AREA OF WIN PROV.(SQM)	TYPE OF WINDOW PROVD.
LIVING	36.970	6.182	6.230	W1B
BED ROOM	11.680	1.947	3.870	W2
BED ROOM 1	13.970	2.328	3.870	W2
BED ROOM 2	13.540	2.257	3.060	W2A
KITCHEN	10.050	1.675	3.225	W3
TOILET	3.340	0.557	0.720	V
TOILET 1	3.960	0.660	0.720	V
TOILET 2	3.730	0.622	0.720	V

LIGHT AND VENTILATION STATEMENT (BLDG 2,FLAT NO 2 & 3)

ROOM	AREA OF ROOM (SQM)	AREA OF WIN REQ. (SQM)	AREA OF WIN PROV.(SQM)	TYPE OF WINDOW PROVD.
LIVING	45.970	7.662	8.060	W
BED ROOM	11.590	1.932	3.870	W2
BED ROOM 1	14.460	2.410	3.870	W2
BED ROOM 2	20.230	3.372	3.870	W2
BED ROOM 3	16.580	2.763	3.870	W2
KITCHEN	10.140	1.690	3.225	W3
TOILET	3.670	0.612	0.720	V
TOILET 1	3.860	0.643	0.720	V
TOILET 2	3.730	0.622	0.720	V
TOILET 3	4.190	0.698	0.720	V

LIGHT AND VENTILATION STATEMENT (BLDG 2, FLAT NO 5 & 7)

ROOM	AREA OF ROOM (SQM)	AREA OF WIN REQ. (SQM)	AREA OF WIN PROV.(SQM)	TYPE OF WINDOW PROVD.
LIVING	26.550	4.425	4.420	W1A
BED ROOM	10.810	1.802	3.870	W2
BED ROOM 1	14.180	2.363	3.870	W2
BED ROOM 2	14.210	2.368	3.060	W2A
KITCHEN	7.470	1.245	3.225	W3
TOILET	3.230	0.538	0.720	V
TOILET 1	4.810	0.802	0.860	V1
TOILET 2	2.490	0.415	0.720	V

LIGHT AND VENTILATION STATEMENT (BLDG 2, FLAT NO 6)

ROOM	AREA OF ROOM (SQM)	AREA OF WIN REQ. (SQM)	AREA OF WIN PROV.(SQM)	TYPE OF WINDOW PROVD.
LIVING	46.650	7.803	8.060	W
BED ROOM	11.880	1.980	3.870	W2
BED ROOM 1	14.460	2.410	3.870	W2
BED ROOM 2	20.230	3.372	3.870	W2
BED ROOM 3	16.460	2.743	3.870	W2
KITCHEN	10.140	1.690	3.225	W3
TOILET	3.640	0.607	0.720	V
TOILET 1	3.860	0.643	0.720	V
TOILET 2	3.750	0.625	0.720	V
TOILET 3	4.170	0.695	0.720	V

CARPET AREA STATEMENT FOR TYPICAL FLOOR (BLDG NO. 2)

FLAT NO. 1	=	105.30 SQ.MT.
FLAT NO. 2	=	146.43 SQ.MT.
FLAT NO. 3	=	146.43 SQ.MT.
FLAT NO. 4	=	105.30 SQ.MT.
FLAT NO. 5	=	91.81 SQ.MT.
FLAT NO.6	=	148.50 SQ.MT.
FLAT NO.7	=	91.81 SQ.MT.

(BLDG NO.2) | 18 / 25

CONTENTS OF SHEET

TYPICAL FLOOR PLAN & CALCULATION

STAMP AND DATE OF APPROVAL OF PLAN

PART OC

This Part Occupancy Certificate is issued for Sale Building no 1 (A ,B ,C) (Till 26th Floor) & Building no 2 (Till 30th Floor), and As Built drawing is approved subject to conditions as mentioned in Part Occupancy Certificate bearing no. NAINA/6529/2021-CIDCO/NAINA/PANVEL/Kolkhe/ BP- 00112/Part/ OC/ 2022/ 0217A. Dated 24.06.2022.

RAJA BHAGUJI WAGHMARE

Digitally signed by RAJA BHAGUJI WAGHMARE
Date: 2022.06.24 19:44:26 +05'30'


DOOR SCHEDULE

Sr.NO.	D.NO.	SIZE	LINTEL LVL	DESCRIPTION	REMARK
1.	FRD	1.5 X 2.30	2.30	FIRE RESISTANT DOOR	STAIRCASE
2.	D-1	1.2 X 2.30	2.30	T.W FRAME WITH W.P FLUSH DOOR	MAIN DOOR
3.	D-2	0.9 X 2.30	2.30	T.W FRAME WITH W.P FLUSH DOOR	BED ROOM
4.	D-3	0.75 X 2.30	2.30	MARBLE/GRANITE FRAME WITH FRP DOOR	TOILET

WINDOW SCHEDULE

Sr.NO.	W.NO.	SIZE	SILL LVL	LINTEL LVL	AREA IN SQ.FT.	DESCRIPTION	REMARK
1	SW-1	2.0 X 2.15	0.15	2.30	4.30	RAILING / FIXED GLASS WINDOW	STAIRCASE
2	W	3.75 X 2.15	0.15	2.30	8.06	ALUMINUM SLIDING WINDOW	LIVING ROOM WINDO, FLAT 5,6,8
3	W-1A	2.60 X 1.70	0.60	2.30	4.42	ALUMINUM SLIDING WINDOW	LIVING ROOM
4	W-1B	2.90 X 2.15	0.15	2.30	6.23	ALUMINUM SLIDING WINDOW	LIVING ROOM WINDO, FLAT 1,5,4
5	W-2	1.8 X 2.15	0.15	2.30	3.87	ALUMINUM SLIDING WINDOW	BED ROOM
6	W-2A	1.8 X 1.70	0.60	2.30	3.06	ALUMINUM SLIDING WINDOW	BED ROOM
7	W-3	1.5 X 2.15	0.15	2.30	3.22	ALUMINUM SLIDING WINDOW	KITCHEN
8	V	0.85 X 1.76	0.54	2.30	1.50	LOUVERS VENTILATOR	TOILET'S & DUCT
9	V1	0.90 X 0.95	1.35	2.30	0.85	LOUVERS VENTILATOR	TOILET'S & DUCT
10	V2	0.65 X 0.95	1.35	2.30	0.61	LOUVERS VENTILATOR	TOILET'S & DUCT

NOTE :-
1) HABITABLE ROOM INCLUDES BEDROOM & LIVING ROOM
2) REFUGE AREAS ARE PROVIDED AT MIDLANDING OF EVERY ALTERNATE FLOOR
3) ALL DIMENSIONS ARE IN METERS

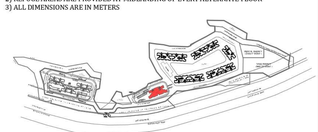

KEY PLAN

DESCRIPTION OF PROPOSAL & PROPERTY

PROPOSED DEVELOPMENT FOR RENTAL HOUSING SCHEME ON LAND BEARING S.NO.95/1(pt), 95/2(pt),95/3A(pt),98/1,98/2,98/3,98/4A,98/4/B/1,98/4/B/2,98/5(pt),98/7/3(pt),98/8,98/9, 98/10A,98/10B,98/9(pt),101/3,101/4/A,101/4/B,101/4/C,101/5,101/6,101/7,101/8A,101/8B,101/9, 101/10/A,101/10/B,102,103/1,103/2(pt),103/3,103/4,110/1A(pt),110/4,110/5A,110/6A,110/10, 110/11 at Village Kolkhe, Taluka - Panvel, District Raigad


NORTH	JOB. NO.	DRG. NO.	DRAWN BY
		18 / 25	-
	SCALE	DATE	CHECKED BY
	1:100	-	-
REVISIONS	DESCRIPTION :		
R-0			
NAME OF THE OWNER			


M/S. PARADISE LIFESPACES LLP.
(P.O.A.H. of Shri. Esmail Ebrahim Dhariwala & others)

MANISH MADHU BATHIJA

NAME & ADDRESS OF THE DESIGN ARCHITECT:

NAME OF ARCHITECT	M/s. DIMENSION ARCHITECTS
LICENSE NO	CA/ /
ADDRESS	PLOT NO.99, NEAR SAGAR VIHAR, SECTOR-08, VASHI, NAVI MUMBAI 400 703
NAME OF ARCHITECT	DEVYANI KHADILKAR
LIC. NO	CA/90/13184
ADDRESS	B-106, Natraj Building, Mulund Goregaon Link Road Mulund (w), Mumbai : 400 080

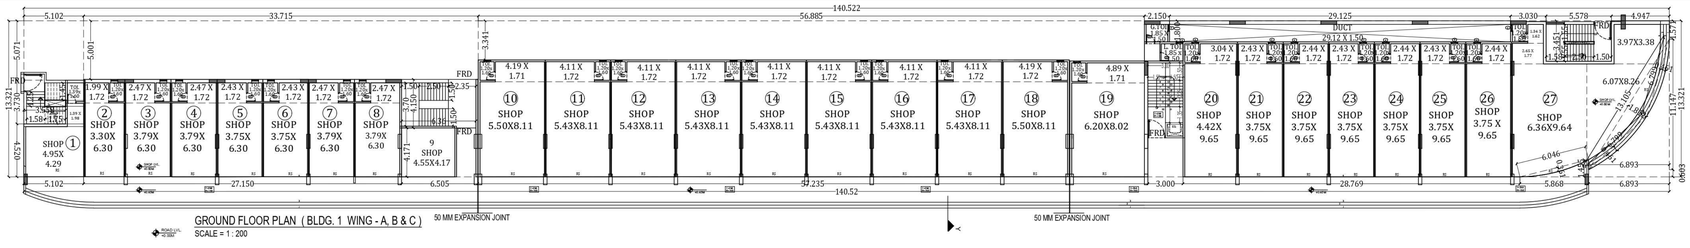

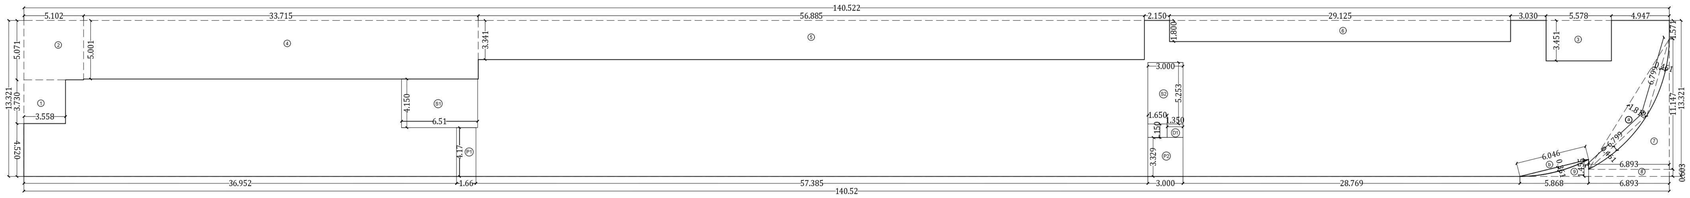



GROUND FLOOR PLAN									
ADDITION (X)									
A	140.522	X	13.321	X	1.00	X	1	=	1871.89 SQ.MT.
a	13.105	X	1.812	X	0.5	X	1	=	11.87 SQ.MT.
a	6.799	X	0.461	X	2/3	X	2	=	4.18 SQ.MT.
b	6.046	X	0.361	X	2/3	X	1	=	1.46 SQ.MT.
d	0.68	X	0.30	X	0.5	X	1	=	0.10 SQ.MT.
"	0.52	X	0.25	X	0.5	X	1	=	0.07 SQ.MT.
e	0.30	X	0.67	X	1.00	X	21	=	4.22 SQ.MT.
f	0.38	X	0.50	X	1	X	2	=	0.38 SQ.MT.
TOTAL (X)								=	1894.17 SQ.MT.
DEDUCTION (Y)									
1	3.558	X	3.73	X	1.00	X	1	=	13.27 SQ.MT.
2	5.102	X	5.071	X	1.00	X	1	=	25.87 SQ.MT.
3	5.578	X	3.451	X	1.00	X	1	=	19.25 SQ.MT.
4	33.715	X	5.001	X	1.00	X	1	=	168.61 SQ.MT.
5	56.885	X	3.341	X	1.00	X	1	=	190.05 SQ.MT.
6	29.125	X	1.80	X	1.00	X	1	=	52.43 SQ.MT.
7	6.893	X	11.147	X	0.50	X	1	=	38.42 SQ.MT.
8	6.893	X	0.603	X	1.00	X	1	=	4.16 SQ.MT.
9	5.868	X	1.455	X	0.50	X	1	=	4.27 SQ.MT.
TOTAL (Y)								=	516.32 SQ.MT.
DUCT DEDUCTION (Y1)									
D1	1.35	X	1.15	X	1.00	X	1	=	1.55 SQ.MT.
TOTAL (Y1)								=	1.55 SQ.MT.
STAIRCASE DEDUCTION (Y2)									
S1	6.505	X	4.15	X	1.00	X	1	=	27.00 SQ.MT.
S2	3.00	X	5.25	X	1.00	X	1	=	15.75 SQ.MT.
"	1.65	X	1.15	X	1.00	X	1	=	1.90 SQ.MT.
TOTAL (Y2)								=	44.64 SQ.MT.
PASSAGE DEDUCTION (Y3)									
P1	1.660	X	4.170	X	1.00	X	1	=	6.92 SQ.MT.
P2	3.00	X	3.329	X	1.00	X	1	=	9.99 SQ.MT.
TOTAL (Y3)								=	16.91 SQ.MT.
TOTAL DEDUCTION Y4 (Y+Y1+Y2+Y3)								=	579.43 SQ.MT.
BUILT UP AREA (X - Y4)								=	1314.74 SQ.MT.

Ground floor (Bldg no.1, Wing A,B & C)		
shop no	carpet area	Built up area
1	23.86	26.74
2	26.22	28.69
3	30.12	32.76
4	30.12	32.76
5	29.82	32.46
6	29.82	32.45
7	30.12	32.76
8	30.13	33.38
8A	18.97	20.95
9	53.69	58.77
10	53.09	55.65
11	53.09	55.27
12	53.08	55.64
13	53.09	55.64
14	53.08	55.64
15	53.08	55.64
16	53.08	55.64
17	53.82	57.14
18	60.14	66.25
19	50.05	53.57
20	42.39	44.93
21	42.39	44.93
22	42.39	44.93
23	42.39	44.93
24	42.39	44.93
25	42.39	44.92
26	113.76	131.03
G.TOILET	2.78	3.87
L.TOILET	2.75	3.22
PASSAGE	0.00	2.19
Total	**1212.10**	**1307.68**

1ST FLOOR PLAN									
ADDITION (X)									
A	139.772	X	13.32	X	1.00	X	1	=	1861.76 SQ.MT.
a	10.074	X	1.518	X	0.50	X	1	=	7.65 SQ.MT.
"	5.261	X	0.388	X	2/3	X	2	=	2.72 SQ.MT.
c	0.52	X	0.25	X	0.50	X	1	=	0.07 SQ.MT.
"	0.68	X	0.30	X	0.50	X	1	=	0.10 SQ.MT.
e	0.38	X	0.5	X	1.00	X	1	=	0.19 SQ.MT.
TOTAL (X)								=	1872.49 SQ.MT.
DEDUCTION (Y)									
1	5.876	X	3.301	X	1.00	X	1	=	19.40 SQ.MT.
2	5.876	X	1.699	X	0.50	X	1	=	4.99 SQ.MT.
3	6.117	X	0.434	X	2/3	X	1	=	1.77 SQ.MT.
4	32.93	X	5.00	X	1.00	X	1	=	164.65 SQ.MT.
5	56.885	X	3.341	X	1.00	X	1	=	190.05 SQ.MT.
6	29.125	X	1.80	X	1.00	X	1	=	52.43 SQ.MT.
7	6.143	X	7.985	X	0.50	X	1	=	24.53 SQ.MT.
8	6.143	X	2.473	X	1.00	X	1	=	15.19 SQ.MT.
TOTAL (Y)								=	473.00 SQ.MT.
DUCT DEDUCTION (Y 1)									
D1	1.35	X	1.15	X	1.00	X	1	=	1.55 SQ.MT.
TOTAL (Y1)								=	1.55 SQ.MT.
STAIRCASE DEDUCTION (Y2)									
S1	6.355	X	4.15	X	1.00	X	1	=	26.37 SQ.MT.
S2	3.00	X	5.253	X	1.00	X	1	=	15.76 SQ.MT.
"	1.65	X	1.15	X	1.00	X	1	=	1.90 SQ.MT.
TOTAL (Y2)								=	44.03 SQ.MT.
PASSAGE DEDUCTION (Y3)									
P1	32.252	X	2.43	X	1.00	X	1	=	78.37 SQ.MT.
P2	6.205	X	4.17	X	1.00	X	1	=	25.87 SQ.MT.
P3	57.535	X	2.43	X	1.00	X	1	=	139.81 SQ.MT.
P4	3.00	X	3.33	X	1.00	X	1	=	9.99 SQ.MT.
P5	34.637	X	2.43	X	1.00	X	1	=	84.17 SQ.MT.
TOTAL (Y3)								=	338.22 SQ.MT.
TOTAL DEDUCTION Y4 (Y+Y1+Y2+Y3)								=	856.80 SQ.MT.
BUILT UP AREA (X - Y4)								=	1015.69 SQ.MT.

1ST FLOOR (Bldg no.1, Wing A,B & C)		
shop no	carpet area	Built up area
1	30.30	33.70
2	18.20	20.33
3	20.92	23.19
4	20.92	23.19
5	20.71	22.97
6	20.71	22.97
7	20.92	23.19
8	20.92	23.63
9	40.43	44.64
10	39.90	42.10
11	39.90	42.10
12	39.90	42.10
13	39.90	42.10
14	39.90	42.10
15	39.90	42.10
16	39.90	42.10
17	40.45	43.42
18	45.06	50.43
19	47.36	51.97
20	33.28	35.45
21	33.28	35.45
22	33.28	35.45
23	33.28	35.45
24	33.28	35.45
25	33.28	35.45
26	119.33	124.15
Total	**945.21**	**1015.18**

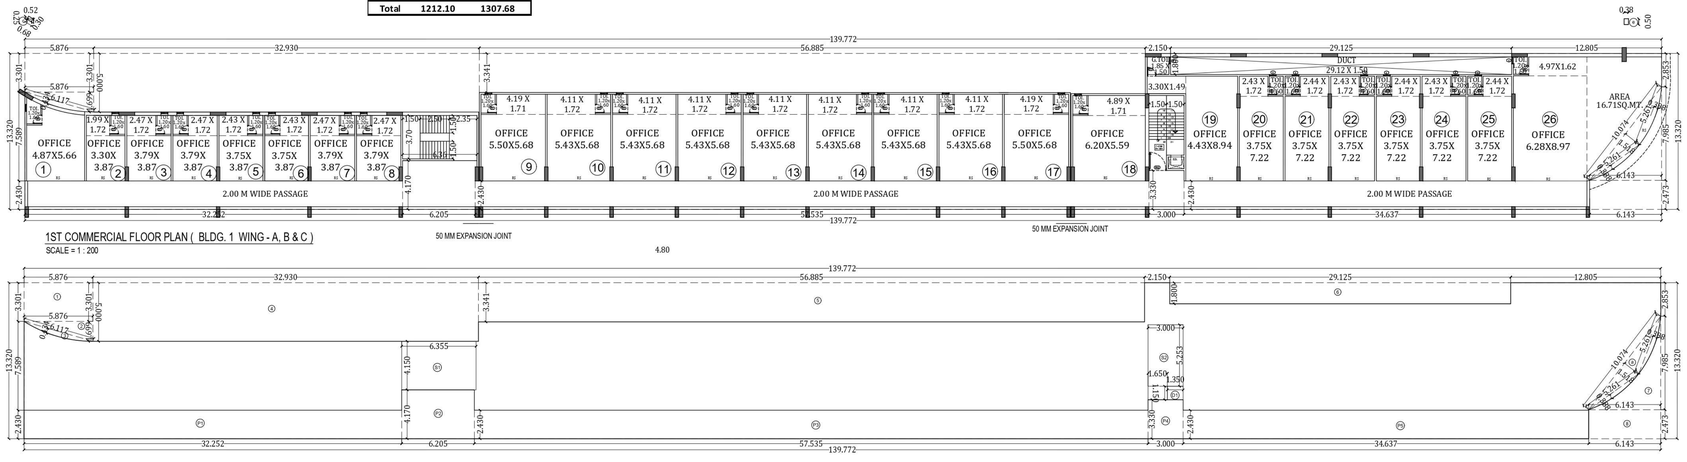

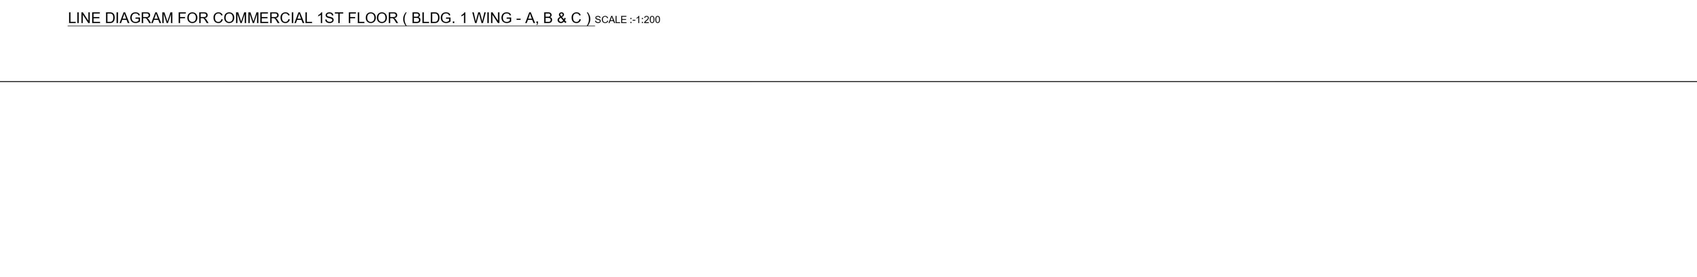

(COMMERCIAL BUILDING) 19 / 25

CONTENTS OF SHEET


GROUND (SHOP) & FIRST (OFFICE) FLOOR PLAN (BLDG NO. 1, WING A,B & C)
LINE DIAGRAM & CALCULATION

STAMP AND DATE OF APPROVAL OF PLAN

PART OC
This Part Occupancy Certificate is issued for Sale Building no 1 (A ,B ,C) (Till 26th Floor) & Building no 2 (Till 30th Floor), and As Built drawing is approved subject to conditions as mentioned in Part Occupancy Certificate bearing no. NAINA/6529/2021-CIDCO/NAINA/PANVEL/Kolkhe/ BP- 00112/Part/ OC/ 2022/ 0217A. Dated 24.06.2022.

RAJA BHAGUJI WAGHMARE
Digitally signed by RAJA BHAGUJI WAGHMARE
Date: 2022.06.24 19:45:02 +05'30'

NOTE :-
1) HABITABLE ROOM INCLUDES BEDROOM & LIVING ROOM
2) REFUGE AREAS ARE PROVIDED AT MIDLANDING OF EVERY ALTERNATE FLOOR
3) ALL DIMENSIONS ARE IN METERS

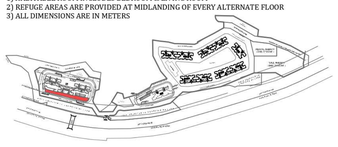

KEY PLAN

DESCRIPTION OF PROPOSAL & PROPERTY

PROPOSED DEVELOPMENT FOR RENTAL HOUSING SCHEME ON LAND BEARING S.NO.95/1(pt), 95/2(pt),95/3A(pt),98/1,98/2,98/3,98/4A,98/4/B/1,98/4/B/2,98/5(pt),98/7/3(pt),98/8,98/9, 98/10A,98/10B,99(pt),101/3,101/4/A,101/4/B,101/4/C,101/5,101/6,101/7,101/8A,101/8B,101/9, 101/10/A,101/10/B,102,103/1,103/2(pt),103/3,103/4,110/1A(pt),110/4,110/5A,110/6A,110/10, 110/11 at Village Kolkhe, Taluka - Panvel, District Raigad

NORTH	JOB. NO.	DRG. NO.	DRAWN BY
		19 / 25	-
	SCALE	DATE	CHECKED BY
	1: 200	-	-
REVISIONS	DESCRIPTION :		
R-0			


NAME OF THE OWNER

MANISH MADHU BATHIJA

M/S. PARADISE LIFESPACES LLP.
(P.O.A.H. of Shri. Esmail Ebrahim Dhariwala & others)


NAME & ADDRESS OF THE DESIGN ARCHITECT:	
NAME OF ARCHITECT	M/s. DIMENSION ARCHITECTS
LICENSE NO	CA/ /
ADDRESS	PLOT NO.99, NEAR SAGAR VIHAR, SECTOR-08, VASHI, NAVI MUMBAI 400 703

NAME OF ARCHITECT	DEVYANI KHADILKAR
LIC. NO	CA/90/13184
ADDRESS	B-106, Natraj Building, Mulund Goregaon Link Road Mulund (w), Mumbai : 400 080

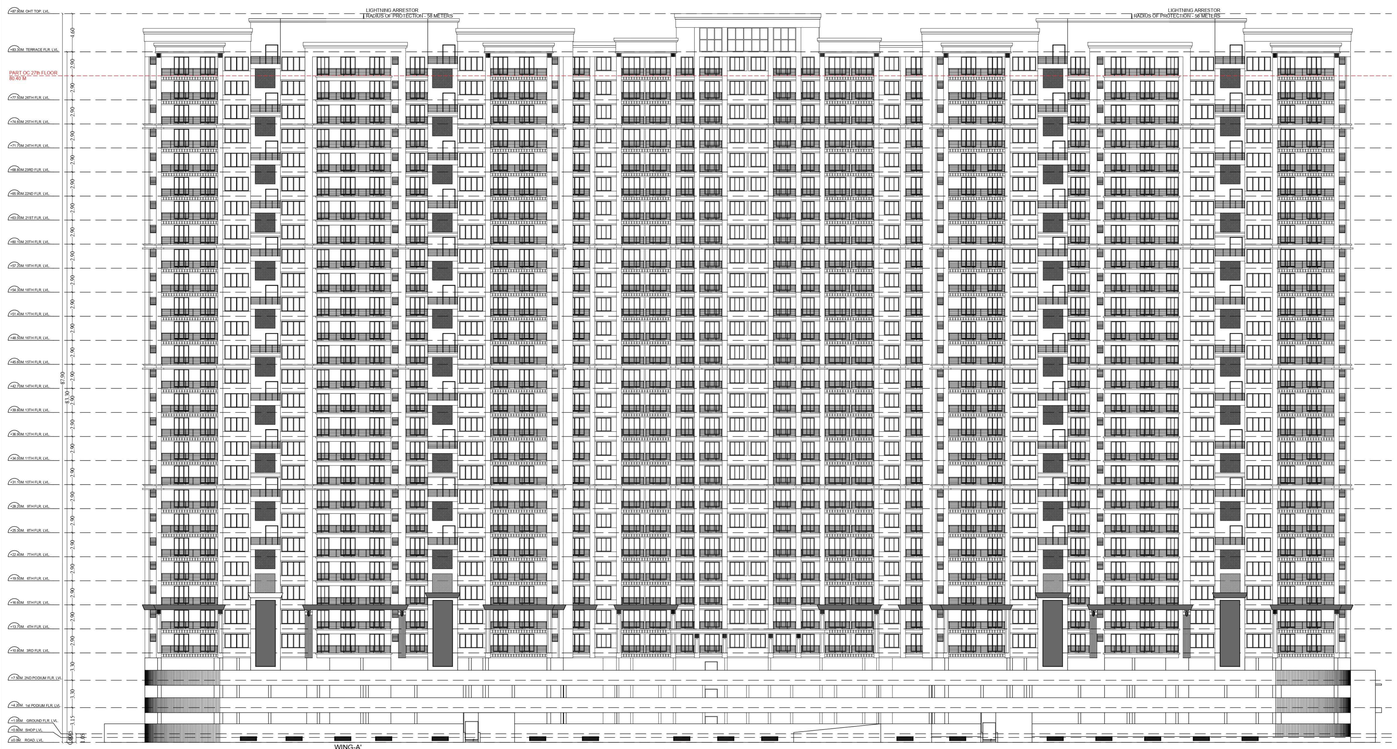

REAR ELEVATION - {BLDG 1,WING -A , B & C)
SCALE 1:200

REAR SIDE ELEVATION

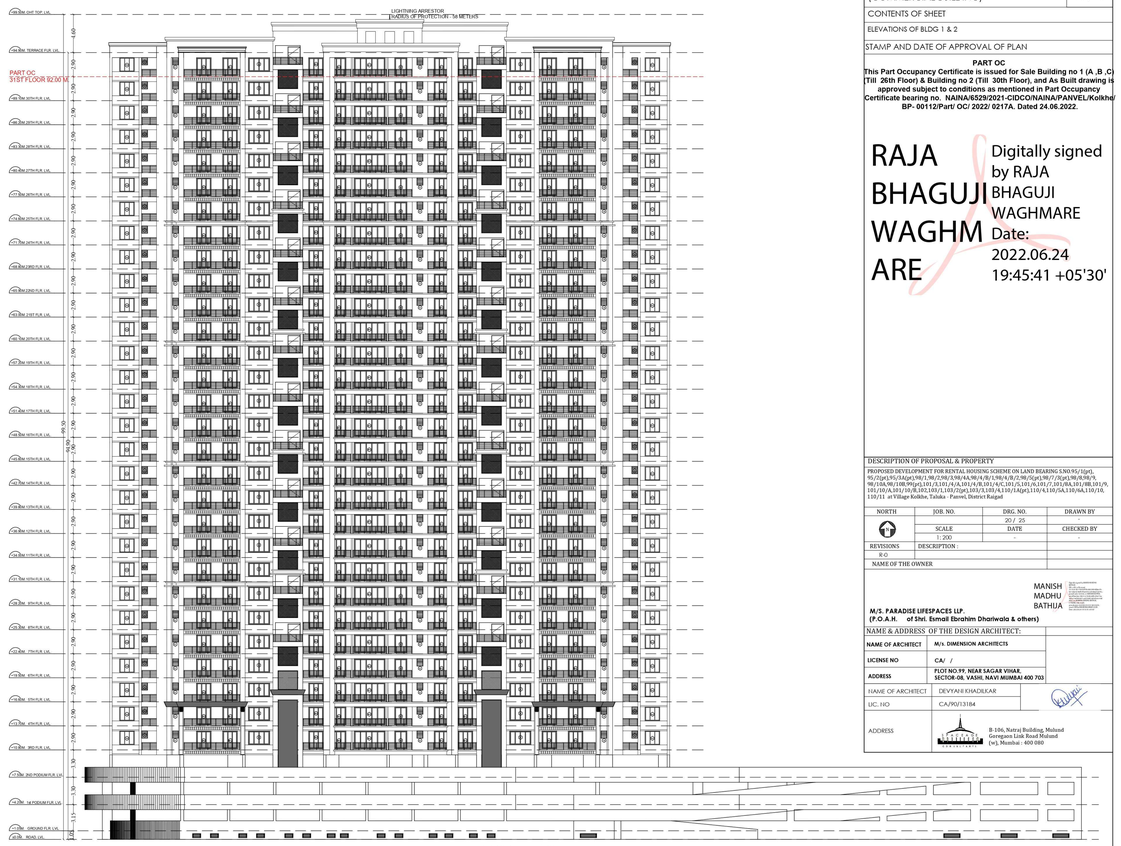

REAR SIDE ELEVATION

REAR ELEVATION - {BLDG 2}
SCALE 1:200

(COMMERCIAL BUILDING)	20 / 25
CONTENTS OF SHEET	
ELEVATIONS OF BLDG 1 & 2	
STAMP AND DATE OF APPROVAL OF PLAN	

PART OC

This Part Occupancy Certificate is issued for Sale Building no 1 (A ,B ,C) (Till 26th Floor) & Building no 2 (Till 30th Floor), and As Built drawing is approved subject to conditions as mentioned in Part Occupancy Certificate bearing no. NAINA/6529/2021-CIDCO/NAINA/PANVEL/Kolkhe/ BP- 00112/Part/ OC/ 2022/ 0217A. Dated 24.06.2022.

RAJA BHAGUJI WAGHMARE

Digitally signed by RAJA BHAGUJI WAGHMARE
Date: 2022.06.24 19:45:41 +05'30'

DESCRIPTION OF PROPOSAL & PROPERTY


PROPOSED DEVELOPMENT FOR RENTAL HOUSING SCHEME ON LAND BEARING S.NO.95/1(pt), 95/2(pt),95/3A(pt),98/1,98/2,98/3,98/4A,98/4/B/1,98/4/B/2,98/5(pt),98/7/2(pt),98/8,98/9, 99/1BA,98/1BB,98(pt),101/3,101/4/A,101/4/B,101/4/C,101/5,101/6,101/7,101/8A,101/8B,101/9, 101/10/A,101/10/B,102,103/1,103/2(pt),103/3,103/4,110/1A(pt),110/4,110/5A,110/6A,110/10, 110/11 at Village Kolkhe, Taluka – Panvel, District Raigad

NORTH	JOB. NO.	DRG. NO.	DRAWN BY
		20 / 25	
	SCALE	DATE	CHECKED BY
	1: 200	-	
REVISIONS	DESCRIPTION :		
R-0			
NAME OF THE OWNER			

MANISH MADHU BATHIJA


M/S. PARADISE LIFESPACES LLP.
(P.O.A.H. of Shri. Esmail Ebrahim Dhariwala & others)

NAME & ADDRESS OF THE DESIGN ARCHITECT:	
NAME OF ARCHITECT	M/s. DIMENSION ARCHITECTS
LICENSE NO	CA/ /
ADDRESS	PLOT NO.99, NEAR SAGAR VIHAR, SECTOR-08, VASHI, NAVI MUMBAI 400 703
NAME OF ARCHITECT	DEVYANI KHADILKAR
LIC. NO	CA/90/13184
ADDRESS	B-106, Natraj Building, Mulund Goregaon Link Road Mulund (we), Mumbai : 400 080

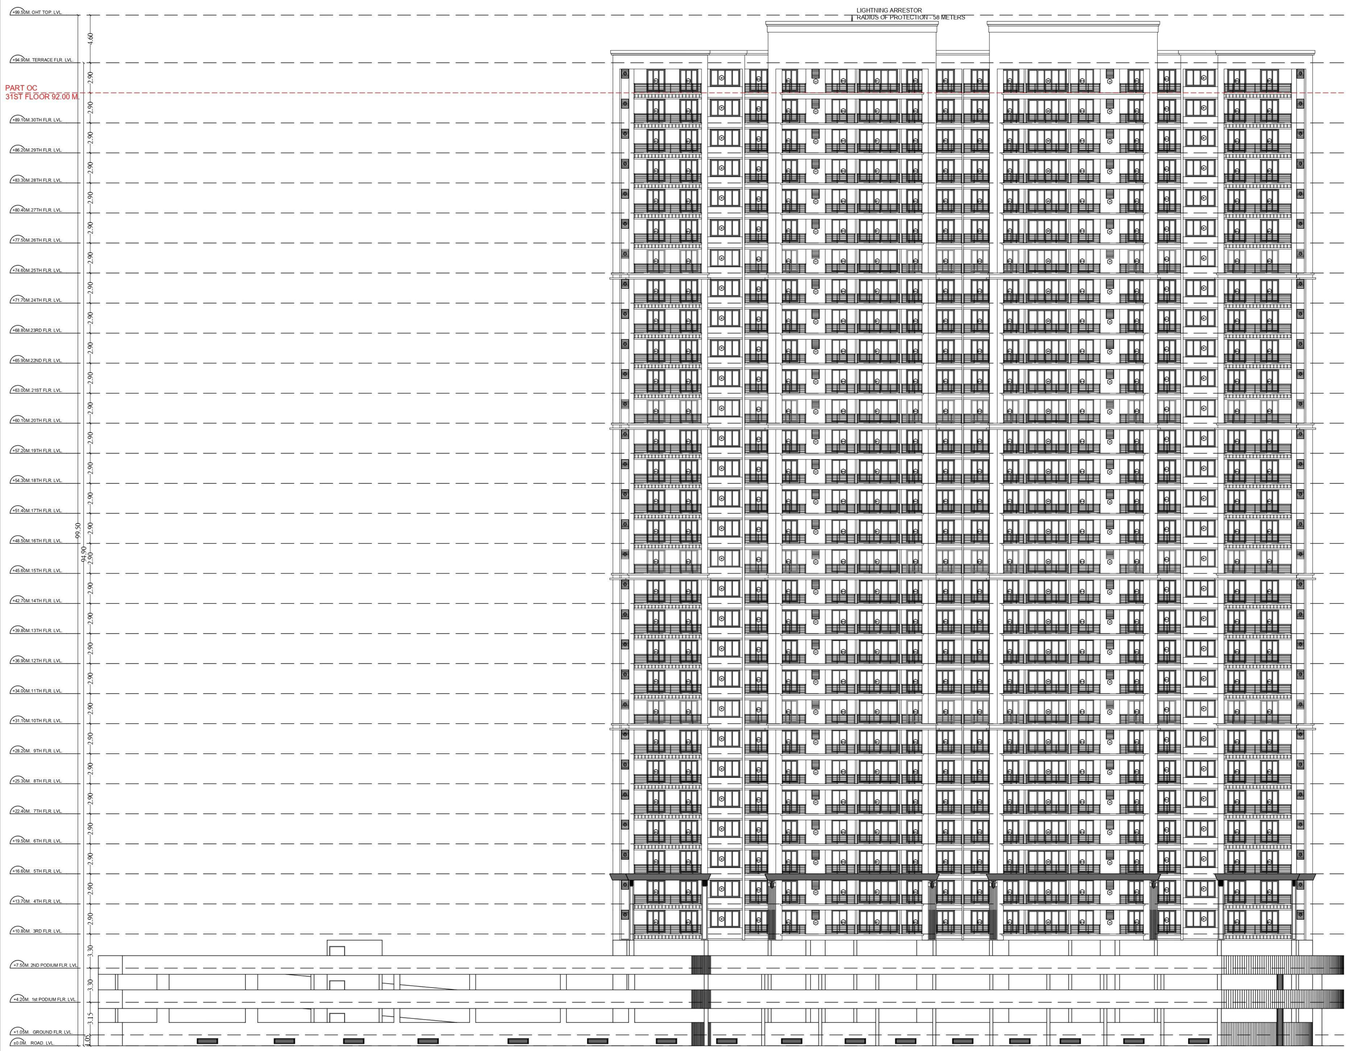

FRONT ELEVATION - (BLDG-2)
SCALE 1 : 200

FRONT SIDE ELEVATION

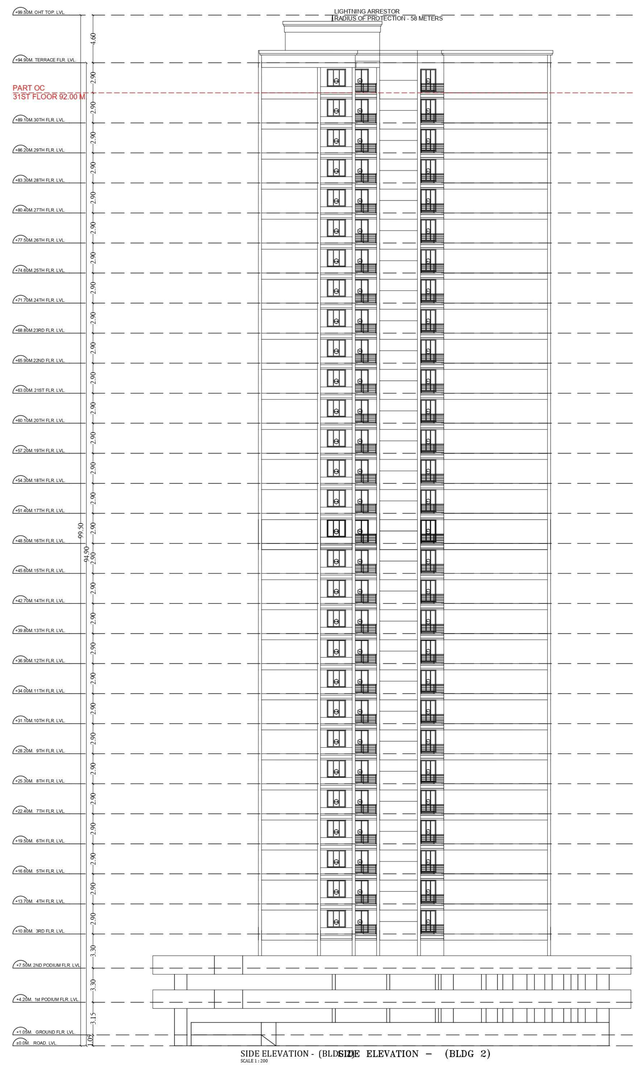

SIDE ELEVATION - (BLDG 2)
SCALE 1 : 200

SIDE ELEVATION – (BLDG 2)

(COMMERCIAL BUILDING)	21 / 25
CONTENTS OF SHEET	
ELEVATIONS OF BLDG 2	
STAMP AND DATE OF APPROVAL OF PLAN	

PART OC
This Part Occupancy Certificate is issued for Sale Building no 1 (A ,B ,C) (Till 26th Floor) & Building no 2 (Till 30th Floor), and As Built drawing is approved subject to conditions as mentioned in Part Occupancy Certificate bearing no. NAINA/6529/2021-CIDCO/NAINA/PANVEL/Kolkhe/ BP- 00112/Part/ OC/ 2022/ 0217A. Dated 24.06.2022.

RAJA BHAGUJI WAGHMARE
Digitally signed by RAJA BHAGUJI WAGHMARE
Date: 2022.06.24 19:46:21 +05'30'

DESCRIPTION OF PROPOSAL & PROPERTY


PROPOSED DEVELOPMENT FOR RENTAL HOUSING SCHEME ON LAND BEARING S.NO.95/1(pt), 95/2(pt),95/3A(pt),98/1,98/2,98/3,98/4A,98/4/B,98/4,98/4/B/2,98/5(pt),98/7/2(pt),98/8,98/9, 98/10A,98/10B,99(pt),101/3,101/4/A,101/4/B,101/4/C,101/5,101/6,101/7,101/8A,101/8B,101/9, 101/10/A,101/10/B,102,103/1,103/2(pt),103/3,103/4,110/1A(pt),110/4,110/5A,110/6A,110/10, 110/11 at Village Kolkhe, Taluka - Panvel, District Raigad

NORTH	JOB. NO.	DRG. NO.	DRAWN BY
		21 / 25	-
	SCALE	DATE	CHECKED BY
	1: 200	-	-
REVISIONS	DESCRIPTION :		
R-0			
NAME OF THE OWNER			

MANISH MADHU BATHIJA


M/S. PARADISE LIFESPACES LLP.
(P.O.A.H. of Shri. Esmail Ebrahim Dhariwala & others)

NAME & ADDRESS OF THE DESIGN ARCHITECT:		
NAME OF ARCHITECT	M/s. DIMENSION ARCHITECTS	
LICENSE NO	CA/ /	
ADDRESS	PLOT NO.99, NEAR SAGAR VIHAR, SECTOR-08, VASHI, NAVI MUMBAI 400 703.	
NAME OF ARCHITECT	DEVYANI KHADILKAR	
LIC. NO	CA/90/13184	
ADDRESS	B-106, Nataraj Building, Mulund Goregaon Link Road Mulund (w), Mumbai : 400 080	

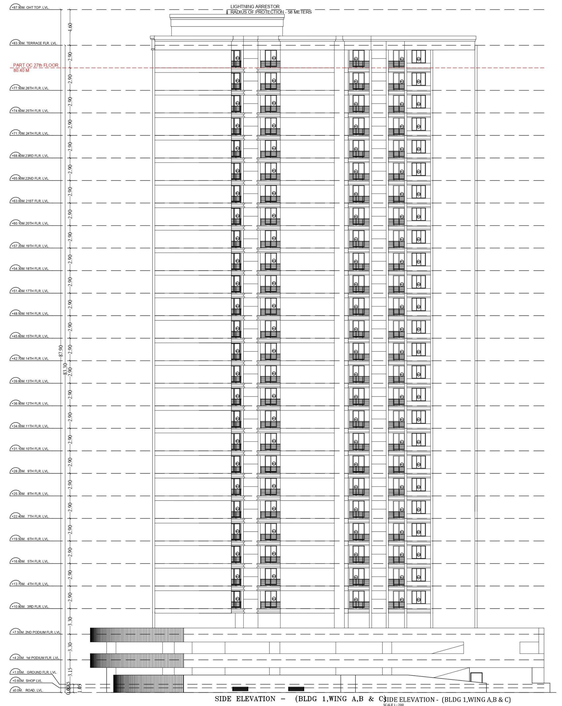

SIDE ELEVATION – (BLDG 1,WING A,B & C)SIDE ELEVATION - (BLDG 1,WING A,B & C)

SCALE 1:200

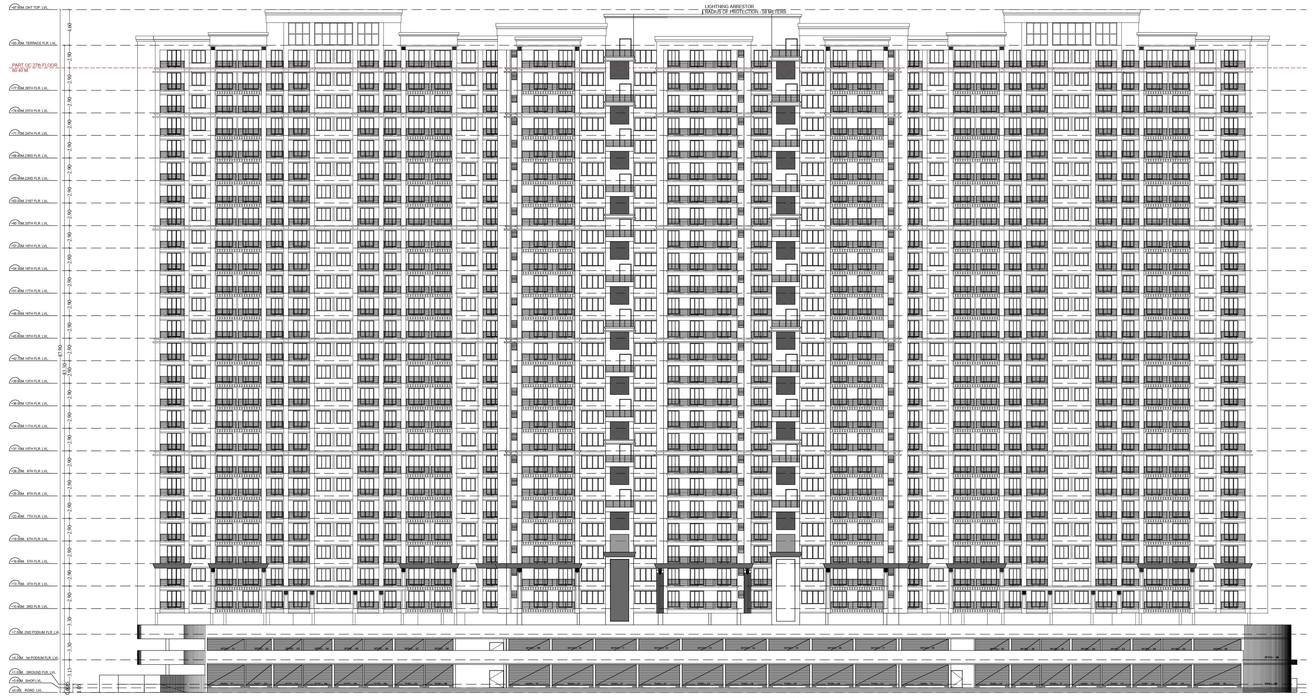

WING-A' FRONT SIDE ELEVATION WING-B' FRONT ELEVATION - (BLDG-1,WING A,B& C) WING-C'

SCALE 1:200

(COMMERCIAL BUILDING) 22 / 25

CONTENTS OF SHEET

ELEVATIONS OF BLDG 1

STAMP AND DATE OF APPROVAL OF PLAN

PART OC

This Part Occupancy Certificate is issued for Sale Building no 1 (A ,B ,C) (Till 26th Floor) & Building no 2 (Till 30th Floor), and As Built drawing is approved subject to conditions as mentioned in Part Occupancy Certificate bearing no. NAINA/8529/2021-CIDCO/NAINA/PANVEL/Kolkhe BP- 00112/Part/ OC/ 2022/ 0217A. Dated 24.06.2022.

RAJA BHAGUJI WAGHMARE

Digitally signed by RAJA BHAGUJI WAGHMARE
Date: 2022.06.24 19:47:03 +05'30'

DESCRIPTION OF PROPOSAL & PROPERTY



CONTENTS OF SHEET


SECTION - 'A-A' (BLDG NO.1, WING A,B & C)
SECTION - 'Z-Z' (MADE UP LVL)

STAMP AND DATE OF APPROVAL OF PLAN


PART OC
This Part Occupancy Certificate is issued for Sale Building no 1 (A ,B ,C) (Till 26th Floor) & Building no 2 (Till 30th Floor), and As Built drawing is approved subject to conditions as mentioned in Part Occupancy Certificate bearing no. NAINA/6529/2021-CIDCO/NAINA/PANVEL/Kolkhe/ BP- 00112/Part/ OC/ 2022/ 0217A. Dated 24.06.2022.


RAJA BHAGUJI WAGHMARE

Digitally signed by RAJA BHAGUJI WAGHMARE
Date: 2022.06.24 19:48:02 +05'30'

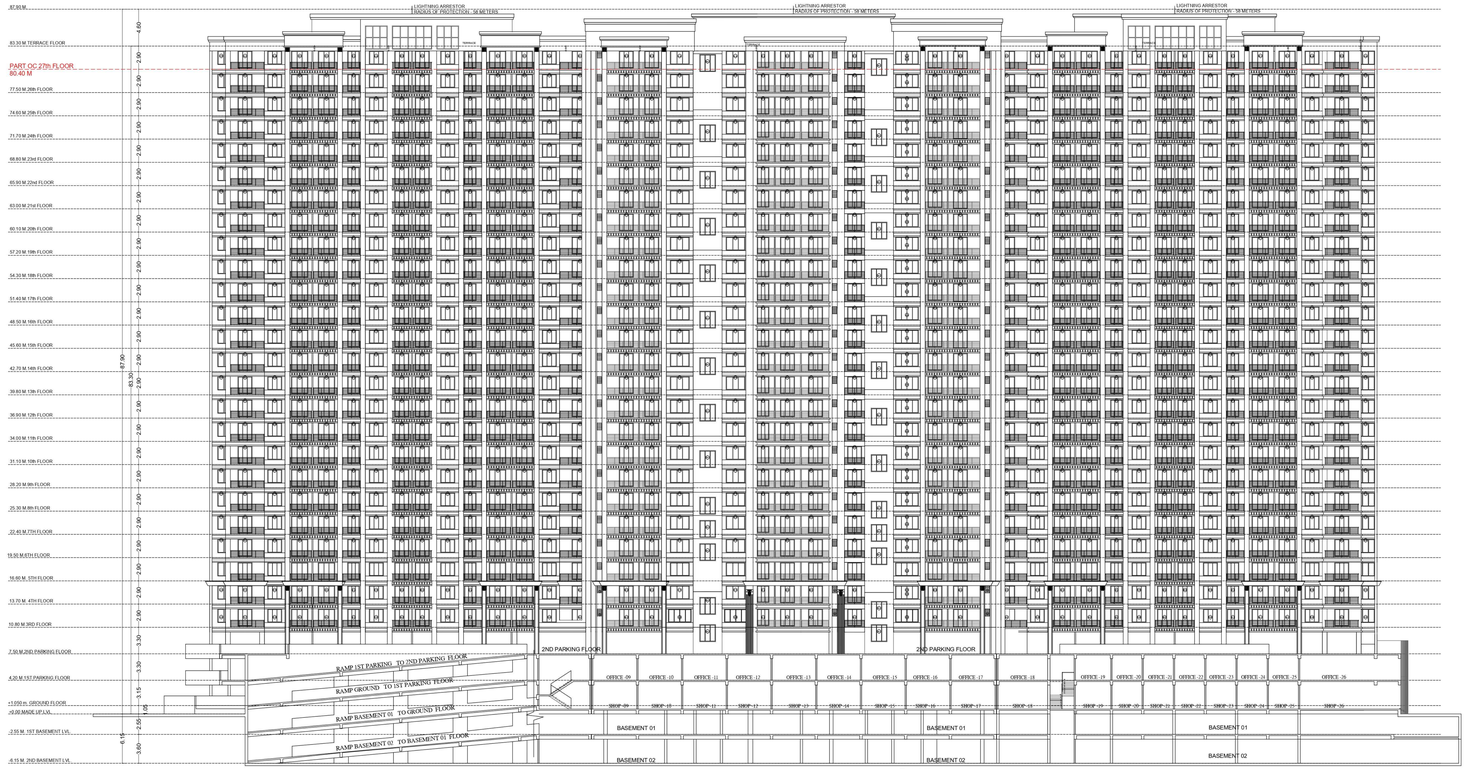

SECTION A-A

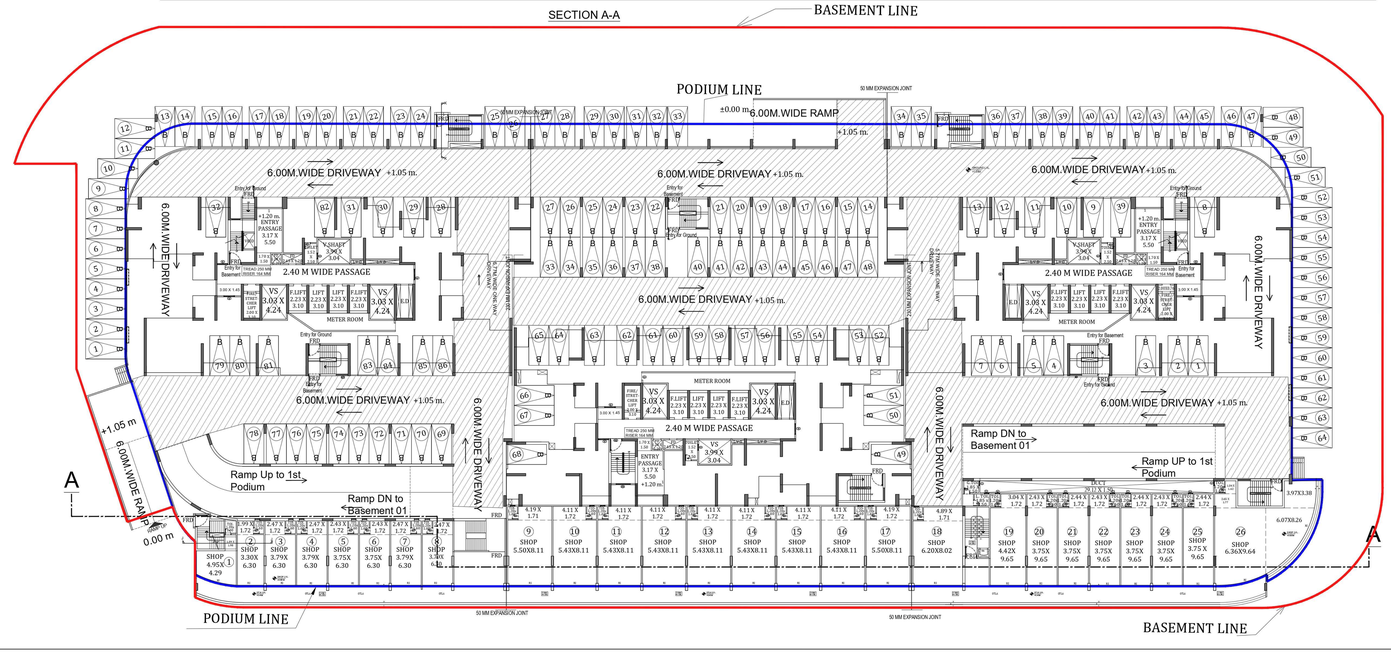

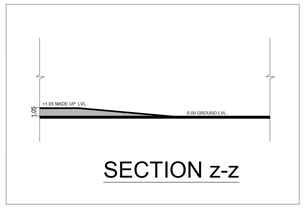

SECTION z-z

DESCRIPTION OF PROPOSAL & PROPERTY

PROPOSED DEVELOPMENT FOR RENTAL HOUSING SCHEME ON LAND BEARING S.NO.95/1(pt), 95/2(pt),95/3A(pt),98/1,98/2,98/3,98/4A/8/1,98/4/8/2,98/5(pt),98/7/5(pt),98/8,98/9, 98/10A,98/10B,98(pt),101/3,101/4/A,101/4/B,101/4/C,101/5,101/6,101/7,101/8A,101/9B,101/9, 

NORTH	JOB. NO.	DRG. NO.	DRAWN BY
		23 / 25	
	SCALE	DATE	CHECKED BY
	1:200	-	
REVISIONS	DESCRIPTION :		
R.0	-		

NAME OF THE OWNER

M/S. PARADISE LIFESPACES LLP.
(P.O.A.H. of Shri. Esmail Ebrahim Dhanwala & others)

MANISH MADHU BATHIJA

NAME & ADDRESS OF THE DESIGN ARCHITECT:	
NAME OF ARCHITECT	M/s. DIMENSION ARCHITECTS
LICENSE NO	CA/ /
ADDRESS	PLOT NO.99, NEAR SAGAR VIHAR, SECTOR-08, VASHI, NAVI MUMBAI 400 703
NAME OF ARCHITECT	DEVYANI KHADILKAR
LIC. NO	CA/90/13184
ADDRESS	B-106, Natraj Building, Mulund Goregaon Link Road Mulund (w), Mumbai - 400 080

CONTENTS OF SHEET


SECTION - 'A -A' (BLDG NO.2)
SECTION - 'B -B' (BLDG NO.1, WING B)
SECTION - 'C -C' (BLDG NO.1, WING B)

STAMP AND DATE OF APPROVAL OF PLAN


PART OC
This Part Occupancy Certificate is issued for Sale Building no 1 (A ,B ,C) (Till 26th Floor) & Building no 2 (Till 30th Floor), and As Built drawing is approved subject to conditions as mentioned in Part Occupancy Certificate bearing no. NAINA/6529/2021-CIDCO/NAINA/PANVEL/Kolkhe/ BP- 00112/Part/ OC/ 2022/ 0217A. Dated 24.06.2022.


RAJA BHAGUJI WAGHMARE

Digitally signed by RAJA BHAGUJI WAGHMARE
Date: 2022.06.24 19:48:48 +05'30'

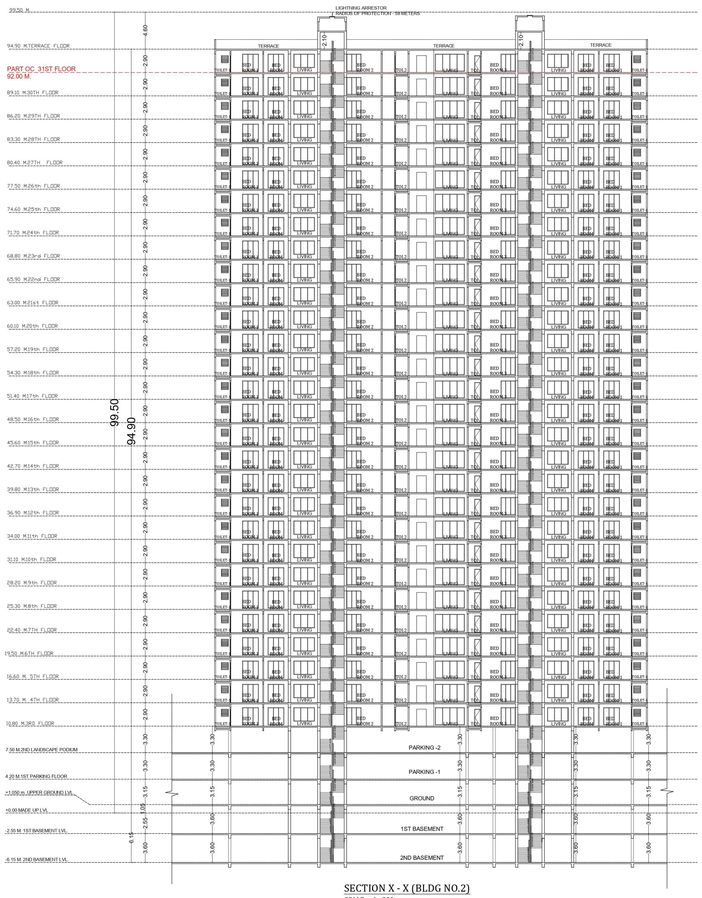


SECTION X - X (BLDG NO.2)
SCALE = 1 : 200

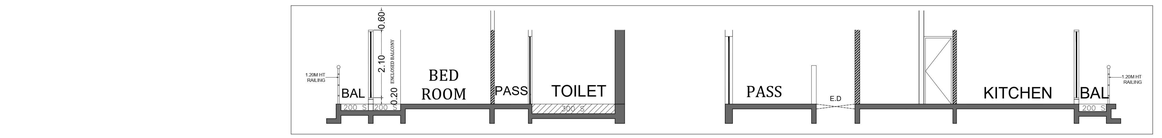


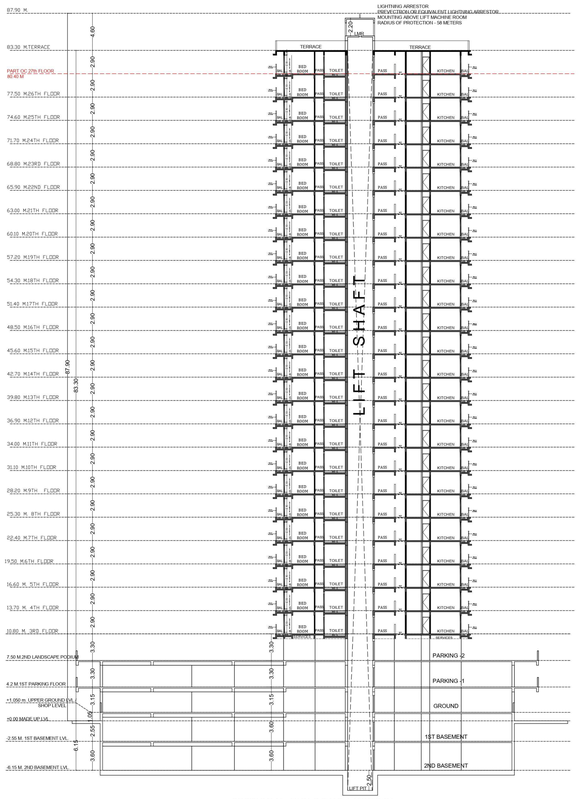



SECTION Y - Y(BLDG NO.1 WING B)
SCALE = 1 : 200

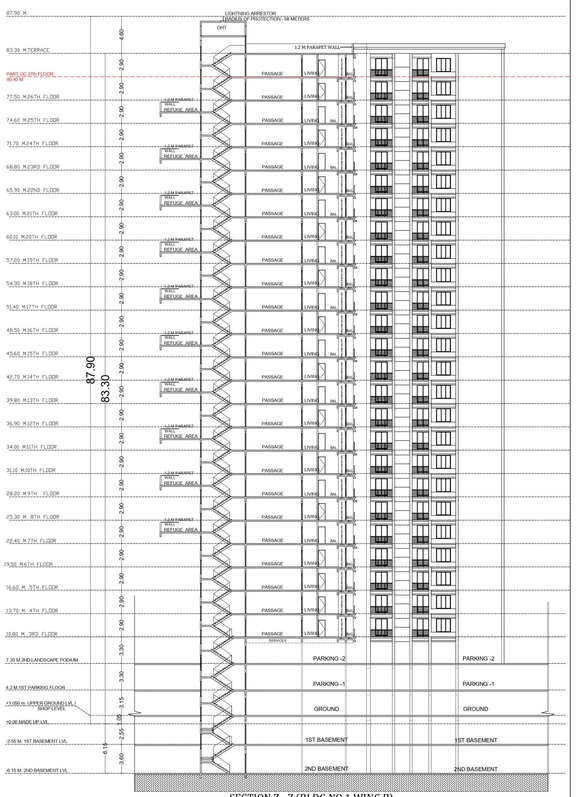

SECTION Z - Z (BLDG NO.1 WING B)
SCALE = 1 : 200

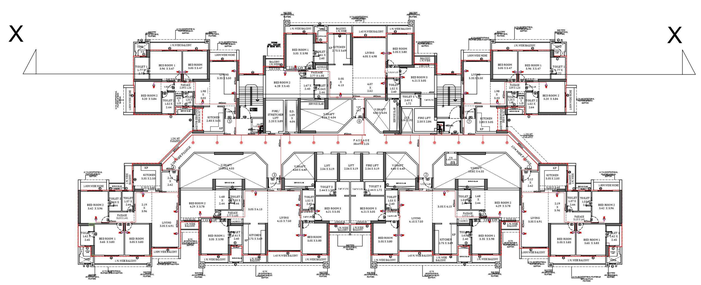

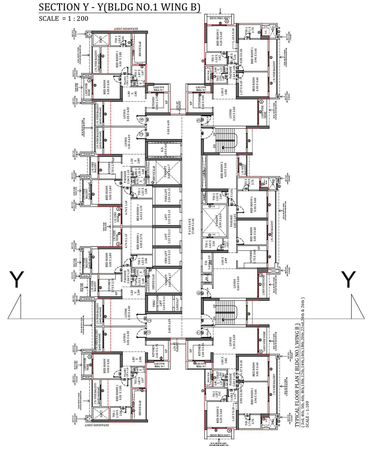

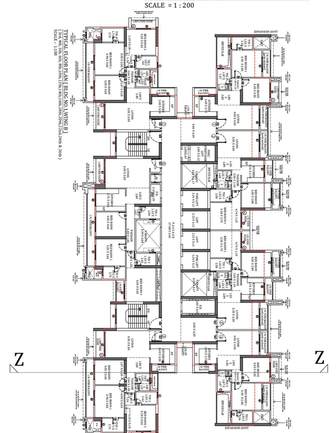

DESCRIPTION OF PROPOSAL & PROPERTY


PROPOSED DEVELOPMENT FOR RENTAL HOUSING SCHEME ON LAND BEARING S.NO.95/1(pt), 95/2(pt),95/3A(pt),98/1,98/2,98/3,98/4A,98/4/B/1,98/4/B/2,98/5(pt),98/7/2(pt),98/8,98/9, 98/10A/B/108,99(pt),101/3,101/4/A,101/4/B,101/4/C,101/5,101/6,101/7,101/8A,101/8B,101/9, 101/10/A,101/10/B,102,103/1,103/2(pt),103/3,103/4,110/1A(pt),110/2/A,110/5A,110/6A,110/10, 110/11 at Village Kolkhe, Taluka - Panvel, District Raigad

NORTH	JOB. NO.	DRG. NO.	DRAWN BY
		24 / 25	
	SCALE	DATE	CHECKED BY
	1 : 200	-	-
REVISIONS	DESCRIPTION :		
R-0	-		
NAME OF THE OWNER			

M/S. PARADISE LIFESPACES LLP.
(P.O.A.H. of Shri. Esmail Ebrahim Dhariwala & others)


MANISH MADHU BATHIJA

NAME & ADDRESS OF THE DESIGN ARCHITECT:		
NAME OF ARCHITECT	M/s. DIMENSION ARCHITECTS	
LICENSE NO	CA/ /	
ADDRESS	PLOT NO.99, NEAR SAGAR VIHAR, SECTOR 08, VASHI, NAVI MUMBAI 400 703	
NAME OF ARCHITECT	DEVYANI KHADILKAR	
LIC. NO	CA/90/13184	
ADDRESS	B-106, Natraj Building, Mulund Goregaon Link Road Mulund (w), Mumbai : 400 080	

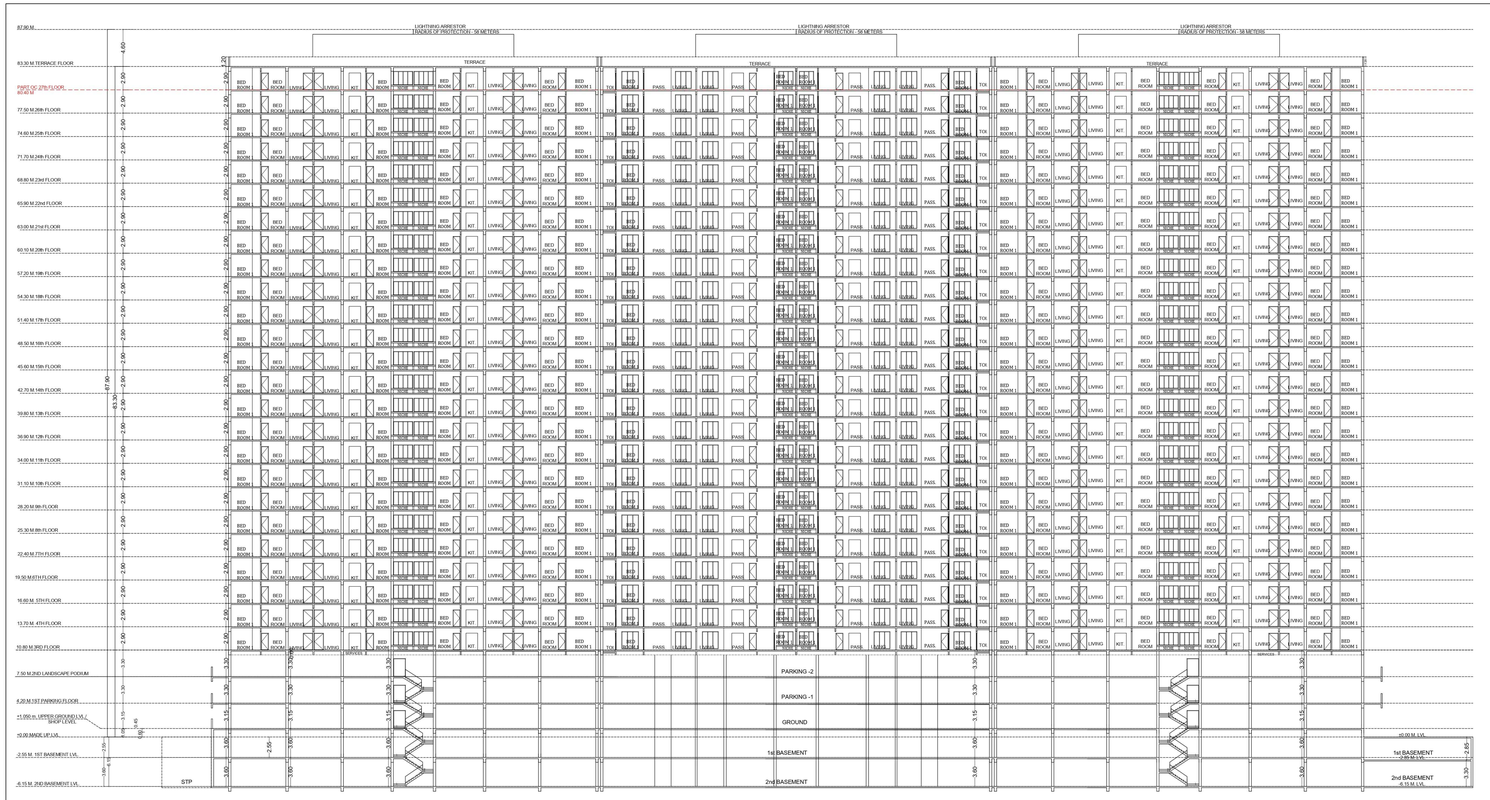


SECTION D - D (BLDG NO.1, WING A,B & C)


SCALE = 1 :200

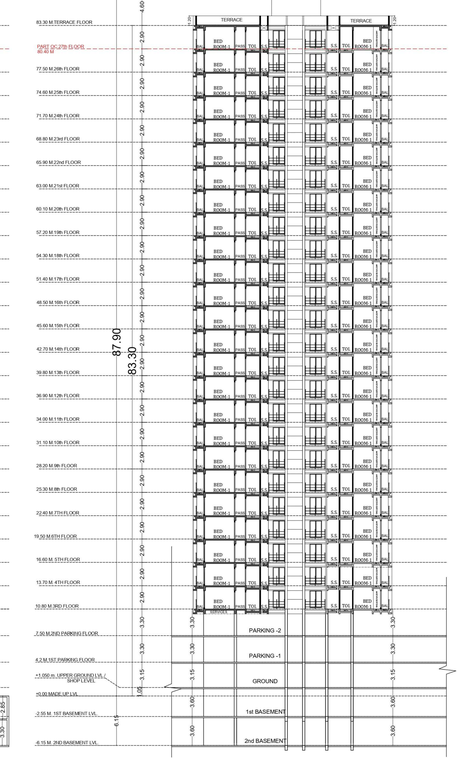


SECTION E - E (BLDG NO.1, WING A)

SCALE = 1 :200

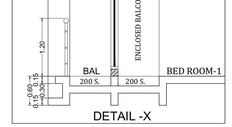

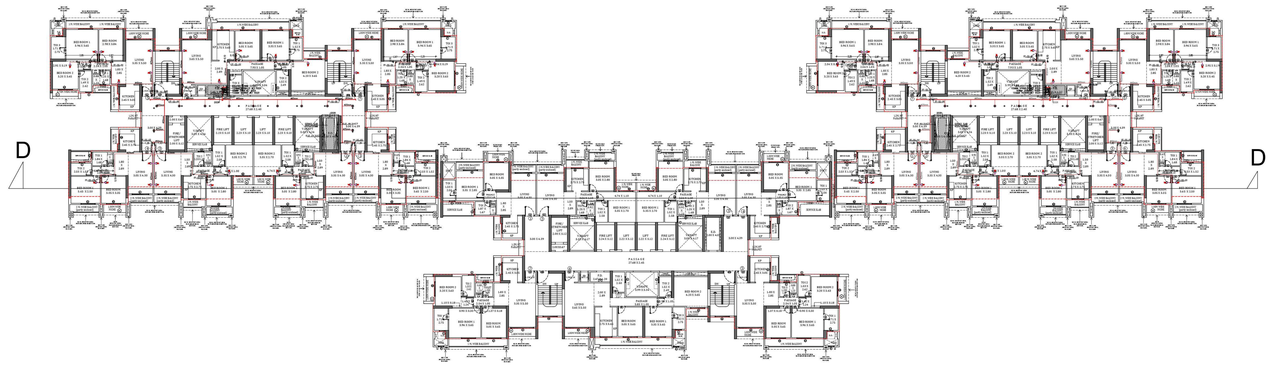

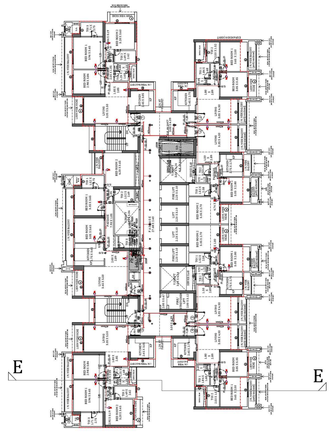

CONTENTS OF SHEET

SECTION - 'A -A' (BLDG NO.1, WING A,B & C)
SECTION - 'E -E' (BLDG NO.1, WING A)

STAMP AND DATE OF APPROVAL OF PLAN

PART OC

This Part Occupancy Certificate is issued for Sale Building no 1 (A ,B ,C) (Till 26th Floor) & Building no 2 (Till 30th Floor), and As Built drawing is approved subject to conditions as mentioned in Part Occupancy Certificate bearing no. NAINA/6529/2021-CIDCO/NAINA/PANVEL/Kolkhe/ BP--00112/Part/ OC/ 2022/ 0217A. Dated 24.06.2022.

RAJA BHAGUJI WAGHMARE

Digitally signed by RAJA BHAGUJI WAGHMARE
Date: 2022.06.24 19:50:22 +05'30'

DESCRIPTION OF PROPOSAL & PROPERTY

PROPOSED DEVELOPMENT FOR RENTAL HOUSING SCHEME ON LAND BEARING S.NO.95/1(pt), 95/2(pt),95/3A(pt),98/1,98/2,98/3,98/4A,98/4/B/1,98/4/B/2,98/5(pt),98/6,98/9, 98/10A,98/10B,99(pt),101/1/1/A,101/4/B,101/4/C,101/5,101/6,101/7,101/8A,101/9B,101/9, 101/10/A,101/10/B,102,103/1,103/2(pt),103/3,103/4,110/1A(pt),110/4,110/5A,110/6A,110/10, 110/11 at Village Kolkhe, Taluka - Panvel, District Raigad.

NORTH	JOB. NO.	DRG. NO.	DRAWN BY
		25 / 25	
	SCALE	DATE	CHECKED BY
	1: 200		
REVISIONS	DESCRIPTION :		
R-0			

NAME OF THE OWNER

MANISH MADHU BATHIJA

M/S. PARADISE LIFESPACES LLP.
(P.O.A.H. of Shri. Esmail Ebrahim Dhariwala & others)

NAME & ADDRESS OF THE DESIGN ARCHITECT:

NAME OF ARCHITECT	M/s. DIMENSION ARCHITECTS
LICENSE NO	CA/ /
ADDRESS	PLOT NO.99, NEAR SAGAR VIHAR, SECTOR-08, VASHI, NAVI MUMBAI 400 703.
NAME OF ARCHITECT	DEVYANI KHADILKAR
LIC. NO	CA/90/13184
ADDRESS	B-106, Natraj Building, Mulund Goregaon Link Road Mulund (w), Mumbai - 400 080