
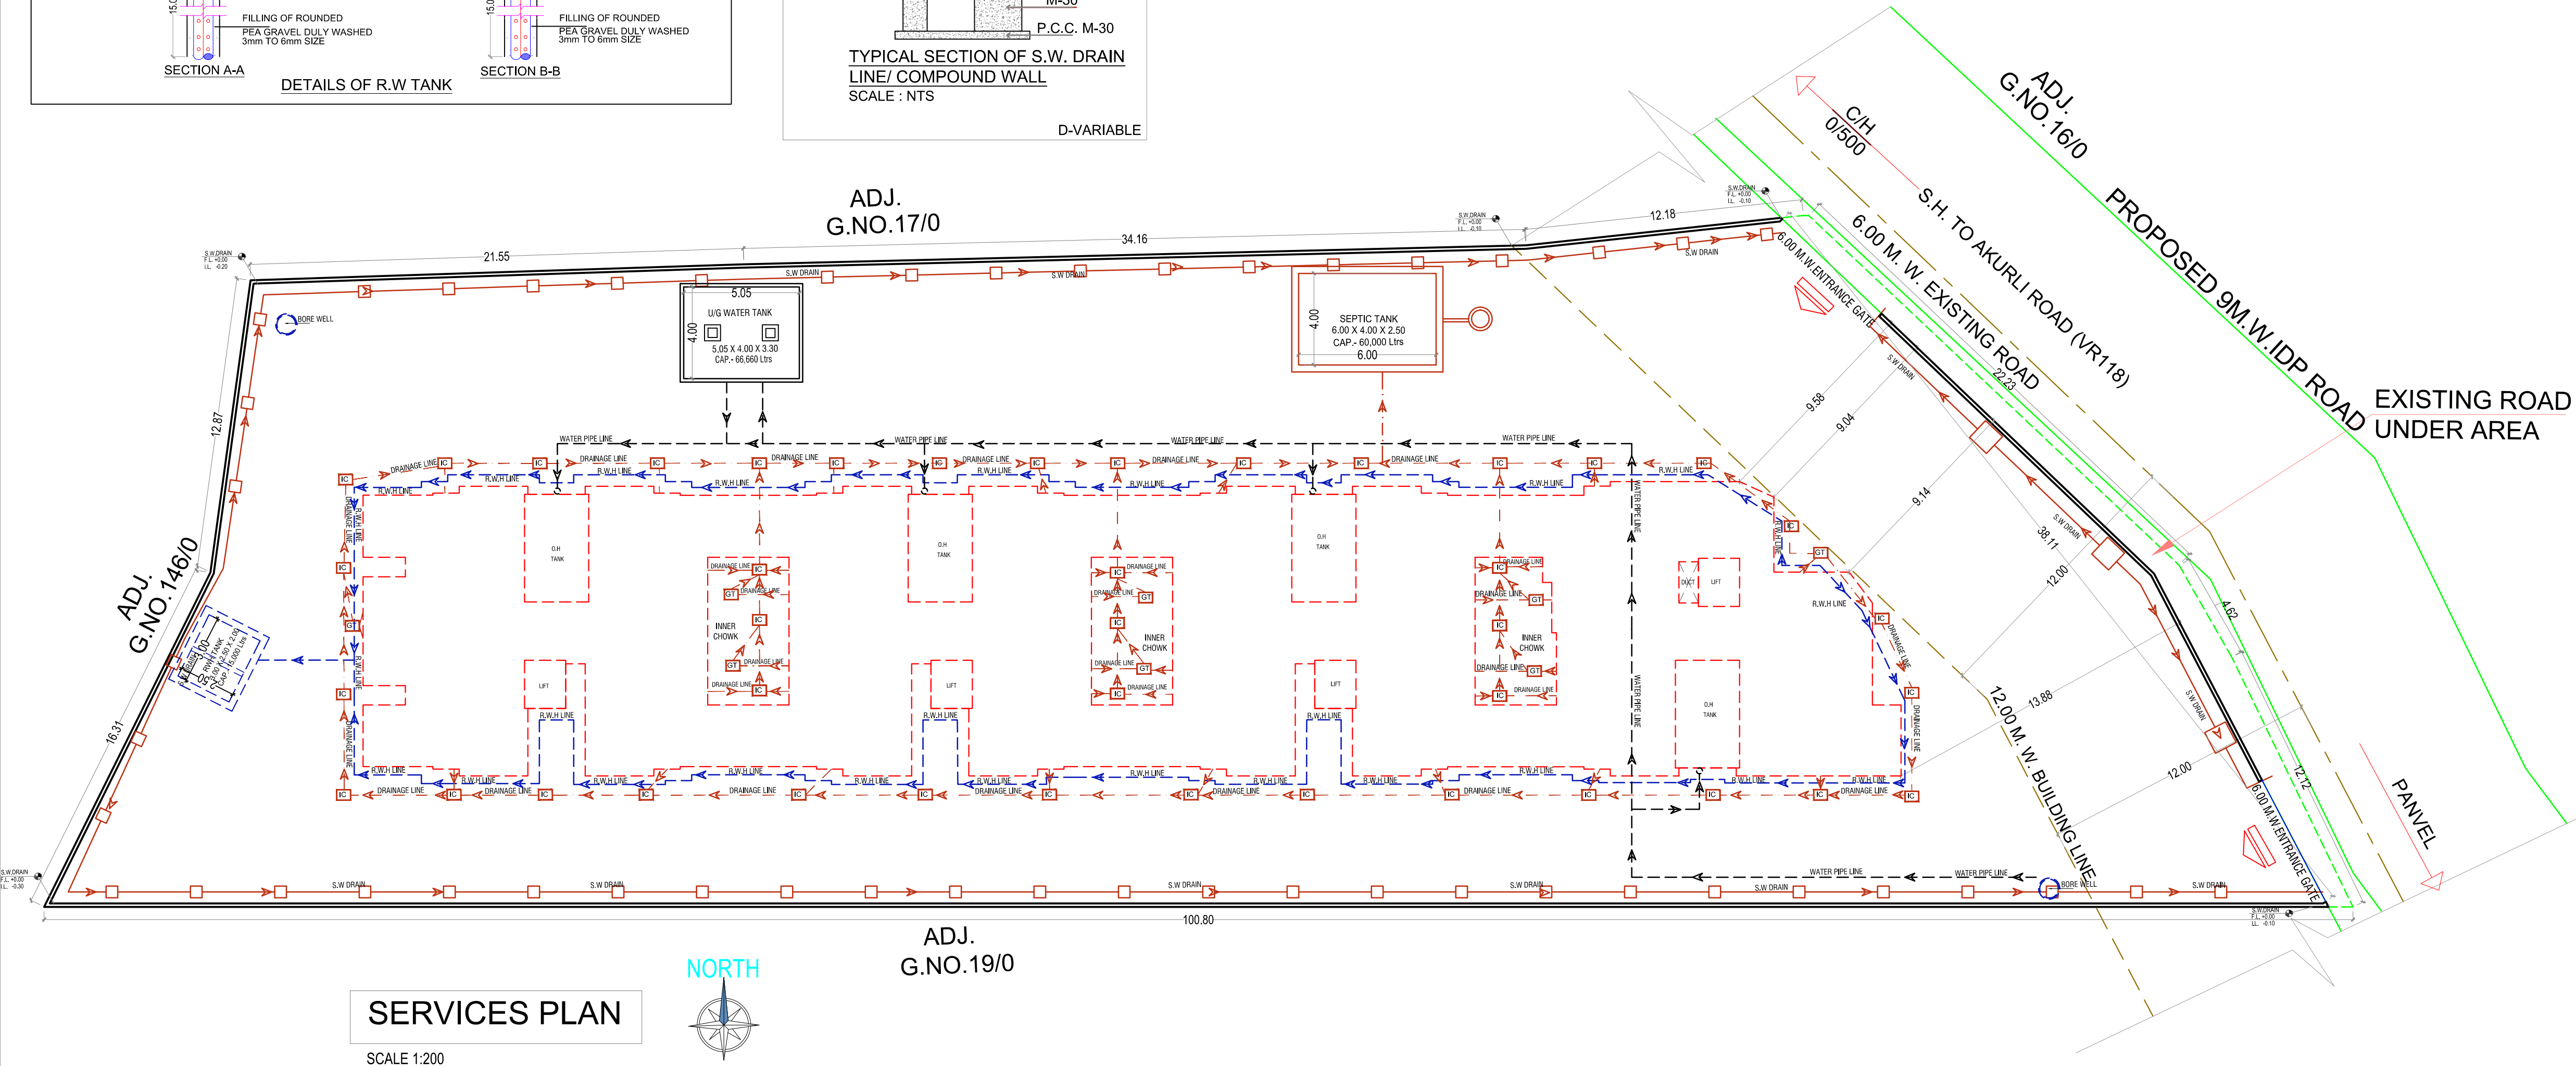
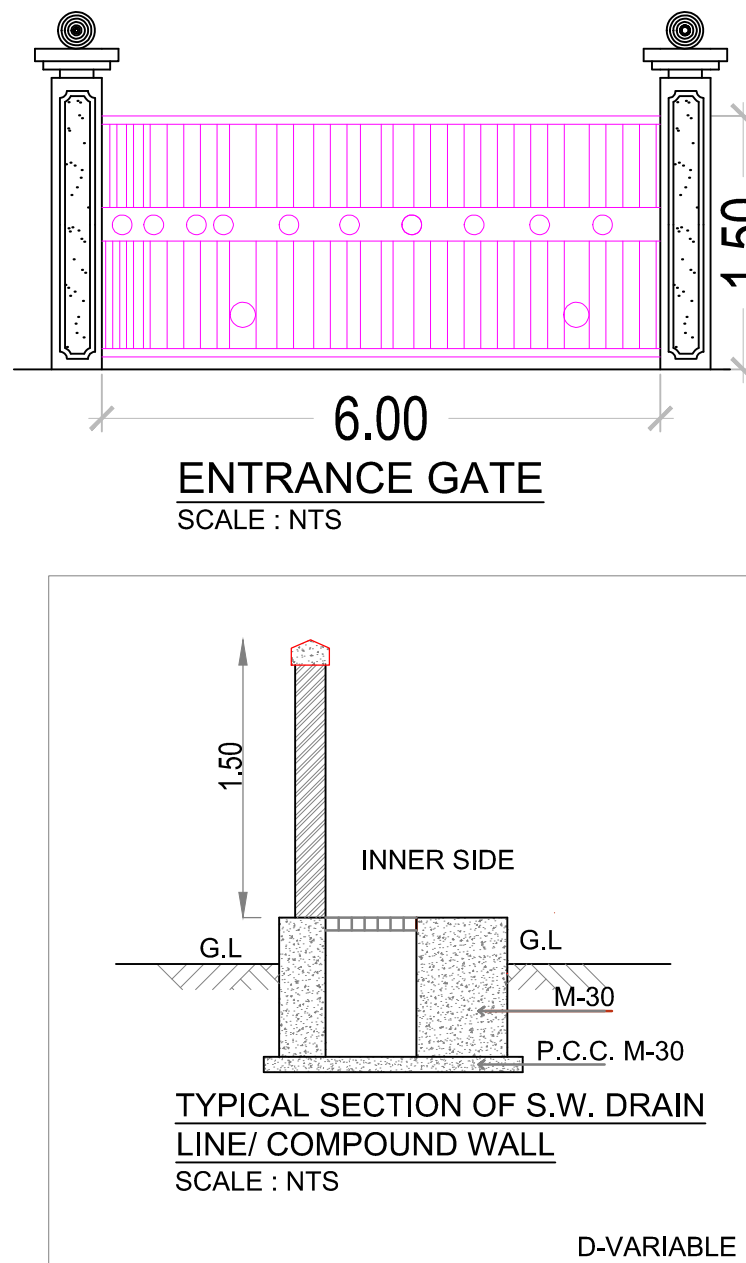


SEPTIC TANK REQUIRMENT										
BUILDING NUMBER	NUMBER OF TENEMENT	POPULATION	WATER REQUIREMENT				% FLOW TO SEWER		TOTAL FLOW	TOTAL PROVIDED SEPTIC TANK CAPACITY
			FLUSHING	DOMESTIC		TOTAL	FLUSHING 100%	DOMESTIC 85%		
1			LPCD	LPD	LPCD	LPD	LPD	LPD	LPD	
	67	335	54	18090	135	45225	63315	18090	38441.25	56531.25
	ADD. TOILETS	8	54	432	126	1008	1440	432	856.80	1288.80
	TOTAL		—	18522	—	46233	64755	18522	39298.05	57820.05
										6.00X 4.00 X 2.50
										60,000

WATER STORAGE CAPACITY CALCULATION									
BUILDING NUMBER	TOTAL NUMBER OF UNITS	ADDITI ONAL TOILET	POPULATION	WATER REQUIREMENT (IN LITRE)		UNDER GROUND WATER TANK PROVIDED			
				ADDL. TOILET (180 LITRE)	POPULATION (189 LITRE)	TOTAL	TANK NUMBER	SIZE /DIMENSION	CAPACITY (LITRE)
1	67	8	335	1440	63315	64755	1	8.00X 4.00 X 3.30	66,660

OVERHEAD WATER TANK CAPACITY CALCULATION					
BUILDING NUMBER	WING	WATER REQUIRED (LITRE) (50% OF UNDER GROUND TANK)	COLD WATER REQUIREMENT		
			TANK SIZE (METRE)	NUMBER OF TANK	CAPACITY (LITRE)
1	WING A	33330	4.40 X 2.50 X 1.20	1	13200
	WING B		4.40 X 2.50 X 1.20	1	13200
	WING C		4.40 X 2.50 X 1.20	1	13200
	WING D		4.40 X 2.50 X 1.20	1	13200
	TOTAL				52800

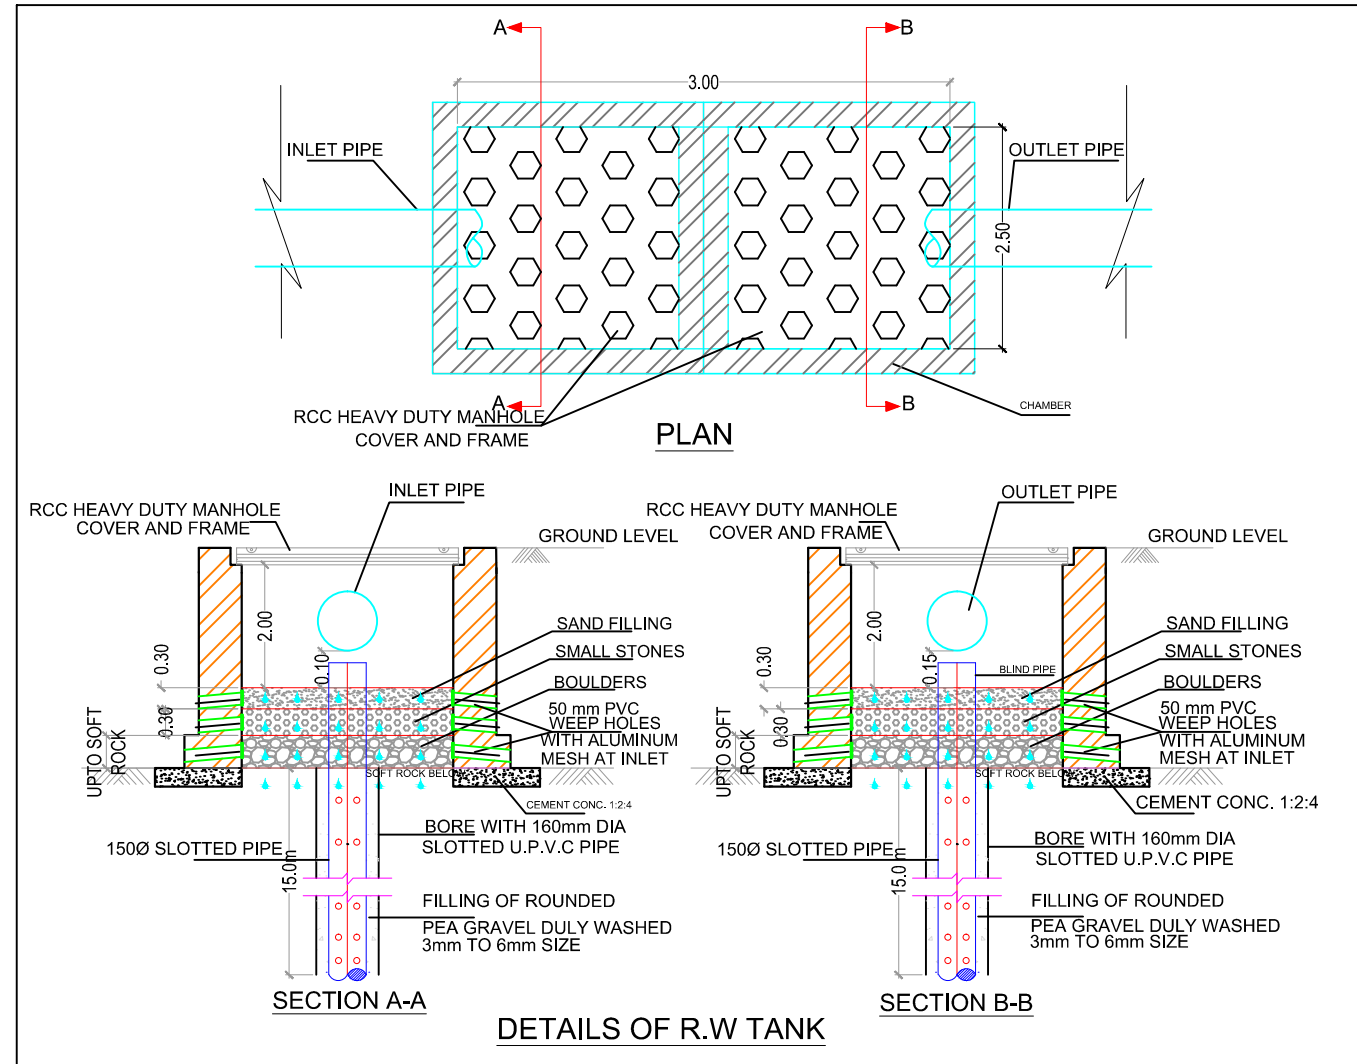

STAMP OF APPROVAL 2/4

This OC as built drawing is approved subject to the conditions mentioned in Occupancy Certificate bearing no. CIDCO/NAINA/Panvel/Akurli/BP-003 85/OC/Full/2022/0160 dated 17 Feb 2022.

Legend :-

Sr.No.	Item	Site Plan On White Print	Building Plan On White Print
01.	Plot Line	—	
02.	Existing Street	—	
03.	Future Street	—	
04.	DAILY BAZAAR	—	
05.	Proposed Work	—	
06.	Drainage & Sewerage Work	—	
07.	Water Supply Work	—	
08.	RWH Line	—	

NOTE:

- ALL DIMENSIONS ARE IN METERS.
- INTERNAL WALL THICKNESS 0.10 M.
- EXTERNAL WALL THICKNESS 0.15 M.

CONTENT OF THE SHEET

SERVICES PLAN, WATER CAPACITY CALCULATION , SEPTIC TANK CALCULATION, SEPTIC TANK & SOAK PIT SECTION ,COMPOUND WALL DETAILS,SECTION OF S.W. DRAIN LINE / COMPOUND WALL , ECCENTRIC FOOTING DETAILS,U.G. TANK DETAILS ,TYPICAL GATE DETAILS, LEGENDS.

NAME OF THE OWNERS & SIGNATURE

For FUTURE HOMES CONSTRUCTIONS  
Partner

M/S FUTURE HOMES CONSTRUCTION THROUGH PARTNER  
DEVRAJ GOKUL RAVARIA  
NAME & SIGNATURE OF OWNER

DESCRIPTION OF PROPOSAL & PROPERTY

PROPOSED DEVELOPMENT PERMISSION ON G.NO. 18/0, VILLAGE - AKURLI , TAL. - PANVEL , DIST. - RAIGAD.

SCALE	22.07.2021
DRN BY	1: 100, 1:200, 1: 500, 1: 5000, N.T.S.
CHKD BY	
	SWARNIL KALYANKAR


NAME & SIGNATURE OF ARCHITECT




(Signature of Architect.)  
AR. SWARNIL KALYANKAR  
REGD. NO. CA / 2010 / 47491

**SKA**  
SWARNIL KALYANKAR ARCHITECTS  
Swarnil Kalyankar | +91 - 99875 96001 | +91-7711000345  
OFFICE A 101,NEEL EMERALD, FINAL PLOT NO. 527 B,  
SAI NAGAR ROAD,NEAR TEHSILDAR OFFICE,PANVEL-410206.  
EMAIL : skaplanners@gmail.com



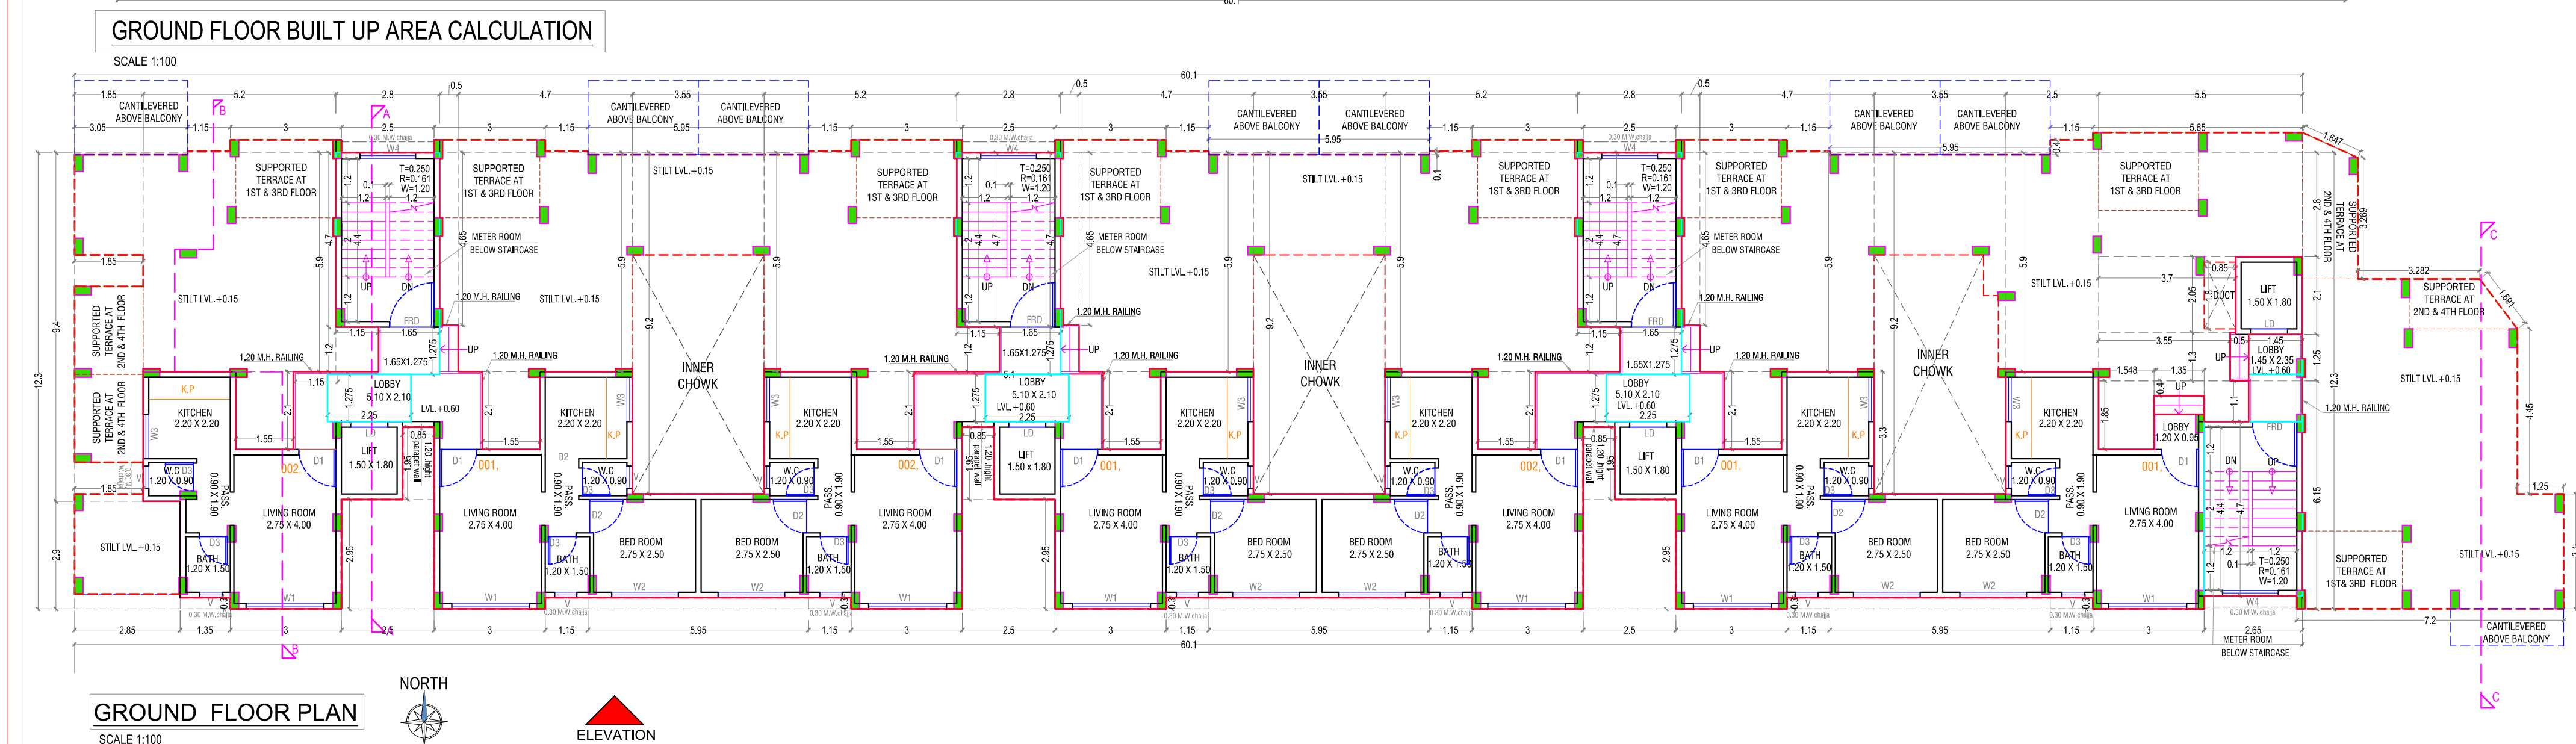

SCHEDULE OF DOOR & WINDOWS				
SIZE				
TYPE	WIDTH (METER)	HEIGHT (METER)	AREA (SQ.M)	DESCRIPTION
FRO	1.20	2.10	2.52	DOOR METAL
D1	1.00	2.10	2.10	T.W. PANEL DOOR
D2	0.90	2.10	1.89	T.W. PANEL DOOR
D3	0.75	2.10	1.58	T.W. PANEL DOOR
DW1	2.10	2.10	4.41	AL SLIDING WINDOW
DW2	1.80	2.10	3.78	AL SLIDING FRENCH WINDOW
DW3	1.20	2.10	2.52	AL SLIDING FRENCH WINDOW
W1	2.10	1.30	2.72	AL SLIDING WINDOW
W2	1.80	1.30	2.34	AL SLIDING WINDOW
W3	1.20	1.30	1.56	AL SLIDING WINDOW
W4	1.50	1.30	1.95	AL SLIDING WINDOW
W5	1.20	1.30	1.56	AL SLIDING WINDOW

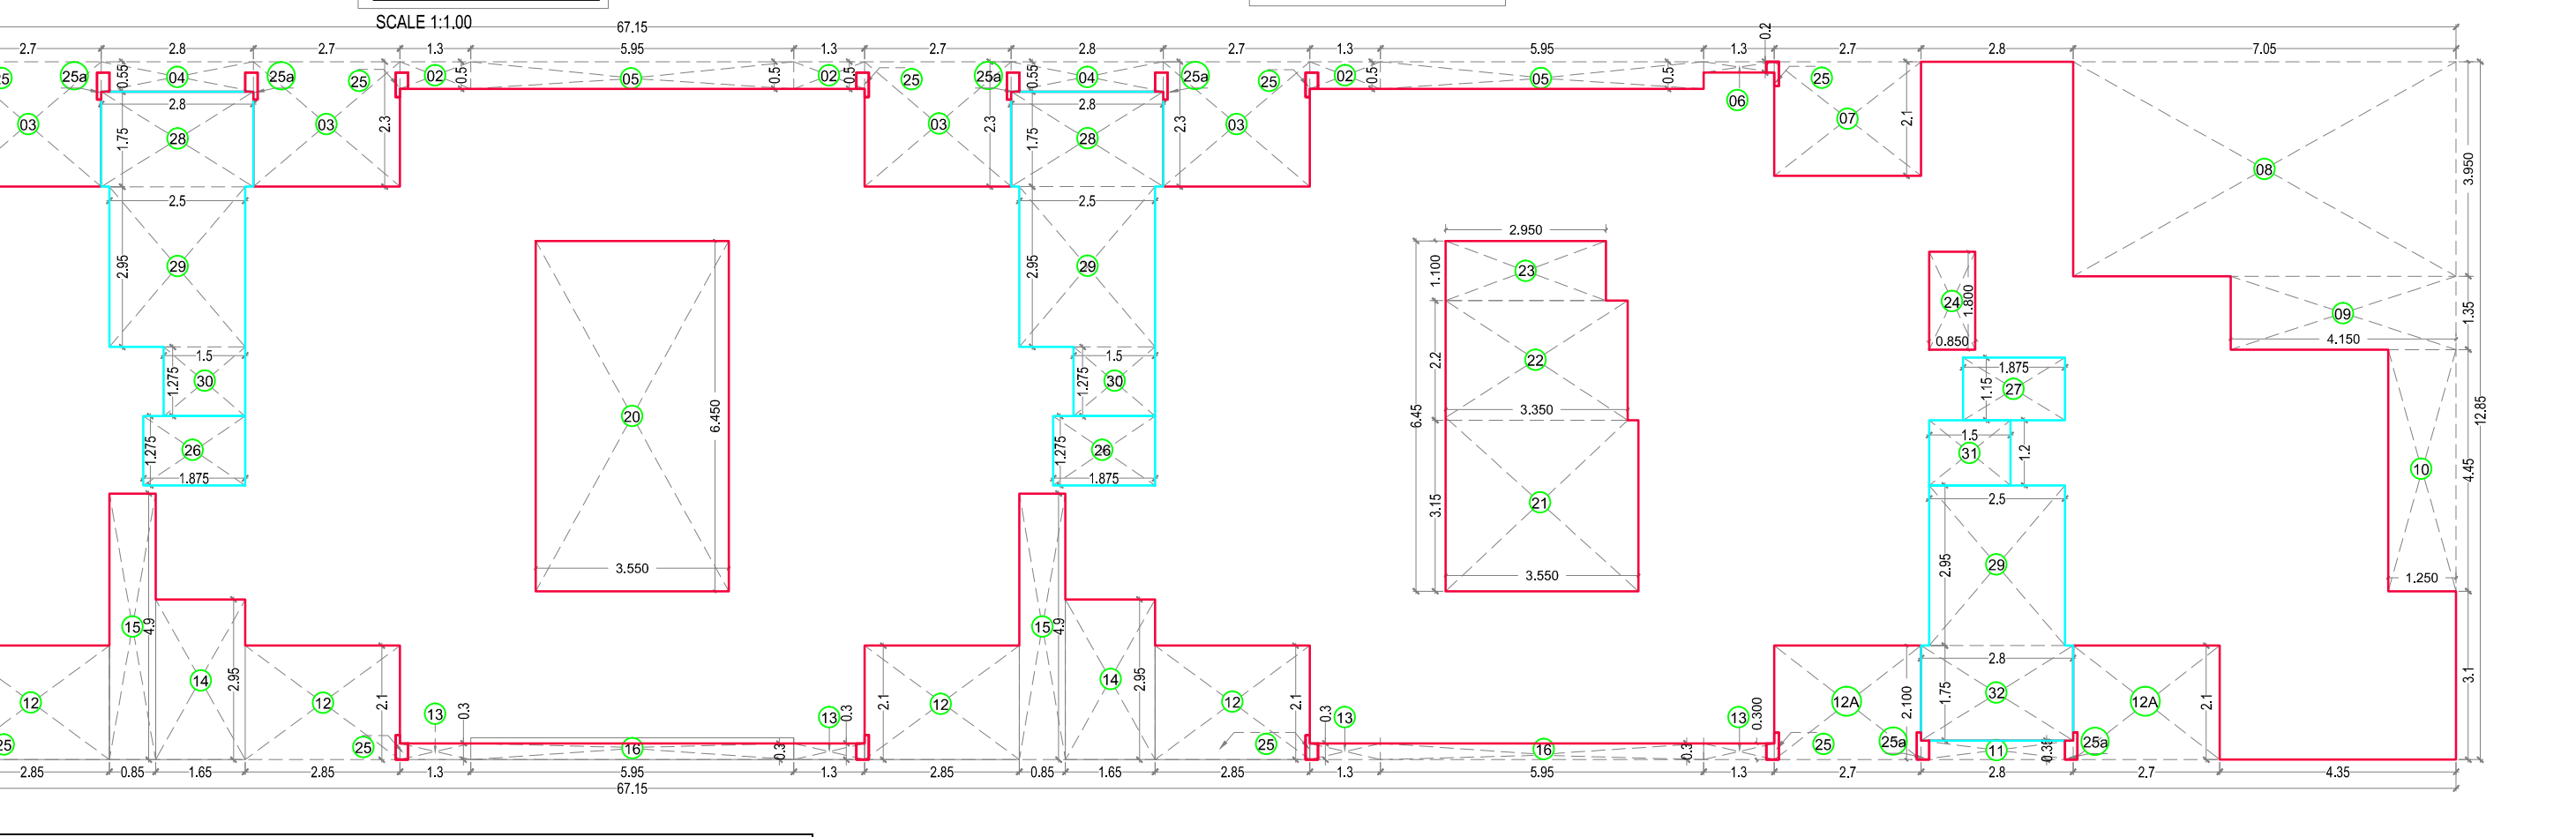

DEDUCTION						
1	1	1.850	9.400	=	17.390	
2	3	5.200	5.900	=	92.040	
3	3	0.500	4.650	=	6.975	
4	3	4.700	5.900	=	83.190	
5	3	3.550	9.200	=	97.980	
6	1	2.500	5.900	=	14.750	
7	1	5.500	2.800	=	15.400	
8	1	3.700	2.650	=	7.585	
9	1	3.550	1.300	=	4.615	
10	1	1.500	1.850	=	2.775	
11	1	1.350	0.400	=	0.540	
12	1	1.200	1.100	=	1.320	
12A	1	1.450	1.075	=	1.559	
12B	1	1.450	1.275	=	1.849	
13	1	2.650	4.700	=	12.455	
13A	1	2.650	0.350	=	0.928	
14	6	1.150	0.300	=	2.070	
15	3	5.950	0.300	=	5.355	
16	3	2.500	2.950	=	22.125	
17	3	0.850	1.950	=	4.973	
18	1	1.350	0.300	=	0.405	
19	1	2.850	2.900	=	8.265	
20	6	1.550	2.100	=	19.530	
21	3	2.800	4.700	=	39.480	
22	3	1.650	1.275	=	6.311	
23	3	2.250	1.275	=	8.606	
23 A	3	1.150	1.200	=	4.140	
SUBTOTAL : B					=	482.610
( SUBTOTAL : C) - ( SUBTOTAL :B)					=	256.620
ADDITION -D						
24	6	AS PER POLYLINE		=	0.216	
25	8	AS PER POLYLINE		=	0.633	
26	19	AS PER POLYLINE		=	1.113	
ADDITION -D					=	1.962
(NET BUILT UP AREA -D) = ( SUBTOTAL : C ) + ( SUBTOTAL :D )					=	258.582


ADDITION -D				
25	14	AS PER POLYLINE	=	1.123
25a	8	AS PER POLYLINE	=	0.739
(NET BUILT UP AREA :D) = ( SUBTOTAL : C) + ( SUBTOTAL :D)				531.609
(GROSS BUILT UP AREA :E) = ( SUBTOTAL : D) + ( SUBTOTAL :E)+EXCESS BALCONY AREA (6.909 SQM)			=	538.518

2ND FLOOR			
TERRACE TYPE	NUMBER OF TERRACE	LENGTH (METER)	BREATH (METER)
T6	2	2.375	1.850
T7	1	3.610	1.500
T8	1	2.391	1.350
TOTAL PROPOSED TERRACE AREA			17.430
NET BUILT UP AREA OF FLOOR			531.609
PERMISSIBLE TERRACE AREA = (NET BUILT UP AREA ) X 20 %			106.322
BALANCE TERRACE AREA			88.891




--	--

For FUTURE HOMES CONSTRUCTIONS  
  
 Partner  
 MIS FUTURE HOMES CONSTRUCTION THROUGH PARTNER  
 DEVIKA GOKUL RAOVARA  
 NAME & SIGNATURE OF OWNER


  
(Signature of Architect.)  
AR, SWAPNIL KALYANKAR  
REGD. NO. CA 2010 / 47481

  
**SWAPNIL KALYANKAR ARCHITECTS**  
Swarn Kalyan, Plot - 28/55 Road 11/1100045  
OFFICE: A-115 KHEL CHENGLAL, PLOT NO. 28/55  
SANGHAR BHAGNAR, THESEDA OFFICE PARK - A-1100  
EMAIL: [skoplaners@gmail.com](mailto:skoplaners@gmail.com)

**SKA**  
SWAPNIL KALYANKAR ARCHITECTS  
Swapnil Kalyankar | +91 - 99875 90011 | 95-7711000  
OFFICE A 101 MEER, EMERALD FINAL PLOT NO. 525  
SAHAGAR ROAD NEAR TEJSHILDA OFFICE, PANVEL - 4  
EMAIL : [skaplanners@gmail.com](mailto:skaplanners@gmail.com)




This OC as built drawing is approved subject to the conditions mentioned in Occupancy Certificate bearing no. CIDCO/NAINA/Panvel/Akurli/BP-00385/OC/Full/2022/0160 dated 17 Feb 2022.

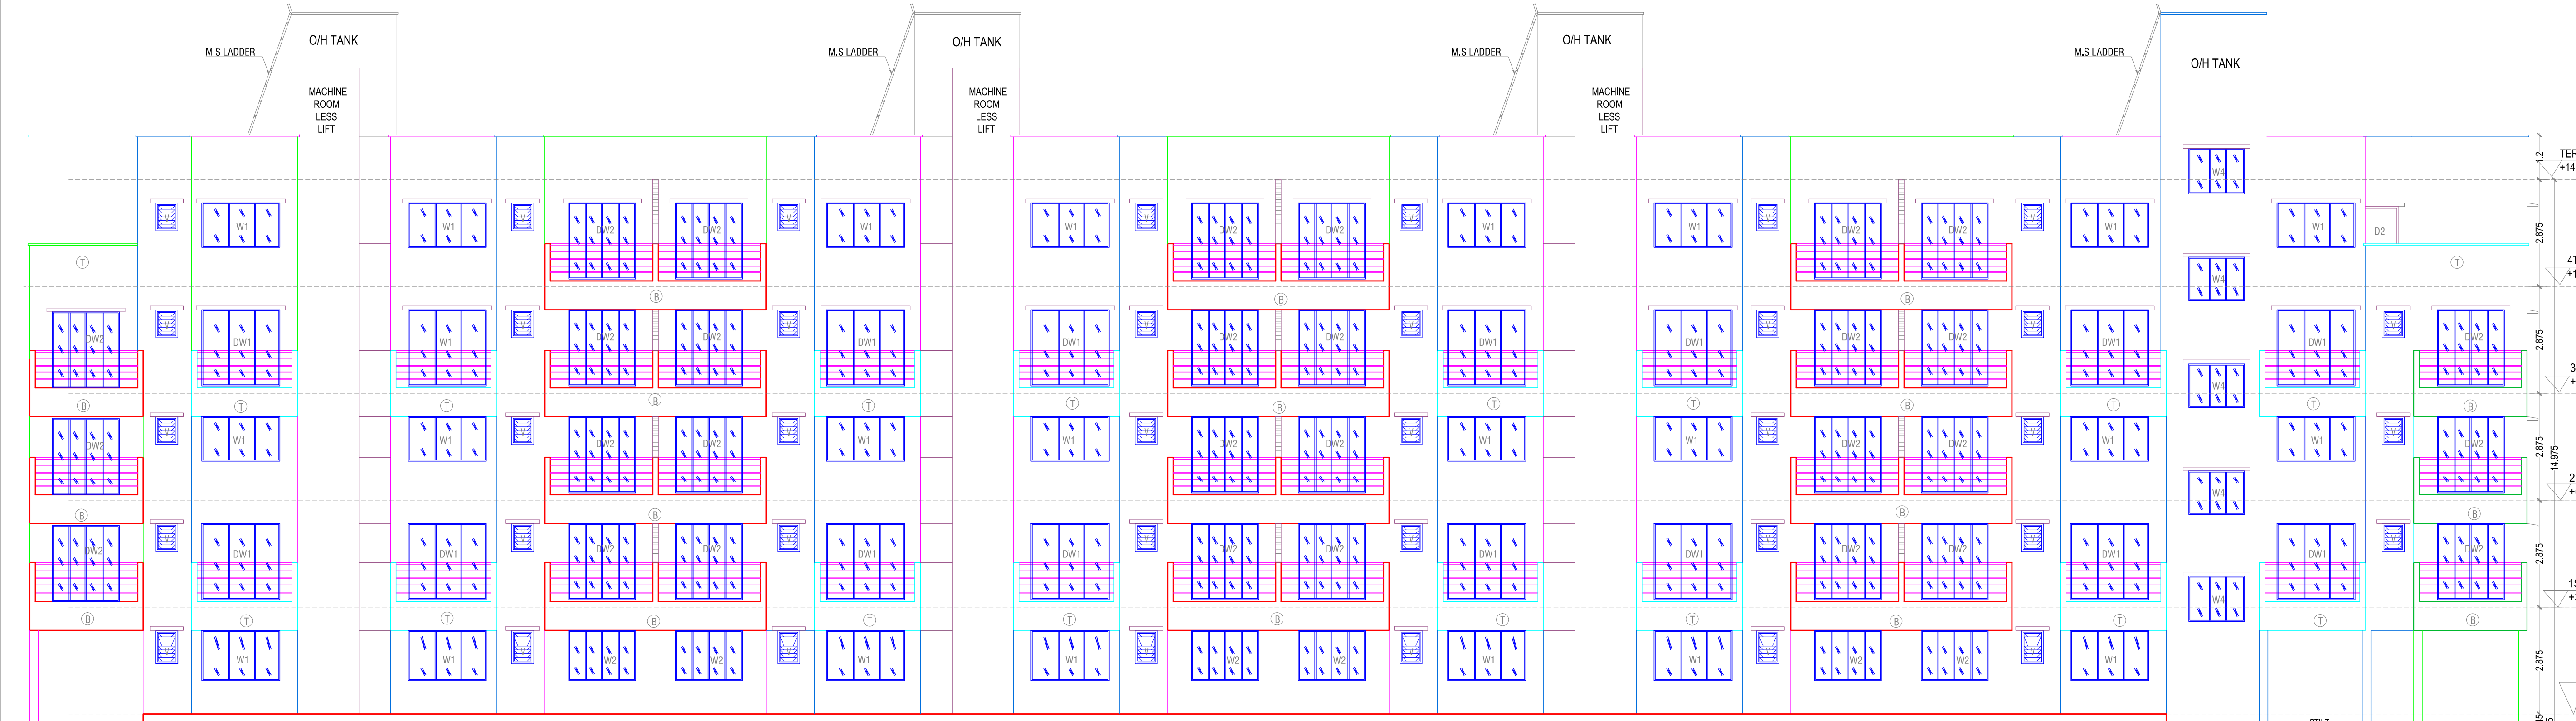


ELEVATION

SCALE 1:100

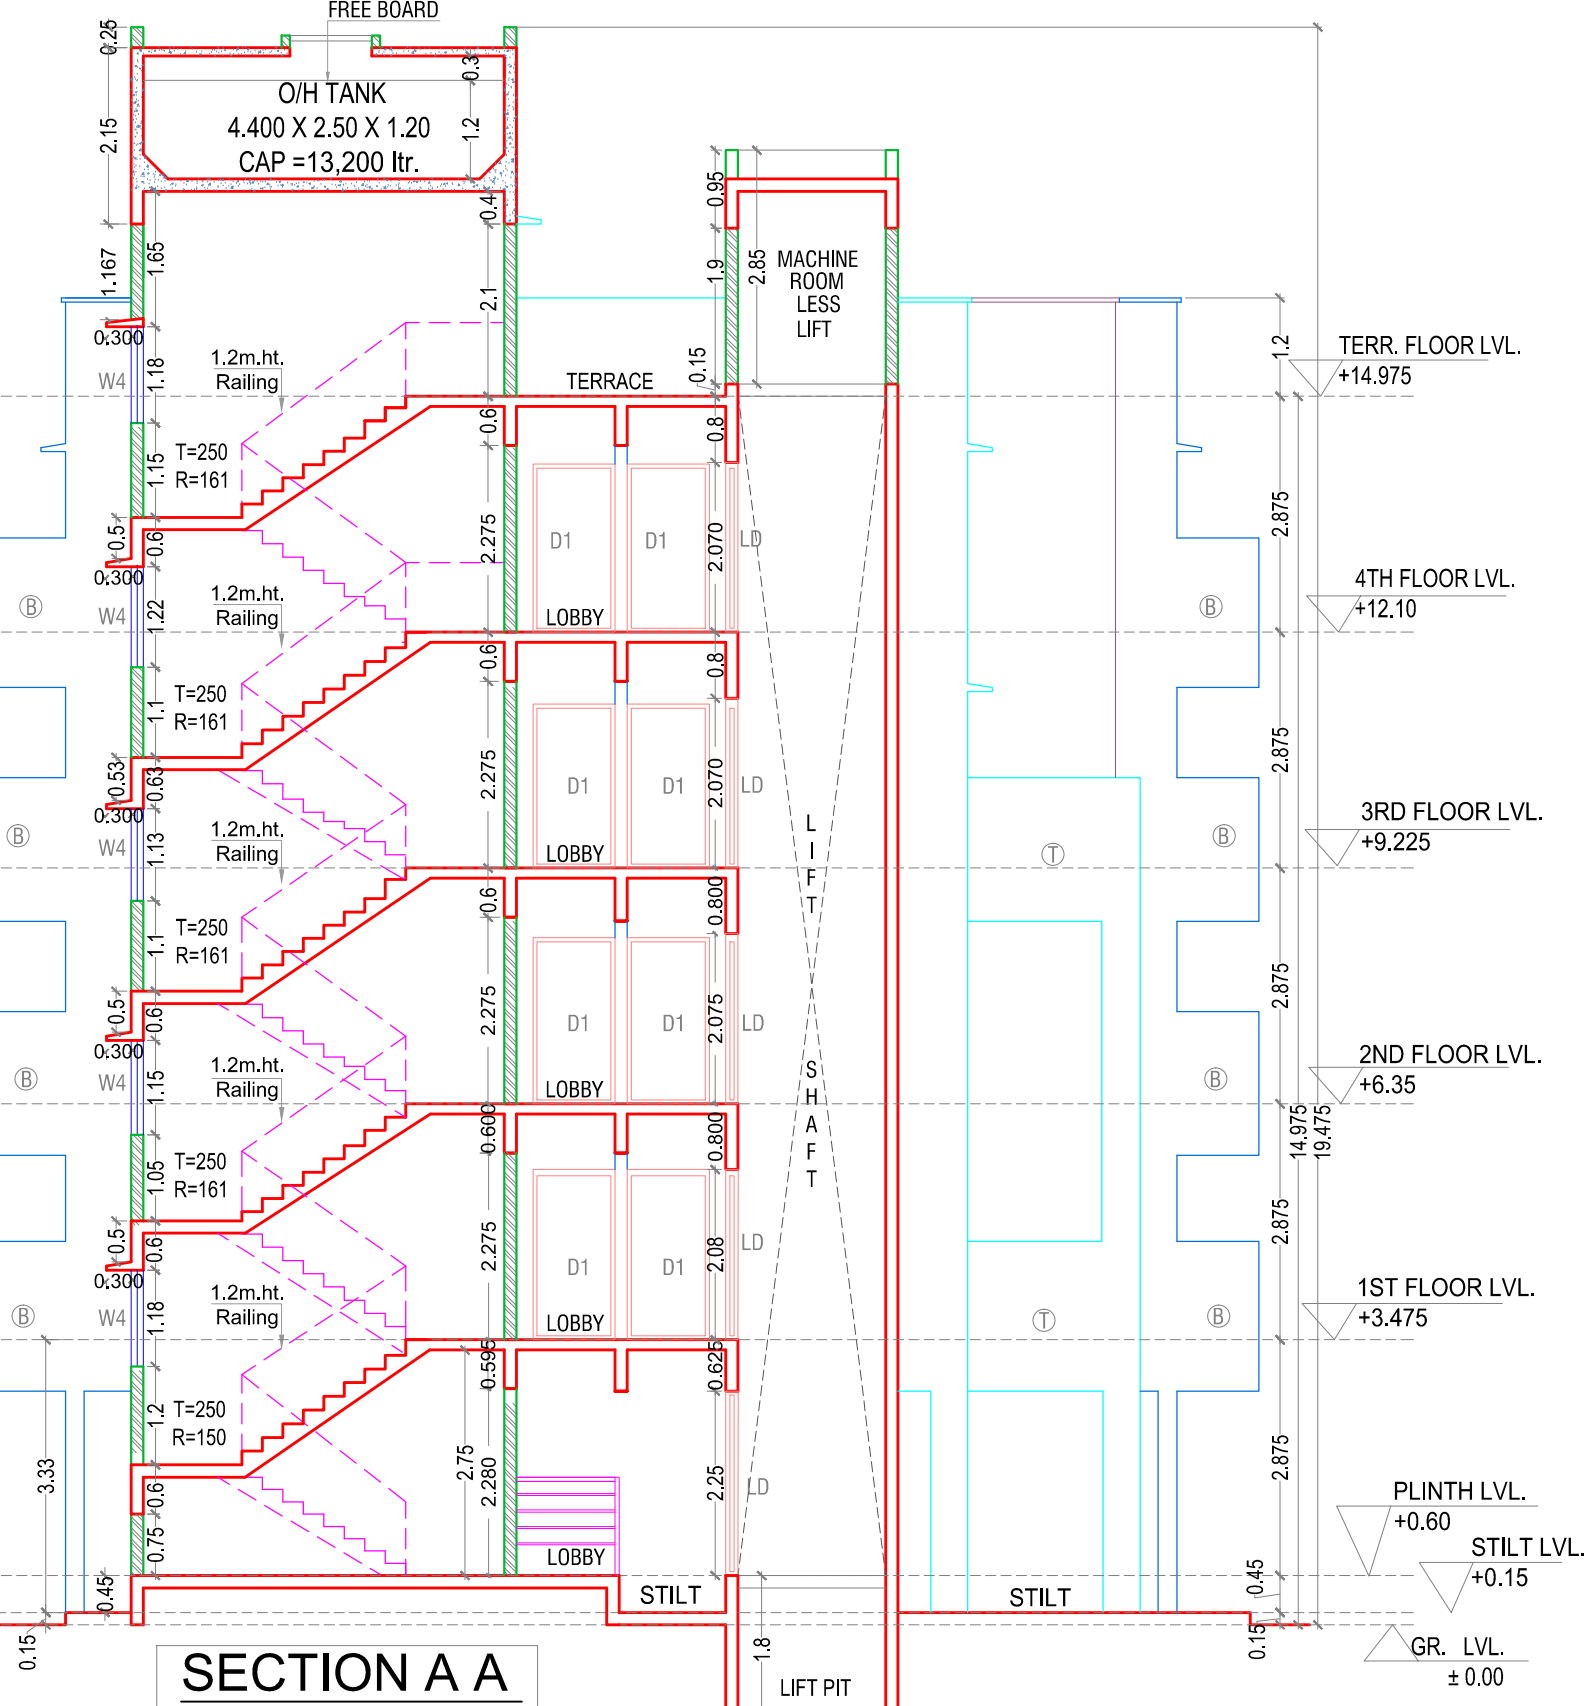

SECTION A A


SCALE 1:100

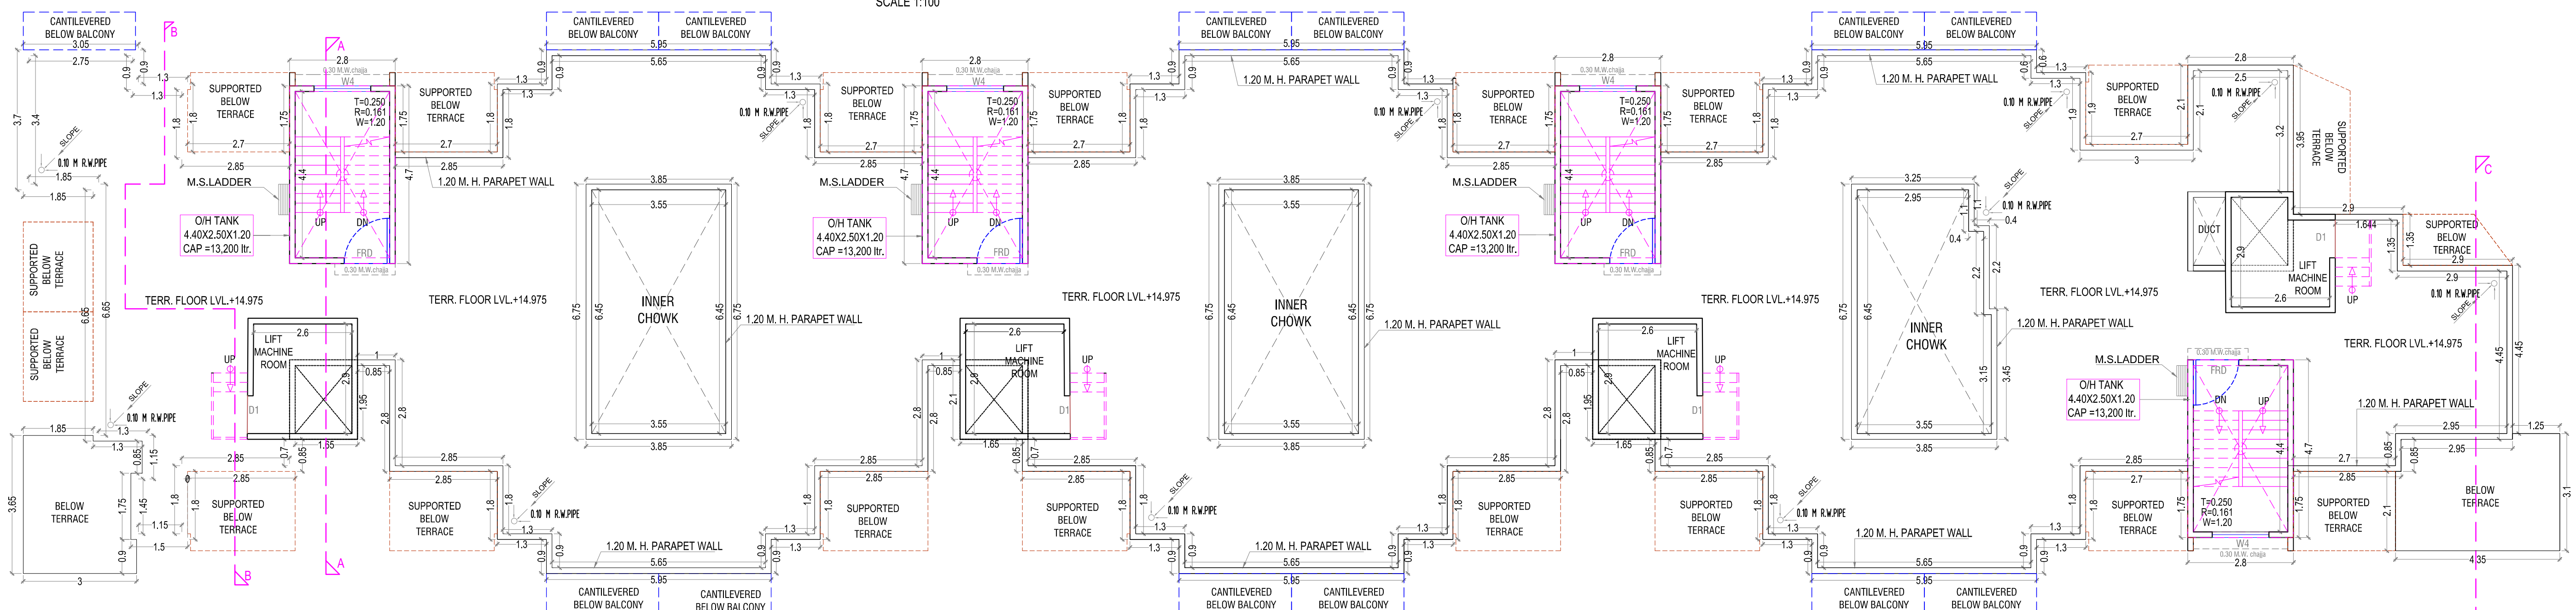

TERRACE FLOOR PLAN


SCALE 1:100

ELEVATION

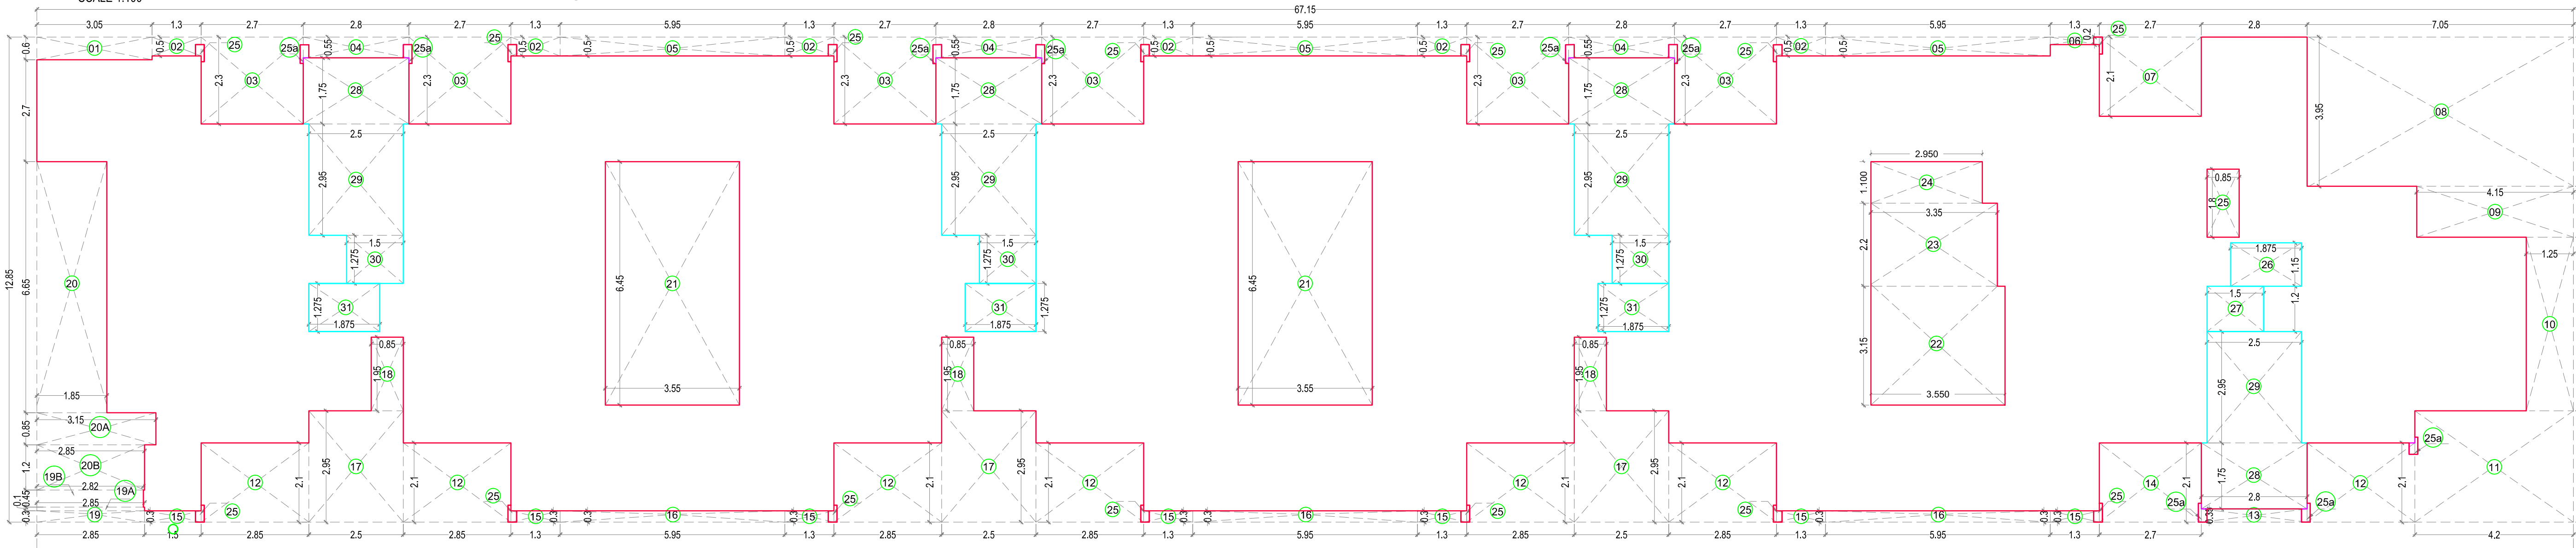

4TH FLOOR BUILT UP AREA CALCULATION

SCALE 1:100

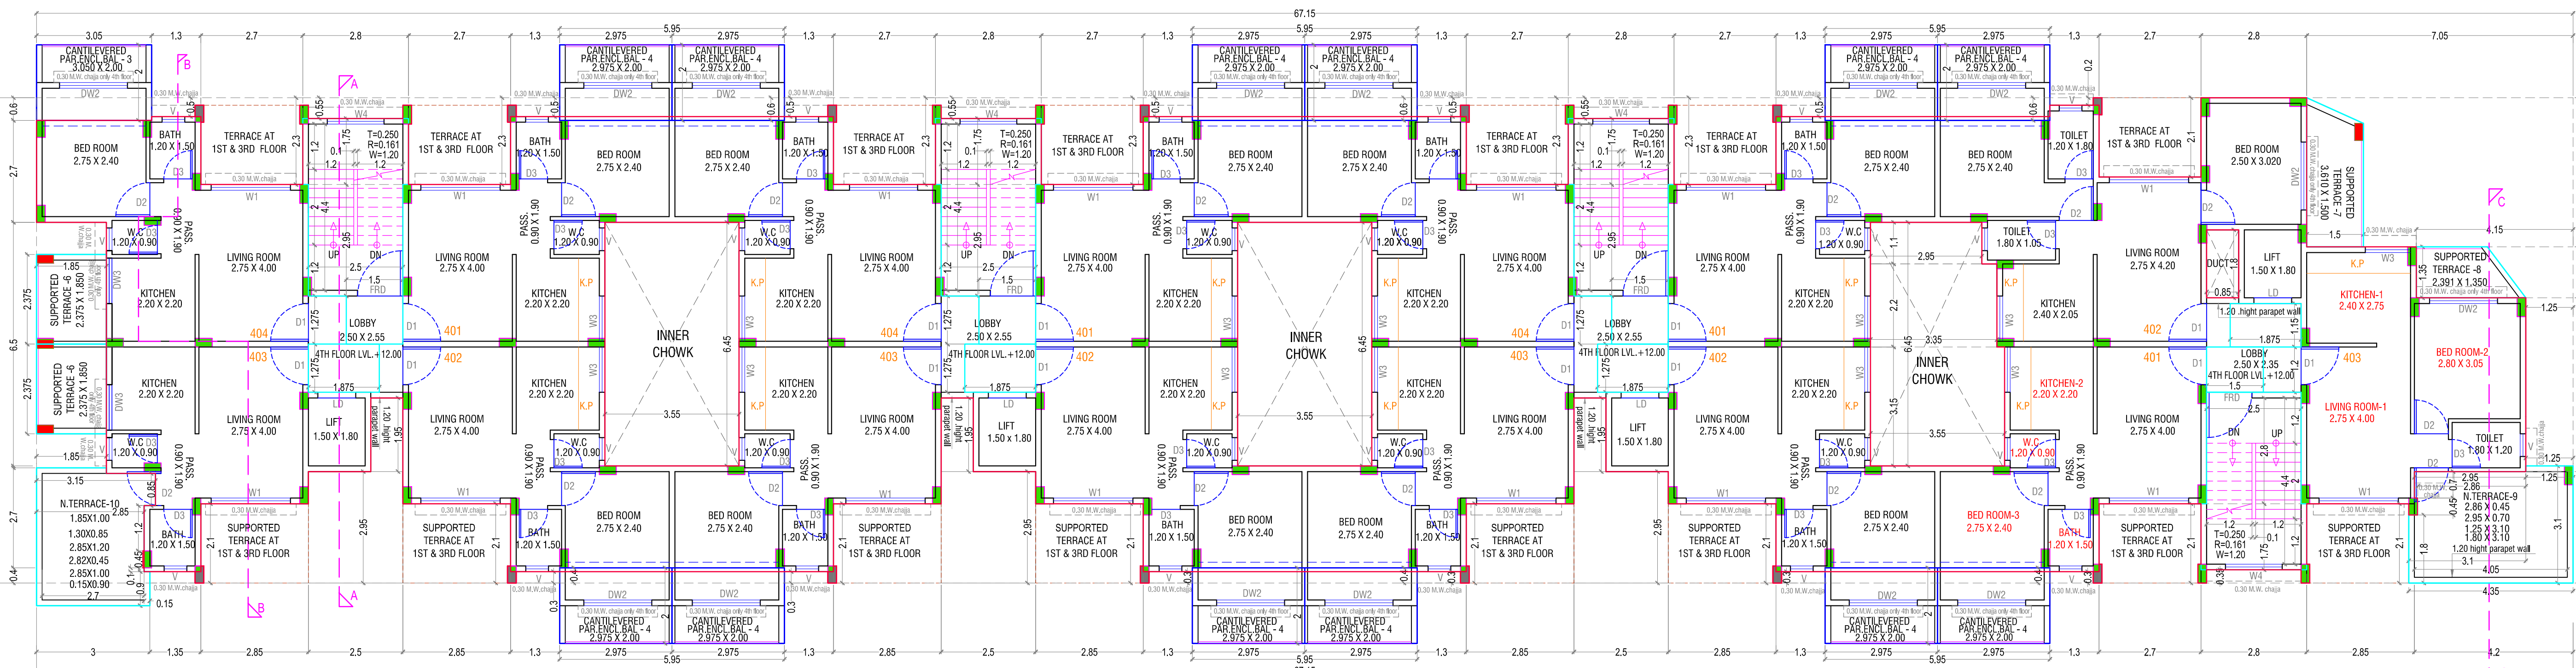

4TH FLOOR PLAN

SCALE 1:100

NORTH

ELEVATION

4TH FLOOR BUILT UP AREA CALCULATION					
Block Description	Number of Blocks	Length (meter)	Breadth (meter)		Area (sqm.)
1	67.150	12.850		=	862.878
SUBTOTAL : A					
DEDUCTION					
1	1	3.050	0.600	=	1.830
2	6	1.300	0.500	=	3.900
3	6	2.700	2.300	=	37.260
4	3	2.800	0.550	=	4.620
5	3	5.950	0.500	=	8.925
6	1	1.300	0.200	=	0.260
7	1	2.700	2.100	=	5.670
8	1	7.050	3.950	=	27.848
9	1	4.150	1.350	=	5.603
10	1	1.250	4.600	=	5.750
11	1	4.200	2.950	=	12.390
12	7	2.850	2.100	=	41.895
13	1	2.800	0.350	=	0.980
14	1	2.700	2.100	=	5.670
15	6	1.300	0.300	=	2.340
15A	1	1.500	0.300	=	0.450
16	3	5.950	0.300	=	5.355
17	3	2.500	2.950	=	22.125
18	3	0.850	1.950	=	4.973
19	1	2.850	0.300	=	0.855
19A	1	2.850	0.100	=	0.285
19B	1	2.820	0.450	=	1.269
20	1	1.850	6.650	=	12.303
20A	1	3.150	0.850	=	2.678
20B	1	2.850	1.200	=	3.420
21	2	3.550	6.450	=	45.795
22	1	3.550	3.150	=	11.183
23	1	3.250	2.200	=	7.370
24	1	2.950	1.100	=	3.245
25	1	0.850	1.800	=	1.530
26	1	0.975	1.150	=	2.156
27	1	1.500	1.200	=	1.800
28	4	2.800	1.750	=	19.600
29	4	2.500	2.950	=	29.500
30	3	1.500	1.275	=	5.738
31	3	0.875	1.275	=	7.172
SUBTOTAL : B					
( SUBTOTAL : C ) = ( SUBTOTAL : A ) - ( SUBTOTAL : B )					509.138
ADDITION : D					
25	14	AS PER POLYLINE		=	1.123
25 A	9	AS PER POLYLINE		=	0.820
( NET BUILT UP AREA : D ) = ( SUBTOTAL : C ) + ( SUBTOTAL : D )					511.081
( GROSS BUILT UP AREA : E ) = ( SUBTOTAL : D )					511.919

BALCONY AREA STATEMENT						
4TH FLOOR						
BALCONY TYPE	NUMBER OF BALCONY	LENGTH (METER)	BREATH (METER)	AREA IN SQM.		
				OPEN	PARTLY ENCLOSED	ENCLOSED
PAR. ENCL-BAL-3	1	3.050	2.000	0.000	6.100	0.000
PAR. ENCL-BAL-4	12	2.975	2.000	0.000	71.400	0.000
SUBTOTAL				0.000	77.500	0.000
TOTAL PROPOSED BALCONY AREA					77.500	
NET BUILT UP AREA OF FLOOR					511.081	
PERMISSIBLE BALCONY AREA = ( NET BUILT UP AREA ) X 15 %					76.662	
BALANCE BALCONY AREA,IF ANY					NA	
(EXCESS BALCONY AREA,IF ANY : E)					0.838	
TERRACE AREA STATEMENT						
4TH FLOOR						
TERRACE TYPE	NUMBER OF TERRACE	LENGTH (METER)	BREATH (METER)	AREA IN SQM.		
T6	2	2.375	1.850	8.788		
T7	1	3.610	1.500	5.415		
T8	1	2.391	1.350	3.228		
N. T9	1	2.860	0.450	1.287		
		2.950	0.700	2.065		
		1.250	3.100	3.875		
		3.100	1.800	5.580		
		1.850	1.000	1.850		
N. T10	1	1.300	0.850	1.105		
		2.850	1.200	3.420		
		2.820	0.450	1.269		
		2.850	1.000	2.850		
		0.150	0.900	0.135		
TOTAL PROPOSED TERRACE AREA				40.866		
NET BUILT UP AREA OF FLOOR				511.081		
PERMISSIBLE TERRACE AREA = ( NET BUILT UP AREA ) X 20 %				102.216		
BALANCE TERRACE AREA				61.350		

CONTENT OF THE SHEET

4TH FLOOR PLAN, AREA DIAGRAM & CALCULATION, TERRACE FLOOR PLAN, SECTION AA, ELEVATION.

NAME OF THE OWNERS & SIGNATURE

For FUTURE HOMES CONSTRUCTIONS

M/S FUTURE HOMES CONSTRUCTION THROUGH PARTNER  
DEVRAJ OGUL RAVARA  
NAME & SIGNATURE OF OWNER

DESCRIPTION OF PROPOSAL & PROPERTY

PROPOSED DEVELOPMENT PERMISSION ON G. NO. 18/0, AT  
VILLAGE - AKURLI, TAL. - PANVEL, DIST. - RAIGAD.

DATE 22.07.2021

SCALE 1:100, 1:200, 1:500, 1:5000, N.T.S.

DRN BY

CHKD BY SWAPNIL KALYANKAR

NAME & SIGNATURE OF ARCHITECT



**SKA**  
SWAPNIL KALYANKAR ARCHITECTS  
Snehal Kalyankar | +91-98973 90001 | +91-271100345  
OFFICE A 101/NEEL ENERALD FINAL PLOT NO. 5278,  
SANVGAR/ROKHAR TENDLING OFFICE PANVEL - 410202.  
EMAIL: skaplanners@gmail.com

(Signature of Architect)

as SWAPNIL KALYANKAR  
REGD. NO. CA /2010 /47491